

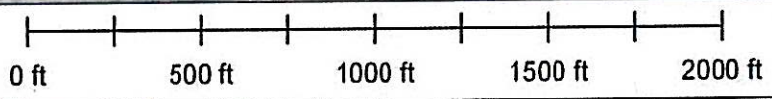
Exhibit B – Letkeman Route Deviation



MARGARET BETTENDORF

DEBRA LETKEMAN

RANDY CARIGNAN - ROGER CARIGNAN - ROBERT MEECE

D HOOEY



 <p>TransCanada In business to deliver</p>		<p>TROW ENGINEERING CONSULTANTS INC. 1300 Metropolitan Blvd. Suite 200 Tallahassee, Florida 32308 Phone: 1-850-385-5441 Fax: 1-850-385-5523</p> 	
TROW PROJ. No.:	THES0050386S	<p>KEYSTONE PIPELINE PROJECT ROUTE VARIATION: 355-ND-14.1-15.2-S</p>	
DRAWN BY:	TB		
CHECKED BY:	SS	DRAWING No.:	REV.
DATE:	APRIL 28, 2008	ND-355-1	0