


Exhibit C – Johansen Route Deviation

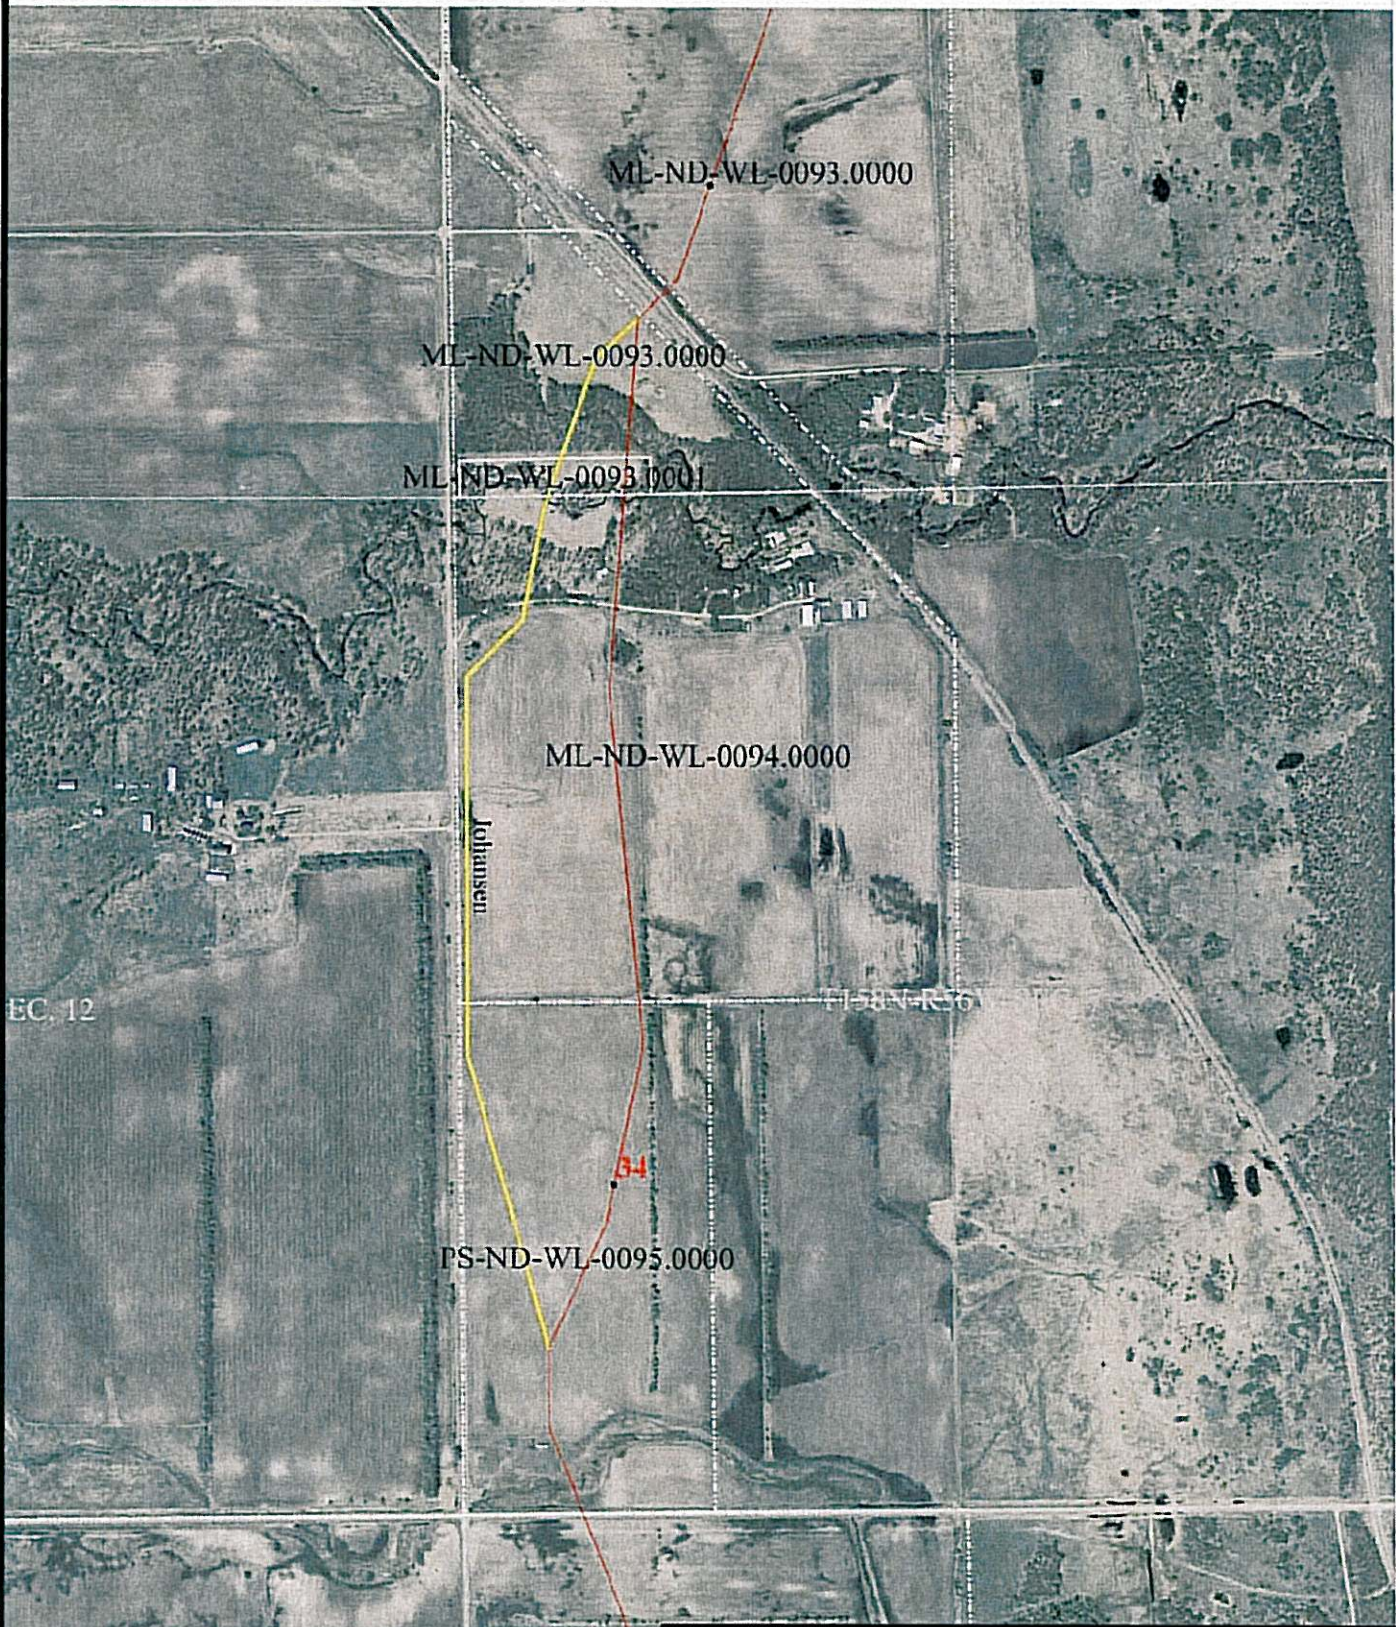

EC 12

Jollansen


34

ML-ND-WL-0093.0000

ML-ND-WL-0094.0000

PS-ND-WL-0095.0000

ML-ND-WL-0096.0000

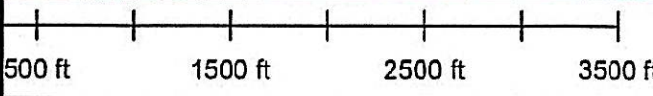

TROW ENGINEERING CONSULTANTS INC.
 1300 Metropolitan Blvd, Suite 200
 Tallahassee, Florida 32308
 Phone: 1-850-385-5441
 Fax: 1-850-385-5523



TROW PROJ. No.:	THES0050388S
DRAWN BY:	TB
CHECKED BY:	SS
DATE:	APRIL 28, 2008

KEYSTONE PIPELINE PROJECT	
ROUTE VARIATION: 356-ND-33.2-34.2-S	
DRAWING No.:	REV.
ND-356-1	0