



Exhibit E – Holm-Klein-Starke Route Deviation

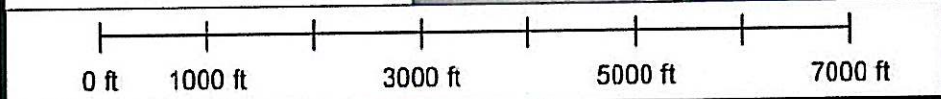

TROW ENGINEERING CONSULTANTS INC.
 1300 Metropolitan Blvd. Suite 200
 Tallahassee, Florida 32308
 Phone: 1-850-385-5441
 Fax: 1-850-385-5523

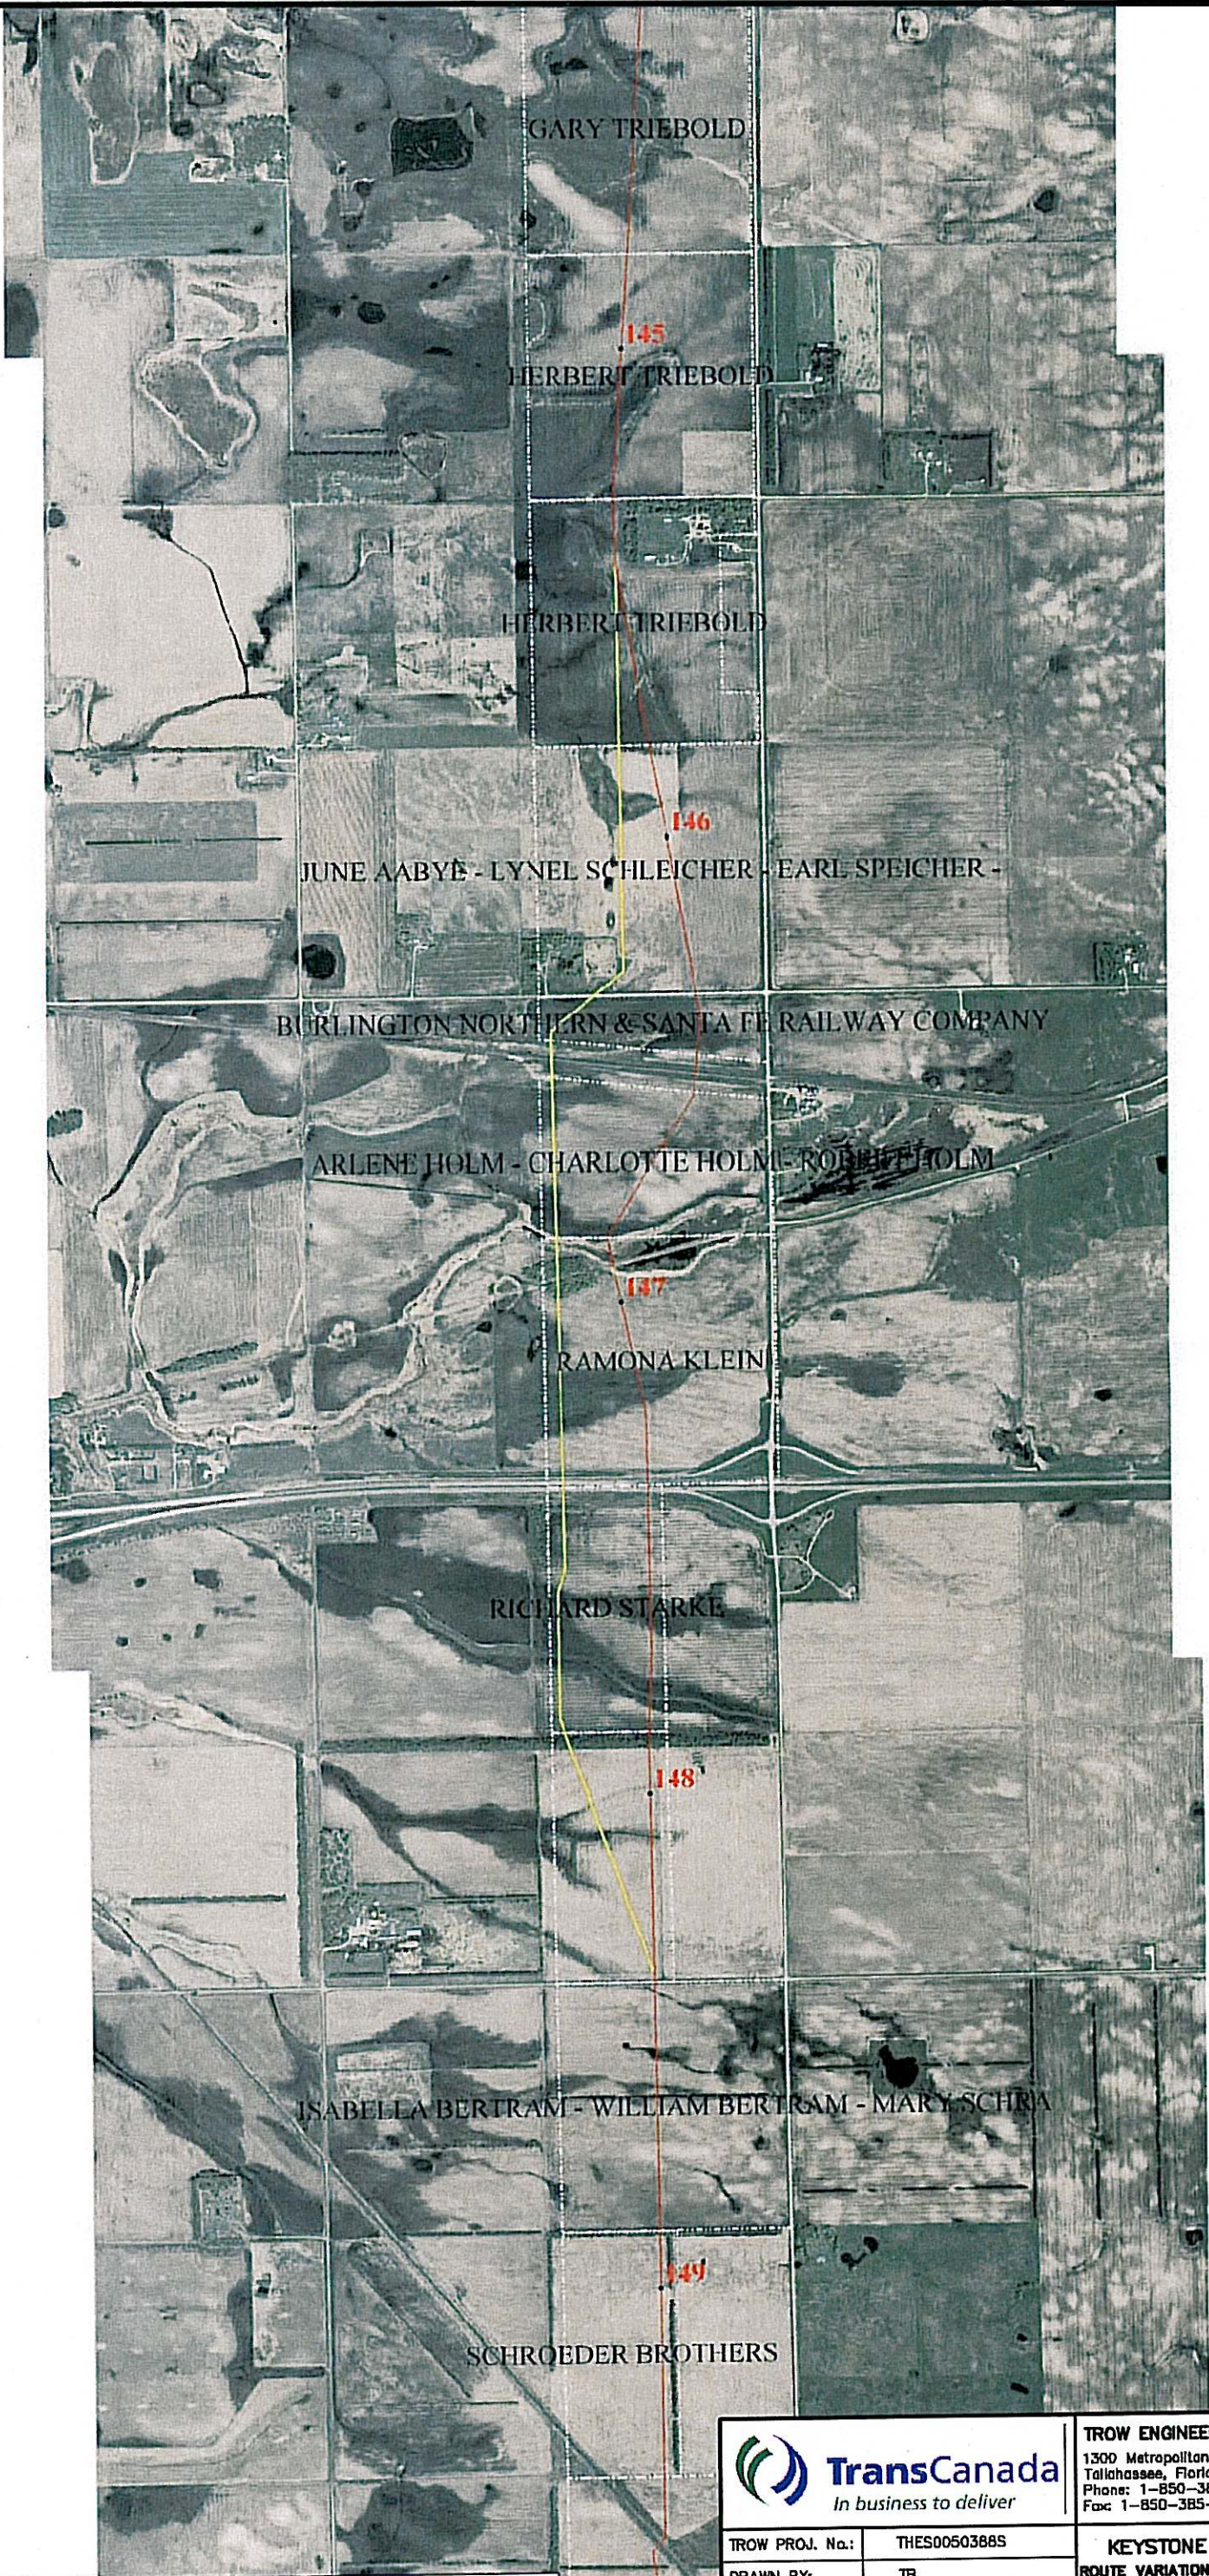

TROW PROJ. No.:	THES00503885
DRAWN BY:	TB
CHECKED BY:	SS
DATE:	APRIL 28, 2008

KEYSTONE PIPELINE PROJECT	
ROUTE VARIATION: KLEIN & STARKE REROUTE	
DRAWING No.:	REV.
ND 358-1	0

M - WILLIAM