

Hamre, John G.

From: Fahn, Patrick J.
Sent: Wednesday, May 21, 2008 8:31 AM
To: Hamre, John G.
Subject: FW: Notice of deadline of 5:00 pm central on Thursday May 22, 2008 for any comment on two route changes proposed with the Keystone Pipeline
Attachments: Substitute Exhibit A (Belanus Map) ND-354-1-rev1.pdf; Substitute Exhibit C (Johansen Map) ND-356-1-rev 1.pdf

RECEIVED

MAY 20 2008

PUBLIC SERVICE COMMISSION

Patrick Fahn
Utility Analyst
Email: pfahn@nd.gov
Phone: (701) 328-4077

North Dakota Public Service Commission
600 E Boulevard
Bismarck ND 58505-0480
Fax: (701) 328-2410

From: Todd Kranda [mailto:kranda@kelschlaw.com]
Sent: Tuesday, May 20, 2008 5:54 PM
To: -Info-Aeronautics Commission; -Info-Dept. of Agriculture; -Info-Attorney General; Dwelle, Terry L.; -Info-DHS Executive Office; -Info-Labor Dept.; -Info-Dept. of Career & Technical Education; Lucy, Paul J.; Engleson, Jeff A.; -Info-Game & Fish Dept.; Murphy, Ed C.; -Info-Governor's Office; -Info-Dept. of Transportation; Paaverud, Merl E.; Kulas, Cheryl M.; Brostrom, Darren W.; Preszler, Gary D.; -Info-Parks & Recreation; Govig, Paul T.; scott.hochhalter@ndsu.edu; -Info-State Water Commission
Cc: Fahn, Patrick J.; Binek, William W.; 'Thomas D Kelsch'
Subject: Notice of deadline of 5:00 pm central on Thursday May 22, 2008 for any comment on two route changes proposed with the Keystone Pipeline

May 20, 2008

Notice to State Agencies and Officials as Identified Pursuant to Section 69-06-01-05 ND Admin Code:

TransCanada Keystone Pipeline has previously filed with the North Dakota Public Service Commission (PSC) a Motion dated April 29, 2008 for approval of certain pending route refinements. You previously received notice of that filing. Subsequently, there was a survey which identified two cultural resource sites located along the proposed route for two landowners. As a result, Keystone has modified the route to avoid those two sites and two maps are attached that show the proposed route refinement to avoid the sites as identified.

The PSC is being asked by Keystone to approve these route refinement which include the changes shown on the two attached maps. Keystone is providing this email notice to each agency and state official with a deadline for comment on these two changes that have been filed with the PSC. This email is intended to provide notification to you that any comments on the two changes as proposed be provided in writing to the attention of Patrick Fahn at the PSC located at 600 East Boulevard - Dept 408 in Bismarck, with a copy of such written comments also mailed or emailed to the undersigned, by **no later than 5:00 p.m.** central time on **Thursday, May 22, 2008.**

Thank you for your attention to this matter.

Sincerely,

470 PU-06-421 Filed: 5/20/2008 Pages: 4
Email re Notice to State Agencies and Officials
Concerning Two Route Changes

TransCanada Keystone Pipeline, LP
Kelsch Kelsch Ruff & Kranda

Todd D. Kranda
Attorney for TransCanada Keystone Pipeline

Attachments as stated

c: Partick Fahn, Staff with Public Service Commission
William W. Binek, Attorney for Public Service Commission
Thomas D. Kelsch, Attorney for TransCanada Keystone Pipeline

KELSCH KELSCH RUFF & KRANDA

NOTICE: This e-mail, including attachments, is covered by the Electronic Communications Privacy Act, 18 U.S.C. 2510 et seq., is confidential, and/or is legally privileged. The preceding message and any attachments are intended only for the use of the addressee and may contain information that is privileged and confidential. If the reader of this message is not the intended recipient or an authorized representative of the intended recipient, you are hereby notified that any dissemination of this communication is strictly prohibited. If you have received this communication in error, please 1) notify us immediately by e-mail to kranda@kelschlaw.com or by telephone at 701-663-9818 (toll free at 1-888-663-9818); 2) delete this e-mail, including deletion of all associated text files from all storage locations including individual and network storage devices; and 3) refrain from disseminating or copying this communication. Thank you.

Todd D. Kranda
Kelsch Kelsch Ruff & Kranda
103 Collins Avenue, PO Box 1266
Mandan ND 58554-7266
Phone 701-663-9818 (toll free 1-888-663-9818)
Fax 701-663-9810
kranda@kelschlaw.com

EDWARD STREMICK — MARLENE STREMICK

Belanus Recroute Rev 1

JAMES BELANUS — TERESA BELANUS

SCALE:



Blue Line, Original Keystone Route
 Red Line — 1st Alternative Route
 Yellow Line — 2nd Alternative Route



TROW ENGINEERING CONSULTANTS INC.

1300 Metropolitan Blvd. Suite 200
 Tallahassee, Florida 32308
 Phone: 1-850-385-5441
 Fax: 1-850-385-5523



TROW PROJ. No.:	THES0050368S
DRAWN BY:	TB
CHECKED BY:	SS
DATE:	MAY 19 08

KEYSTONE PIPELINE PROJECT
ROUTE VARIATION: 354-ND-4.6-5.1-S-rev1

DRAWING No.:	REV.
ND-354-1-rev1	1

V-SEC. 1

T150N R5 W SEC. 6

GORDON GEMMILL - WILMA GEMMILL

GORDON GEMMILL - WILMA GEMMILL

ANTON JOHANSEN - KENNETH JOHANSEN


ANTON JOHANSEN - KENNETH JOHANSEN

W-SEC. 12

CHARLES TROFTGRUBEN - SHARON TROFTGRUBEN

34


SCALE:

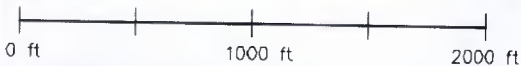

Walsh County, ND Rsd Line - Keystone Centerline
Yellow Line - Route Variation



TROW ENGINEERING CONSULTANTS INC.
 1300 Metropolitan Blvd. Suite 200
 Tallahassee, Florida 32308
 Phone: 1-850-385-5441
 Fax: 1-850-385-5523



TROW PROJ. No.:	THES0050388S
DRAWN BY:	TB
CHECKED BY:	SS
DATE:	MAY 19 08

KEYSTONE PIPELINE PROJECT	
ROUTE VARIATION: 356-ND-33.2-34.2-S-rev1	
DRAWING No.:	REV.
ND-356-1-rev1	1