

RECEIVED

JUL 01 2008

PUBLIC SERVICE COMMISSION



STATE
HISTORICAL
SOCIETY
OF NORTH DAKOTA

John Hoeven
Governor of North Dakota

July 1, 2008

North Dakota
State Historical Board

Ms. Elizabeth Orlando, Esq.
OES/ENV
Room 2657A
US Department of State
Washington, DC 20520

Albert I. Berger
Grand Forks - President

PU-06-421

Chester E. Nelson, Jr.
Bismarck - Vice President

NDSHPO REF. : 06-0088ss PSC/ Department of State/ENSR
**TransCanada Keystone Pipeline: Addendum 14: Class I, II, and III CRI,
National Register Eligibility Determination and Determination of Effect for
Site 32RM169**

Gereld Gerntholz
Valley City - Secretary

Dear Elizabeth:

A. Ruric Todd III
Jamestown

We have received and reviewed 06-0088qq DOS correspondence of June 30 for **TransCanada Keystone Pipeline related to:** "Addendum 14 to Keystone Project: Class I, II, and III Cultural Resource Investigations in Eastern North Dakota: Discovery Site 32RM169," by Ed Stine and Damien Rhinehart (Metcalf Archaeological Consultants, June 2008) and find it acceptable. We concur with the scope of identification efforts undertaken in the TransCanada Keystone project APE, as reported. Also, we concur with "**No Historic Properties Affected**" and "**No Significant Sites Affected**" determinations provided the protective fencing is used to avoid 32RM169 as stipulated in Revision 2 aerial. Thank you and we look forward to further consultation and to further review of outstanding documents regarding the project. If you have questions please contact either Paul Picha at (701) 328-3574 or Susan Quinnell at (701) 328-3576.

Diane K. Larson
Bismarck

Marvin L. Kaiser
Williston

Richard Kloubec
Fargo

Sara Otte Coleman
Director
Tourism Division

Kelly Schmidt
State Treasurer

Alvin A. Jaeger
Secretary of State

Douglass Prchal
Director
Parks and Recreation
Department

Francis Ziegler
Director
Department of Transportation

Sincerely,


Merlan E. Paaverud, Jr.
Director

Merlan E. Paaverud, Jr.
State Historic Preservation Officer (North Dakota)
and
Director, State Historical Society of North Dakota

✓ c: Susan E. Wefald, President, Commissioner, PSC, Rev. 2 attachment

Accredited by the
American Association
of Museums

543 PU-06-421 Filed: 7/1/2008 Pages: 2
Letter - No Historic Sites Affected - Addendum 14,
Class I,II,III, CRI - Revision 2 Aerial

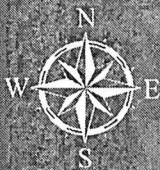


Ransom County


AMA5ANDRA02

Safety Fence to be installed along east side of construction corridor for site AMA5ANDRA02

 REROUTE
 ORIGINAL CENTERLINE
 EXTRA WORK SPACE
 SAFETY FENCE

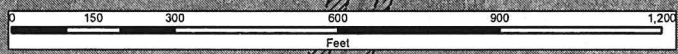

RANSOM COUNTY
NORTH DAKOTA
AMA5ANDRA02

<i>PRELIMINARY</i>				<small>PREPARED BY:</small> TROW ENGINEERING CONSULTANTS INC. 1300 Metropolitan Boulevard, Suite 200 Tallahassee, Florida, USA 32308 Phone: 1-850-385-6441 Fax: 1-850-385-4523				 TransCanada <i>In business to deliver</i> KEYSTONE PIPELINE PROJECT Cultural Sites Drawings - ND				
2	REVISED CL OFFSET TO 30 PER ESR REQUEST	06/28/08	RG	SCALE	DATE	DRAWN	CHECKED	APPROVED	PROJECT:	DRAWING NUMBER	SHEET	REVISION
1	ADJ WRKSP AND CL TO STAY WITHIN SURVEY CORRIDOR	06/25/08	RG						50388E	K-38-4400-W-002A	2A	2
0	ISSUED FOR REVIEW	06/10/08	RG									
NO.	REVISION	DATE	APPR.	1:4:204	06/10/2008	GS	SS	RG				