

Hamre, John G.

From: Fahn, Patrick J.
Sent: Thursday, October 30, 2008 4:50 PM
To: Hamre, John G.
Subject: FW: PSC CASE NUMBER PU-06-421
Attachments: South Spread Report 10-28-08 PU-06-421.pdf

John - please docket in 06-421 from KLJ and then forward to Commissioners, PUD, and Legal

Patrick Fahn
Utility Analyst
Email: pfahn@nd.gov
Phone: (701) 328-4077

North Dakota Public Service Commission
600 E Boulevard
Bismarck ND 58505-0480
Fax: (701) 328-2410

-----Original Message-----

From: Dave Opdahl [mailto:dave.opdahl@kljeng.com]
Sent: Thursday, October 30, 2008 2:12 PM
To: Fahn, Patrick J.
Cc: Mark Anderson
Subject: PSC CASE NUMBER PU-06-421

Please call if you have any questions or comments.

David Opdahl
Engineering Technician
Municipal Group
Kadrmass Lee & Jackson, Inc.
701-845-4980

PSC CASE NUMBER: PU-06-421

Kadmas
Lee &
Jackson
Engineers Surveyors
Planners

DAILY REPORT

Job Site: SOUTH SPREAD

Date: 10-28-08


Location and Operations Observed: MP 147 MEASURE PIPE THICKNESS

General Notes: THE SOLE PURPOSE OF THIS REPORT IS
TO DOCUMENT THE FIELD MEASUREMENTS OF
PIPE STOCKPILED ON THE RICHARD STARKLE
PROPERTY.

SEE PAGE 2 OF 3 FOR MEASUREMENTS
& MAP.

← 1-94 →

PIPE THICKNESS			
NUM.	STAMPED THK.	INITIAL READ.	CLEAN READ.
1 N	0.438	0.444	0.4415
1 S	0.438	0.443	0.439
2 N	0.438	0.444	0.442
2 S	0.438	0.442	0.439
3 N	0.516	0.521	0.520
3 S	0.516	0.522	n.m.
4 N	0.516	0.524	n.m.
4 S	0.516	0.531	n.m.
5 N	0.516	0.525	n.m.
5 S	0.516	0.525	n.m.
6 N	0.516	0.535	n.m.
6 S	0.516	0.527	n.m.
7 N	0.516	0.520	n.m.
7 S	0.516	0.536	n.m.
8 N	0.516	0.522	n.m.
8 S	0.516	0.530	0.522
	n.m.	Not Measured	

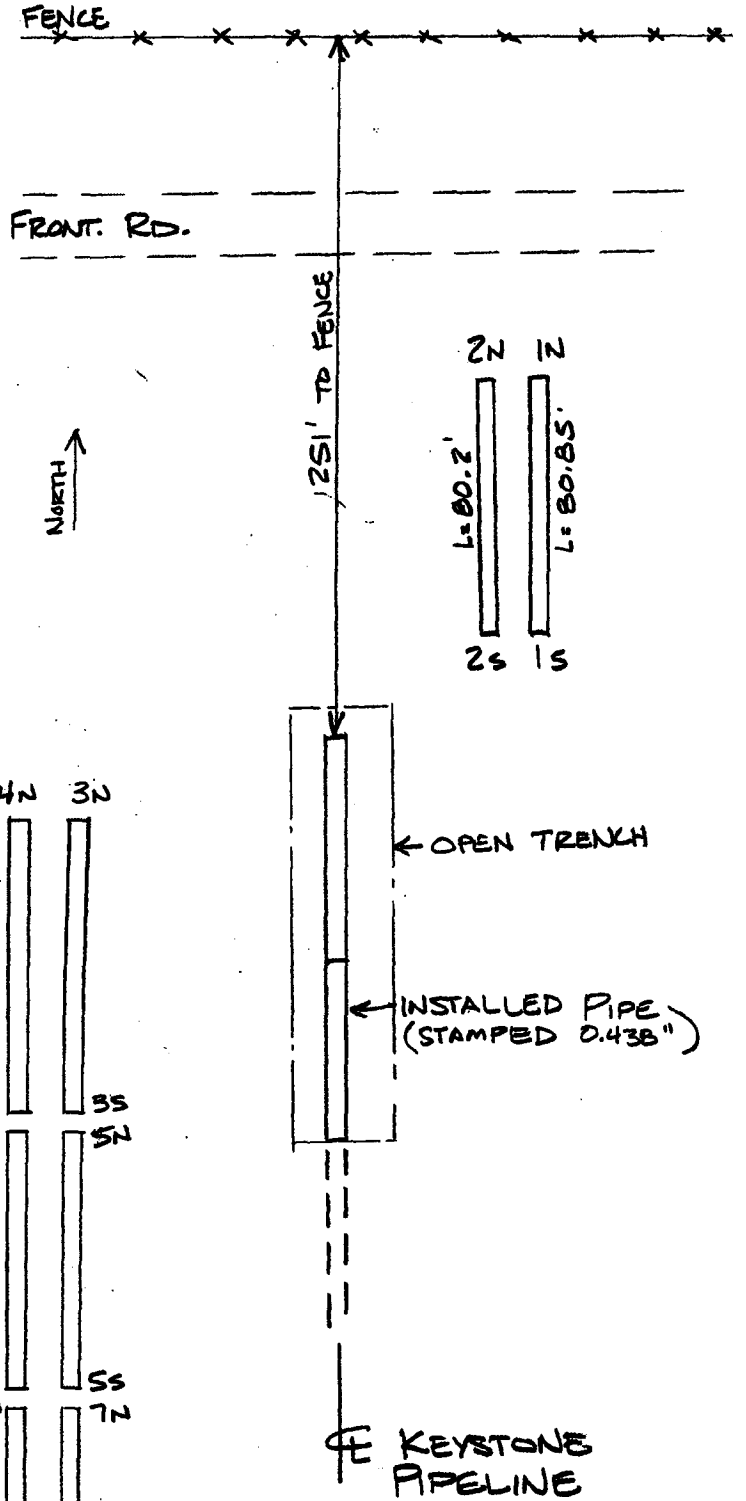

ALL MEASUREMENTS ARE IN INCHES TAKEN WITH A DIGITAL CALIPER.

PSC CASE NUMBER: PU-06-421

Wadmas
Lee &
Jackson
Engineers Surveyors
Planners

DAILY REPORT (Cont.)


Date 10-23-08

Page 3 of 3

The following deviations from the finding of facts were found:

- NONE -

Signature:

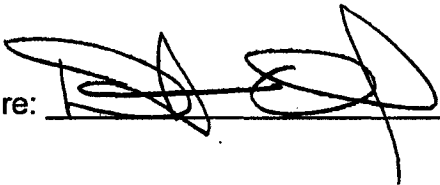

Print Name:

DAVID OPDAHL