

RIGHT-OF-WAY HORIZONTAL REPRESENTATION (2D)
TRACT NUMBER
LENGTH APPLICABLE DWG. NO.

LAND USE

PIPELINE PROFILE
HORIZONTAL REPRESENTATION (2D)
HORIZ: 1"=500' VER: 1"=100'
HORIZONTAL REPRESENTATION (2D)

LEGEND

- KEYSTONE PIPELINE
- STATE BOUNDARY
- COUNTY/TOWNSHIP
- SECTIONS
- NATIONAL OR STATE RESERVATION BOUNDARY
- PROPERTY LINE
- FENCE
- EXCLUSIONARY FENCE
- POWER LINE
- TELEPHONE LINE
- BURIED CABLE
- WATER LINE
- SANITARY SEWER LINE
- STORM SEWER / DRAIN
- FOREIGN PIPELINE
- RAILROAD
- HIGHWAY / ROAD
- STREAM / DITCH
- WETLAND
- INTERSTATE ROUTE
- U.S. ROUTE
- STATE ROUTE
- POINT OF INTERSECTION (PI)
- PIPELINE MILEPOST
- DIRECTION OF FLOW
- HOUSE
- BUILDING
- WATER WELL
- MANLINE VALVE


PIPELINE SCHEMATIC

- HEAVY WALL PIPE
- WELD FITTING
- TRANSITION PIECE
- CASING PIPE
- CONCRETE COATING
- SET ON WELLS
- PIPELINE WARNING SIGN
- PIPELINE MARKER
- MATERIAL ITEM
- GROUNDING MAT
- ZINC RIBBON
- AERIAL MARKER
- CATHODIC TEST STATION
- MANLINE VALVE
- CHECK VALVE
- OPEN CUT
- BORER
- DRINKING WATER USA
- ECOLOGICAL USA
- HIGHLY POPULATED AREA
- OPERATOR (INVESTOR) DEFINED
- OTHER POPULATED AREA
- SOURCE WATER PROTECTION AREA
- WELLHEAD PROTECTION AREA

TEST SECTIONS (3D)

ENVIRONMENTAL MITIGATION/RECLAMATION STATIONS (2D)

- TOPSOIL SALVAGE METHOD
- STREAMS
- WETLANDS
- TIMING CONSTRAINTS
- STATIONS
- MONITORING
- RECLAMATION
- SPECIAL CONSIDERATIONS

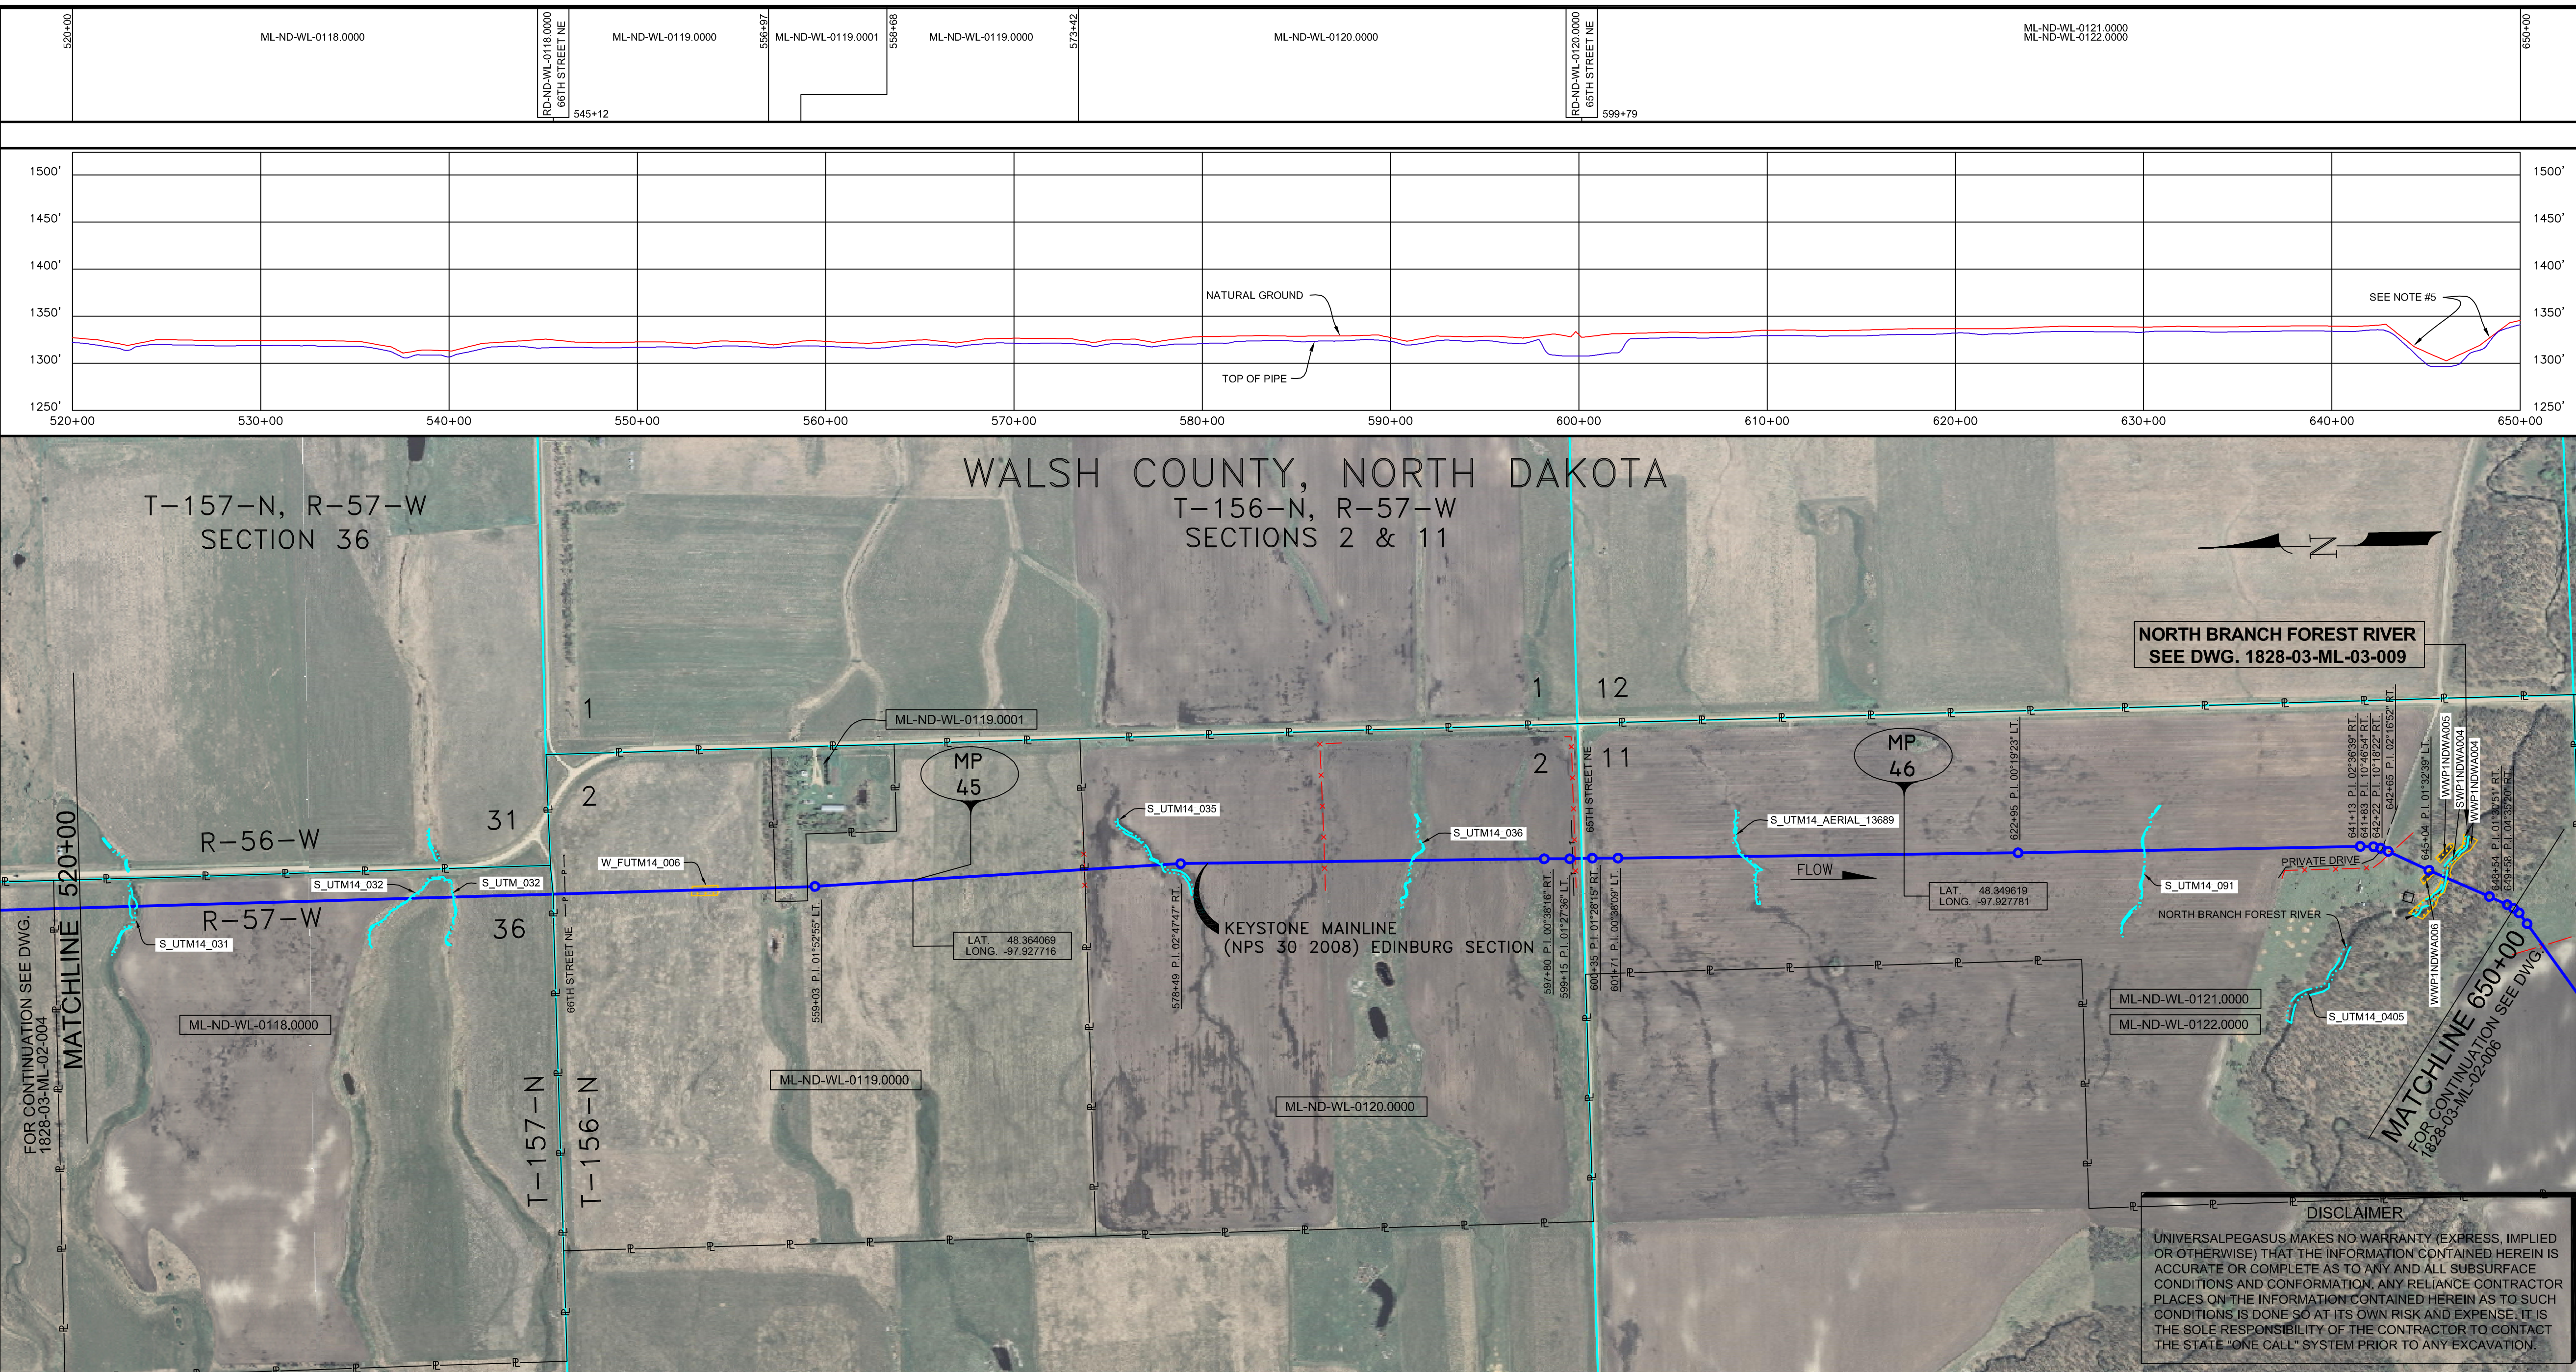

- GENERAL NOTES**
- 1) ALL CHAINAGES ARE IN FEET UNLESS OTHERWISE SPECIFIED.
 - 2) DATUM ELEVATION AND PROJECTION ARE BASED ON MEAN SEA LEVEL AND NAD 83.
 - 3) FIELD PIPE LOCATING REQUIRED TO DETERMINE PLACEMENT OF PIPELINE WITHIN PERMANENT EASEMENT.
 - 4) UNLESS OTHERWISE NOTED, 48 INCHES MINIMUM COVER EXCEPT 36 INCHES IN AREAS OF CONSOLIDATED ROCK.
 - 5) NO ACTUAL AS-BUILT GROUND SHOTS WERE TAKEN AT THIS LOCATION. THE PROFILE REPRESENTS A PROJECTION FROM SHOTS TAKEN AT 150' TO 250' INTERVALS.
 - 6) THE TYPE OF COATING APPLIED TO THE FIELD WELDS DURING THE ORIGINAL CONSTRUCTION WAS TWO COMPONENT LIQUID EPOXY. THE COATING PRODUCTS USED WERE DENSO 7200 OR SPC SP-2888.
 - 7) THE SUBSTANTIAL CONSTRUCTION COMPLETION DATE, BASED ON CALIPER PIG RUN, WAS AUGUST 12, 2009 FOR M.P. 31.03 TO M.P. 66.93 AND AUGUST 16, 2009 FOR M.P. 66.90 TO M.P. 88.54.
 - 8) ORIGINAL IN-SERVICE DATE OF THE KEYSTONE PIPELINE (PHASE 1): JUNE 30, 2010.
 - 9) CPS CALCULATION DATE: MAY 2010.
 - 10) ORION STATION SERIES NUMBER: 1182700.
 - 11) TO DETERMINE THE MILE POST AT A GIVEN LOCATION, ADD THE 3D STATION NUMBER FROM THIS SEGMENT TO STATION NUMBER 1810+69 AND DIVIDE BY 5280.

OPERATING AND TEST PRESSURE

1. THE MAXIMUM OPERATING PRESSURE (MOP) IS 1440 PSIG.
2. THE MINIMUM TEST PRESSURE WAS 1601 PSIG.

BILL OF MATERIALS (3D)

ITEM NO.	DESCRIPTION	QUANTITY
1	30" O.D. X 0.438" W.T. API-SLX-70 W/FBE COATING	4.996'
2	30" O.D. X 0.386" W.T. API-SLX-70 W/FBE COATING	7.866'
3	30" O.D. X 0.516" W.T. API-SLX-70 W/FBE COATING & ABRASION RESISTANT OVERCOAT	160'
	PIPELINE MARKERS	6 EA
	PIPELINE WARNING SIGNS	12 EA
	CATHODIC TEST STATION	2 EA
	AERIAL MARKER	1 EA

REFERENCE DRAWINGS

REF. NO.	DRAWING NO.	REV. NO.	DRAWING TITLE
O.C.	1828-03-ML-03-009	05	NORTH BRANCH FOREST RIVER OPEN CUT

REVISIONS

NO.	DATE	REV. BY	CHKD. BY	APP'D. BY	DESCRIPTION
1	5/17/08	UEI	RDG	LAG	ISSUE FOR CONSTRUCTION
2	8/27/08	UEI	RDG	LAG	ADDED CROSSING DETAILS ISSUED FOR AS-BUILT
3	10/17/08	UEI	RDG	LAG	REPLACES COVERAGE OF 1828-03-ML-02-005 IFC DRAWINGS
					1828-03-ML-02-007
					1828-03-ML-02-008
					1828-03-ML-02-009


ENGINEERING RECORDS

DRAWN BY	INITIAL	DATE	ENY APP'D.	INITIAL	DATE
UEI		10/01/04			

CHECKED BY: [Signature]

PROFESSIONAL ENGINEER

NAME	STATE	LIC#	REV#	DATE
LOYS A. GRAY, III	ND	PE5714		

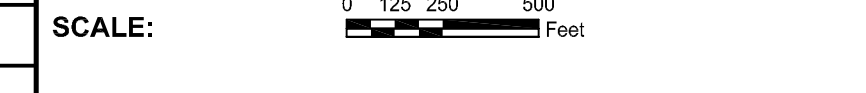

TransCanada
In business to deliver

KEYSTONE MAINLINE (NPS 30 2008) EDINBURG SECTION
SPREAD 1A DISCIPLINE 03

AS-BUILT ALIGNMENT

M.P. 44.16 TO M.P. 46.63
SHEET 5 OF 18 SHEETS
STA. 521+06 TO STA. 651+25 (3D)

DRAWING NO. 1828-03-ML-02-005 REV. 3

Z:\00_KEYSTONE_AS_BUILT\14-alignment sheets for North Dakota\ND1828_AS_BUILT\14-alignment sheets for North Dakota\ND1828-03-05.dwg, 3/9/2011 8:58:21 AM, pdfFactory.p3