RIGHT-OF-WAY HORIZONTAL REPRESENTATION (2D)

TRACT NUMBER
OWNERSHIP/AGENCY

LENGTH
APPLICABLE DWG. NO.

LAND USE

1040+00 | ML-ND-ST-0232.0000 | 1052+45 | ML-ND-ST-0234.0000 | 1083+91 | ML-ND-ST-0234.0000 BURLINGTON NORTHERN RAILWAY | 1086+92 | ML-ND-ST-0234.0000 | RD-ND-ST-0234.0001 15TH STREET NE | 1091+21 | ML-ND-ST-0235.0000 | 1117+88 | ML-ND-ST-0236.0000 | RD-ND-ST-0236.0000 14TH STREET NE | 1145+55 | ML-ND-ST-0237.0000 | 1170+00

PIPELINE PROFILE

HORIZ. 1"=500' VER. 1"=100'
HORIZONTAL REPRESENTATION (2D)

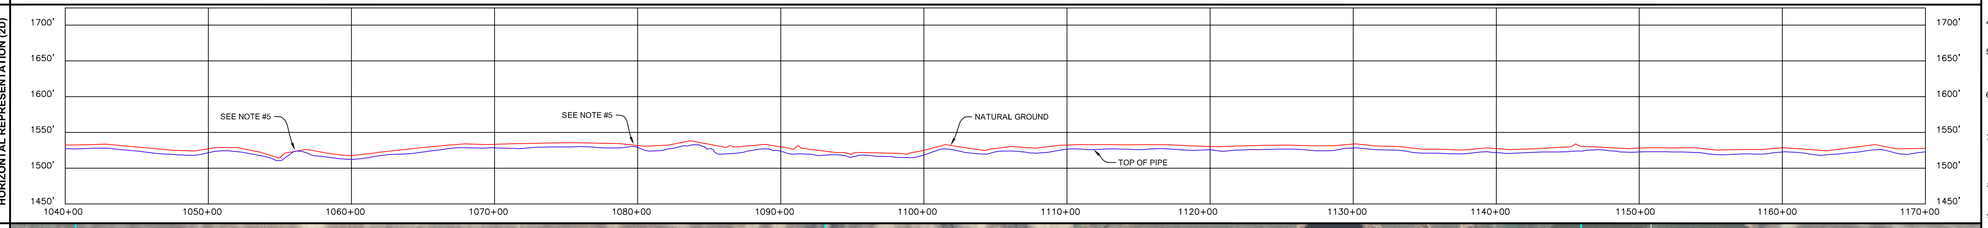

LEGEND

- KEYSTONE PIPELINE
- STATE BOUNDARY
- COUNTY/TOWNSHIP
- SECTIONS
- NATIONAL OR STATE RESERVATION BOUNDARY
- PROPERTY LINE
- FENCE
- EXCLUSIONARY FENCE
- POWER LINE
- TELEPHONE LINE
- BURIED CABLE
- WATER LINE
- SANITARY SEWER LINE
- STORM SEWER / DRAIN
- FOREIGN PIPELINE
- RAILROAD
- HIGHWAY / ROAD
- STREAM / DITCH
- WETLAND
- INTERSTATE ROUTE
- U.S. ROUTE
- STATE ROUTE
- POINT OF INTERSECTION (PI)
- PIPELINE MILEPOST
- DIRECTION OF FLOW
- HOUSE
- BUILDING
- WATER WELL
- MAINLINE VALVE
- ML-XX-XX-0000.0000 TRACT NUMBER

PIPELINE PLAN (SCALE 1" = 500')HORIZONTAL REPRESENTATION (2D)

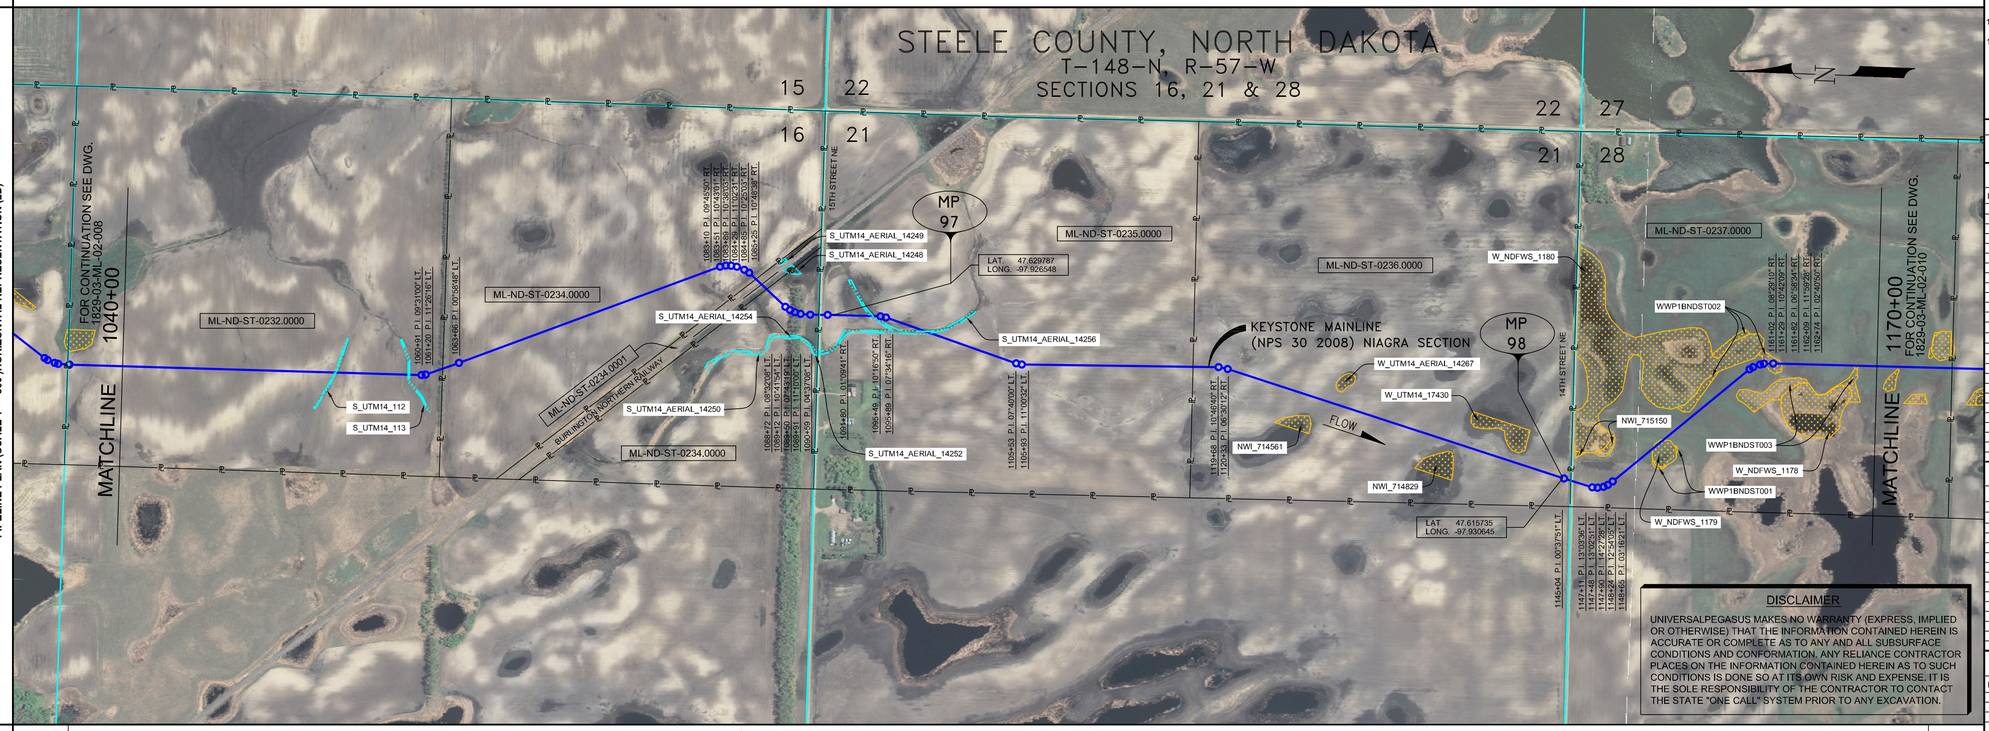

PIPELINE SCHEMATIC

- HEAVYWALL PIPE
- WELD FITTING
- TRANSITION PIECE
- CASING PIPE
- CONCRETE COATING
- SET-ON WEIGHTS
- PIPELINE WARNING SIGN
- PIPELINE MARKER
- MATERIAL ITEM
- GROUNDING MAT
- ZINC RIBBON
- AERIAL MARKER
- CATHODIC TEST STATION
- MAINLINE VALVE
- CHECK VALVE
- O.C. OPEN CUT
- BR. BORE

PIPELINE DATA — STATION/DESCRIPTION

- D DRINKING WATER USA
- E ECOLOGICAL USA
- H HIGHLY POPULATED AREA
- K OPERATOR (KEYSTONE) DEFINED
- O OTHER POPULATED AREA
- S SOURCE WATER PROTECTION AREA
- W WELLHEAD PROTECTION AREA

HORIZONTAL STATIONS (2D)

MATCHLINE 1040+00 | 1054+92 TOP BANK 1055+08 TOP BANK | 1059+46 TOP BANK 1060+17 CL DITCH 1061+20 P.I. 11°26'16" LT. | 1061+56 TOP BANK 1063+66 P.I. 00°58'48" LT. | 1083+10 P.I. 09°45'50" RT. 1083+51 P.I. 10°43'01" RT. 1084+58 P.I. 10°28'03" RT. 1084+75 P.I. 10°25'03" RT. 1085+25 P.I. 10°46'38" RT. | 1085+94 VENT 1086+27 ROAD BAR DITCH 1086+41 TOP OF RAIL 1086+43 NORTHERN RAILWAY 1086+46 TOP OF RAIL 1087+02 VENT | 1088+72 P.I. 08°32'08" LT. 1089+12 P.I. 07°43'19" LT. 1089+50 P.I. 07°43'19" LT. 1089+91 P.I. 11°10'00" LT. 1090+45 P.I. 11°10'00" LT. | 1091+11 EDGE OF ROAD 1091+21 CL 15TH STREET NE 1091+31 EDGE OF ROAD | 1091+80 P.I. 01°09'41" RT. | 1095+49 P.I. 10°16'50" RT. 1094+51 TOP BANK 1095+10 CL DITCH 1095+89 P.I. 07°34'16" RT. | 1098+02 TOP BANK 1098+76 CL DITCH 1099+88 TOP BANK | 1104+17 TOP BANK 1104+36 CL DITCH 1104+64 TOP BANK | 1105+53 P.I. 07°46'00" LT. 1106+68 P.I. 11°00'32" LT. | 1119+66 P.I. 10°46'40" RT. 1120+43 P.I. 06°30'12" RT. | 1145+04 P.I. 00°37'51" LT. | 1145+47 EDGE OF ROAD 1145+55 CL 14TH STREET NE | 1145+63 EDGE OF ROAD | 1147+11 P.I. 13°03'36" LT. 1147+48 P.I. 13°02'51" LT. 1147+98 P.I. 13°02'51" LT. 1148+24 P.I. 12°54'05" LT. 1148+65 P.I. 03°16'21" LT. | 1161+09 P.I. 06°29'10" RT. 1161+29 P.I. 10°42'09" RT. 1161+82 P.I. 06°38'34" RT. 1162+09 P.I. 11°59'28" RT. 1162+74 P.I. 02°40'50" RT. | MATCHLINE 1170+00

SLOPE STATIONS (3D)

MATCHLINE 1040+63 | 1046+61 6.2° CVR. | 1054+50 5.1° CVR. | 1055+77 TOP BANK 1056+07 CL DITCH 1056+93 TOP BANK | 1056+20 7.3° CVR. | 1060+33 TOP BANK 1061+04 CL DITCH 1061+97 P.I. 11°26'16" LT. 1062+07 P.I. 11°26'16" LT. | 1062+43 TOP BANK 1064+54 P.I. 00°58'48" LT. | 1070+34 4.7° CVR. | 1073+42 6.2° CVR. | 1081+38 5.8° CVR. | 1083+99 P.I. 09°45'50" RT. 1084+40 P.I. 10°43'01" RT. 1084+78 P.I. 10°28'03" RT. 1085+28 P.I. 10°25'03" RT. 1085+75 P.I. 10°46'38" RT. | 1087+08 ROAD BAR DITCH 1087+28 TOP OF RAIL 1087+34 NORTHERN RAILWAY 1087+37 TOP OF RAIL 1087+40 VENT 1087+50 6.1° CVR. | 1088+44 P.I. 08°32'08" LT. 1089+04 P.I. 07°43'19" LT. 1089+42 P.I. 07°43'19" LT. 1089+83 P.I. 11°10'00" LT. 1090+37 P.I. 11°10'00" LT. | 1091+03 EDGE OF ROAD 1091+13 CL 15TH STREET NE 1091+23 EDGE OF ROAD | 1092+73 P.I. 01°09'41" RT. 1092+42 P.I. 01°16'50" RT. | 1096+43 TOP BANK 1096+93 CL DITCH 1097+81 P.I. 07°34'16" RT. 1098+44 CL DITCH 1099+58 TOP BANK 1099+68 CL DITCH 1099+81 TOP BANK | 1103+11 TOP BANK 1103+30 CL DITCH 1103+37 TOP BANK | 1106+47 P.I. 07°46'00" LT. 1106+67 P.I. 11°00'32" LT. | 1108+73 7.6° CVR. | 1120+03 P.I. 10°46'40" RT. 1121+49 P.I. 06°30'12" RT. | 1121+49 5.4° CVR. | 1129+00 6.4° CVR. | 1134+19 5.1° CVR. | 1145+04 P.I. 00°37'51" LT. | 1145+47 EDGE OF ROAD 1145+55 CL 14TH STREET NE | 1145+63 EDGE OF ROAD | 1147+11 P.I. 13°03'36" LT. 1147+48 P.I. 13°02'51" LT. 1147+98 P.I. 13°02'51" LT. 1148+24 P.I. 12°54'05" LT. 1148+65 P.I. 03°16'21" LT. | 1148+67 4.1° CVR. | 1154+82 6.4° CVR. | 1161+09 P.I. 06°29'10" RT. 1161+29 P.I. 10°42'09" RT. 1161+82 P.I. 06°38'34" RT. 1162+09 P.I. 11°59'28" RT. 1162+74 P.I. 02°40'50" RT. | 1165+94 6.9° CVR. | MATCHLINE 1170+97

PIPE SLOPE REPRESENTATION (3D)

1040+63 | 1055+52 | ② 4,587' FBE | 1060+21 | 1063+15 | 1086+70 | ③ 130' FBE & ARO BR. 36" CASING 119' | 1087+84 | 1088+00 | ② 372' FBE | 1091+72 | ③ 81' FBE & ARO BR. | 1092+53 | 1095+36 | 1099+88 | ② 5,359' FBE | 1146+12 | ③ 80' FBE & ARO BR. | 1146+92 | ② 2,405' FBE | 1170+97

TYPE 'B'

CPS (3D)

TEST SECTIONS (3D) — TEST SECTION 1A-5 ILTO-021-2010

ENVIRONMENTAL MITIGATION/RECLAMATION STATIONS (2D)

- TOPSOIL SALVAGE METHOD
- STREAMS
- WETLANDS
- TIMING CONSTRAINTS
- **STATIONS**
- MONITORING
- RECLAMATION
- SPECIAL CONSIDERATIONS

GENERAL NOTES

1) COVER NOT IN PARENTHESIS IS TO TOP OF KEYSTONE PIPELINE. COVER IN PARENTHESIS IS TO TOP OF FOREIGN PIPELINE OR UTILITY LINE.

2) DATUM ELEVATION AND PROJECTION ARE BASED ON MEAN SEA LEVEL AND NAD 83.

3) FIELD PIPE LOCATING REQUIRED TO DETERMINE PLACEMENT OF PIPELINE WITHIN PERMANENT EASEMENT.

4) UNLESS OTHERWISE NOTED, 48 INCHES MINIMUM COVER EXCEPT 36 INCHES IN AREAS OF CONSOLIDATED ROCK.

5) NO ACTUAL AS-BUILT GROUND SHOTS WERE TAKEN AT THIS LOW LEVEL CROSSING. THE PROFILE REPRESENTS A PROJECTION FROM SHOTS TAKEN AT 150' TO 250' INTERVALS.

6) THE TYPE OF COATING APPLIED TO THE FIELD WELDS DURING THE ORIGINAL CONSTRUCTION WAS TWO COMPONENT LIQUID EPOXY. THE COATING PRODUCTS USED WERE DENSO 7200 OR SPC SP-2888.

7) THE SUBSTANTIAL CONSTRUCTION COMPLETION DATE, BASED ON CALIPER PIG RUN, WAS AUGUST 16, 2009 FOR M.P. 66.90 TO M.P. 88.54, SEPTEMBER 16, 2009 FOR M.P. 88.54 TO M.P. 114.00 AND SEPTEMBER 23, 2009 FOR M.P. 114.00 TO M.P. 130.00

8) ORIGINAL IN-SERVICE DATE OF THE KEYSTONE PIPELINE (PHASE 1): JUNE 30, 2010.

9) CPS CALCULATION DATE: MAY 2010.

10) ORION STATION SERIES NUMBER: 1182700.

11) TO DETERMINE THE MILE POST AT A GIVEN LOCATION, ADD THE 3D STATION NUMBER FROM THIS SEGMENT TO STATION NUMBER 4028+46 AND DIVIDE BY 5280.

OPERATING AND TEST PRESSURE

1. THE MAXIMUM OPERATING PRESSURE (MOP) IS 1440 PSIG.
2. THE MINIMUM TEST PRESSURE WAS 1801 PSIG.

BILL OF MATERIALS (3D)

ITEM NO.	DESCRIPTION	QUANTITY
2	30" O.D. X 0.386 W.T., API -5LX-70 W/FBE COATING	12,723'
3	30" O.D. X 0.516 W.T., API -5LX-70 W/FBE COATING & ABRASION RESISTANT OVERCOAT	291'
	PIPELINE MARKERS	3 EA
	PIPELINE WARNING SIGNS	8 EA
	CATHODIC TEST STATION	4 EA
	AERIAL MARKER	0 EA

REFERENCE DRAWINGS

REF. NO.	DRAWING NO.	REV. NO.	DRAWING TITLE

REVISIONS

NO.	DATE	REV. BY	CHCK BY	APPRD BY	ENV. APPRD	DESCRIPTION
1	5/12/08	UEI	RDG	LAG	SEC	ISSUED FOR CONSTRUCTION
2	10/11/23	UEI				ISSUED FOR AS-BUILT 1829-03-ML-02-009 REPLACES COVERAGE OF IFC DRAWINGS 1829-03-ML-02-014, 1829-03-ML-02-015

ENGINEERING RECORDS

	INITIAL	DATE		INITIAL	DATE
DRAWN BY	UEI	10/01/11	ENV. APPRD.		
CHECKED BY			APPRD. BY		
			COMPANY APPROVED		

PROFESSIONAL ENGINEER

NAME	STATE	LIC#	REV#	DATE
LOYS A. GRAY, III	ND	PE5714		

SCALE: 0 125 250 500 Feet

DISCLAIMER

UNIVERSALPEGASUS MAKES NO WARRANTY (EXPRESS, IMPLIED OR OTHERWISE) THAT THE INFORMATION CONTAINED HEREIN IS ACCURATE OR COMPLETE AS TO ANY AND ALL SUBSURFACE CONDITIONS AND CONFORMATION. ANY RELIANCE CONTRACTOR PLACES ON THE INFORMATION CONTAINED HEREIN AS TO SUCH CONDITIONS IS DONE SO AT ITS OWN RISK AND EXPENSE. IT IS THE SOLE RESPONSIBILITY OF THE CONTRACTOR TO CONTACT THE STATE "ONE CALL" SYSTEM PRIOR TO ANY EXCAVATION.

TransCanada — In business to deliver

UNIVERSAL PEGASUS INTERNATIONAL

KEYSTONE MAINLINE (NPS 30 2008) NIAGRA SECTION

P/A#	SPREAD	DISCIPLINE
1829	SPREAD 1A	DISCIPLINE 03

AS-BUILT ALIGNMENT

M.P. 96.01 TO M.P. 98.47

SHEET 9 OF 20 SHEETS

STA. 1040+83 TO STA. 1170+97 (3D)

DRAWING NO.	REV.
1829-03-ML-02-009	2

Z:\00_KEYSTONE_AS_BUILT\14-alignment sheets for North Dakota\ND1829_ASBUILTWD1829-009.dwg, 3/9/2011 10:45:01 AM, pdfFactory.pc3