


SIMPLE

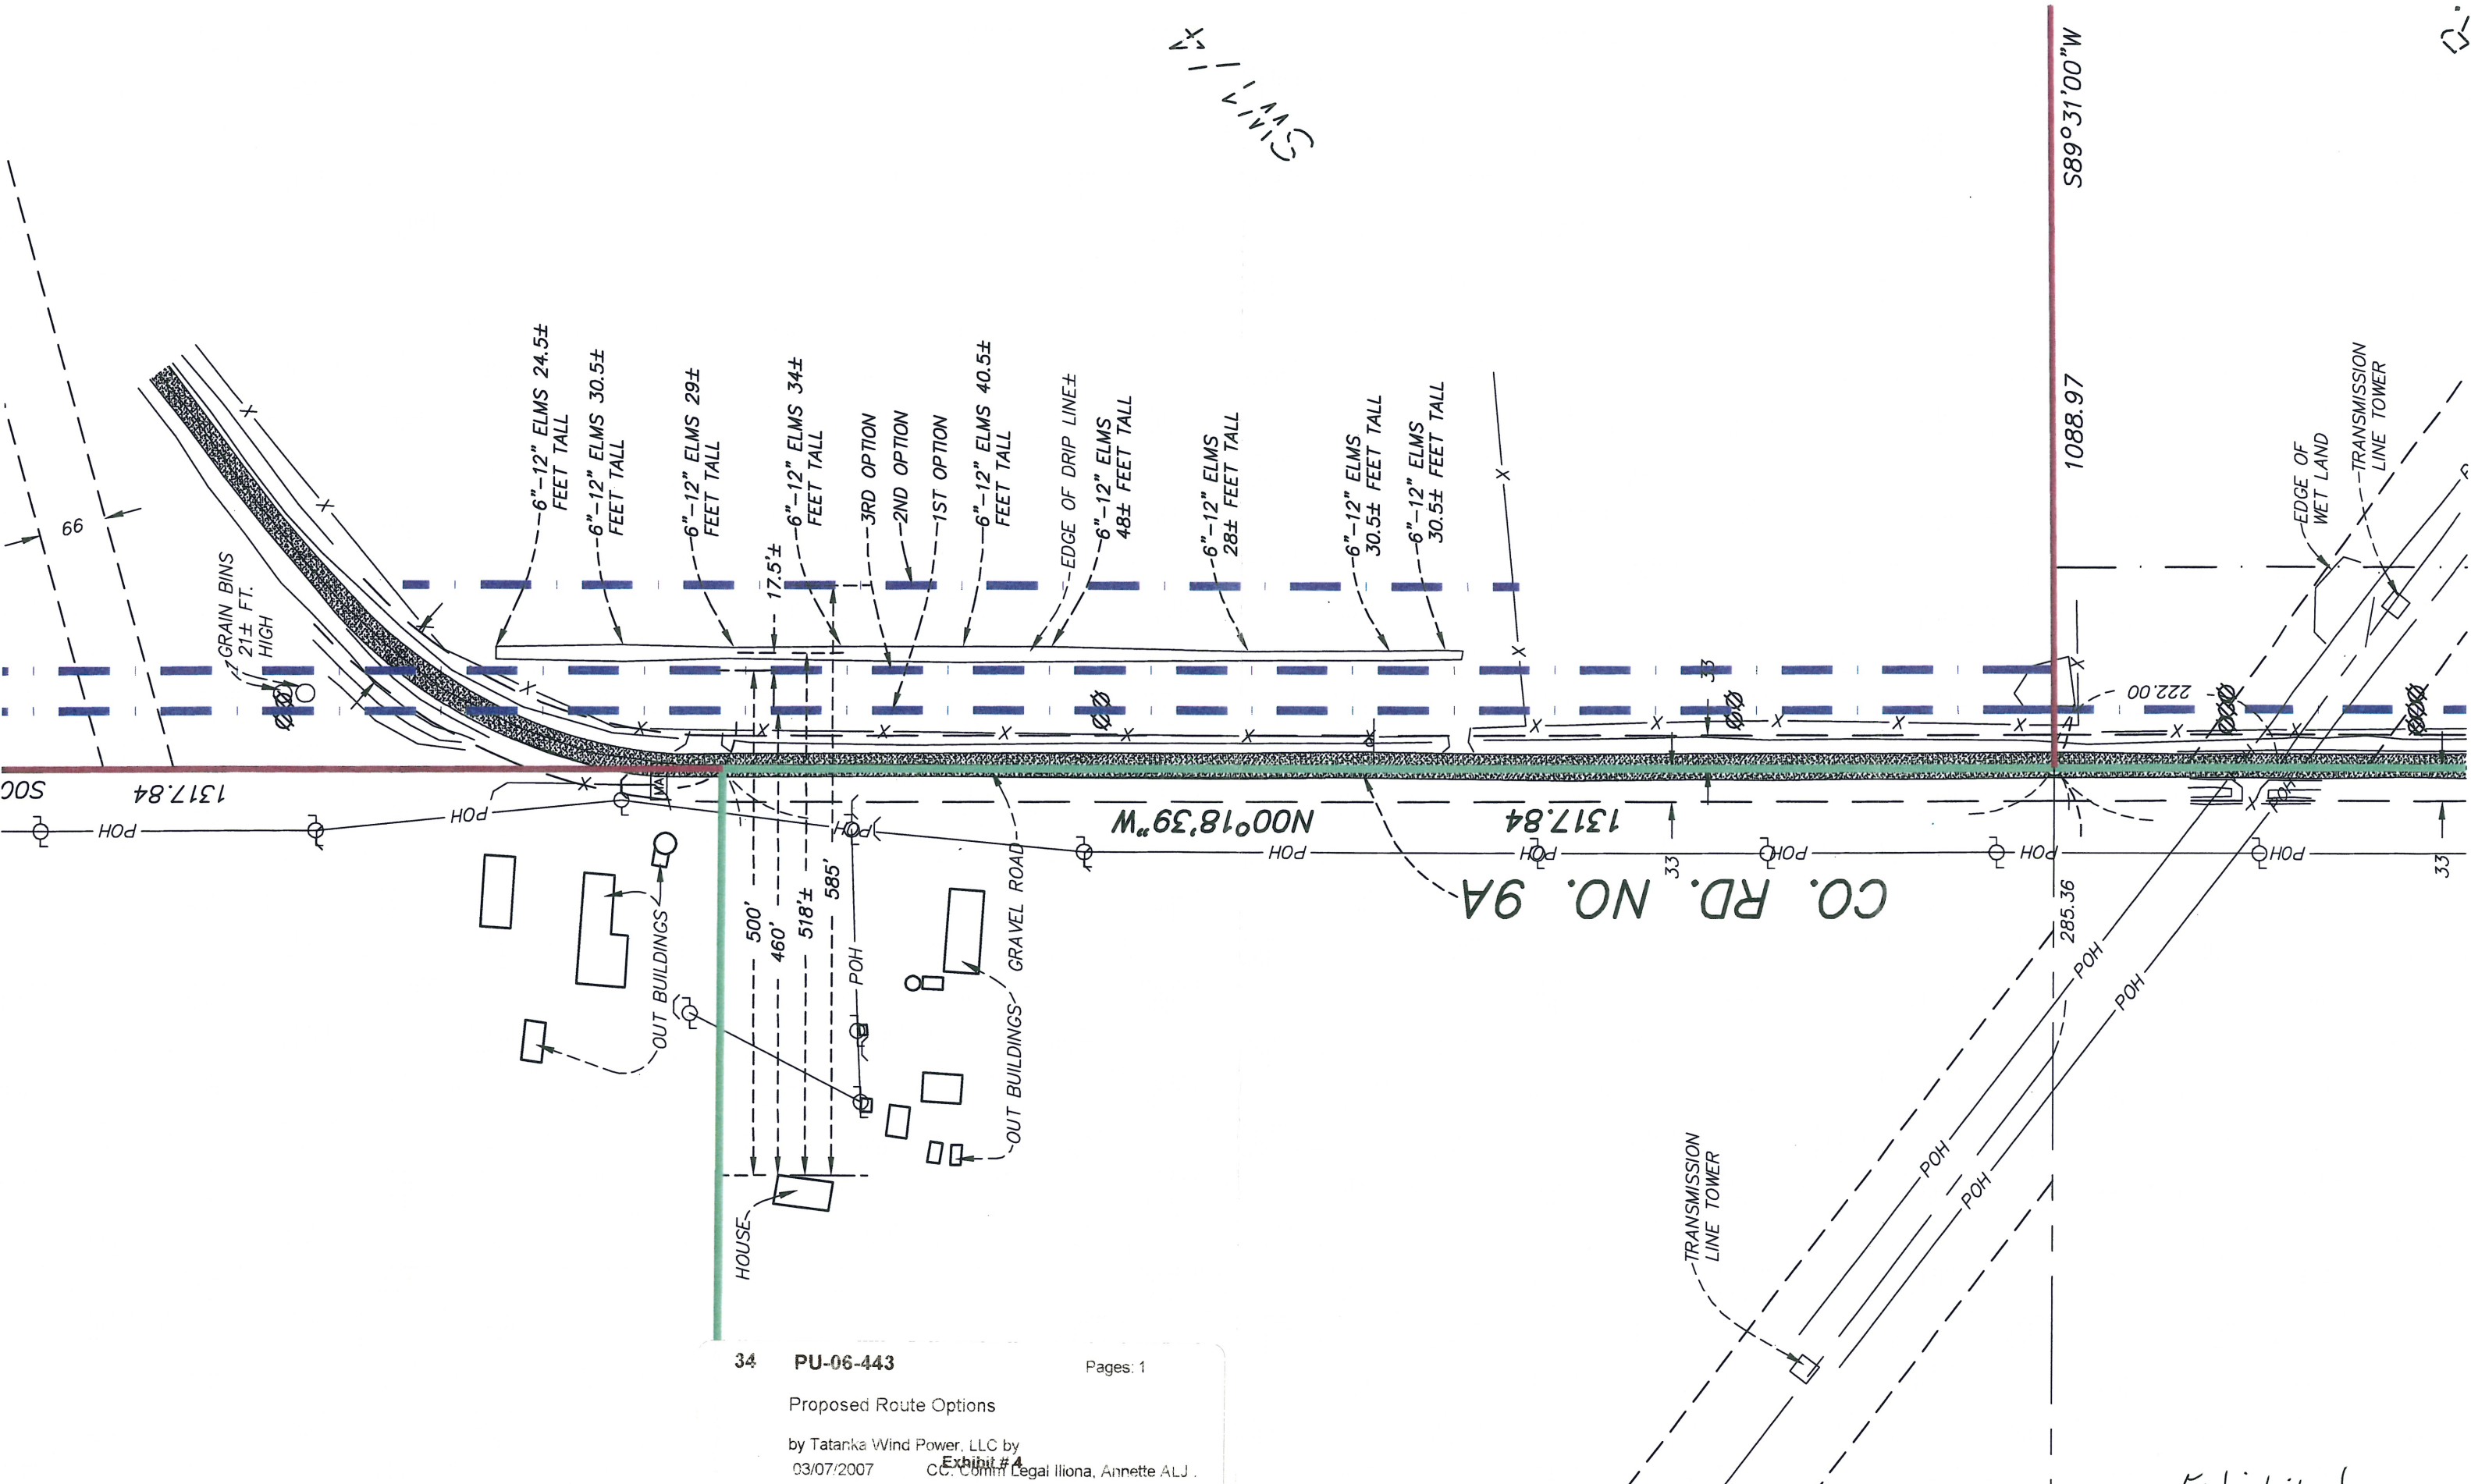

Proposed Route Options

by Tatanka Wind Power, LLC by
 03/07/2007 Exhibit # 4
 CC, County Legal Iliona, Annette ALJ.

Exhibit 4