


Fahn, Patrick J.

From: Brian Bjella [brbjella@flecklaw.com]
Sent: Thursday, December 20, 2007 12:45 PM
To: Fahn, Patrick J.; Binek, William W.
Subject: Case Nos. PU-07-108 & PU-07-75: Tongue River
Attachments: Tongue River Crossing rev A.pdf

Pat & Bill-

Attached for filing in the above cases is map showing alternate pipeline routes at the Tongue River. This maps depicts where the new pipelines would be located if the Commission approves these alternate routes, and allows for approximately 100' of trees to be removed on the north side of the existing pipelines.

Brian

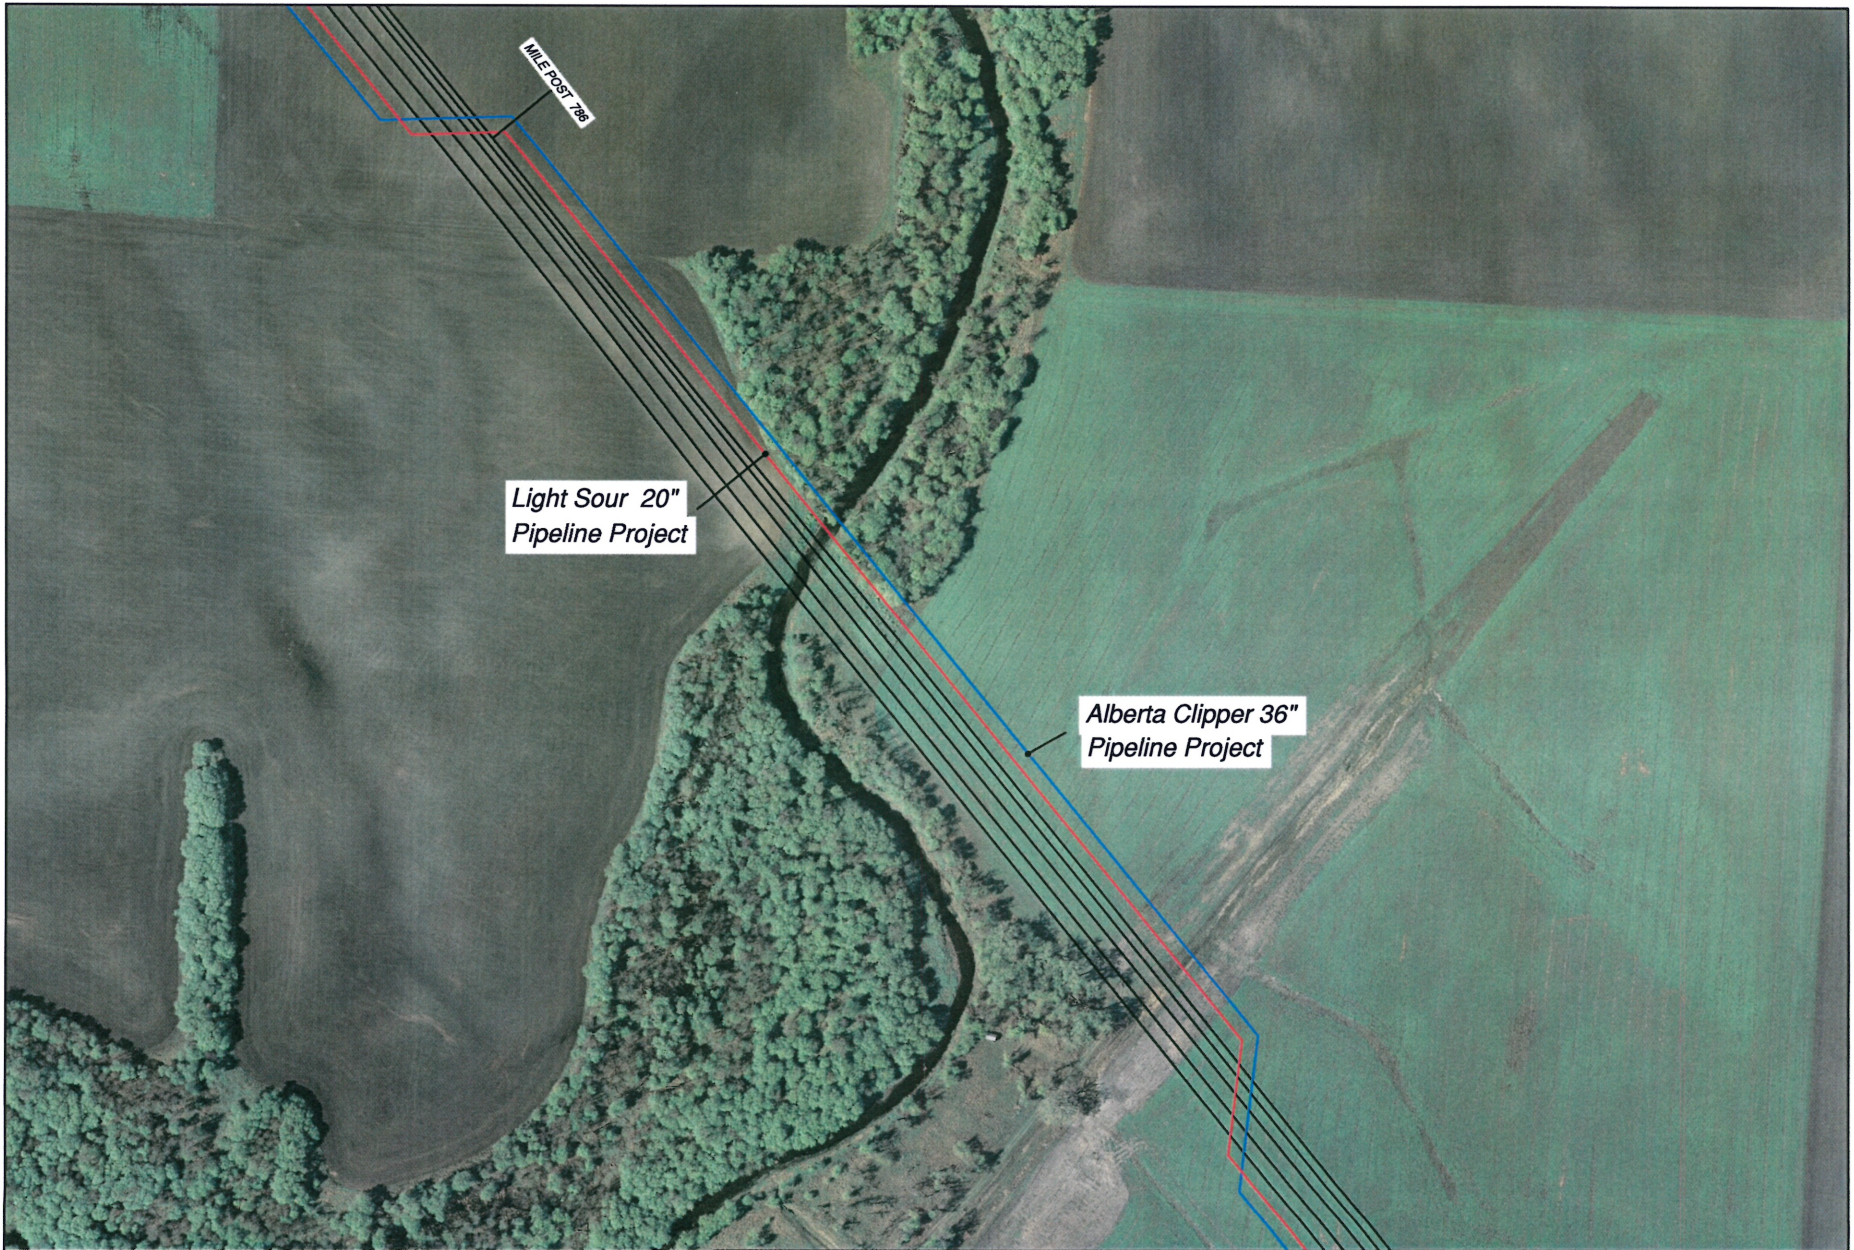

Light Sour & Alberta Clipper Projects
Tongue River Crossing - Pembina Co. North Dakota

Date: 12/18/07 Scale: 1" = 300'
Drawing: Tongue-02 Rev - A