Enbridge Pipelines (Lakehead) L.L.C.
1320 Grand Ave
Superior, WI 54880
Tel 715 398 4694
jan.larson@enbridge.com

www.enbridgepartners.com

ENBRIDGE™

VIA FEDERAL EXPRESS

March 4, 2010

Mr. Patrick Fahn
Director-Compliance and Competitive Markets
North Dakota Public Service Commission
600 E Boulevard
Bismarck, ND 58505-0480

Re: Case No. PU-07-108
Findings of Fact, Conclusions of Law, and Order
Enbridge Energy, Limited Partnership

Dear Mr. Fahn:

Pursuant to Paragraph 24 of the Commission's Order dated December 31, 2007, which states as follows:

> "Enbridge LP shall provide the Commission with a hard copy and electronic copy of the pipeline alignment drawings with alignment data showing the pipeline as built, and an electronic version of the as-built pipeline alignment that can be imported into ESRI GIS mapping software, and shall provide this information within 3 months of the completion of construction.",

enclosed is a complete set of as-built drawings and a CD containing all electronic data referenced above.

If you have any questions or require additional information regarding the submission of these materials, please feel free to call me at (715) 398-4694.

Sincerely,

Janice M Larson

Janice M. Larson

Enclosures

91 **PU-07-108** Filed: 3/8/2010 Pages: 31
Letter with As-Built Drawings and CD of Electronic Data

Enbridge Pipelines (North Dakota) LLC

Janice Larson


CROSSING INFORMATION

XX" LINE MATERIALS

ALL PIPE IS XX" O.D.
API 5L-X-70 STEEL PIPE
FBE COATED

TRACT NUMBER		T-1120	T-1119	T-1118A	T-1118	T-1117 RX 109th ST NE	T-1117	T-1116	T-1115 RX 146TH AVE. NE	T-1115	T-1114	T-1113	T-1113 RX PEMBINA	T-1113	T-1112 RX 108th ST NE	T-1112	T-1111	
LAND USE		CROP		CROP		ROAD	CROP	CROP		CROP		OPEN	RIVER	CROP	ROAD	CROP		

PLAN
1" = 500'

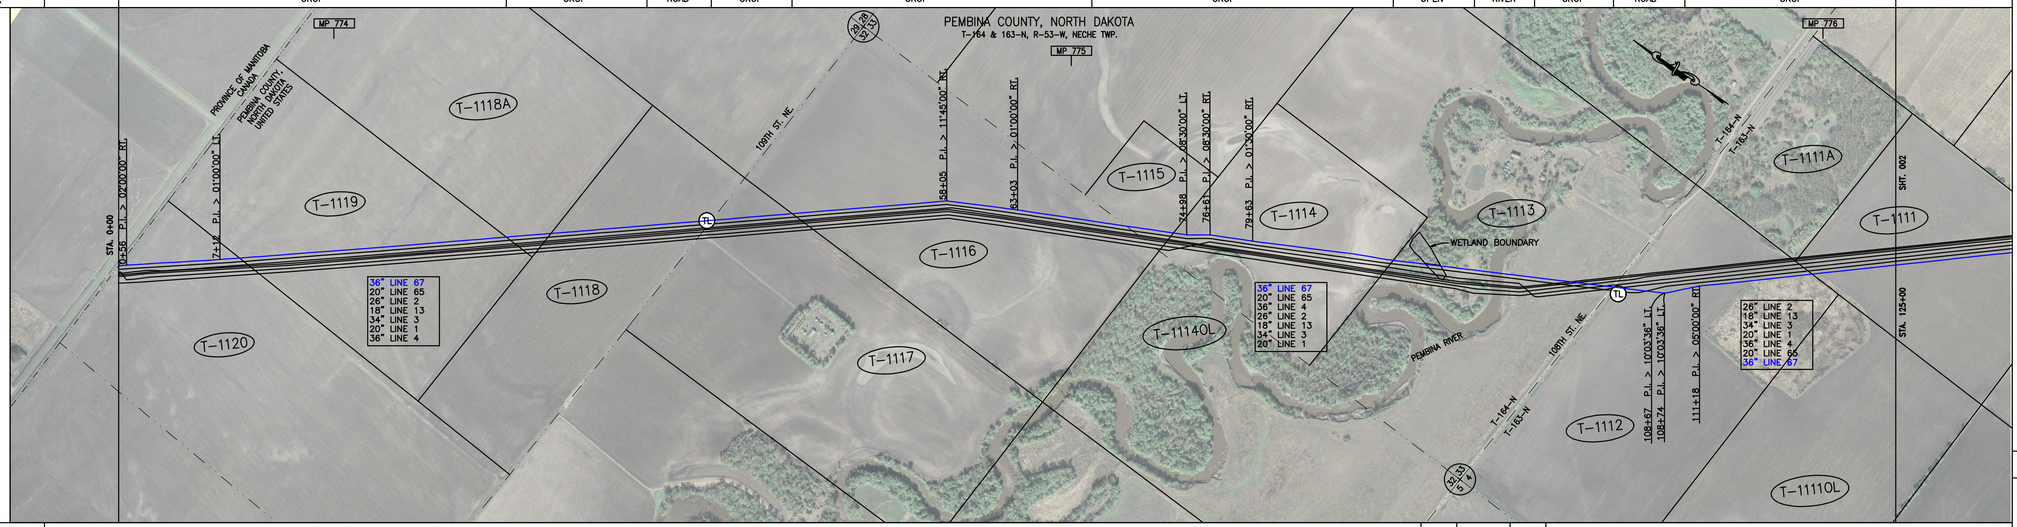

ENVIRONMENTAL


W-775A S-775A

CROSSING INFORMATION

0+00	US/CAN. BORDER
0+06	PROP. LINE
0+56	P.I. < 02°00'00" RT.
7+12	P.I. < 01°00'00" LT.
8+47	PROPERTY LINE
27+17	PROPERTY LINE
29+91	CROP LINE
30+29	PROPERTY LINE
41+12	ROAD R-O-W
41+53	CL 109TH ST NE
41+66	ROAD R-O-W
42+02	CROP LINE
46+17	CROP LINE
47+20	PROPERTY LINE
58+05	P.I. < 11°45'00" RT.
83+03	P.I. < 01°00'00" RT.
88+00	CROP LINE
70+04	ROAD R-O-W
70+17	WATER LINE
71+40	ROAD R-O-W
74+05	PROPERTY LINE
74+98	P.I. < 08°30'00" LT.
76+61	P.I. < 08°30'00" RT.
79+63	P.I. < 01°30'00" RT.
89+33	CROP LINE
89+55	PROPERTY LINE
91+93	EXIT WETLAND
96+28	TOP OF BANK
96+53	EDGE OF WATER
96+93	PEMBINA RIVER
97+15	EDGE OF WATER
97+55	TOP OF BANK
102+06	EXISTING 26" PIPELINE
103+38	EXISTING 34" PIPELINE
104+44	BURIED TELEPHONE LINE
104+55	EXISTING 20" PIPELINE
104+55	BURIED TELEPHONE LINE
104+70	ROAD R-O-W
105+09	SECTION LINE
105+48	CL 108TH ST NE
105+62	CROSS ROAD
105+62	EXISTING 16" PIPELINE
106+48	ROAD R-O-W
107+42	EXISTING 20" PIPELINE
108+67	P.I. < 10°03'36" LT.
108+74	P.I. < 10°03'36" LT.
111+18	P.I. < 05°00'00" RT.
119+12	PROPERTY LINE


36" LINE MATERIALS

ALL PIPE IS 36" O.D.
API 5L-X-70 STEEL PIPE
FBE COATED

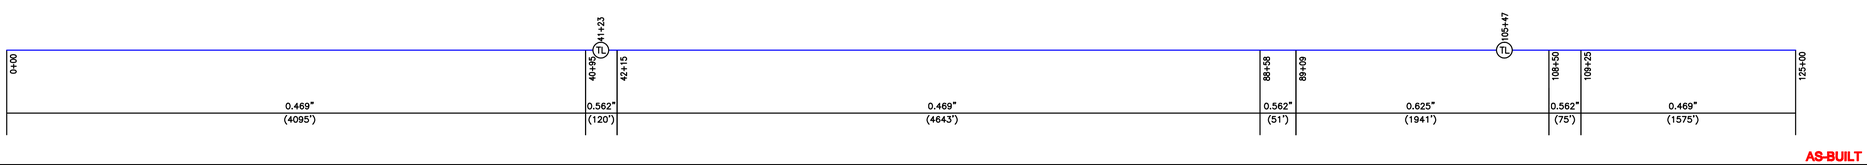

AS-BUILT

PIPE PROFILE
HORIZONTAL: 1" = 800'
VERTICAL: 1" = 100'

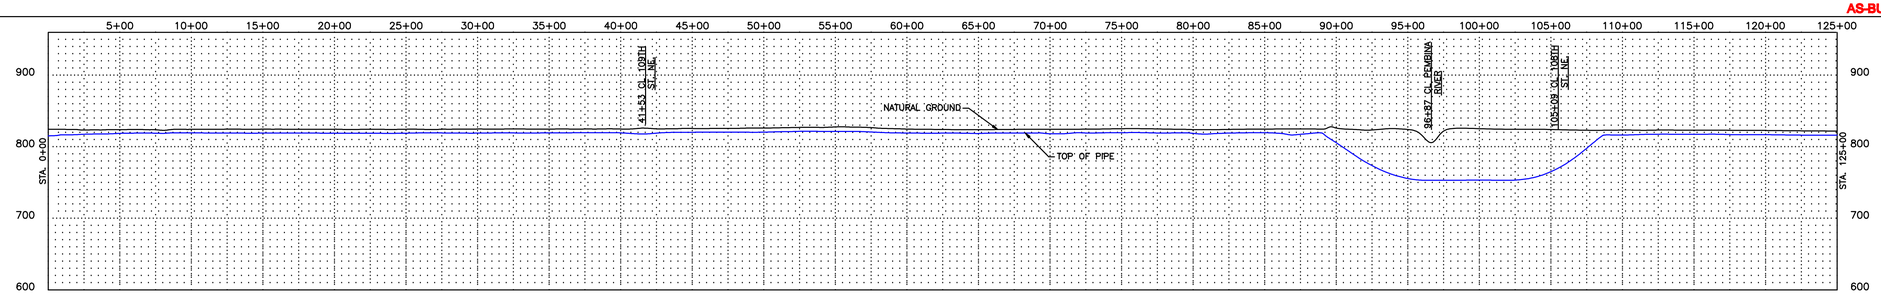

LEGEND

- INTERSTATE HIGHWAY
- US HIGHWAY
- STATE HIGHWAY
- CO. STATE AID HIGHWAYS
- COUNTY ROAD
- M. P. MARKER
- AERIAL M.P. MARKER
- CIVIL TOWNSHIP LINE
- FOREIGN PIPELINE
- SECTION LINES
- ROADS
- BURIED PHONE LINE
- BURIED POWER LINE
- OVERHEAD POWER LINE
- WATER LINE
- GAS LINE
- FIBER OPTIC CABLE LINE
- PROPERTY LINE
- RAILROADS
- WATER RIVERS, STREAMS, CREEKS, DITCHES
- ROCK SHIELD
- SET ON WEIGHTS
- CONCRETE COATING
- CASING
- MOV MOTOR OPERATED VALVE
- GATE VALVE
- TEE
- STOPPLE TEE
- REPAIR SLEEVE
- RECTIFIER
- WELD PLUS
- TEST LEAD

NOTES:

ENBRIDGE ENERGY # 1-800-858-5253
(L.C.) – LAND CONTRACT
RRX – RAILROAD CROSSING
WX – WATER CROSSING
RX – ROAD CROSSING
LWA – LOW WET AREA
WL – WETLAND (SEE WETLAND DELINEATION DRAWINGS REPORT)
GOPHER STATE ONE-CALL 1-800-252-1166
ALL STATIONING IN TRUE (PIPE) LENGTH

FIELD BOOK	FIELD BOOK	FIELD BOOK

NO.	REFERENCE DRAWINGS

	REVISION	DATE	APPR.

SCALE	DATE	DRAWN	APPROVED	APPROVED
1"=500'		MM	CN	

800 400 200 100 0 200 500 1000
SCALE IN FEET

ENBRIDGE

AS-BUILT ALIGNMENT
ALBERTA CLIPPER 36" PIPELINE
MP 773.7 TO MP 776.1
STA. 0+00 TO STA. 125+00
PEMBINA COUNTY, NORTH DAKOTA

DRAWING NUMBER	ROUTE SHEET
D-67-5.92-16920-001	001

CROSSING INFORMATION

XX" LINE MATERIALS

ALL PIPE IS XX" O.D.
API 5L-X-70 STEEL PIPE
FBE COATED

TRACT NUMBER	T-1111	T-1110A	T-1110	T-1109-RX 147TH AVE NE	T-1109	T-1107C	T-1107	T-1105-RX 107TH ST NE	T-1105	T-1104	T-1103	T-1102-RX 148TH AVE NE	T-1102	T-1101-RX 106TH ST NE	T-1101
LAND USE	CROP	OPEN		ROAD		OPEN		ROAD		CROP		ROAD	CROP	ROAD	CROP

PLAN
1" = 500'



ENVIRONMENTAL

CROSSING INFORMATION


137+84	CROP LINE	156+43	WATER LINE
138+05	PROPERTY LINE	156+52	CROP LINE
139+07	PROPERTY LINE	156+67	BURIED TELEPHONE LINE
		156+69	ROAD R-O-W
		156+92	PROPERTY LINE
		157+02	BURIED ELECTRIC LINE
		157+04	TOE OF BANK
		157+22	CL 147th AVE NE
		157+37	CL DITCH
		157+42	SECTION LINE
		157+69	TOE OF BANK
		157+77	CROP LINE
		157+89	ROAD R-O-W
		159+79	PROPERTY LINE

170+85	TOE OF BANK	196+31	PROPERTY LINE
171+11	TOE OF BANK		
171+37	TOE OF BANK		
171+42	CROP LINE		
173+86	ROAD R-O-W		
173+88	ROAD R-O-W		
173+91	TOE OF BANK		
174+32	TOE OF BANK		
174+37	CENTER OF ASPHALT		
174+53	CL 107th ST NE		
174+56	SECTION LINE		
174+70	CENTER OF ASPHALT		
174+74	TOP OF BANK		
175+28	TOP OF BANK		
175+43	CROP LINE		
175+45	ROAD R-O-W		
175+56	BURIED TELEPHONE LINE		
175+62	BURIED TELEPHONE LINE		
176+93	PROPERTY LINE		

233+82	BURIED TELEPHONE LINE	247+28	CROP LINE
233+93	BURIED TELEPHONE LINE	247+67	SECTION LINE
234+38	CROP LINE	248+11	TOE OF BANK
234+40	TOE OF BANK	248+15	CROP LINE
234+51	ROAD R-O-W		
234+67	TOE OF BANK		
234+80	TOP OF BANK		
235+05	CL 148th AVE NE		
235+20	TOP OF BANK		
235+47	CL DITCH		
235+52	ROAD R-O-W		
235+68	TOE OF BANK		
235+88	CROP LINE		


36" LINE MATERIALS

ALL PIPE IS 36" O.D.
API 5L-X-70 STEEL PIPE
FBE COATED

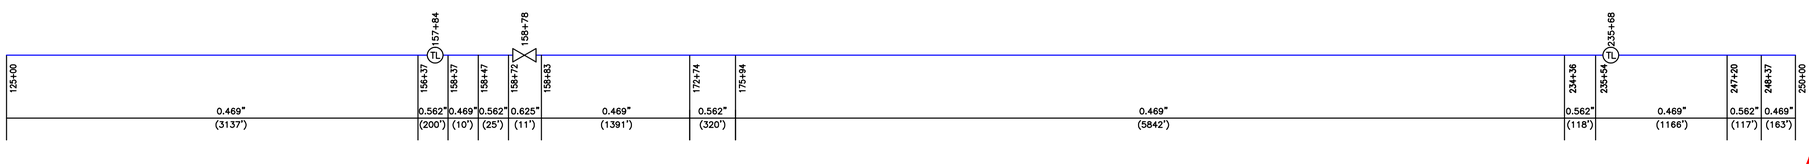

AS-BUILT

PIPE PROFILE
HORIZONTAL: 1" = 500'
VERTICAL: 1" = 100'

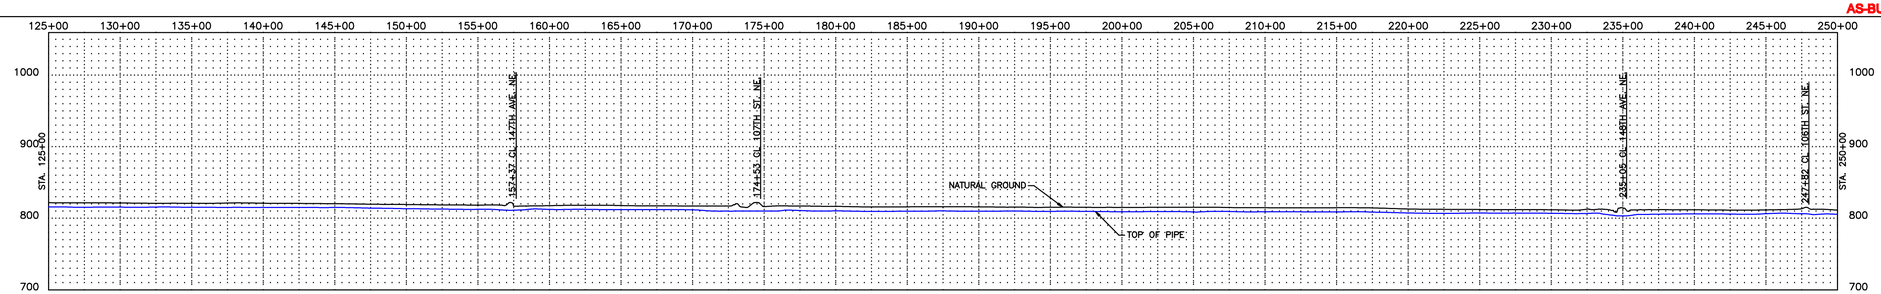

LEGEND

- INTERSTATE HIGHWAY
- US HIGHWAY
- STATE HIGHWAY
- CO. STATE AID HIGHWAYS
- COUNTY ROAD
- M. P. MARKER
- AERIAL M.P. MARKER
- CIVIL TOWNSHIP LINE
- FOREIGN PIPELINE
- SECTION LINES
- ROADS
- BURIED PHONE LINE
- BURIED POWER LINE
- OVERHEAD POWER LINE
- WATER LINE
- GAS LINE
- FIBER OPTIC CABLE LINE
- PROPERTY LINE
- RAILROADS
- WATER (RIVERS, STREAMS, CREEKS, DITCHES)
- ROCK SHIELD
- SET ON WEIGHTS
- CONCRETE COATING
- CASING
- MOTOR OPERATED VALVE
- GATE VALVE
- TEE
- STOPPLE TEE
- REPAIR SLEEVE
- RECTIFIER
- WELD PLUS
- TEST LEAD

NOTES:

ENBRIDGE ENERGY # 1-800-858-5253
(L.C.) – LAND CONTRACT
RRX – RAILROAD CROSSING
WX – WATER CROSSING
RX – ROAD CROSSING
LWA – LOW WET AREA
WL – WETLAND (SEE WETLAND DELINEATION DRAWINGS REPORT)
GOPHER STATE ONE-CALL 1-800-252-1166
ALL STATIONING IN TRUE (PIPE) LENGTH

FIELD BOOK	FIELD BOOK	FIELD BOOK

NO.	REFERENCE DRAWINGS

REVISION	DATE	APPR.

SCALE	DATE	DRAWN	APPROVED	APPROVED
1"=500'		MM	CN	

800 400 200 100 0 200 500 1000
SCALE IN FEET

ENBRIDGE

AS-BUILT ALIGNMENT
ALBERTA CLIPPER 36" PIPELINE
MP 776.1 TO MP 778.5
STA. 125+00 TO STA. 250+00
PEMBINA COUNTY, NORTH DAKOTA

DRAWING NUMBER	ROUTE SHEET
D-67-5.92-16921-002	002


CROSSING INFORMATION

XX" LINE MATERIALS

ALL PIPE IS XX" O.D.
API 5L-X-70 STEEL PIPE
FBE COATED

TRACT NUMBER		T-1101	T-1101-DD	T-1101	T-1100	T-1099	T-1098-RX 149TH AVE NE	T-1098	T-1097-RX 105TH ST NE	T-1097	T-1096	T-1095	T-1094	
LAND USE		CROP	DITCH	CROP			ROAD	CROP	ROAD	CROP				

PLAN
1" = 500'

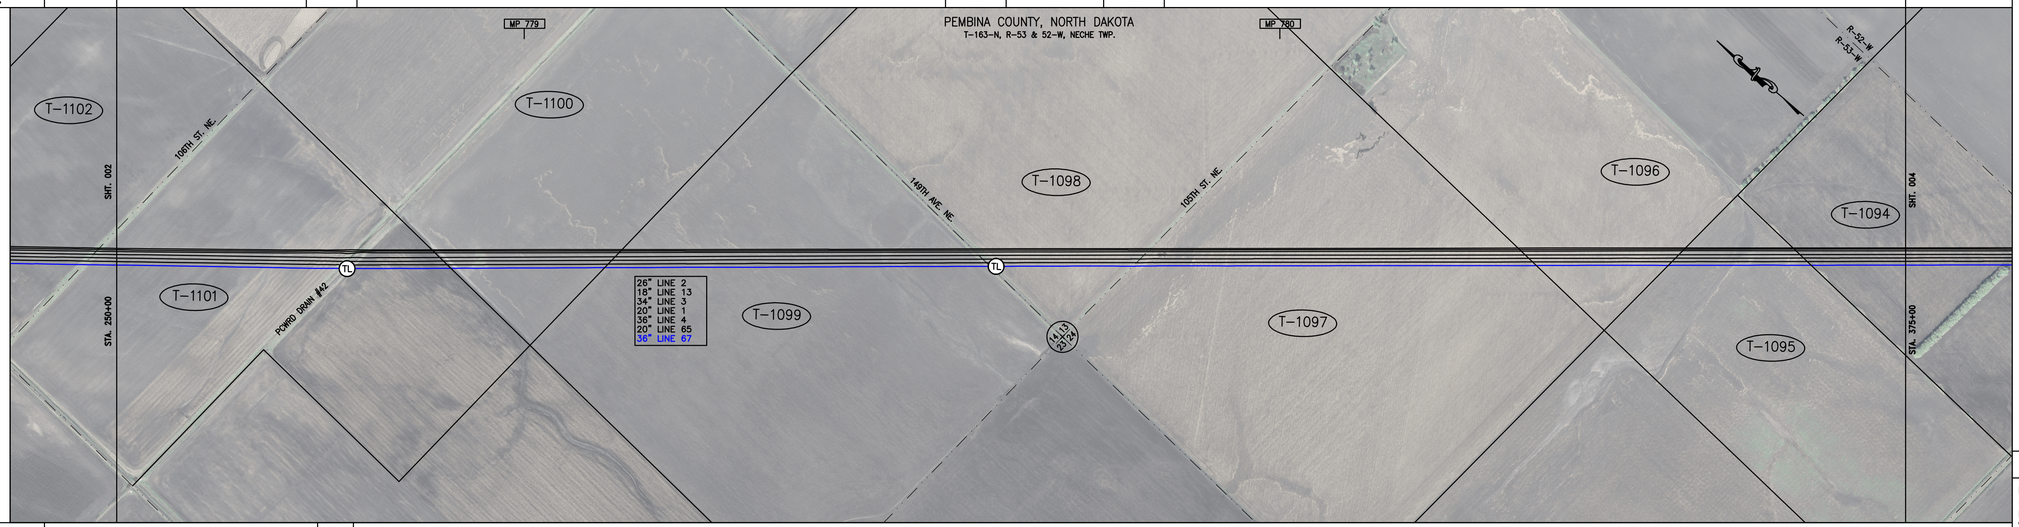

ENVIRONMENTAL


S-778A	

CROSSING INFORMATION

265+23	TOP OF BANK	
265+27	CROP LINE	
265+44	TOE OF BANK	
265+62	CL DITCH	
265+63	TOE OF BANK	CL POWRD DRAIN # 42
265+68	TOE OF BANK	
266+15	TOP OF BANK	
266+55	CROP LINE	
273+35	PROPERTY LINE	
284+11	PROPERTY LINE	
310+65	ROAD R-O-W	
310+75	TOP OF BANK	
310+82	CROP LINE	
310+87	TOP OF BANK	
310+91	SECTION LINE	149th AVE NE
311+03	TOE OF BANK	
311+17	TOP OF BANK	
311+51	ROAD R-O-W	
311+54	CROP LINE	
320+73	CROP LINE	
321+02	SECTION LINE	105th ST NE
321+10	CROP LINE	
321+08	CROP LINE	
349+20	PROPERTY LINE	
358+32	CROP LINE	
358+42	PROPERTY LINE	
368+29	CROP LINE	
368+40	PROPERTY LINE	


36" LINE MATERIALS

ALL PIPE IS 36" O.D.
API 5L-X-70 STEEL PIPE
FBE COATED

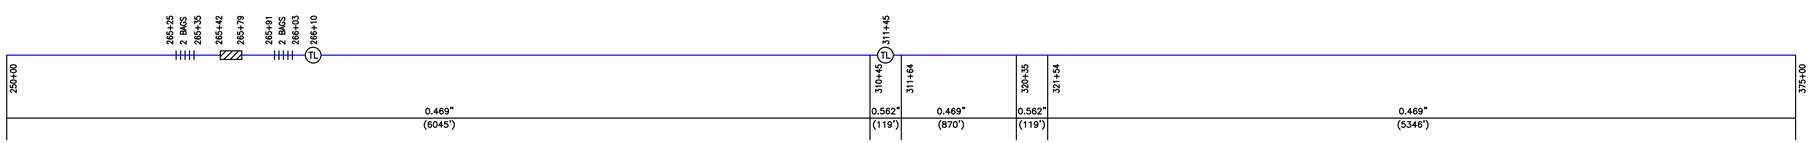

AS-BUILT

PIPE PROFILE
HORIZONTAL: 1" = 600'
VERTICAL: 1" = 100'

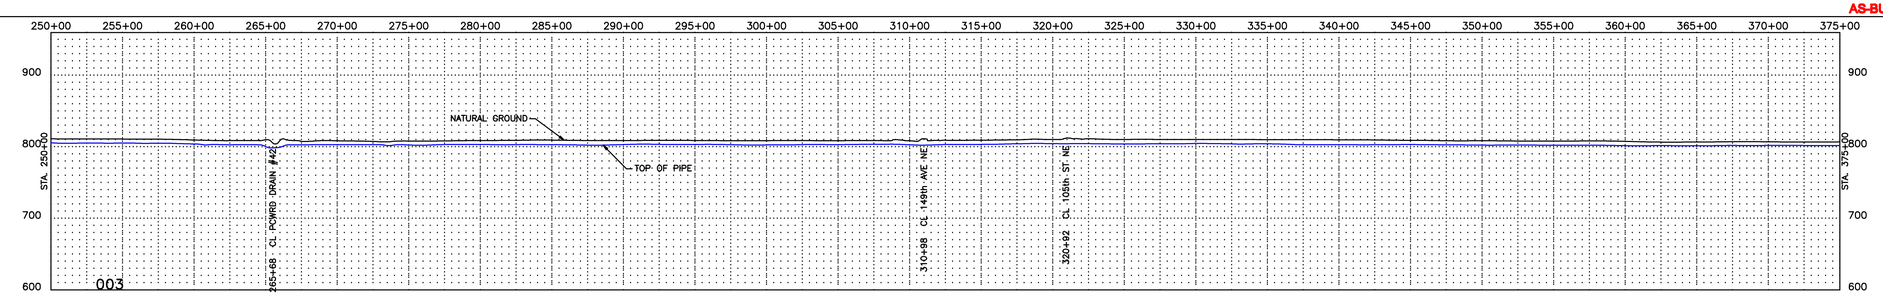

LEGEND

- INTERSTATE HIGHWAY
- US HIGHWAY
- STATE HIGHWAY
- CO. STATE AID HIGHWAYS
- COUNTY ROAD
- M. P. MARKER
- AERIAL M.P. MARKER
- CIVIL TOWNSHIP LINE
- FOREIGN PIPELINE
- SECTION LINES
- ROADS
- BURIED PHONE LINE
- BURIED POWER LINE
- OVERHEAD POWER LINE
- WATER LINE
- GAS LINE
- FIBER OPTIC CABLE LINE
- PROPERTY LINE
- RAILROADS
- WATER RIVERS, STREAMS, CREEKS, DITCHES
- ROCK SHIELD
- SET ON WEIGHTS
- CONCRETE COATING
- CASING
- MOTOR OPERATED VALVE
- GATE VALVE
- TEE
- STOPPLE TEE
- REPAIR SLEEVE
- RECTIFIER
- WELD PLUS
- TEST LEAD

NOTES:

ENBRIDGE ENERGY # 1-800-858-5253
(L.C.) – LAND CONTRACT
RRX – RAILROAD CROSSING
WX – WATER CROSSING
RX – ROAD CROSSING
LWA – LOW WET AREA
WL – WETLAND (SEE WETLAND DELINEATION DRAWINGS REPORT)
GOPHER STATE ONE-CALL 1-800-252-1166
ALL STATIONING IN TRUE (PIPE) LENGTH

FIELD BOOK	FIELD BOOK	FIELD BOOK

NO.	REFERENCE DRAWINGS

REVISION	DATE	APPR.

SCALE	DATE	DRAWN	APPROVED	APPROVED
1"=500'		MM	CN	

SCALE IN FEET

ENBRIDGE

AS-BUILT ALIGNMENT
ALBERTA CLIPPER 36" PIPELINE
MP 778.5 TO MP 780.8
STA. 250+00 TO STA. 375+00
PEMBINA COUNTY, NORTH DAKOTA

DRAWING NUMBER	ROUTE SHEET
D-67-5.92-16922-003	003


CROSSING INFORMATION

XX" LINE MATERIALS

ALL PIPE IS XX" O.D.
API 5L-X-70 STEEL PIPE
FBE COATED

TRACT NUMBER		T-1094		T-1093-RX 150TH AVE NE	T-1093	T-1092-RX 104TH ST NE	T-1092	T-1091	T-1090	T-1089-RX 151ST AVE NE	T-1089	T-1088-RX 103RD ST NE	T-1088	T-1088-DD	T-1088
LAND USE		CROP	TREES	ROAD		ROAD	CROP	OPEN	CROP	ROAD	OPEN	ROAD	OPEN	DITCH	CROP

PLAN
1" = 500'

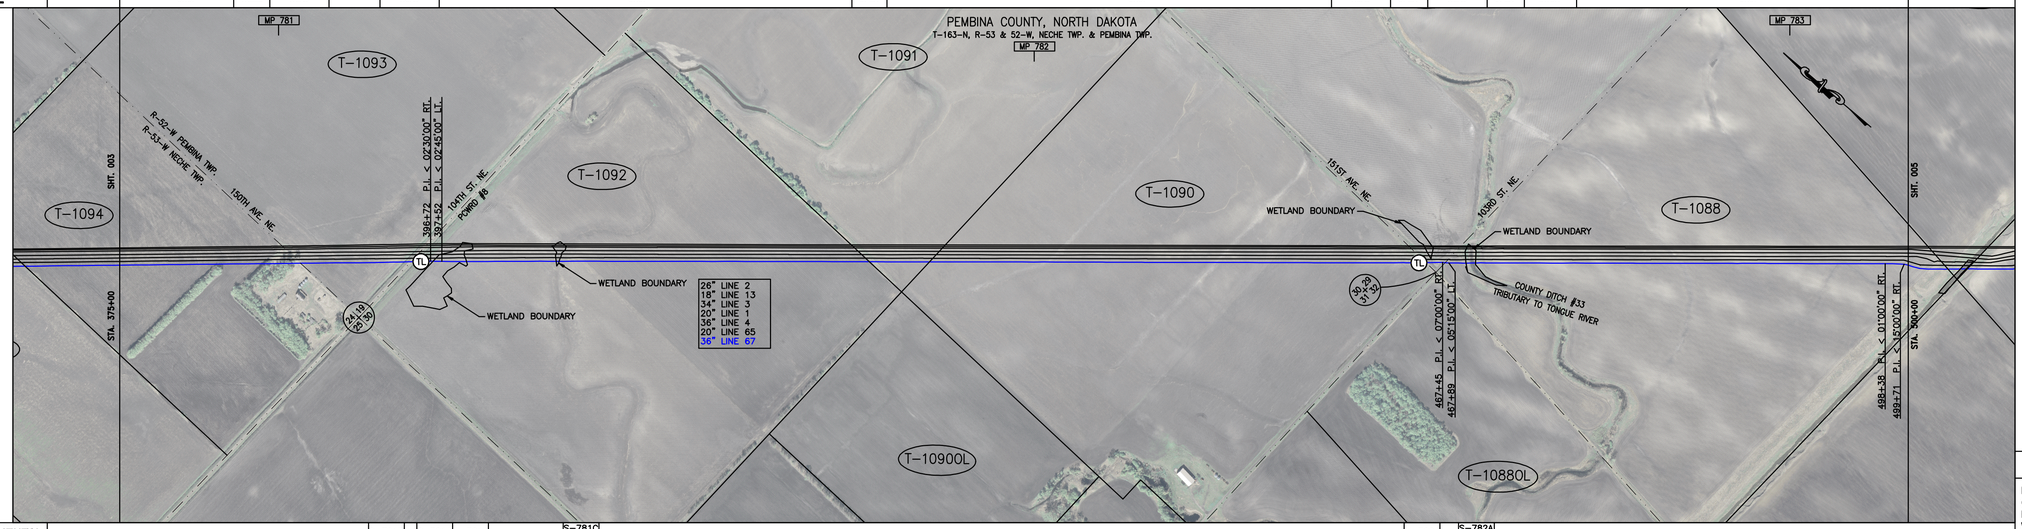

ENVIRONMENTAL		S-781B	S-781A W-781A	S-781C W-781B	W-782A	S-782A W-782B

CROSSING INFORMATION

| | | |


CROSSING INFORMATION

XX" LINE MATERIALS

ALL PIPE IS XX" O.D.
API 5L-X-70 STEEL PIPE
FBE COATED

TRACT NUMBER		T-1088	T-1086	T-1085-DD	T-1085	T-1084A-RX 152ND AVE NE	T-1084A	T-1083-RX 102ND ST NE	T-1083	T-1082	T-1080	T-1079-RX 101ST ST NE	T-1079		T-1079-RX 153RD ST NE	
LAND USE		CROP		DITCH	CROP	ROAD	CROP	ROAD	CROP			ROAD	CROP	OPEN	CROP	

PLAN
1" = 500'

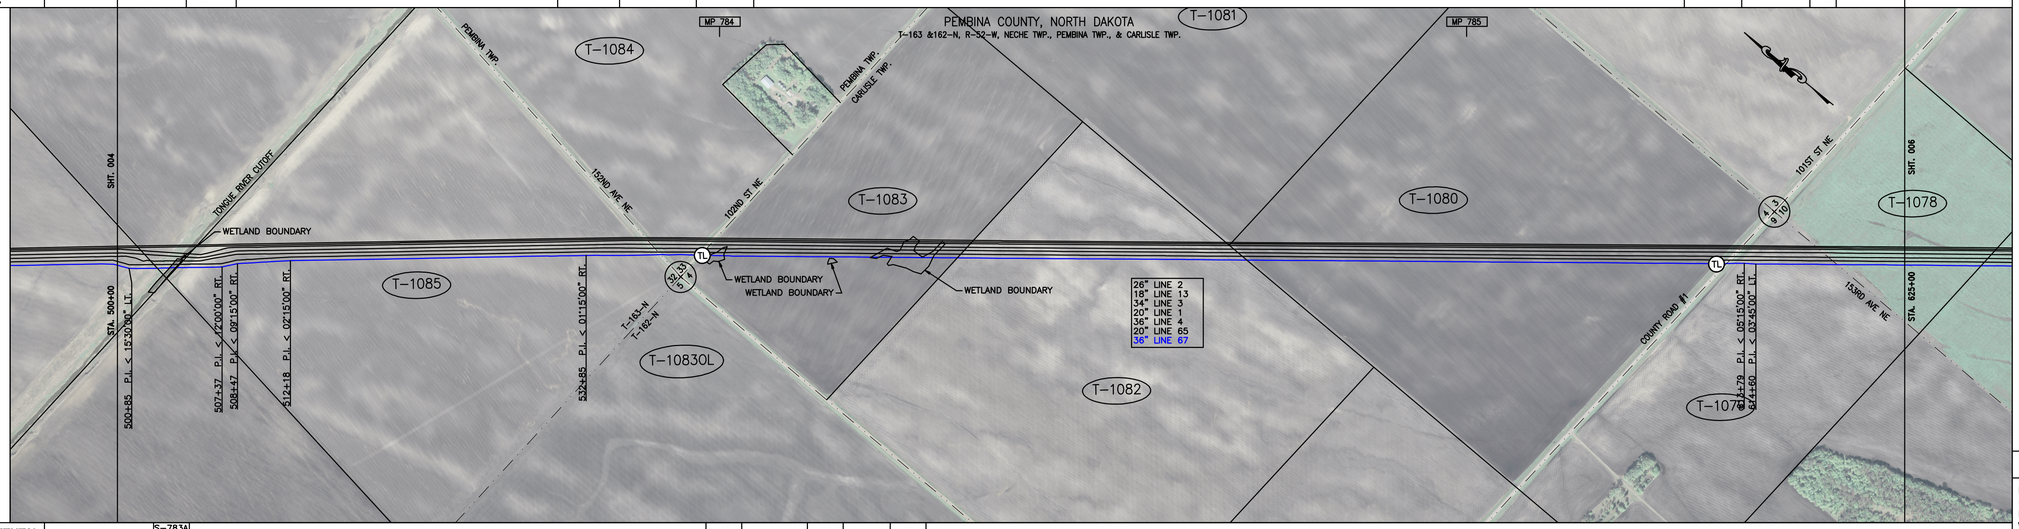

ENVIRONMENTAL

S-783A
W-783B
W-784A
W-784B
W-784C

CROSSING INFORMATION

500+85 P.I. < 15°30'00" LT.
501+44 CROP LINE
502+82 PROPERTY LINE
503+13 TOP OF BANK
503+45 EDGE OF WETLAND
503+68 EDGE OF WETLAND
503+75 EDGE OF WATER
503+89 CL TONGUE RIVER CUTOFF
503+89 EDGE OF WATER
503+89 TOE OF BANK
504+17 EDGE OF WETLAND
504+18 TOP OF BANK
504+18 PROPERTY LINE
505+00 CROP LINE

507+37 P.I. < 12°00'00" RT.
508+47 P.I. < 08°15'00" RT.
512+18 P.I. < 02°15'00" RT.

532+85 P.I. < 01°15'00" RT.

537+26 CROP LINE
537+41 POWER-PO ELECTRIC
537+45 TOP OF BANK
537+55 CL DITCH
537+78 CL 152ND AVE NE
537+96 SECTION LINE
538+05 TOE OF BANK
538+35 EDGE OF WETLAND
538+45 ROAD R-O-W
538+52 CROP LINE TELEPHONE LINE
538+52 ROAD R-O-W
540+24 CROP LINE
540+27 POWER-PO ELECTRIC
540+29 TOP OF BANK
540+49 CL DITCH
540+74 CL 102nd ST NE
540+83 SECTION LINE
540+97 TOE OF BANK
541+16 EDGE OF WETLAND
541+45 ROAD R-O-W
542+76 EDGE OF WETLAND
552+76 EDGE OF WETLAND
553+29 EDGE OF WETLAND

554+18 EDGE OF WETLAND

557+08 EDGE OF WETLAND

558+79 PROPERTY LINE
558+89 CROP LINE


578+82 CROP LINE
579+01 PROPERTY LINE

611+64 ROAD R-O-W
611+78 CROP LINE
612+00 CL DITCH
612+03 CL COUNTY ROAD
612+51 EDGE OF ROAD
613+15 CL DITCH
613+42 ROAD R-O-W
614+60 P.I. < 02°45'00" LT.

619+69 ROAD R-O-W
620+09 CROP LINE
620+15 CL 153RD AVE NE
620+27 SECTION LINE
620+47 ROAD R-O-W
625+71 ROAD R-O-W


36" LINE MATERIALS

ALL PIPE IS 36" O.D.
API 5L-X-70 STEEL PIPE
FBE COATED

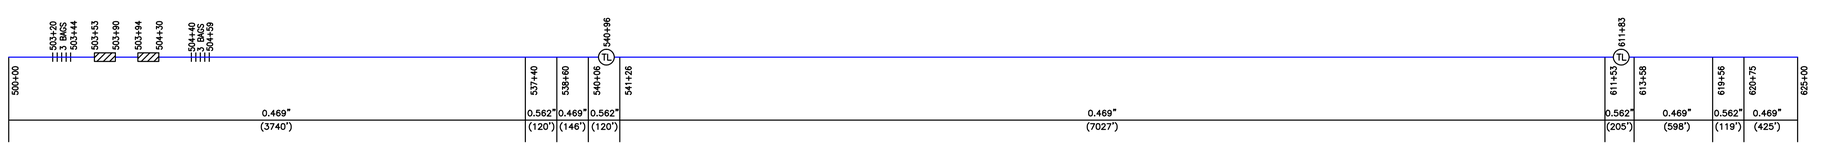

AS-BUILT

PIPE PROFILE
HORIZONTAL: 1" = 800'
VERTICAL: 1" = 100'

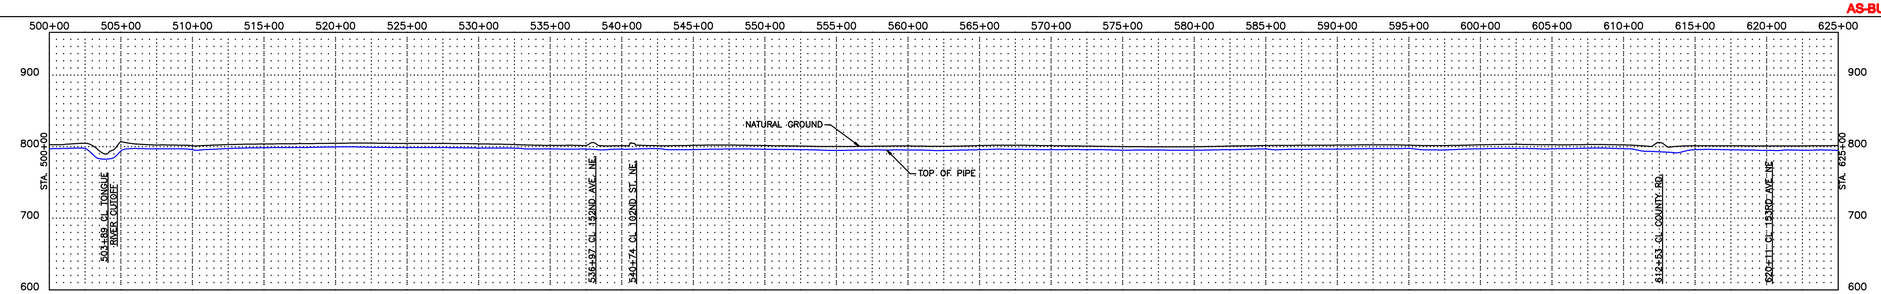

LEGEND

- INTERSTATE HIGHWAY
- US HIGHWAY
- STATE HIGHWAY
- CO. STATE AID HIGHWAYS
- COUNTY ROAD
- M. P. MARKER
- AERIAL M.P. MARKER
- CIVIL TOWNSHIP LINE
- FOREIGN PIPELINE
- SECTION LINES
- ROADS
- BURIED PHONE LINE
- BURIED POWER LINE
- OVERHEAD POWER LINE
- WATER LINE
- GAS LINE
- FIBER OPTIC CABLE LINE
- PROPERTY LINE
- RAILROADS
- WATER (RIVERS, STREAMS, CREEKS, DITCHES)
- ROCK SHIELD
- SET ON WEIGHTS
- CONCRETE COATING
- CASING
- MOV — MOTOR OPERATED VALVE
- GATE VALVE
- TEE
- STOPPLE TEE
- REPAIR SLEEVE
- R — RECTIFIER
- WELD PLUS
- TL — TEST LEAD

NOTES:

ENBRIDGE ENERGY # 1-800-858-5253
(L.C.) – LAND CONTRACT
RRX – RAILROAD CROSSING
WX – WATER CROSSING
RX – ROAD CROSSING
LWA – LOW WET AREA
WL – WETLAND (SEE WETLAND DELINEATION DRAWINGS REPORT)
GOPHER STATE ONE–CALL 1-800-252-1166
ALL STATIONING IN TRUE (PIPE) LENGTH

FIELD BOOK	FIELD BOOK	FIELD BOOK

NO.	REFERENCE DRAWINGS

REVISION	DATE	APPR.

SCALE	DATE	DRAWN	APPROVED	APPROVED
1"=500'		MM	CN	

800 400 300 200 100 0 200 500 1000
SCALE IN FEET

ENBRIDGE

AS–BUILT ALIGNMENT
ALBERTA CLIPPER 36" PIPELINE
MP 783.2 TO MP 785.6
STA. 500+00 TO STA. 625+00
PEMBINA COUNTY, NORTH DAKOTA

DRAWING NUMBER	ROUTE SHEET
D–67–5.92–16924–005	005


CROSSING INFORMATION

XX" LINE MATERIALS

ALL PIPE IS XX" O.D.
API 5L-X-70 STEEL PIPE
FBE COATED

TRACT NUMBER	T-1078	T-1077	T-1076	T-1075	T-1074	T-1072-RX 100TH ST NE	T-1072	T-1071A-RX 154TH AVE NE	T-1071A	T-1071	T-1070
LAND USE	CROP			OPEN RIVER OPEN	CROP	ROAD	CROP	ROAD	CROP	OPEN	CROP

PLAN
1" = 500'

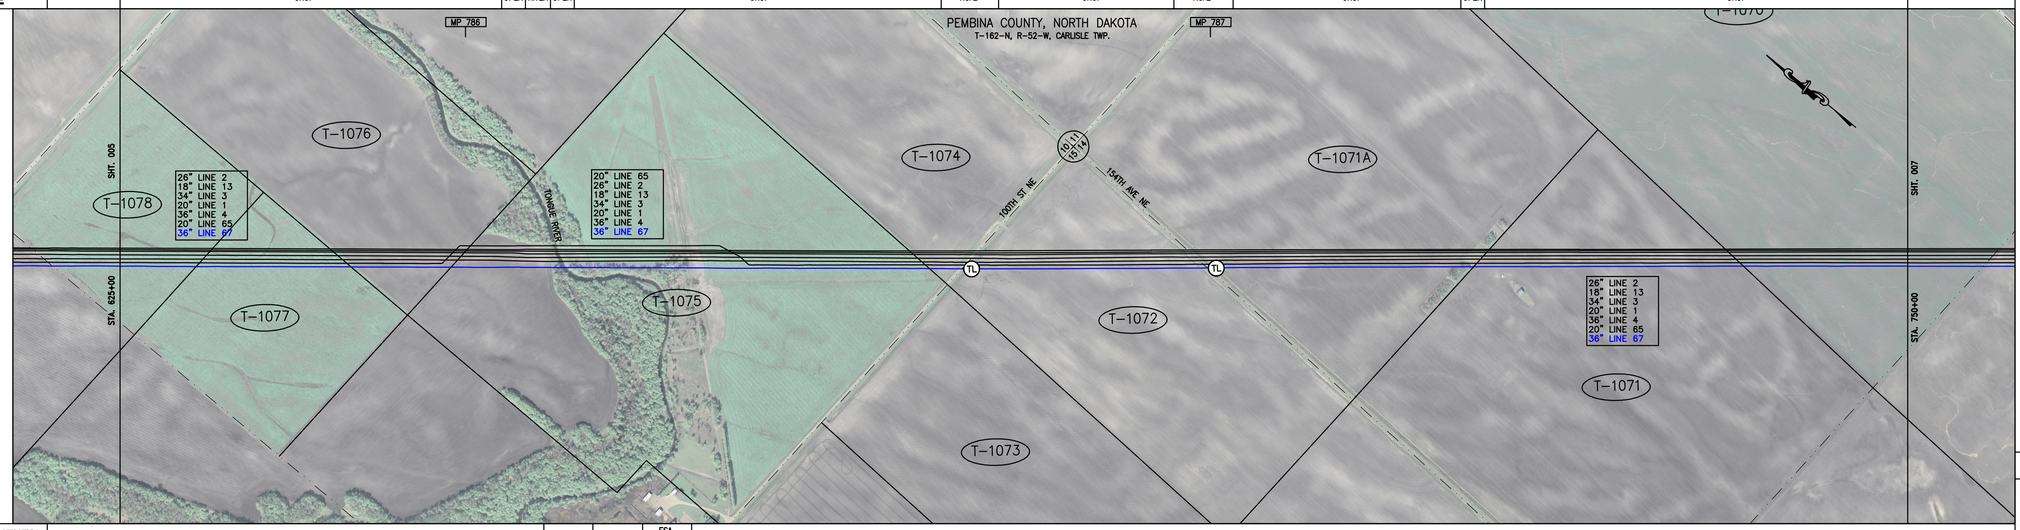


ENVIRONMENTAL		S-786A		ESA #786.2

CROSSING INFORMATION

630+32 PROPERTY LINE
641+14 PROPERTY LINE
641+55 CROP LINE
648+12 PROPERTY LINE
655+56 TOP OF BANK
655+98 EDGE OF WATER
656+05 CL TONGUE RIVER
656+10 EDGE OF WATER
656+46 TOP OF BANK
680+22 BURIED TELEPHONE
681+66 PROPERTY LINE
683+32 CROP LINE
683+42 ROAD R-O-W
683+52 CL DITCH
683+78 EDGE OF ROAD
683+82 CL 100th ST NE
683+93 SECTION LINE
684+05 EDGE OF ROAD
684+07 ROAD R-O-W
684+39 CL DITCH
684+65 CROP LINE
700+37 CROP LINE
700+61 TOP OF BANK
700+71 ROAD R-O-W
701+09 CL DITCH
701+11 CL 154th AVE NE
701+51 EDGE OF ROAD
701+52 CL DITCH
701+65 ROAD R-O-W
701+66 TOP OF BANK
701+72 CROP LINE
719+69 PROPERTY LINE
738+55 PROPERTY LINE


36" LINE MATERIALS

ALL PIPE IS 36" O.D.
API 5L-X-70 STEEL PIPE
FBE COATED

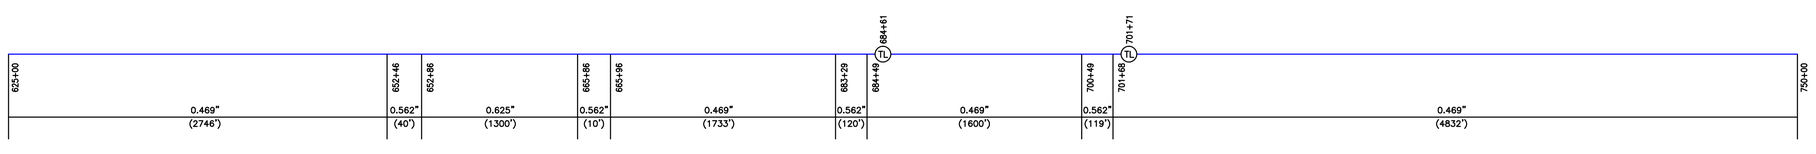

AS-BUILT

PIPE PROFILE
HORIZONTAL: 1" = 600'
VERTICAL: 1" = 100'

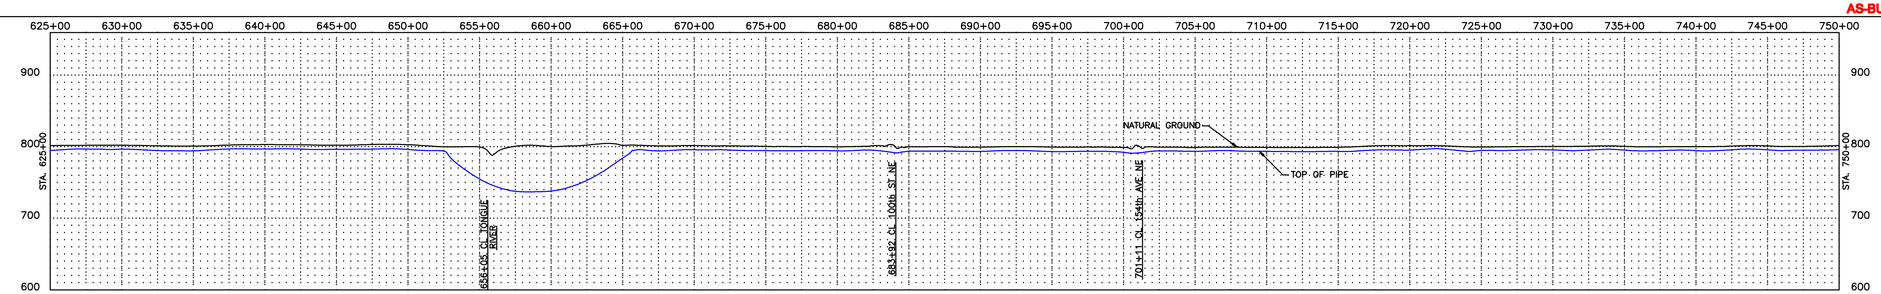

LEGEND

- INTERSTATE HIGHWAY
- US HIGHWAY
- STATE HIGHWAY
- CO. STATE AID HIGHWAYS
- COUNTY ROAD
- M. P. MARKER
- AERIAL M.P. MARKER
- CIVIL TOWNSHIP LINE
- FOREIGN PIPELINE
- SECTION LINES
- ROADS
- BURIED PHONE LINE
- BURIED POWER LINE
- OVERHEAD POWER LINE
- WATER LINE
- GAS LINE
- FIBER OPTIC CABLE LINE
- PROPERTY LINE
- RAILROADS
- WATER RIVERS, STREAMS, CREEKS, DITCHES
- ROCK SHIELD
- SET ON WEIGHTS
- CONCRETE COATING
- CASING
- MOTOR OPERATED VALVE
- GATE VALVE
- TEE
- STOPPLE TEE
- REPAIR SLEEVE
- RECTIFIER
- WELD PLUS
- TEST LEAD

NOTES:

ENBRIDGE ENERGY # 1-800-858-5253
(L.C.) – LAND CONTRACT
RRX – RAILROAD CROSSING
WX – WATER CROSSING
RX – ROAD CROSSING
LWA – LOW WET AREA
WL – WETLAND (SEE WETLAND DELINEATION DRAWINGS REPORT)
GOPHER STATE ONE-CALL 1-800-252-1166
ALL STATIONING IN TRUE (PIPE) LENGTH

FIELD BOOK	FIELD BOOK	FIELD BOOK

NO.	REFERENCE DRAWINGS

REVISION	DATE	APPR.

SCALE	DATE	DRAWN	APPROVED	APPROVED
1"=500'		MM	CN	

800 400 200 100 0 200 500 1000
SCALE IN FEET

ENBRIDGE

AS-BUILT ALIGNMENT
ALBERTA CLIPPER 36" PIPELINE
MP 785.6 TO MP 787.9
STA. 625+00 TO STA. 750+00
PEMBINA COUNTY, NORTH DAKOTA

DRAWING NUMBER	ROUTE SHEET
D-67-5.92-16925-006	006


CROSSING INFORMATION

XX" LINE MATERIALS

ALL PIPE IS XX" O.D.
API 5L-X-70 STEEL PIPE
FBE COATED

TRACT NUMBER	T-1070	T-1069	T-1069A	T-1068-RX 155TH AVE NE	T-1068A	T-1068	T-1067A	T-1067	T-1067B	T-1066	T-1065-RX 98TH ST NE	T-1065	T-1064
LAND USE	CROP / OPEN	CROP		ROAD	CROP						ROAD	CROP / OPEN	CROP

PLAN
1" = 500'

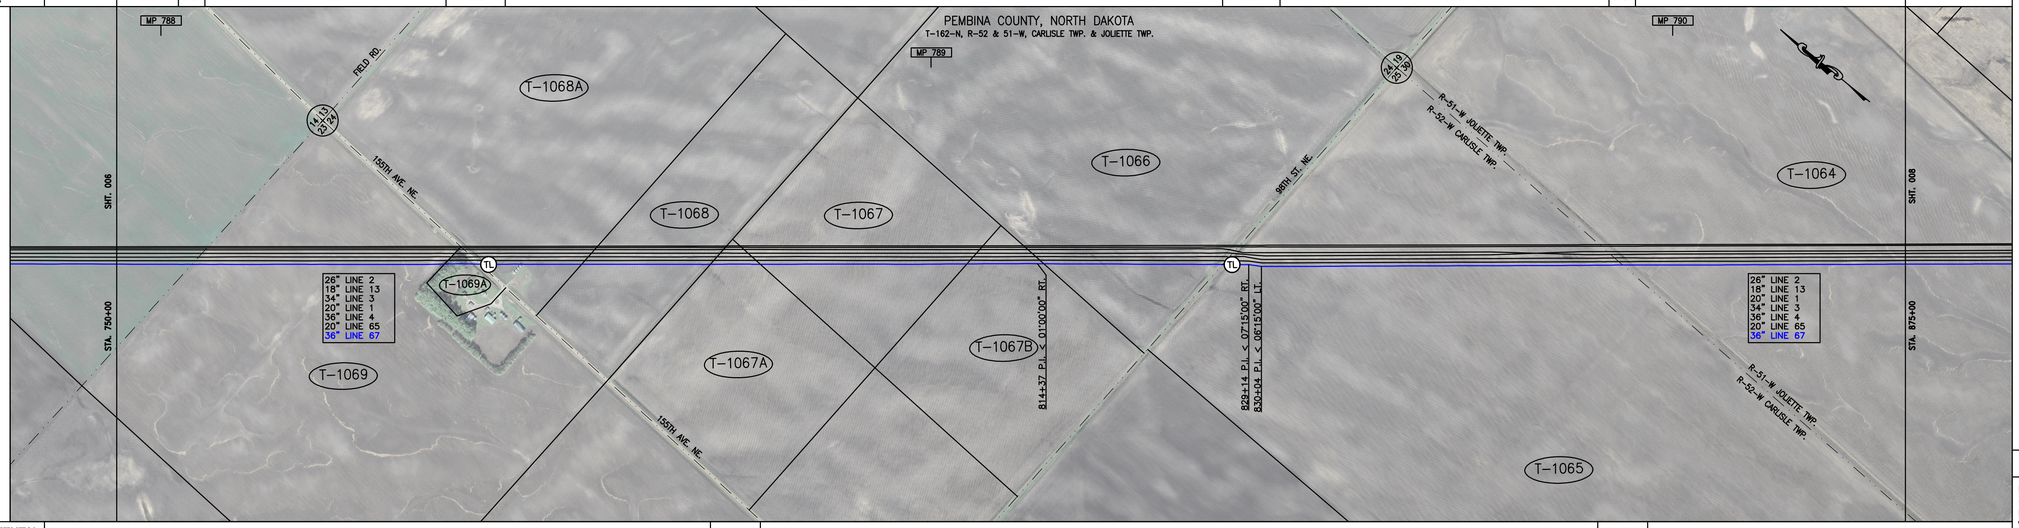

ENVIRONMENTAL S-788A S-790B

CROSSING INFORMATION

| | | | | | |


CROSSING INFORMATION

XX" LINE MATERIALS

ALL PIPE IS XX" O.D.
API 5L-X-70 STEEL PIPE
FBE COATED

TRACT NUMBER		T-1064	T-1063	T-1062-RX 97TH ST NE	T-1062	T-1060	T-1058-RX STATE HWY 5	T-1058	T-1057	
LAND USE		CROP	OPEN	ROAD	OPEN		ROAD	OPEN		

PLAN
1" = 500'

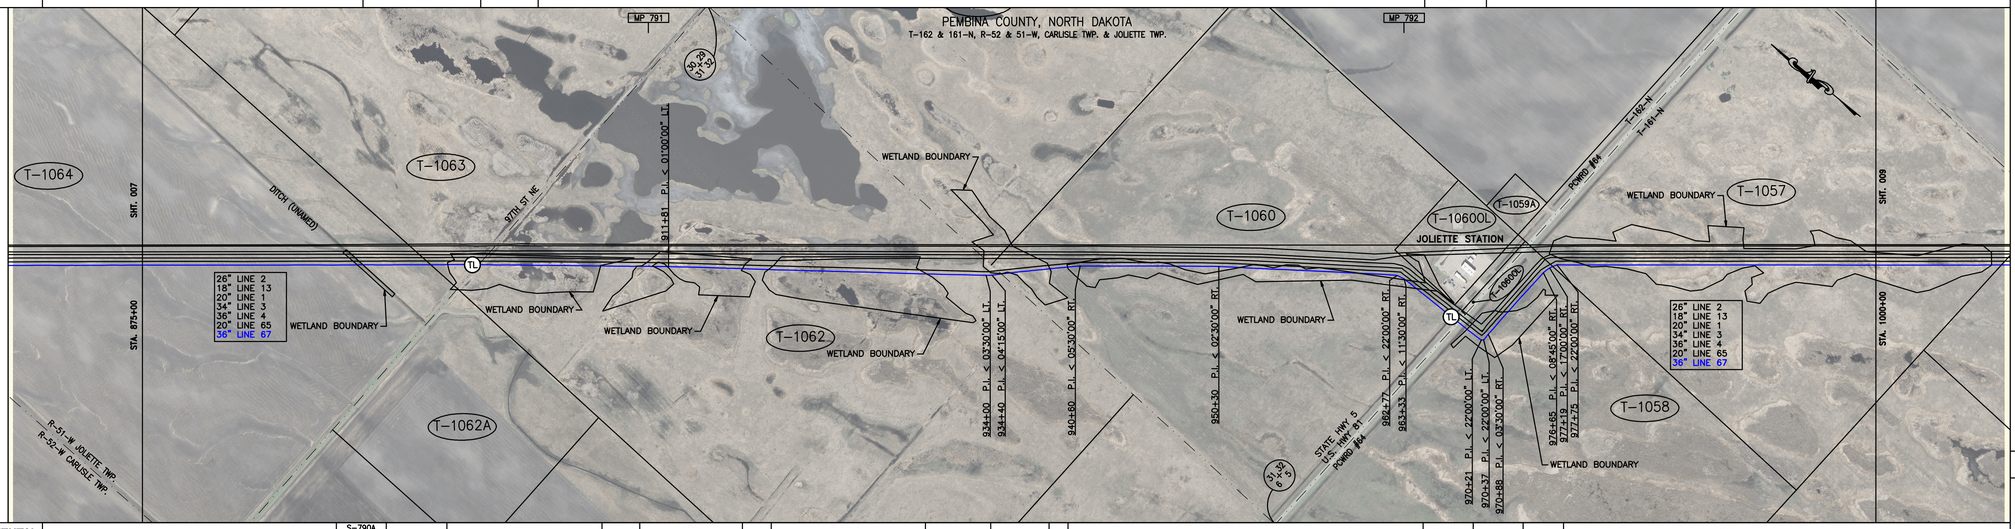

ENVIRONMENTAL


S-790A W-790B	W-790A	W-791D	W-791C	W-791A	W-791B	S-792A	W-792A	W-792B		

CROSSING INFORMATION


885+14 CROP LINE	889+88 CROP LINE	890+14 EDGE OF WETLAND	890+25 TOP OF BANK (UNNAMED)	890+45 BOTTOM OF DITCH	890+56 TOP OF BANK	896+19 PROPERTY LINE	896+38 EDGE OF WETLAND	898+07 ROAD R-O-W	898+14 TOP OF BANK	898+34 TOP OF BANK
898+44 CL DITCH (UNNAMED)	898+54 CL OF ST NE	898+55 PROPERTY LINE	898+58 EDGE OF ROAD	898+70 EDGE OF BANK	898+83 CL DITCH (UNNAMED)	898+96 TOP OF BANK	899+06 FENCE	899+08 CROP LINE	907+06 EDGE OF WETLAND	909+76 EDGE OF WETLAND
910+72 EDGE OF WETLAND	911+81 P.I. < 01°00'00" LT.	916+97 EDGE OF WETLAND	918+78 EDGE OF WETLAND	929+86 EDGE OF WETLAND	934+00 P.I. < 03°30'00" LT.	934+40 P.I. < 04°15'00" LT.	935+06 PROPERTY LINE	935+08 SECTION LINE	935+88 EDGE OF WETLAND	936+43 EDGE OF WETLAND
939+72 EDGE OF WETLAND	940+60 P.I. < 05°30'00" RT.	947+27 EDGE OF WETLAND	950+30 P.I. < 02°30'00" RT.	951+77 EDGE OF WETLAND	960+10 EDGE OF WETLAND	962+77 P.I. < 22°00'00" RT.	963+33 P.I. < 11°30'00" RT.	964+41 EDGE OF WETLAND	965+00 BURIED TELEPHONE LINE	967+16 ROAD R-O-W
967+18 TOP OF BANK	967+53 BURIED TELEPHONE LINE	967+83 CL DITCH	968+02 EDGE OF ROAD	968+17 SECTION LINE	968+29 EDGE OF ROAD	968+34 TOP OF BANK	968+74 CL DITCH	968+85 EDGE OF WETLAND	969+05 TOP OF BANK	969+16 ROAD R-O-W
970+21 P.I. < 22°00'00" LT.	970+37 P.I. < 22°00'00" RT.	970+88 P.I. < 03°30'00" RT.	971+37 WATER LINE	972+89 EDGE OF WETLAND	973+03 EDGE OF WETLAND	976+65 P.I. < 08°45'00" RT.	977+19 P.I. < 22°00'00" RT.	977+25 P.I. < 22°00'00" RT.	977+73 EDGE OF WETLAND	

36" LINE MATERIALS

ALL PIPE IS 36" O.D.
API 5L-X-70 STEEL PIPE
FBE COATED

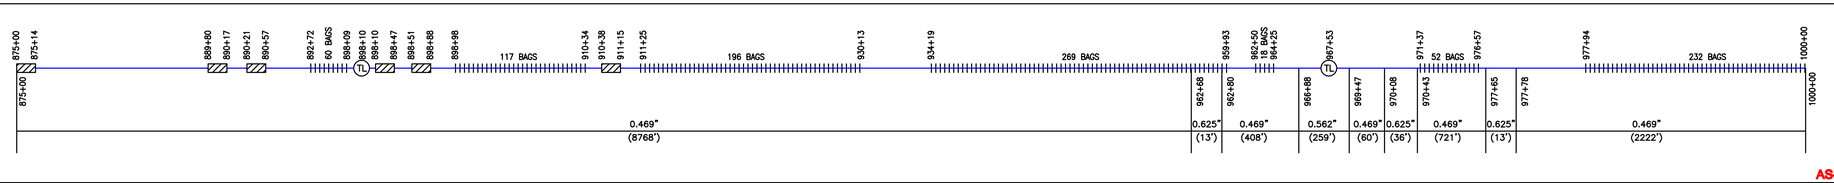

PIPE PROFILE
HORIZONTAL: 1" = 800'
VERTICAL: 1" = 100'

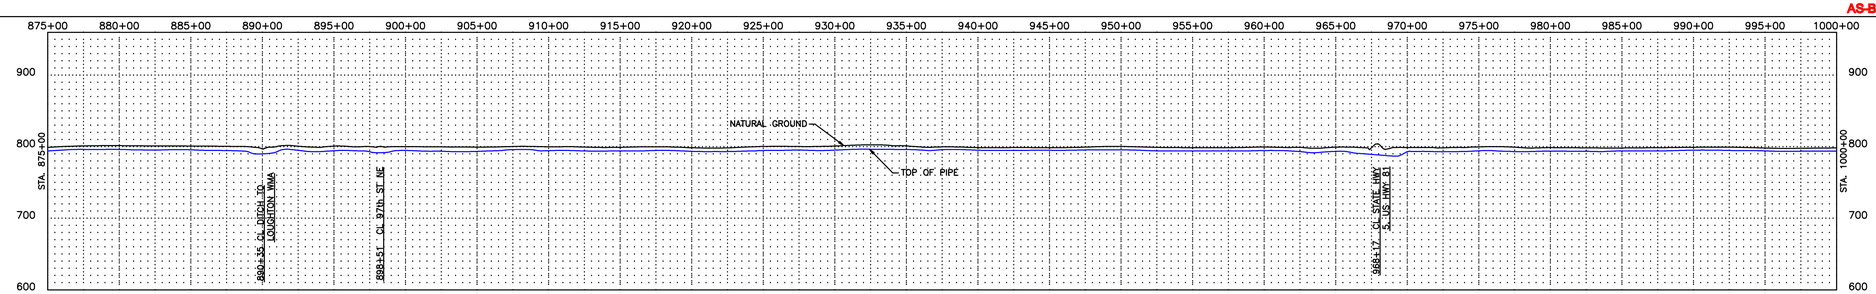

LEGEND

- INTERSTATE HIGHWAY
- US HIGHWAY
- STATE HIGHWAY
- CO. STATE AID HIGHWAYS
- COUNTY ROAD
- M. P. MARKER
- AERIAL M.P. MARKER
- CIVIL TOWNSHIP LINE
- FOREIGN PIPELINE
- SECTION LINES
- ROADS
- BURIED PHONE LINE
- BURIED POWER LINE
- OVERHEAD POWER LINE
- WATER LINE
- GAS LINE
- FIBER OPTIC CABLE LINE
- PROPERTY LINE
- RAILROADS
- WATER RIVERS, STREAMS, CREEKS, DITCHES
- ROCK SHIELD
- SET ON WEIGHTS
- CONCRETE COATING
- CASING
- MOV MOTOR OPERATED VALVE
- GATE VALVE
- TEE
- STOPPLE TEE
- REPAIR SLEEVE
- RECTIFIER
- WELD PLUS
- TL TEST LEAD

NOTES:

ENBRIDGE ENERGY # 1-800-858-5253
(L.C.) – LAND CONTRACT
RRX – RAILROAD CROSSING
WX – WATER CROSSING
RX – ROAD CROSSING
LWA – LOW WET AREA
WL – WETLAND (SEE WETLAND DELINEATION DRAWINGS REPORT)
GOPHER STATE ONE-CALL 1-800-252-1166
ALL STATIONING IN TRUE (PIPE) LENGTH

FIELD BOOK	FIELD BOOK	FIELD BOOK

NO.	REFERENCE DRAWINGS

REVISION	DATE	APPR.

SCALE	DATE	DRAWN	APPROVED	APPROVED
1"=500'		MM	CN	

SCALE IN FEET

ENBRIDGE

AS-BUILT ALIGNMENT
ALBERTA CLIPPER 36" PIPELINE
MP 790.3 TO MP 792.7
STA. 875+00 TO STA. 1000+00
PEMBINA COUNTY, NORTH DAKOTA

DRAWING NUMBER	ROUTE SHEET
D-67-5.92-16927-008	008


CROSSING INFORMATION

XX" LINE MATERIALS

ALL PIPE IS XX" O.D.
API 5L-X-70 STEEL PIPE
FBE COATED

TRACT NUMBER		T-1057	T-1057A	T-1056A-RX 158TH AVE NE	T-1056A	T-1056	T-1055-RX 95TH ST NE	T-1055	T-1054	T-1053	T-1052-RX 159TH AVE NE	T-1052	T-1051-RX 94TH ST NE	T-1051	
LAND USE		OPEN		ROAD	CROP		ROAD	CROP			ROAD	CROP	ROAD	CROP	

PLAN
1" = 500'

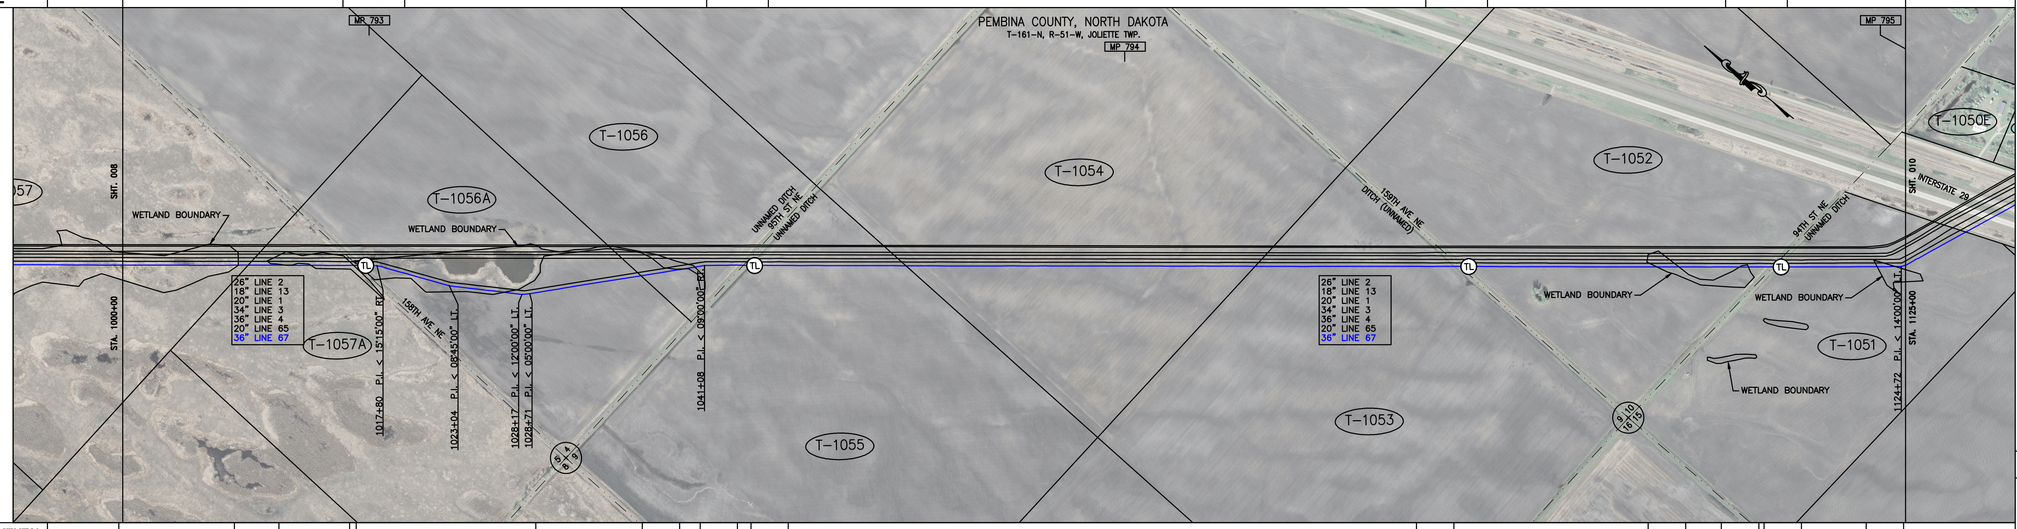


ENVIRONMENTAL		W-792B		W-792C	W-793A		W-793A	S-793B	S-793A		S-794A		W-794A	W-794A	S-794B		W-795A

CROSSING INFORMATION

1008+11 EDGE OF WETLAND
1008+81 PROPERTY LINE
1013+19 EDGE OF WETLAND
1013+96 TOP OF BANK
1015+96 CL DITCH
1016+21 ROAD R-O-W
1016+43 TOP OF BANK
1016+44 PROPERTY LINE
1016+52 CL 158th AVE NE
1016+52 EDGE OF WETLAND
1016+61 EDGE OF WETLAND
1016+84 TOP OF BANK
1017+03 CL DITCH
1017+12 ROAD R-O-W
1017+80 TOP OF BANK
1017+80 CROP LINE
1017+80 P.I. < 15°15'00" RT.
1023+04 P.I. < 08°45'00" LT.
1028+91 EDGE OF WETLAND
1028+17 P.I. < 12°00'00" LT.
1028+71 P.I. < 05°00'00" LT.
1036+58 PROPERTY LINE
1039+66 EDGE OF WETLAND
1040+39 EDGE OF WETLAND
1041+08 P.I. < 09°00'00" RT.
1043+11 CROP LINE
1043+12 ROAD R-O-W
1043+52 CL DITCH (UNNAMED)
1043+79 EDGE OF ROAD
1043+88 SECTION LINE
1043+97 CL 95th ST NE
1044+10 TOP OF BANK
1044+39 CL DITCH (UNNAMED)
1044+55 TOP OF BANK
1044+60 CROP LINE
1055+15 PROPERTY LINE
1073+51 CL DITCH
1079+56 PROPERTY LINE
1093+23 CROP LINE
1093+30 TOP OF BANK
1093+42 CL DITCH (UNNAMED)
1093+76 EDGE OF ROAD
1093+86 SECTION LINE
1093+99 CL 94th ST NE
1094+08 TOP OF BANK
1094+35 ROAD R-O-W
1094+48 CROP LINE
1107+63 EDGE OF WETLAND
1109+18 EDGE OF WETLAND
1113+41 EDGE OF WETLAND
1114+03 EDGE OF WETLAND
1115+28 TOP OF BANK
1115+29 ROAD R-O-W
1115+62 EDGE OF ROAD
1115+75 SECTION LINE
1115+85 EDGE OF ROAD
1115+95 CL DITCH (UNNAMED)
1116+21 ROAD R-O-W
1116+31 TOP OF BANK
1116+32 CROP LINE
1123+02 EDGE OF WETLAND
1124+30 EDGE OF WETLAND
1124+72 P.I. < 14°00'00" LT.


36" LINE MATERIALS

ALL PIPE IS 36" O.D.
API 5L-X-70 STEEL PIPE
FBE COATED

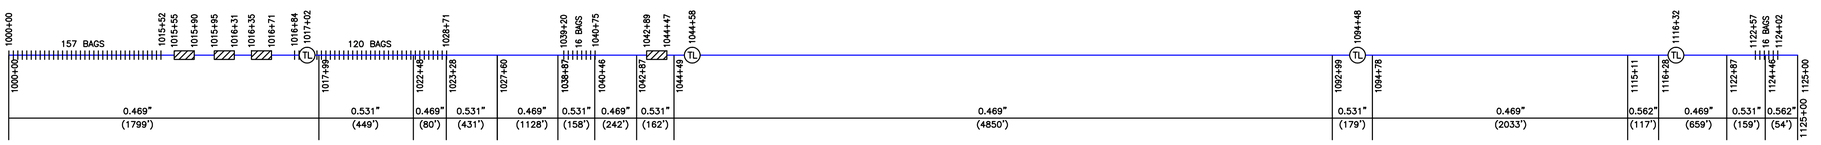

AS-BUILT

PIPE PROFILE
HORIZONTAL: 1" = 800'
VERTICAL: 1" = 100'

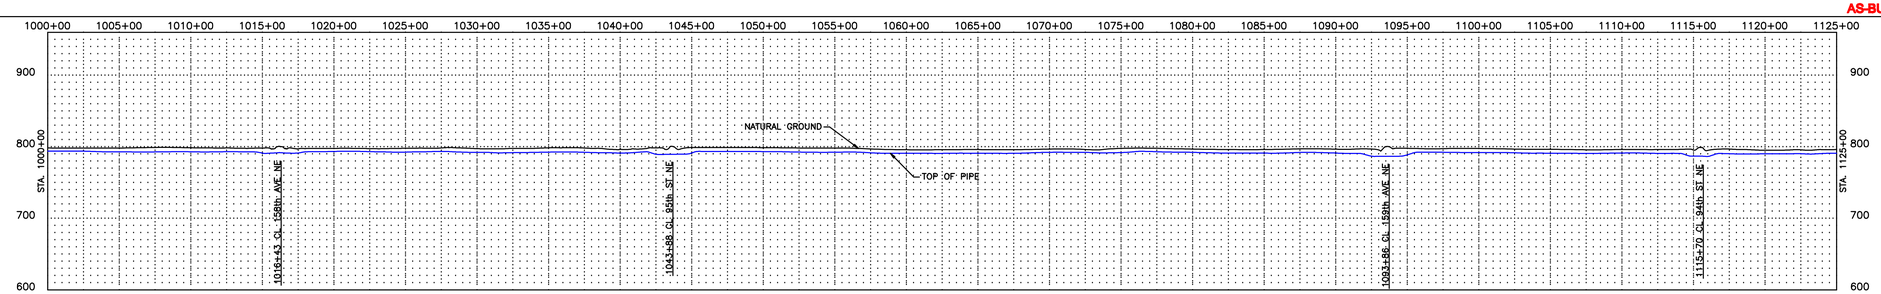

LEGEND

- INTERSTATE HIGHWAY
- US HIGHWAY
- STATE HIGHWAY
- CO. STATE AID HIGHWAYS
- COUNTY ROAD
- M. P. MARKER
- AERIAL M.P. MARKER
- CIVIL TOWNSHIP LINE
- FOREIGN PIPELINE
- SECTION LINES
- ROADS
- BURIED PHONE LINE
- BURIED POWER LINE
- OVERHEAD POWER LINE
- WATER LINE
- GAS LINE
- FIBER OPTIC CABLE LINE
- PROPERTY LINE
- RAILROADS
- WATER RIVERS, STREAMS, CREEKS, DITCHES
- ROCK SHIELD
- SET ON WEIGHTS
- CONCRETE COATING
- CASING
- MOV MOTOR OPERATED VALVE
- GATE VALVE
- TEE
- STOPPLE TEE
- REPAIR SLEEVE
- RECTIFIER
- WELD PLUS
- TL TEST LEAD

NOTES:

ENBRIDGE ENERGY # 1-800-858-5253
(L.C.) – LAND CONTRACT
RRX – RAILROAD CROSSING
WX – WATER CROSSING
RX – ROAD CROSSING
LWA – LOW WET AREA
WL – WETLAND (SEE WETLAND DELINEATION DRAWINGS REPORT)
GOPHER STATE ONE–CALL 1-800-252-1166
ALL STATIONING IN TRUE (PIPE) LENGTH

FIELD BOOK	FIELD BOOK	FIELD BOOK

NO.	REFERENCE DRAWINGS

	REVISION	DATE	APPR.

SCALE	DATE	DRAWN	APPROVED	APPROVED
1"=500'		MM	CN	

800 400 200 100 0 200 500 1000
SCALE IN FEET

ENBRIDGE

AS-BUILT ALIGNMENT
ALBERTA CLIPPER 36" PIPELINE
MP 792.7 TO MP 795.0
STA. 1000+00 TO STA. 1125+00
PEMBINA COUNTY, NORTH DAKOTA

DRAWING NUMBER	ROUTE SHEET
D-67-59.2-16928-009	009


CROSSING INFORMATION

XX" LINE MATERIALS

ALL PIPE IS XX" O.D.
API 5L-X-70 STEEL PIPE
FBE COATED

TRACT NUMBER		T-1051	T-1050B-1-RX I-29	T-1050B-RR R.R. R-O-W	T-1050B-RX OLD HWY 44	T-1050B	T-1050A	T-1050	T-1049-DD	T-1049	T-1047-RX 160TH AVE NE	T-1067	T-1045-RX 93RD ST NE	T-1045	T-1044	T-1044A-DD	T-1044A	T-1043-RX 161ST AVE NE	T-1043	
LAND USE		CROP	ROAD	RAILROAD	ROAD	CROP			DITCH	CROP	ROAD	CROP	ROAD	CROP		DITCH	CROP	ROAD	CROP	

PLAN
1" = 500'

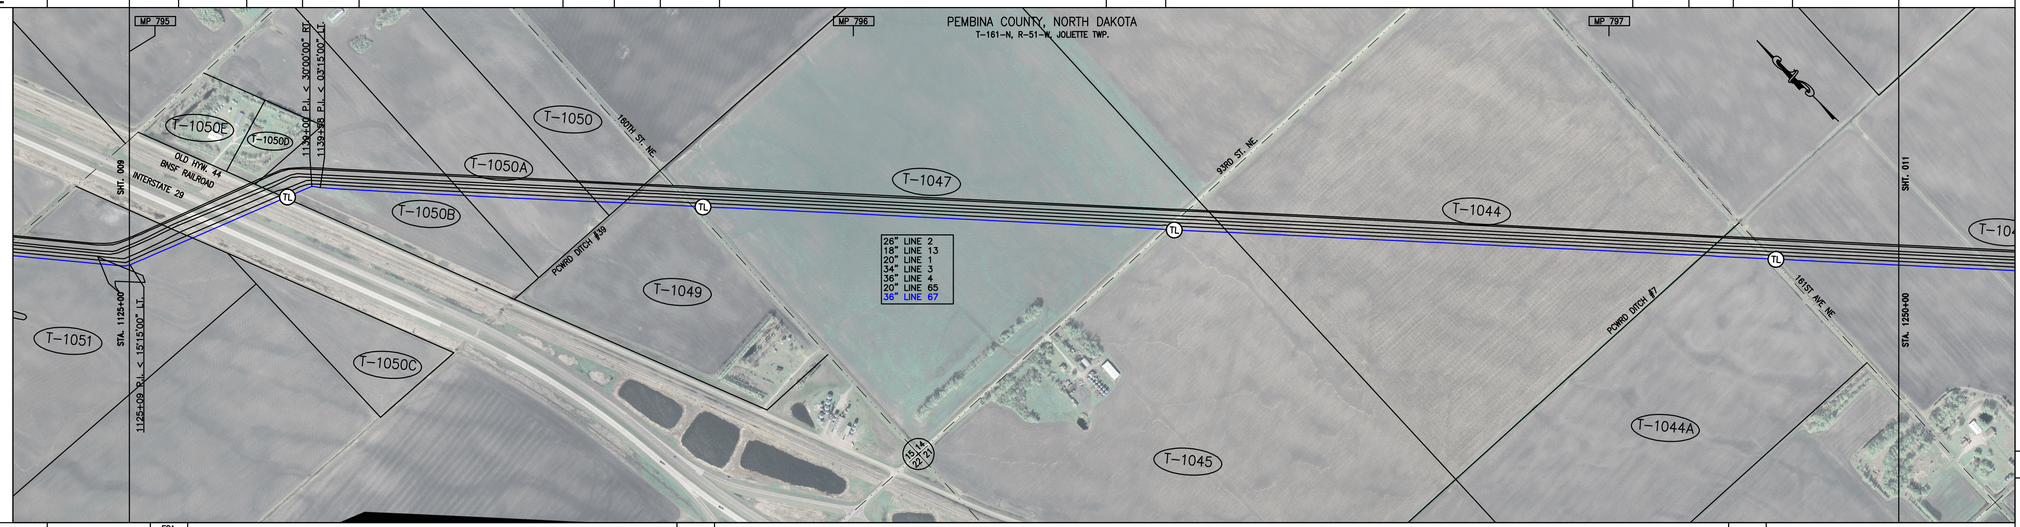


ENVIRONMENTAL		ESA #795.2		S-795A		S-797A	

CROSSING INFORMATION

1125+09 P.I. < 15°15'00" LT.
1129+81 CROP LINE
1129+86 PROPERTY LINE
1131+88 CL INTERSTATE 29(SOUTH BND.)
1132+35 CL INTERSTATE 29(NORTH BND.)
1133+35 CL BNSF RAILROAD
1136+49 CL OLD HWY 44
1136+99 PROPERTY LINE
1137+69 CROP LINE
1137+69 BURIED TELEPHONE LINE
1137+98 BURIED TELEPHONE LINE
1138+17 BURIED TELEPHONE LINE
1138+50 CROP LINE
1139+36 P.I. < 03°15'00" LT.
1149+68 PROPERTY LINE
1158+93 PROPERTY LINE
1160+77 TOP OF BANK
1160+82 PROPERTY LINE
1161+05 CL POWRD DITCH #39
1164+93 WATER LINE
1165+14 CROP LINE
1165+19 R.O.-W
1165+29 CL DITCH
1165+35 EDGE OF ROAD
1165+49 CL 160th AVE. NE
1165+67 TOP OF BANK
1165+88 CL DITCH
1166+11 ROAD R.O.-W
1166+22 TOP OF BANK
1166+33 CROP LINE
1198+01 WATER LINE
1198+12 CROP LINE
1198+17 OVERHEAD ELECTRIC
1198+34 ROAD R.O.-W
1198+35 TOP OF BANK
1198+59 EDGE OF STONE
1198+78 CL 93rd ST. NE
1198+81 SECTION LINE
1198+89 EDGE OF ROAD
1198+99 TOP OF BANK
1199+23 CL DITCH
1199+33 ROAD R.O.-W
1199+44 TOP OF BANK
1199+54 BURIED TELEPHONE LINE
1203+10 PROPERTY LINE
1235+88 TOP OF BANK
1236+06 CL POWRD DITCH #7
1236+31 TOP OF BANK
1236+37 CROP LINE
1236+68 OVERHEAD ELECTRIC LINE
1236+81 CROP LINE
1237+41 TOP OF BANK
1240+41 CL DITCH
1240+53 ROAD R.O.-W
1240+57 TOP OF BANK
1240+63 EDGE OF ROAD
1240+93 CL 161st AVE. NE
1241+12 EDGE OF ROAD
1241+19 TOP OF BANK
1241+19 SECTION LINE
1241+21 TOP OF BANK
1241+31 CL DITCH
1241+41 ROAD R.O.-W
1241+45 TOP OF BANK
1241+64 CROP LINE
1241+91 WATER LINE


36" LINE MATERIALS

ALL PIPE IS 36" O.D.
API 5L-X-70 STEEL PIPE
FBE COATED

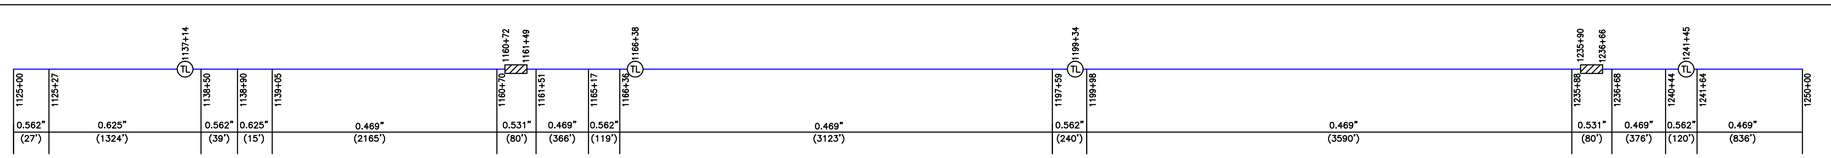

AS-BUILT

PIPE PROFILE
HORIZONTAL: 1" = 800'
VERTICAL: 1" = 100'

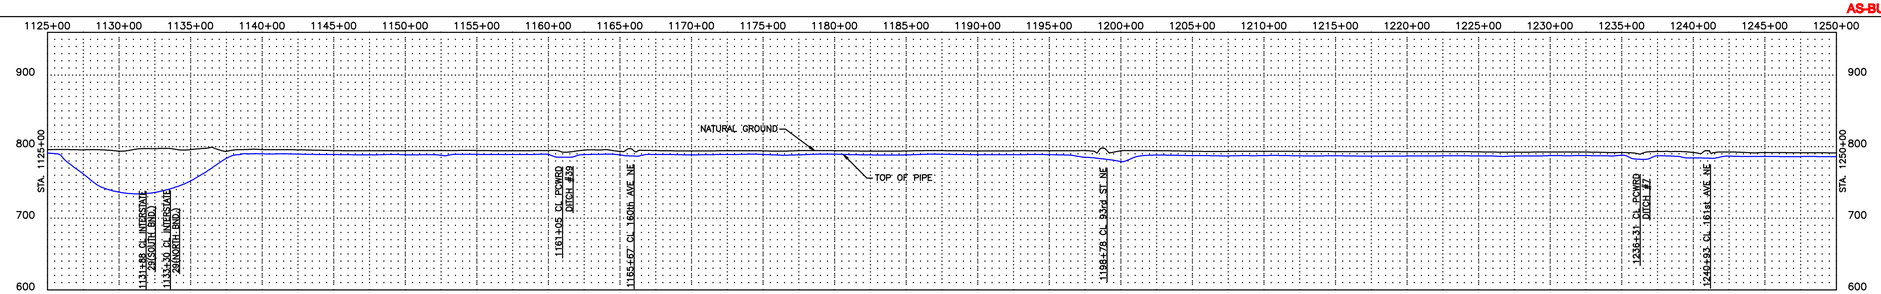

LEGEND

- INTERSTATE HIGHWAY
- US HIGHWAY
- STATE HIGHWAY
- CO. STATE AID HIGHWAYS
- COUNTY ROAD
- M. P. MARKER
- AERIAL M.P. MARKER
- CIVIL TOWNSHIP LINE
- FOREIGN PIPELINE
- SECTION LINES
- ROADS
- BURIED PHONE LINE
- BURIED POWER LINE
- OVERHEAD POWER LINE
- WATER LINE
- GAS LINE
- FIBER OPTIC CABLE LINE
- PROPERTY LINE
- RAILROADS
- WATER RIVERS, STREAMS, CREEKS, DITCHES
- ROCK SHIELD
- SET ON WEIGHTS
- CONCRETE COATING
- CASING
- MOTOR OPERATED VALVE
- GATE VALVE
- TEE
- STOPPLE TEE
- REPAIR SLEEVE
- RECTIFIER
- WELD PLUS
- TEST LEAD

NOTES:

ENBRIDGE ENERGY # 1-800-858-5253
(L.C.) – LAND CONTRACT
RRX – RAILROAD CROSSING
WX – WATER CROSSING
RX – ROAD CROSSING
LWA – LOW WET AREA
WL – WETLAND (SEE WETLAND DELINEATION DRAWINGS REPORT)
GOPHER STATE ONE–CALL 1-800-252-1166
ALL STATIONING IN TRUE (PIPE) LENGTH

FIELD BOOK	FIELD BOOK	FIELD BOOK

NO.	REFERENCE DRAWINGS

REVISION	DATE	APPR.

SCALE	DATE	DRAWN	APPROVED	APPROVED
1"=500'		MM	CN	

800 400 300 200 100 0 200 500 1000
SCALE IN FEET

ENBRIDGE

AS-BUILT ALIGNMENT
ALBERTA CLIPPER 36" PIPELINE
MP 795.0 TO MP 797.4
STA. 1125+00 TO STA. 1250+00
PEMBINA COUNTY, NORTH DAKOTA

DRAWING NUMBER	ROUTE SHEET
D-67-5.92-16929-010	010


CROSSING INFORMATION

XX" LINE MATERIALS

ALL PIPE IS XX" O.D.
API 5L-X-70 STEEL PIPE
FBE COATED

TRACT NUMBER	T-1043	T-1042-RX 92ND ST NE	T-1042	T-1041	T-1040-DD	T-1040	T-1039-RX 162ND AVE NE	T-1039	T-1038-RX 91ST ST NE	T-1038	T-1037
LAND USE		ROAD	CROP		DITCH	CROP	ROAD	CROP	ROAD	CROP	

PLAN
1" = 500'

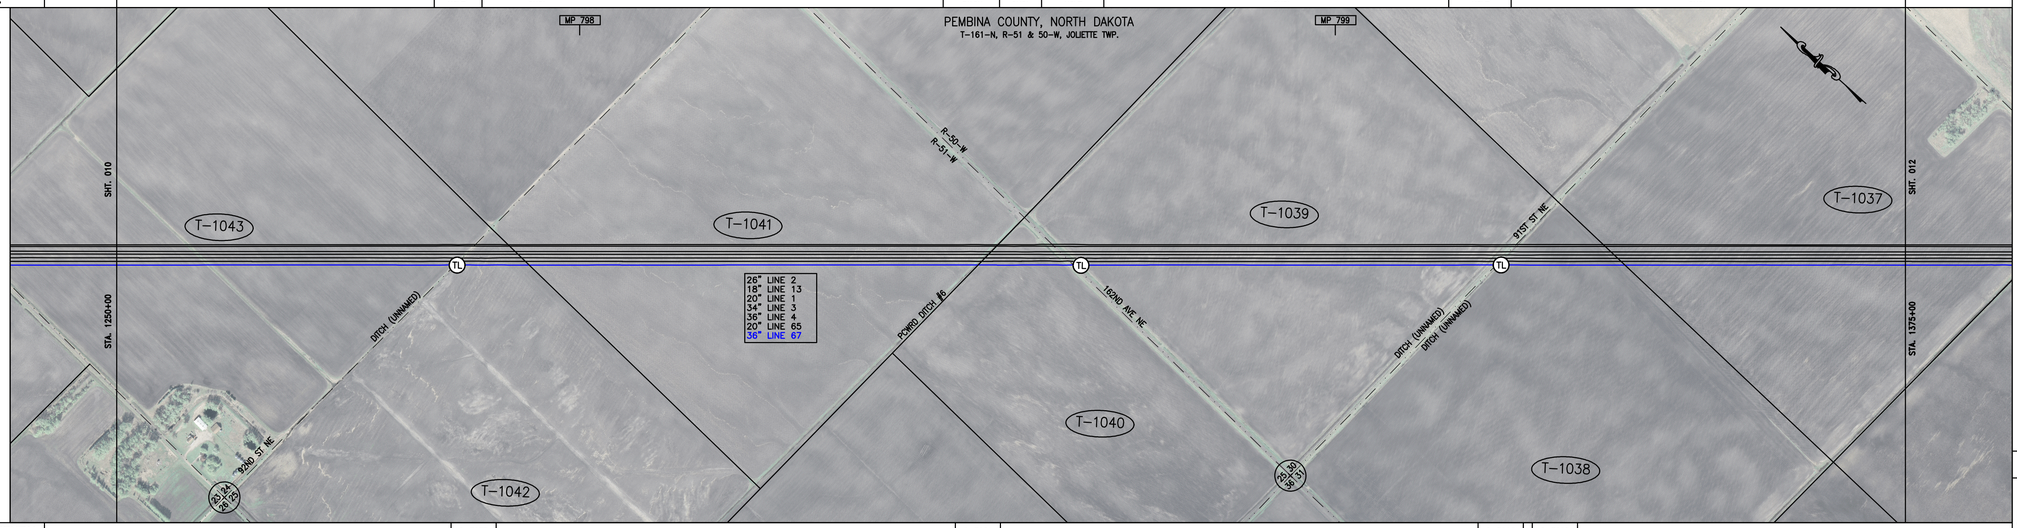

ENVIRONMENTAL

	S-797B		S-798A		S-799C	S-799B	

CROSSING INFORMATION

1273+22 ROAD R-O-W
1273+50 TOP OF BANK
1273+67 CL DITCH
1273+69 SECTION LINE
1273+69 TOP OF BANK
1273+81 TOP OF BANK
1274+19 ROAD R-O-W
1278+66 PROPERTY LINE
1278+91 CROP LINE


1308+37 CL DITCH
1309+72 TOP OF BANK
1309+88 TOP OF BANK
1310+12 CL POWRD DITCH #6
1310+39 TOP OF BANK
1310+41 TOP OF BANK
1316+18 CROP LINE
1316+26 CL DITCH
1316+33 ROAD R-O-W
1316+48 TOP OF ROAD
1316+58 EDGE OF ROAD
1316+80 CL 162nd AVE NE
1316+86 EDGE OF ROAD
1316+96 TOP OF BANK
1317+22 ROAD R-O-W
1317+29 CL DITCH
1317+39 TOP OF BANK
1317+54 CROP LINE

1345+36 CROP LINE
1345+46 TOP OF BANK
1345+59 CL DITCH (UNNAMED)
1345+75 TOP OF BANK
1346+01 TOP OF BANK
1346+31 TOP OF BANK
1346+41 SECTION LINE
1346+42 CL DITCH (UNNAMED)
1346+58 CROP LINE
1346+83 ROAD R-O-W
1346+62

1355+43 PROPERTY LINE


36" LINE MATERIALS

ALL PIPE IS 36" O.D.
API 5L-X-70 STEEL PIPE
FBE COATED

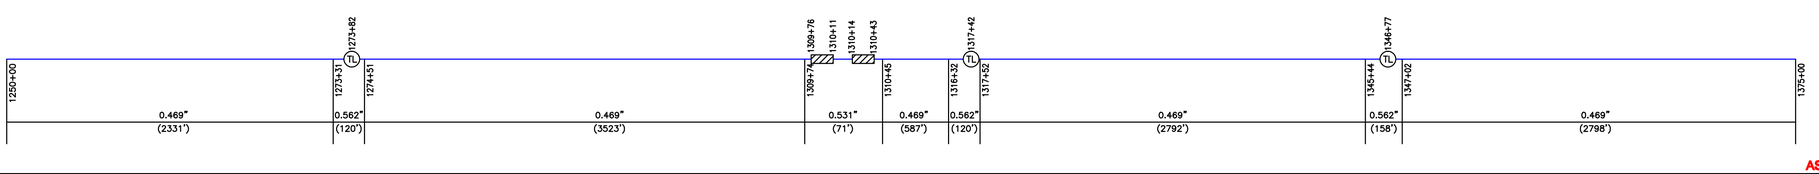

AS-BUILT

PIPE PROFILE
HORIZONTAL: 1" = 800'
VERTICAL: 1" = 100'

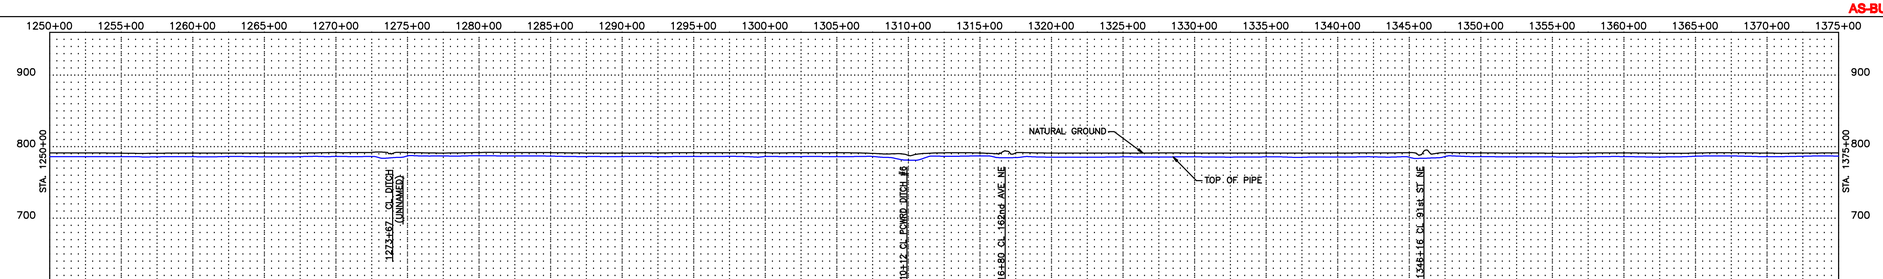

LEGEND

- INTERSTATE HIGHWAY
- US HIGHWAY
- STATE HIGHWAY
- CO. STATE AID HIGHWAYS
- COUNTY ROAD
- M. P. MARKER
- AERIAL M.P. MARKER
- CIVIL TOWNSHIP LINE
- FOREIGN PIPELINE
- SECTION LINES
- ROADS
- BURIED PHONE LINE
- BURIED POWER LINE
- OVERHEAD POWER LINE
- WATER LINE
- GAS LINE
- FIBER OPTIC CABLE LINE
- PROPERTY LINE
- RAILROADS
- WATER (RIVERS, STREAMS, CREEKS, DITCHES)
- ROCK SHIELD
- SET ON WEIGHTS
- CONCRETE COATING
- CASING
- MOV MOTOR OPERATED VALVE
- GATE VALVE
- TEE
- STOPPLE TEE
- REPAIR SLEEVE
- RECTIFIER
- WELD PLUS
- TEST LEAD

NOTES:

ENBRIDGE ENERGY # 1-800-858-5253
(L.C.) – LAND CONTRACT
RRX – RAILROAD CROSSING
WX – WATER CROSSING
RX – ROAD CROSSING
LWA – LOW WET AREA
WL – WETLAND (SEE WETLAND DELINEATION DRAWINGS REPORT)
GOPHER STATE ONE-CALL 1-800-252-1166
ALL STATIONING IN TRUE (PIPE) LENGTH

FIELD BOOK	FIELD BOOK	FIELD BOOK

NO.	REFERENCE DRAWINGS

REVISION	DATE	APPR.

SCALE	DATE	DRAWN	APPROVED	APPROVED
1"=500'		MM	CN	

800 400 200 100 0 200 500 1000
SCALE IN FEET

ENBRIDGE

AS-BUILT ALIGNMENT
ALBERTA CLIPPER 36" PIPELINE
MP 797.4 TO MP 799.8
STA. 1250+00 TO STA. 1375+00
PEMBINA COUNTY, NORTH DAKOTA

DRAWING NUMBER	ROUTE SHEET
D-67-5.92-16930-011	011

CROSSING INFORMATION

XX" LINE MATERIALS

ALL PIPE IS XX" O.D.
API 5L-X-70 STEEL PIPE
FBE COATED

| | | |


CROSSING INFORMATION

XX" LINE MATERIALS

ALL PIPE IS XX" O.D.
API 5L-X-70 STEEL PIPE
FBE COATED

TRACT NUMBER		T-1028	T-1027B-RX 160TH AVE	T-1027B	T-1027A	T-1027	T-1026	T-1025-RX 200TH ST	T-1025	T-1024	T-1023-RX 170TH ST	T-1023	T-1022	T-1021	
LAND USE		CROP	ROAD	ROAD	CROP			ROAD	CROP		ROAD	CROP			

PLAN
1" = 500'

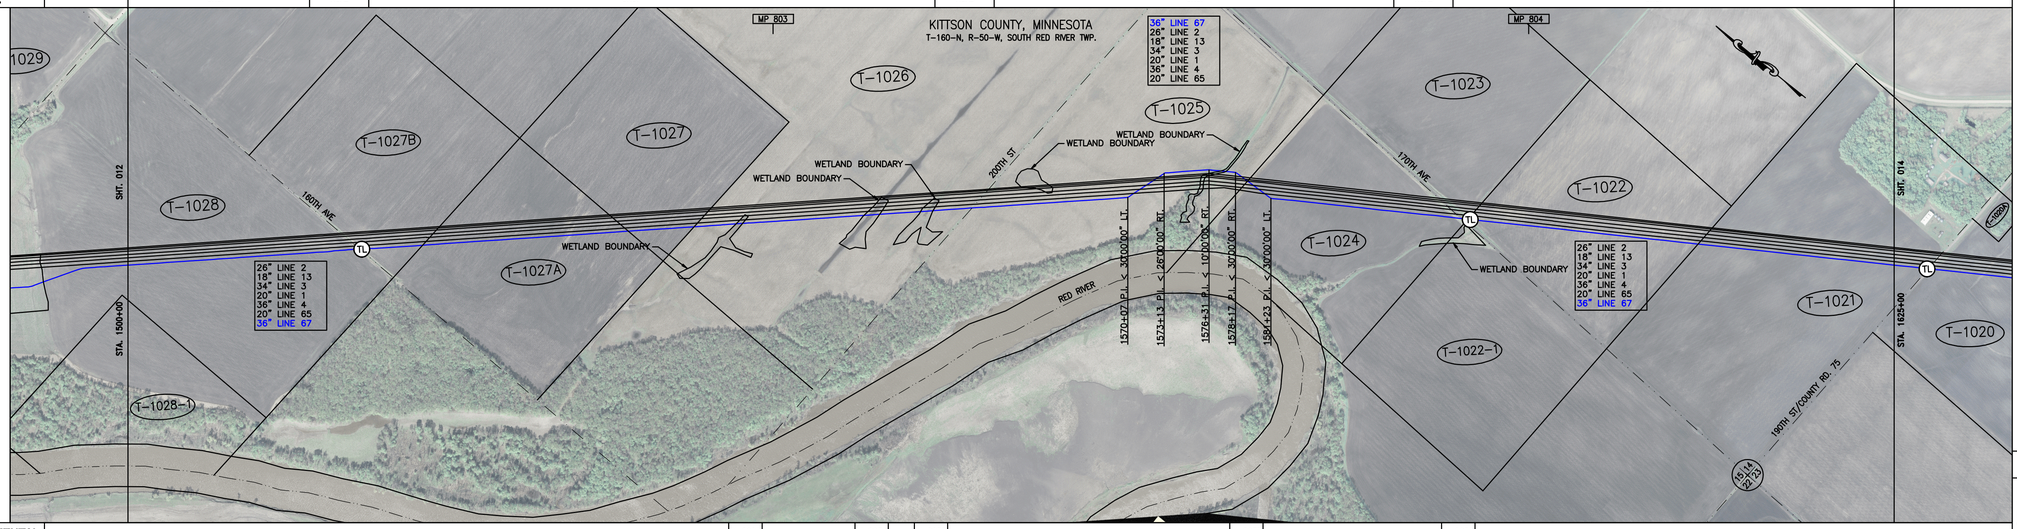

ENVIRONMENTAL


W-802A | W-803A | W-803B | W-803E | W-803D

CROSSING INFORMATION

1515+57	ROAD R-O-W	1570+07	P.I. < 30°00'00" LT.
1516+14	160th AVE	1570+56	EXISTING 20" PIPELINE
1516+18	TOP OF BANK	1570+80	EXISTING 26" PIPELINE
1516+26	SECTION LINE	1571+61	EXISTING 34" PIPELINE
1516+37	CL DITCH	1572+19	EXISTING 18" PIPELINE
1516+53	ROAD R-O-W	1572+65	EXISTING 36" PIPELINE
1520+67	PROPERTY LINE	1573+13	P.I. < 28°00'00" RT.
1535+08	PROPERTY LINE	1576+31	P.I. < 10°00'00" RT.
1539+69	PROPERTY LINE	1577+15	EDGE OF WETLAND
1539+79	CROP LINE	1577+50	CL DITCH
1542+63	EDGE OF WETLAND	1577+80	EDGE OF WETLAND
1542+88	CL DITCH	1578+17	P.I. < 30°00'00" RT.
1543+08	EDGE OF WETLAND	1578+95	EXISTING 20" PIPELINE
1551+58	EDGE OF WETLAND	1579+10	EXISTING 26" PIPELINE
1552+24	CL DITCH	1579+27	PROPERTY LINE
1552+68	EDGE OF WETLAND	1579+56	CROP LINE
1555+56	EDGE OF WETLAND	1579+61	EXISTING 34" PIPELINE
1556+13	CL DITCH	1580+16	EXISTING 18" PIPELINE
1556+42	EDGE OF WETLAND	1580+70	EXISTING 36" PIPELINE
1558+69	ROAD R-O-W	1581+22	P.I. < 30°00'00" LT.
1559+14	CL 200th ST	1593+94	CROP LINE
1559+16	SECTION LINE	1594+02	ROAD R-O-W
1559+62	ROAD R-O-W	1594+22	CL DITCH
		1594+45	TOP OF BANK
		1594+64	CL 170th AVE
		1594+80	TOP OF BANK
		1595+04	CL DITCH
		1595+05	PROPERTY LINE
		1595+16	ROAD R-O-W
		1595+26	CROP LINE
		1610+90	CROP LINE
		1611+25	PROPERTY LINE

36" LINE MATERIALS


ALL PIPE IS 36" O.D.
API 5L-X-70 STEEL PIPE
FBE COATED

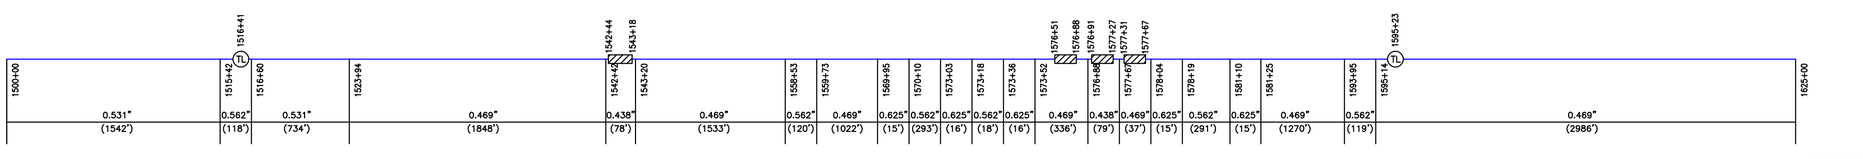

AS-BUILT

PIPE PROFILE
HORIZONTAL: 1" = 800'
VERTICAL: 1" = 100'

1559+14 C/L ROAD

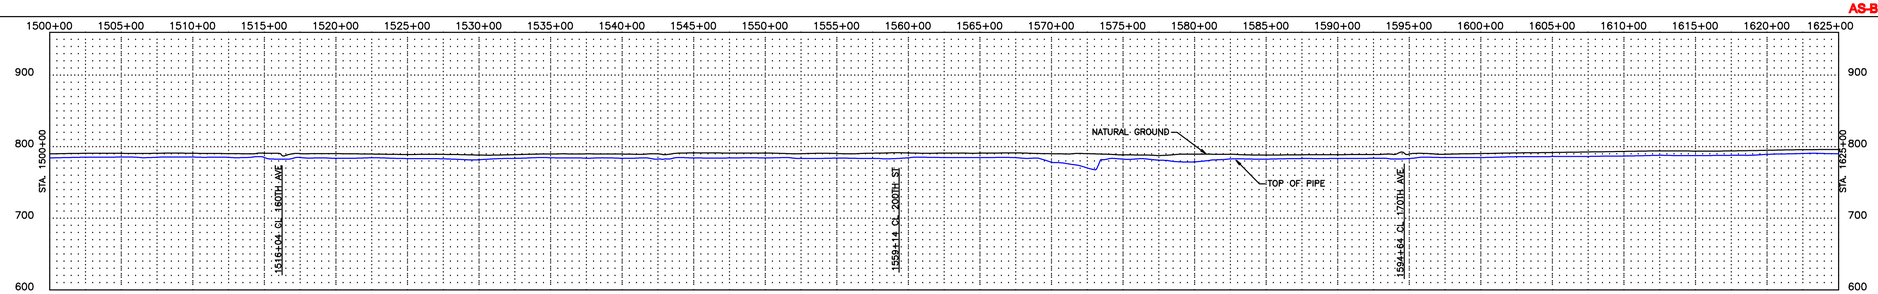

LEGEND

- INTERSTATE HIGHWAY
- US HIGHWAY
- STATE HIGHWAY
- CO. STATE AID HIGHWAYS
- COUNTY ROAD
- M. P. MARKER
- AERIAL M.P. MARKER
- CIVIL TOWNSHIP LINE
- FOREIGN PIPELINE
- SECTION LINES
- ROADS
- BURIED PHONE LINE
- BURIED POWER LINE
- OVERHEAD POWER LINE
- WATER LINE
- GAS LINE
- FIBER OPTIC CABLE LINE
- PROPERTY LINE
- RAILROADS
- WATER RIVERS, STREAMS, CREEKS, DITCHES
- ROCK SHIELD
- SET ON WEIGHTS
- CONCRETE COATING
- CASING
- MOTOR OPERATED VALVE
- GATE VALVE
- TEE
- STOPPLE TEE
- REPAIR SLEEVE
- RECTIFIER
- WELD PLUS
- TEST LEAD

NOTES:

ENBRIDGE ENERGY # 1-800-858-5253
(L.C.) – LAND CONTRACT
RRX – RAILROAD CROSSING
WX – WATER CROSSING
RX – ROAD CROSSING
LWA – LOW WET AREA
WL – WETLAND (SEE WETLAND DELINEATION DRAWINGS REPORT)
GOPHER STATE ONE-CALL 1-800-252-1166
ALL STATIONING IN TRUE (PIPE) LENGTH

FIELD BOOK	FIELD BOOK	FIELD BOOK

NO.	REFERENCE DRAWINGS

	REVISION	DATE	APPR.

SCALE	DATE	DRAWN	APPROVED	APPROVED
1"=500'		MM	CN	

800 400 300 200 100 0 200 500 1000
SCALE IN FEET

ENBRIDGE

AS-BUILT ALIGNMENT
ALBERTA CLIPPER 36" PIPELINE
MP 802.1 TO MP 804.5
STA. 1500+00 TO STA. 1625+00
KITTSON COUNTY, MINNESOTA

DRAWING NUMBER	ROUTE SHEET
D-67-5.92-16932-013	013


CROSSING INFORMATION

XX" LINE MATERIALS

ALL PIPE IS XX" O.D.
API 5L-X-70 STEEL PIPE
FBE COATED

TRACT NUMBER		T-1021	T-1020-RX 190TH ST	T-1020	T-1019A	T-1019	T-1018	T-1017-RX 180TH AVE	T-1018A	T-1017	T-1016-RX 180TH ST	T-1016	T-1015	T-1014	
LAND USE		CROP	ROAD	CROP		CROP	OPEN / CROP	ROAD	OPEN	CROP	ROAD	CROP / TREES	CROP		

PLAN
1" = 500'

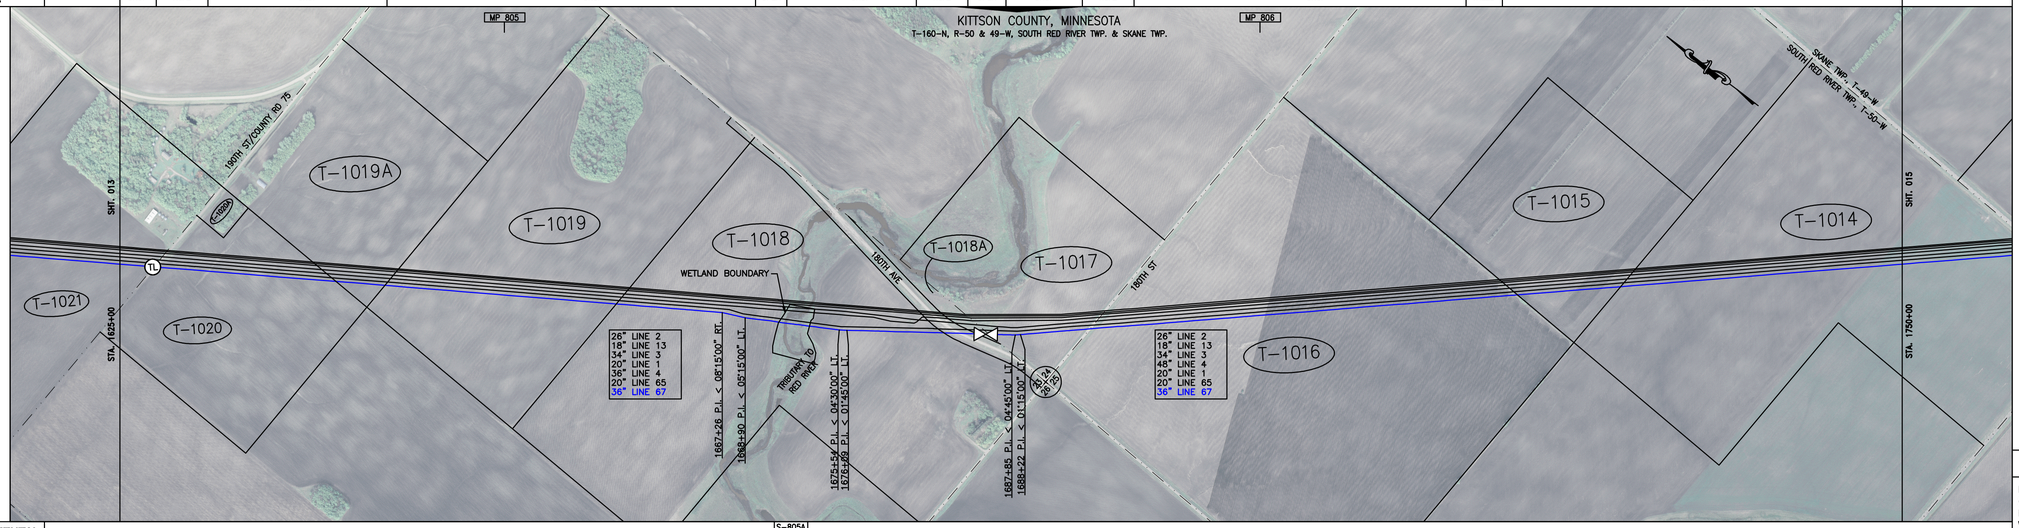

ENVIRONMENTAL


S-805A
W-805A

CROSSING INFORMATION

1627+16	ROAD R-O-W
1627+19	CROP LINE
1627+32	SECTION LINE
1627+46	EDGE OF ROAD
1627+57	ROAD R-O-W
1627+67	EDGE OF ROAD
1627+78	FIBER OPTIC CABLE
1627+88	FIBER OPTIC CABLE
1627+99	ROAD R-O-W
1628+11	CL DITCH
1640+18	PROPERTY LINE
1643+60	CROP LINE
1643+62	PROPERTY LINE
1659+83	PROPERTY LINE
1659+97	CROP LINE
1667+26	P.I. < 08°15'00" RT.
1668+90	P.I. < 09°15'00" LT.
1671+31	CROP LINE
1671+38	EDGE OF WETLAND
1671+78	EDGE OF WATER
1671+85	TREE LINE
1671+99	EDGE OF WATER
1672+00	TOP OF BANK
1673+45	EDGE OF WETLAND
1674+62	CROP LINE
1675+54	P.I. < 04°30'00" LT.
1676+69	P.I. < 01°45'00" LT.
1682+82	PROPERTY LINE
1683+01	TOP OF BANK
1683+14	CROP LINE
1683+36	CL ISH. AVE
1683+53	EDGE OF ROAD
1683+59	PROPERTY LINE
1683+70	SECTION LINE
1683+93	BURIED ELECTRIC
1686+57	BURIED ELECTRIC LINE
1687+26	P.I. < 08°15'00" RT.
1687+85	P.I. < 04°45'00" LT.
1688+22	P.I. < 01°15'00" RT.
1688+28	BURIED TELEPHONE LINE
1692+64	ROAD R-O-W
1692+83	BURIED TELEPHONE LINE
1692+72	CL DITCH
1692+74	TOP OF BANK
1692+75	CROP LINE
1692+98	EDGE OF ROAD
1693+10	CL ISH. AVE
1693+10	SECTION LINE
1693+47	CL DITCH
1693+57	ROAD R-O-W
1693+58	BURIED ELECTRIC
1693+59	TOP OF BANK
1693+62	CROP LINE
1723+06	PROPERTY LINE
1730+29	PROPERTY LINE
1730+54	CROP LINE


36" LINE MATERIALS

ALL PIPE IS 36" O.D.
API 5L-X-70 STEEL PIPE
FBE COATED

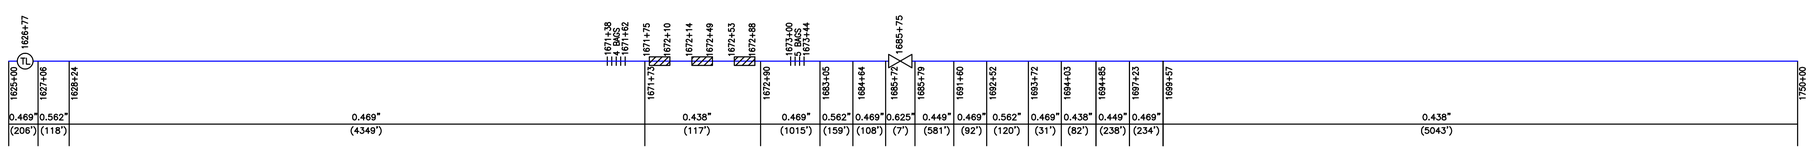

AS-BUILT

PIPE PROFILE
HORIZONTAL: 1" = 800'
VERTICAL: 1" = 100'

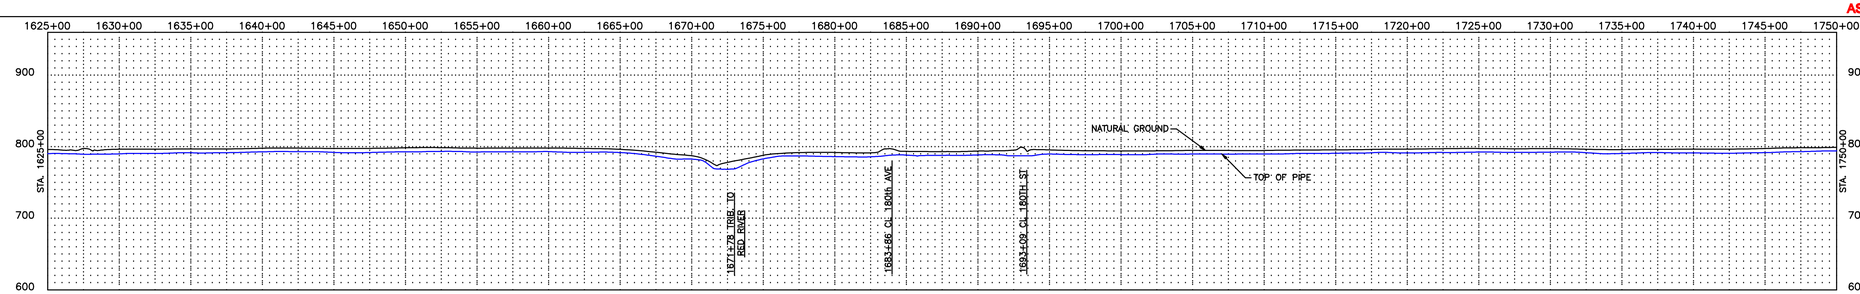

LEGEND

- INTERSTATE HIGHWAY
- US HIGHWAY
- STATE HIGHWAY
- CO. STATE AID HIGHWAYS
- COUNTY ROAD
- M. P. MARKER
- AERIAL M.P. MARKER
- CIVIL TOWNSHIP LINE
- FOREIGN PIPELINE
- SECTION LINES
- ROADS
- BURIED PHONE LINE
- BURIED POWER LINE
- OVERHEAD POWER LINE
- WATER LINE
- GAS LINE
- FIBER OPTIC CABLE LINE
- PROPERTY LINE
- RAILROADS
- WATER RIVERS, STREAMS, CREEKS, DITCHES
- ROCK SHIELD
- SET ON WEIGHTS
- CONCRETE COATING
- CASING
- MOV MOTOR OPERATED VALVE
- GATE VALVE
- TEE
- STOPPLE TEE
- REPAIR SLEEVE
- RECTIFIER
- WELD PLUS
- TL TEST LEAD

NOTES:

ENBRIDGE ENERGY # 1-800-858-5253
(L.C.) – LAND CONTRACT
RRX – RAILROAD CROSSING
WX – WATER CROSSING
RX – ROAD CROSSING
LWA – LOW WET AREA
WL – WETLAND (SEE WETLAND DELINEATION DRAWINGS REPORT)
GOPHER STATE ONE-CALL 1-800-252-1166
ALL STATIONING IN TRUE (PIPE) LENGTH

FIELD BOOK	FIELD BOOK	FIELD BOOK

NO.	REFERENCE DRAWINGS

REVISION	DATE	APPR.

SCALE	DATE	DRAWN	APPROVED	APPROVED
1"=500'		MM	CN	

800 400 200 100 0 200 500 1000
SCALE IN FEET

ENBRIDGE

AS-BUILT ALIGNMENT
ALBERT CLIPPER 36" PIPELINE
MP 804.5 TO MP 806.9
STA. 1625+00 TO STA. 1750+00
KITTSON COUNTY, MINNESOTA

DRAWING NUMBER	ROUTE SHEET
D-67-5.92-16933-014	014


CROSSING INFORMATION

XX" LINE MATERIALS

ALL PIPE IS XX" O.D.
API 5L-X-70 STEEL PIPE
FBE COATED

TRACT NUMBER		T-1014	T-1013-RX 190TH AVE	T-1013	T-1012A-RX 170TH ST	T-1012A	T-1012	T-1010	T-1011	T-1010	T-1009-RX 200TH AVE	T-1009	T-1008-RX 160TH ST	T-1008	T-1007	
LAND USE		CROP	ROAD	CROP	ROAD	CROP					ROAD	CROP	ROAD	CROP		

PLAN
1" = 500'

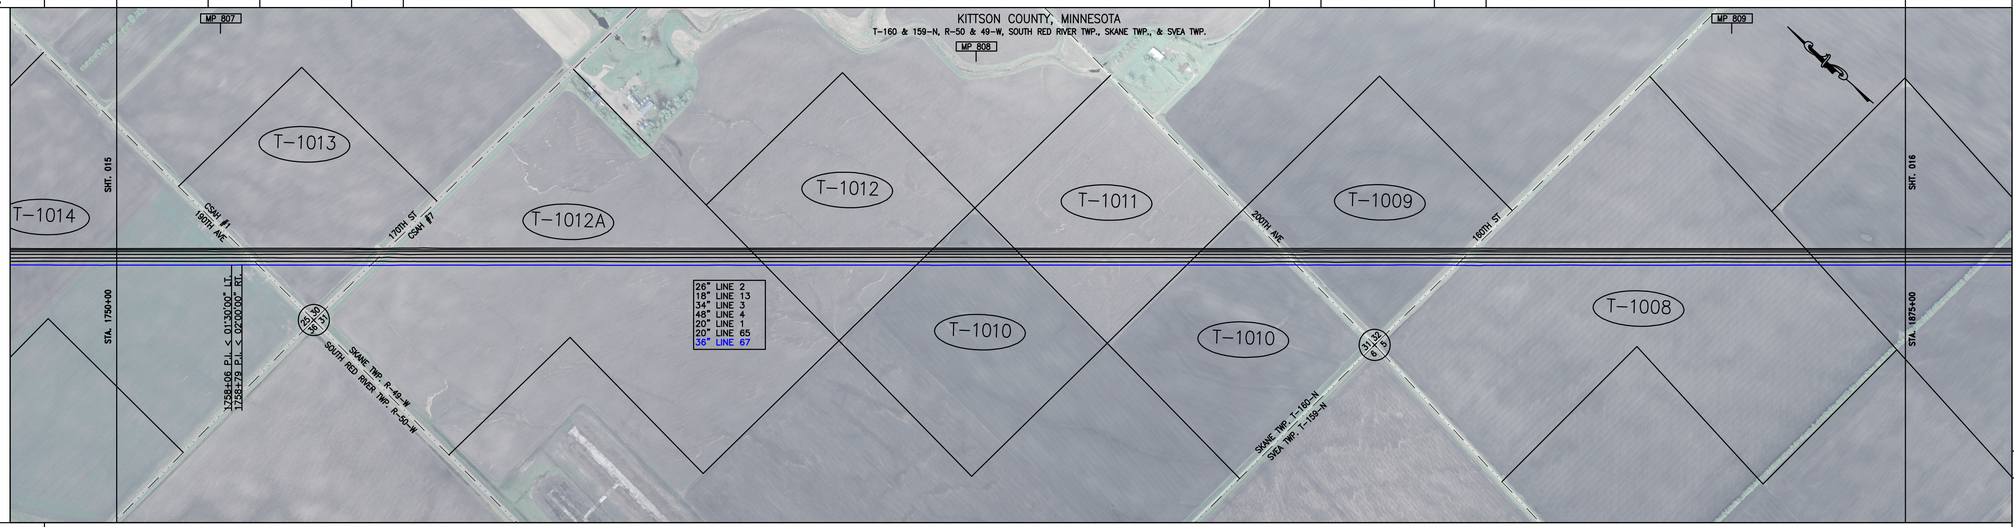

ENVIRONMENTAL

CROSSING INFORMATION

1758+06	P.I. < 01°30'00" LT.
1758+38	BURIED ELECTRIC LINE
1758+79	P.I. < 02°00'00" RT.
1759+44	ROAD R-C-W
1759+78	EDGE OF ROAD
1759+92	SECTION LINE
1759+66	CL 190th AVE
1760+14	ROAD R-C-W
1760+39	ROAD R-C-W
1760+49	CL DITCH
1766+84	BURIED CABLE
1766+94	CROP LINE
1767+10	BURIED CABLE
1767+52	EDGE OF ROAD
1767+75	SECTION LINE
1767+78	CL 170th ST
1768+18	EDGE OF ROAD
1768+46	CL DITCH
1768+51	BURIED TELEPHONE LINE
1768+61	ROAD R-C-W
1768+71	ROAD R-C-W
1768+82	CROP LINE
1795+35	PROPERTY LINE
1805+90	PROPERTY LINE
1806+11	CROP LINE
1813+63	CROP LINE
1813+91	PROPERTY LINE
1824+80	PROPERTY LINE
1825+17	CROP LINE
1830+97	BURIED CABLE
1831+79	ROAD R-C-W
1832+01	ROAD R-C-W
1832+25	CL DITCH
1832+47	SECTION LINE
1832+66	EDGE OF ROAD
1832+94	ROAD R-C-W
1833+08	TOP OF BANK
1833+18	CROP LINE
1842+87	BURIED CABLE
1843+01	CROP LINE
1843+16	ROAD R-C-W
1843+46	EDGE OF ROAD
1843+64	CL 160th ST
1843+95	SECTION LINE
1843+79	EDGE OF ROAD
1844+05	ROAD R-C-W
1844+19	CL DITCH
1844+27	CROP LINE
1844+35	BURIED CABLE
1844+37	BURIED CABLE
1869+09	PROPERTY LINE


36" LINE MATERIALS

ALL PIPE IS 36" O.D.
API 5L-X-70 STEEL PIPE
FBE COATED

1750+00	1758+84	1758+97	1760+96	1761+09	1766+43	1766+56	1768+97	1769+07	1831+70	1831+83	1833+03	1833+16	1842+62	1842+75	1844+54	1844+67	1875+00
0.438" (884')	0.469" (13')	0.562" (199')	0.469" (13')	0.438" (534)	0.469" (13')	0.562" (241')	0.469" (10')	0.438" (6263')	0.469" (13')	0.562" (120')	0.469" (13')	0.438" (946')	0.469" (13')	0.562" (179')	0.469" (13')	0.438" (3033')	

AS-BUILT

PIPE PROFILE
HORIZONTAL: 1" = 800'
VERTICAL: 1" = 100'

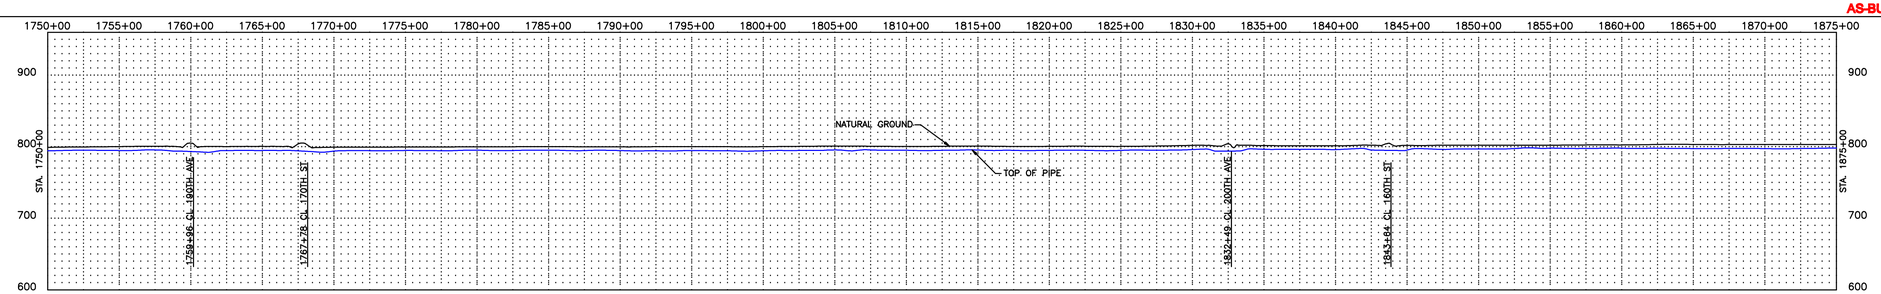

LEGEND

- INTERSTATE HIGHWAY
- US HIGHWAY
- STATE HIGHWAY
- CO. STATE AID HIGHWAYS
- COUNTY ROAD
- M. P. MARKER
- AERIAL M.P. MARKER
- CIVIL TOWNSHIP LINE
- FOREIGN PIPELINE
- SECTION LINES
- ROADS
- BURIED PHONE LINE
- BURIED POWER LINE
- OVERHEAD POWER LINE
- WATER LINE
- GAS LINE
- FIBER OPTIC CABLE LINE
- PROPERTY LINE
- RAILROADS
- WATER RIVERS, STREAMS, CREEKS, DITCHES
- ROCK SHIELD
- SET ON WEIGHTS
- CONCRETE COATING
- CASING
- MOTOR OPERATED VALVE
- GATE VALVE
- TEE
- STOPPLE TEE
- REPAIR SLEEVE
- RECTIFIER
- WELD PLUS
- TEST LEAD

NOTES:

ENBRIDGE ENERGY # 1-800-858-5253
(L.C.) – LAND CONTRACT
RRX – RAILROAD CROSSING
WX – WATER CROSSING
RX – ROAD CROSSING
LWA – LOW WET AREA
WL – WETLAND (SEE WETLAND DELINEATION DRAWINGS REPORT)
GOPHER STATE ONE-CALL 1-800-252-1166
ALL STATIONING IN TRUE (PIPE) LENGTH

FIELD BOOK	FIELD BOOK	FIELD BOOK

NO.	REFERENCE DRAWINGS

REVISION	DATE	APPR.

SCALE	DATE	DRAWN	APPROVED	APPROVED
1"=500'		MM	CN	

800 400 300 200 100 0 200 500 1000
SCALE IN FEET

ENBRIDGE

AS-BUILT ALIGNMENT
ALBERTA CLIPPER 36" PIPELINE
MP 806.90 TO MP 809.2
STA. 1750+00 TO STA. 1875+00
KITTSON COUNTY, MINNESOTA


DRAWING NUMBER	ROUTE SHEET
D-67-5.92-16934-015	015

CROSSING INFORMATION

XX" LINE MATERIALS

ALL PIPE IS XX" O.D.
API 5L-X-70 STEEL PIPE
FBE COATED

TRACT NUMBER	T-1007			T-1006-RX 210TH AVE	T-1006	T-1005-RX 150TH ST	T-1005	T-1004	T-1004A	T-1004	T-1003-RX 220TH AVE	T-1003	T-1002A-RX 140TH ST	T-1002A	
LAND USE	CROP	TREES	CROP	ROAD	CROP	ROAD	CROP				ROAD	CROP	ROAD	CROP	

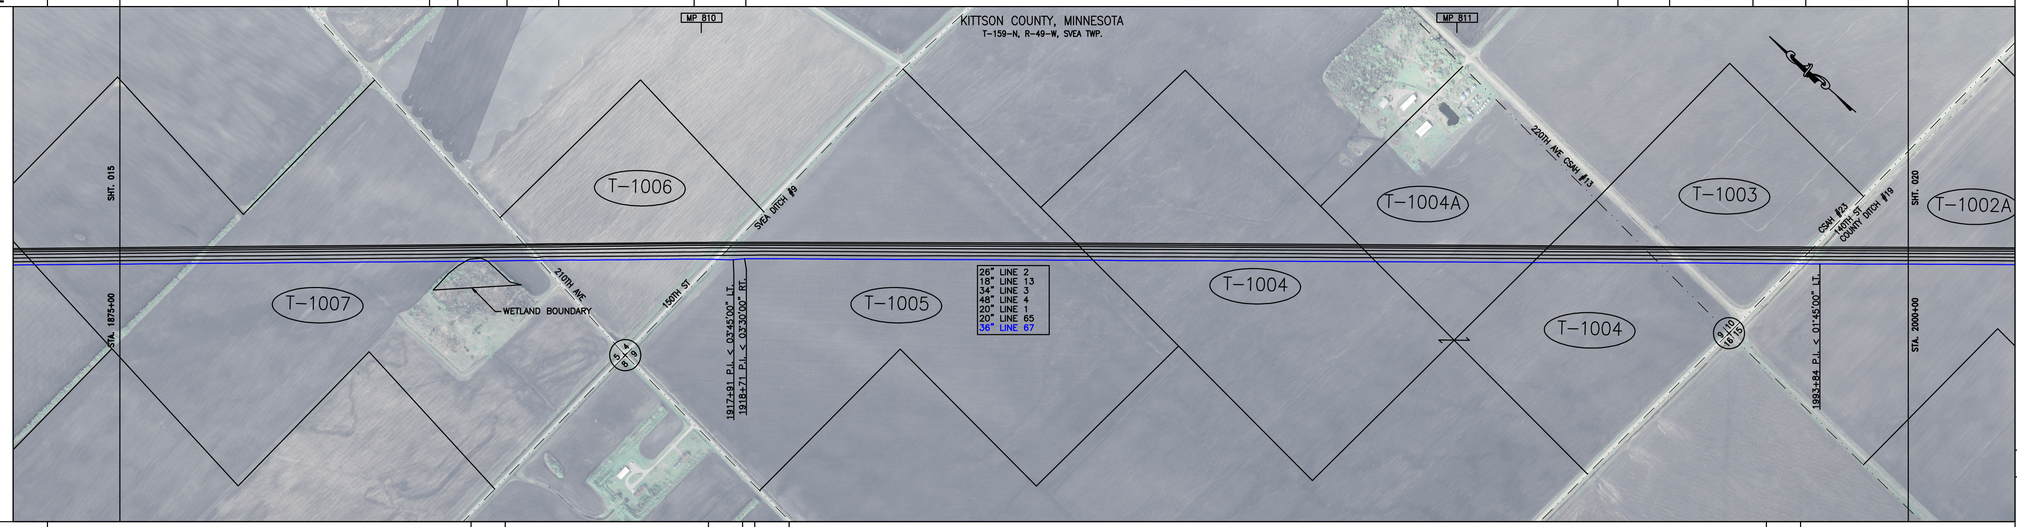

PLAN
1" = 500'

ENVIRONMENTAL	W-809A	S-810A	S-810B	S-811A

CROSSING INFORMATION

1880+27	TOP OF BANK	
1880+48	CL DITCH	
1880+65	TOP OF BANK	
1899+20	EDGE OF WETLAND	
1900+73	EDGE OF WETLAND	
1903+87	CROP LINE	
1903+88	ROAD R-O-W	
1904+04	CL DITCH	
1904+23	EDGE OF ROAD	
1904+32	SECTION LINE	
1904+57	EDGE OF ROAD	
1904+72	CL DITCH	
1904+77	ROAD R-O-W	
1904+87	TOP OF BANK	
1904+93	CROP LINE	
1915+69	CROP LINE	
1915+98	TOP OF BANK	
1916+05	OVERHEAD ELECTRIC	
1916+22	ROAD R-O-W	
1916+25	TOP OF BANK #9	
1916+45	EDGE OF ROAD	
1916+54	SECTION LINE	
1916+65	EDGE OF ROAD	
1916+85	ROAD R-O-W	
1916+89	CL SVEA DITCH #9	
1917+12	CL DITCH	
1917+41	WATER LINE	
1917+51	FIBER OPTIC CABLE	
1917+54	CROP LINE	
1917+65	EDGE OF ROAD	
1917+91	P.I. < 03°45'00" LT.	
1918+71	P.I. < 03°30'00" RT.	
1943+06	PROPERTY LINE	
1962+82	PROPERTY LINE	
1973+77	PROPERTY LINE	
1982+59	SECTION LINE	
1983+71	CROP LINE	
1983+85	ROAD R-O-W	
1984+16	CL DITCH	
1984+35	EDGE OF ROAD	
1984+55	EDGE OF ROAD	
1984+81	ROAD R-O-W	
1984+99	CROP LINE	
1991+62	CROP LINE	
1991+82	ROAD R-O-W	
1992+16	EDGE OF ROAD	
1992+28	SECTION LINE	
1992+46	EDGE OF ROAD	
1992+74	TOP OF BANK	
1992+88	TL COUNTY DITCH #19	
1993+08	TOP OF BANK	
1993+36	CROP LINE	
1993+84	P.I. < 01°45'00" LT.	


36" LINE MATERIALS

ALL PIPE IS 36" O.D.
API 5L-X-70 STEEL PIPE
FBE COATED

1875+00	1903+72	1903+82	1905+02	1905+14	1915+37	1915+50	1917+62	1917+74	1983+61	1983+74	1984+84	1985+10	1991+47	1991+60	1993+47	1993+60	2000+00
0.438" (2872')	0.469" (10')	0.562" (120')	0.469" (12')	0.438" (1023')	0.469" (13')	0.562" (212')	0.469" (12')	0.438" (6587')	0.469" (13')	0.562" (120')	0.469" (16')	0.438" (637')	0.469" (13')	0.562" (187')	0.469" (13')	0.438" (640')	

AS-BUILT

PIPE PROFILE
HORIZONTAL: 1" = 800'
VERTICAL: 1" = 100'

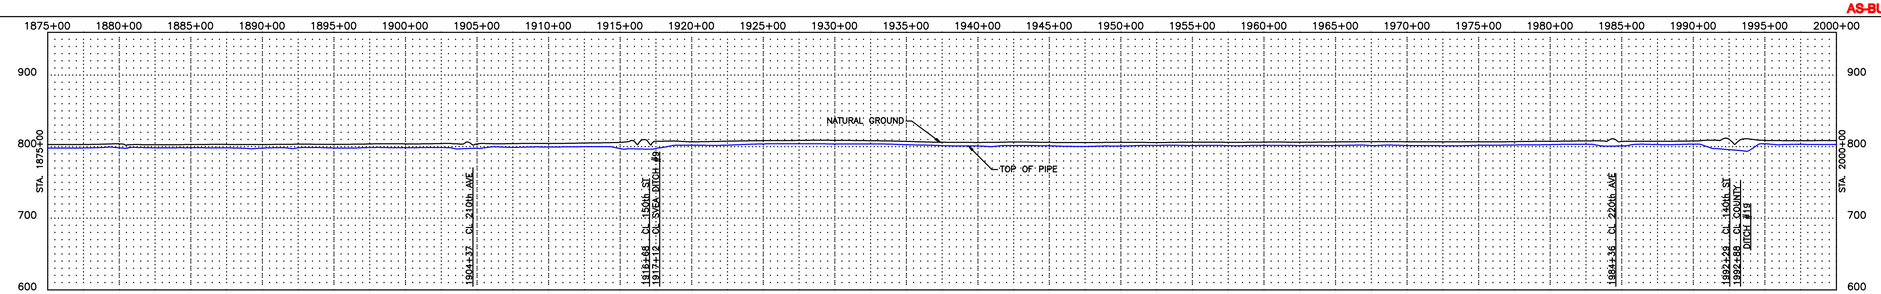

LEGEND

- INTERSTATE HIGHWAY
- US HIGHWAY
- STATE HIGHWAY
- CO. STATE AID HIGHWAYS
- COUNTY ROAD
- M. P. MARKER
- AERIAL M.P. MARKER
- CIVIL TOWNSHIP LINE
- FOREIGN PIPELINE
- SECTION LINES
- ROADS
- BURIED PHONE LINE
- BURIED POWER LINE
- OVERHEAD POWER LINE
- WATER LINE
- GAS LINE
- FIBER OPTIC CABLE LINE
- PROPERTY LINE
- RAILROADS
- WATER (RIVERS, STREAMS, CREEKS, DITCHES)
- ROCK SHIELD
- SET ON WEIGHTS
- CONCRETE COATING
- CASING
- MOTOR OPERATED VALVE
- GATE VALVE
- TEE
- STOPPLE TEE
- REPAIR SLEEVE
- RECTIFIER
- WELD PLUS
- TEST LEAD

NOTES:

ENBRIDGE ENERGY # 1-800-858-5253
(L.C.) – LAND CONTRACT
RRX – RAILROAD CROSSING
WX – WATER CROSSING
RX – ROAD CROSSING
LWA – LOW WET AREA
WL – WETLAND (SEE WETLAND DELINEATION DRAWINGS REPORT)
GOPHER STATE ONE-CALL 1-800-252-1166
ALL STATIONING IN TRUE (PIPE) LENGTH

FIELD BOOK	FIELD BOOK	FIELD BOOK

NO.	REFERENCE DRAWINGS

REVISION	DATE	APPR.

SCALE	DATE	DRAWN	APPROVED	APPROVED
1"=500'		MM	CN	

800 400 200 100 0 200 500 1000
SCALE IN FEET

ENBRIDGE

AS-BUILT ALIGNMENT
ALBERTA CLIPPER 36" PIPELINE
MP 809.2 TO MP 811.6
STA. 1875+00 TO STA. 2000+00
KITTSON COUNTY, MINNESOTA

DRAWING NUMBER	ROUTE SHEET
D-67-5.92-16935-016	016


CROSSING INFORMATION

XX" LINE MATERIALS

ALL PIPE IS XX" O.D.
API 5L-X-70 STEEL PIPE
FBE COATED

TRACT NUMBER		T-1002A	T-1002C	T-1002	T-1002B	T-1001-RX 230TH AVE.	T-1001	T-1001A	T-1001	T-998-RX 130TH ST.	T-998	T-1000	T-998	T-998A	
LAND USE	CROP			CROP		ROAD	CROP		ROAD		CROP		CROP		OPEN	

PLAN
1" = 500'

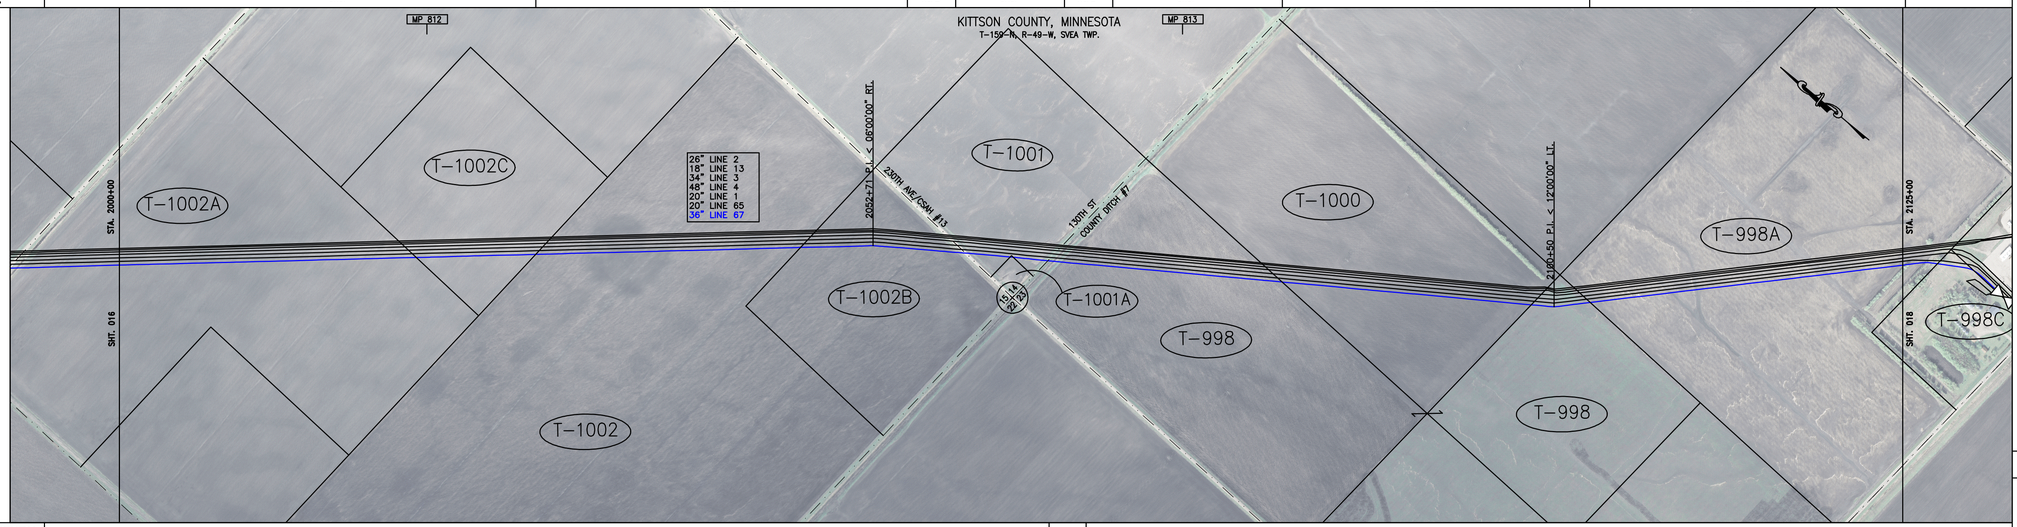


ENVIRONMENTAL S-812A

CROSSING INFORMATION

2020+78	PROPERTY LINE
2029+13	PROPERTY LINE
2029+24	CROP LINE
2047+64	PROPERTY LINE
2052+71	P.I. < 06°00'00" RT.
2058+52	CROP LINE
2058+68	ROAD R-O-W
2058+68	DITCH
2058+45	EDGE OF ROAD
2059+19	230th AVE
2059+35	SECTION LINE
2059+84	EDGE OF ROAD
2059+71	CL DITCH
2059+71	ROAD R-O-W
2059+85	TOP OF BANK
2062+32	CROP LINE
2062+54	PROPERTY LINE
2064+55	PROPERTY LINE
2064+61	ROAD R-O-W
2064+62	TOP OF BANK
2064+97	EDGE OF ROAD
2065+09	130th ST
2065+09	SECTION LINE
2065+41	EDGE OF ROAD
2065+41	CL COUNTY DITCH #7
2065+81	TOP OF BANK
2066+06	CROP LINE
2080+86	CROP LINE
2081+41	PROPERTY LINE
2084+40	OVERHEAD ELECTRIC
2098+89	PROPERTY LINE
2099+35	24" PIPELINE
2100+50	P.I. < 12°00'00" LT.
2103+50	PROPERTY LINE
2103+03	PROPERTY LINE


36" LINE MATERIALS

ALL PIPE IS 36" O.D.
API 5L-X-70 STEEL PIPE
FBE COATED

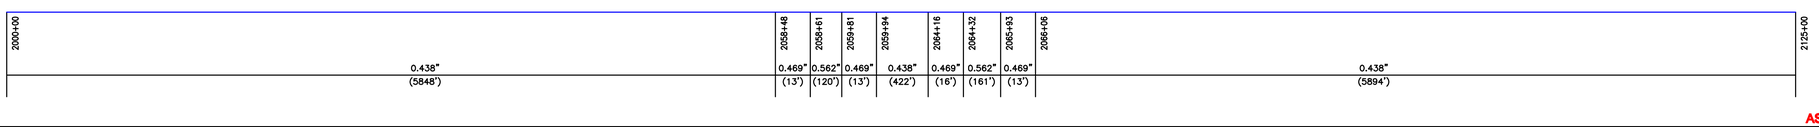

AS-BUILT

PIPE PROFILE
HORIZONTAL: 1" = 800'
VERTICAL: 1" = 100'

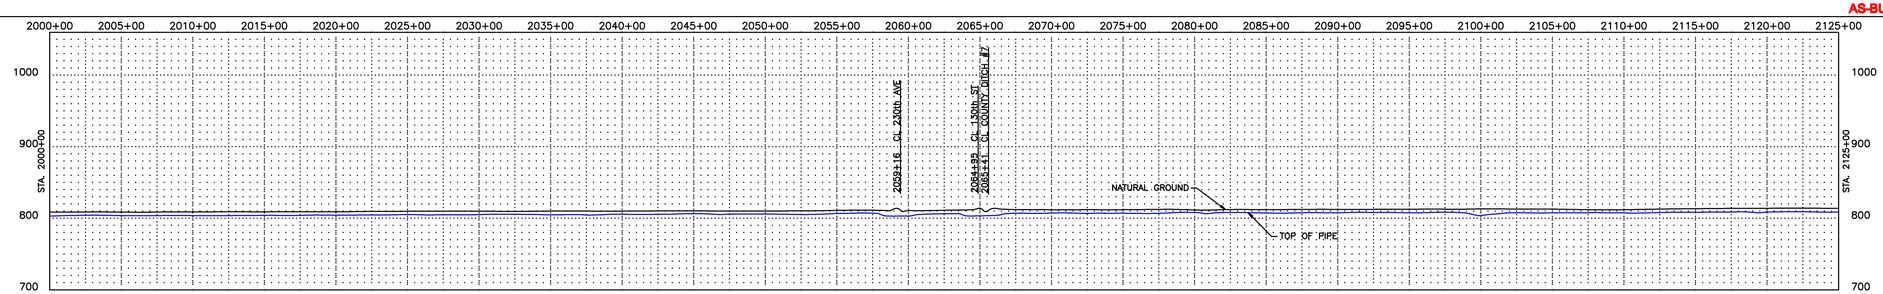

LEGEND

- INTERSTATE HIGHWAY
- US HIGHWAY
- STATE HIGHWAY
- CO. STATE AID HIGHWAYS
- COUNTY ROAD
- M. P. MARKER
- AERIAL M.P. MARKER
- CIVIL TOWNSHIP LINE
- FOREIGN PIPELINE
- SECTION LINES
- ROADS
- BURIED PHONE LINE
- BURIED POWER LINE
- OVERHEAD POWER LINE
- WATER LINE
- GAS LINE
- FIBER OPTIC CABLE LINE
- PROPERTY LINE
- RAILROADS
- WATER (RIVERS, STREAMS, CREEKS, DITCHES)
- ROCK SHIELD
- SET ON WEIGHTS
- CONCRETE COATING
- CASING
- MOTOR OPERATED VALVE
- GATE VALVE
- TEE
- STOPPLE TEE
- REPAIR SLEEVE
- RECTIFIER
- WELD PLUS
- TEST LEAD

NOTES:

ENBRIDGE ENERGY # 1-800-858-5253
(L.C.) – LAND CONTRACT
RRX – RAILROAD CROSSING
WX – WATER CROSSING
RX – ROAD CROSSING
LWA – LOW WET AREA
WL – WETLAND (SEE WETLAND DELINEATION DRAWINGS REPORT)
GOPHER STATE ONE-CALL 1-800-252-1166
ALL STATIONING IN TRUE (PIPE) LENGTH

FIELD BOOK	FIELD BOOK	FIELD BOOK

NO.	REFERENCE DRAWINGS

REVISION	DATE	APPR.

SCALE	DATE	DRAWN	APPROVED	APPROVED
1"=500'		MM	CN	

800 400 200 100 0 200 500 1000
SCALE IN FEET

ENBRIDGE

AS-BUILT ALIGNMENT
ALBERTA CLIPPER 36" PIPELINE
MP 811.6 TO MP 814.0
STA. 2000+00 TO STA. 2125+00
KITTSON COUNTY, MINNESOTA

DRAWING NUMBER	ROUTE SHEET
D-67-5.92-16936-017	017


CROSSING INFORMATION

XX" LINE MATERIALS

ALL PIPE IS XX" O.D.
API 5L-X-70 STEEL PIPE
FBE COATED

TRACT NUMBER		T-998A	T-998C	T-998B	T-996-1-RX STATE HWY 11	T-996-1		T-996-RX 240TH AVE	T-996	T-995	T-994	T-993-DD	T-993-RX 110TH ST	T-993	T-993A	T-991-RX 250TH AVE	T-991A	T-991	T-990	
LAND USE		OPEN		COMMERCIAL	ROAD	OPEN	DRIVE	OPEN	ROAD	CROP		DITCH	ROAD	CROP		ROAD		CROP		

PLAN
1" = 500'

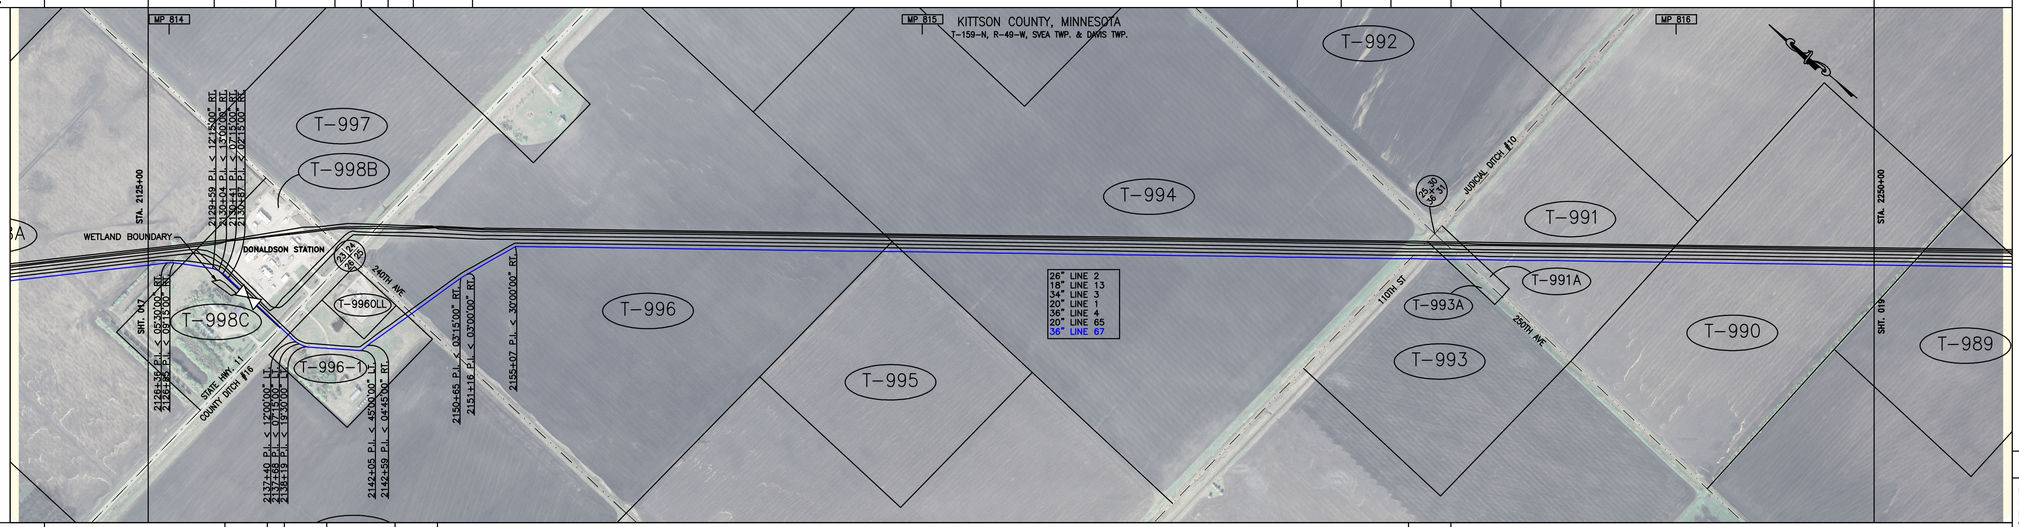

ENVIRONMENTAL


	W-814AA	S-814A		S-814B	S-815A

CROSSING INFORMATION


2126+38 P.I. < 00°30'00" RT.	2129+59 P.I. < 12°15'00" RT.	2132+08 OVERHEAD ELECTRIC	2135+18 ROAD R-O-W
2126+86 P.I. < 00°30'00" RT.	2129+84 OVERHEAD ELECTRIC	2132+20 OVERHEAD ELECTRIC	2135+21 WATER LINE
2127+47 PROPERTY LINE	2130+05 PROPERTY LINE	2132+32 ROAD R-O-W	2135+25 BURIED TELEPHONE CABLE
	2130+21 P.I. < 07°15'00" RT.	2132+38 ROAD R-O-W	2135+49 CL DITCH
	2130+35 P.I. < 07°15'00" RT.	2132+38 OVERHEAD ELECTRIC	2135+49 TOP OF BANK
		2216+26 CROP LINE	2217+44 TOP OF BANK
		2217+61 SECTION LINE	2217+61 JUDICIAL DITCH #10
		2217+77 TOP OF BANK	2217+77 TOP OF BANK
		2218+49 EDGE OF ROAD	2218+49 ROAD R-O-W
		2218+53 CL 110th ST	2218+53 EDGE OF ROAD
		2219+02 EDGE OF ROAD	2219+02 CROP LINE
		2219+16 ROAD R-O-W	2219+16 ROAD R-O-W
			2220+14 PROPERTY LINE
			2220+20 CROP LINE
			2220+64 TOP OF BANK
			2220+76 CL DITCH
			2221+22 ROAD R-O-W
			2221+22 CL 250th AVE
			2221+25 SECTION LINE
			2221+74 EDGE OF ROAD
			2221+88 CL DITCH
			2221+88 ROAD R-O-W
			2222+36 PROPERTY LINE
			2235+13 PROPERTY LINE

36" LINE MATERIALS

ALL PIPE IS 36" O.D.
API 5L-X-70 STEEL PIPE
FBE COATED

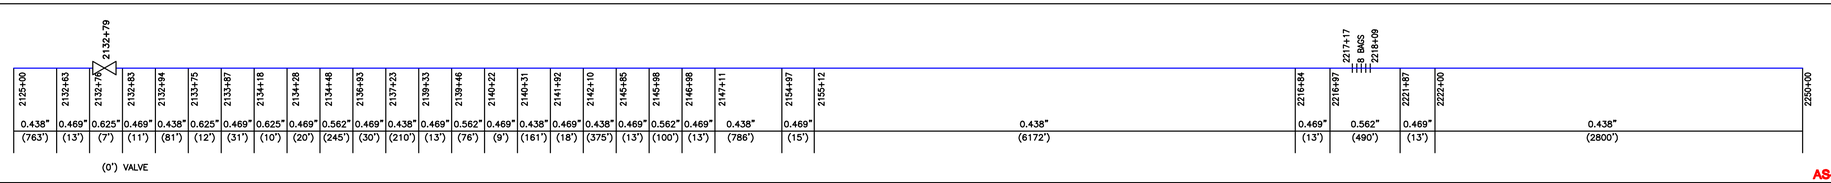

PIPE PROFILE
HORIZONTAL: 1" = 800'
VERTICAL: 1" = 100'

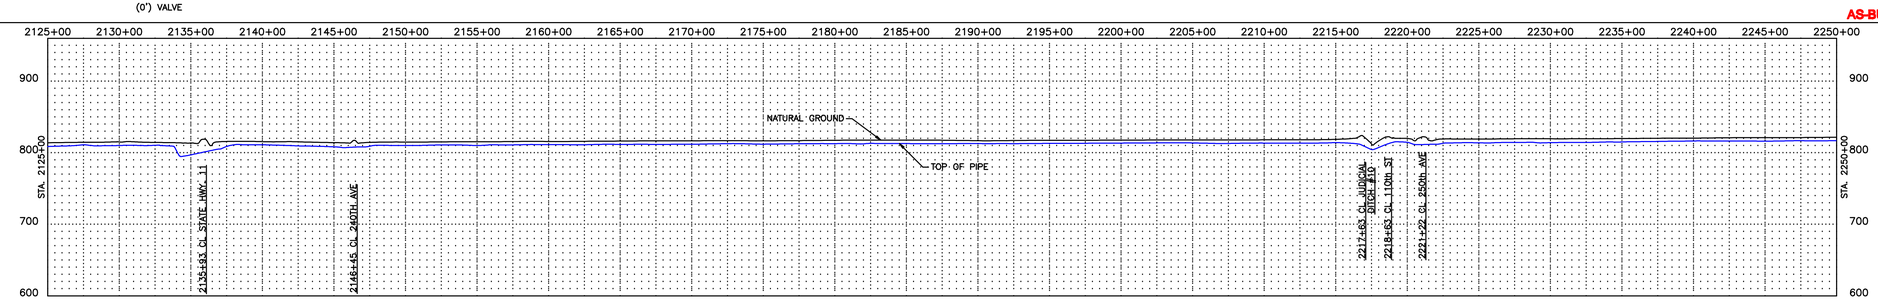

AS-BUILT

LEGEND

- INTERSTATE HIGHWAY
- US HIGHWAY
- STATE HIGHWAY
- CO. STATE AID HIGHWAYS
- COUNTY ROAD
- M. P. MARKER
- AERIAL M.P. MARKER
- CIVIL TOWNSHIP LINE
- FOREIGN PIPELINE
- SECTION LINES
- ROADS
- BURIED PHONE LINE
- BURIED POWER LINE
- OVERHEAD POWER LINE
- WATER LINE
- GAS LINE
- FIBER OPTIC CABLE LINE
- PROPERTY LINE
- RAILROADS
- WATER (RIVERS, STREAMS, CREEKS, DITCHES)
- ROCK SHIELD
- SET ON WEIGHTS
- CONCRETE COATING
- CASING
- MOTOR OPERATED VALVE
- GATE VALVE
- TEE
- STOPPLE TEE
- REPAIR SLEEVE
- RECTIFIER
- WELD PLUS
- TEST LEAD

NOTES:

ENBRIDGE ENERGY # 1-800-858-5253
(L.C.) – LAND CONTRACT
RRX – RAILROAD CROSSING
WX – WATER CROSSING
RX – ROAD CROSSING
LWA – LOW WET AREA
WL – WETLAND (SEE WETLAND DELINEATION DRAWINGS REPORT)
GOPHER STATE ONE-CALL 1-800-252-1166
ALL STATIONING IN TRUE (PIPE) LENGTH

FIELD BOOK	FIELD BOOK	FIELD BOOK

NO.	REFERENCE DRAWINGS

	REVISION	DATE	APPR.

SCALE	DATE	DRAWN	APPROVED	APPROVED
1"=500'		MM	CN	

800 400 300 200 100 0 200 500 1000
SCALE IN FEET

ENBRIDGE

AS-BUILT ALIGNMENT
ALBERTA CLIPPER 36" PIPELINE
MP 814.0 TO MP 816.3
STA. 2125+00 TO STA. 2250+00
KITTSON COUNTY, MINNESOTA

DRAWING NUMBER	ROUTE SHEET
D-67-5.92-16937-018	018


CROSSING INFORMATION

XX" LINE MATERIALS

ALL PIPE IS XX" O.D.
API 5L-X-70 STEEL PIPE
FBE COATED

TRACT NUMBER		T-990	T-989	T-987	T-988	T-988-RR	T-988-RX US HWY 75	T-988	T-986-RX 100TH ST	T-986	T-985	T-984	T-983A	T-983	T-986-RX 450TH ST NW	T-982	
LAND USE		CROP / TREES	CROP			RAILROAD	ROAD	CROP	ROAD	CROP			DRIVE	CROP	ROAD	CROP	

PLAN
1" = 500'

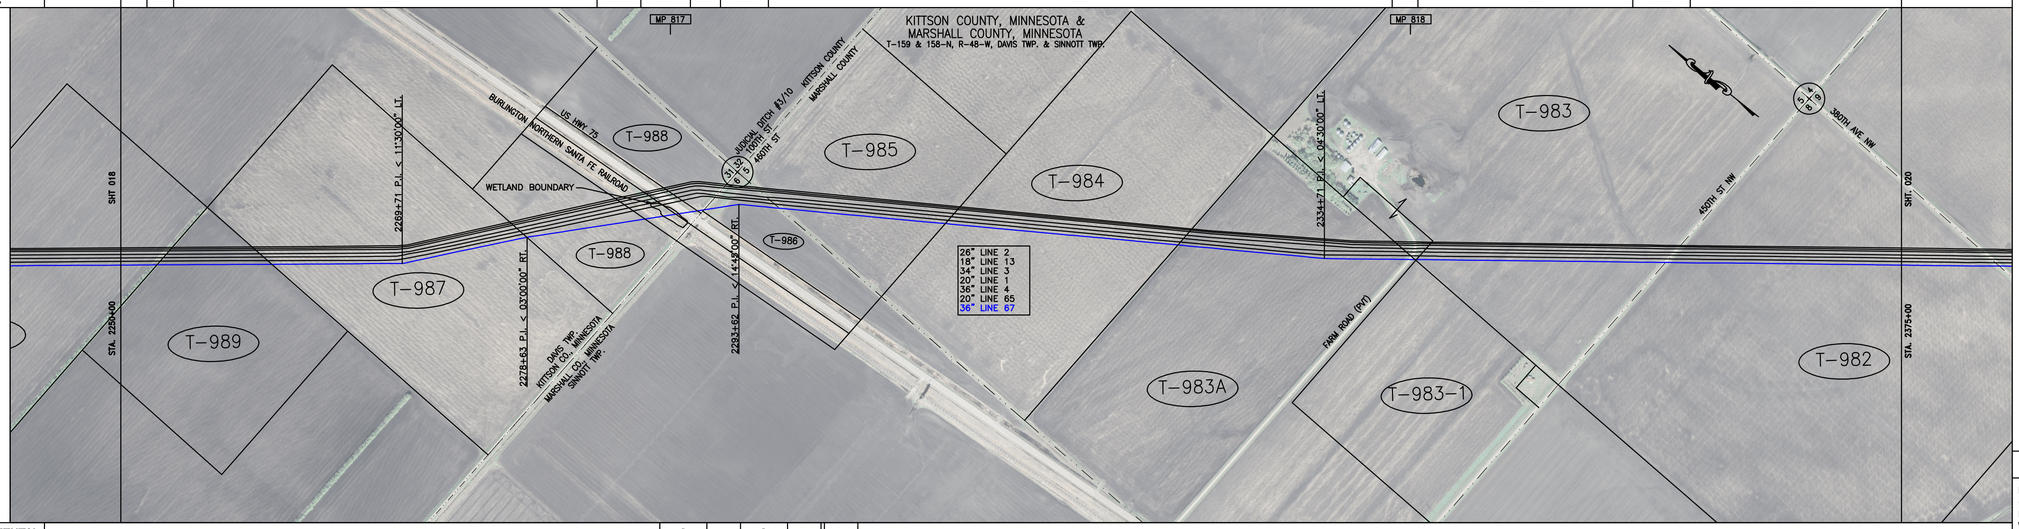

ENVIRONMENTAL

ESA #816.9	W-817A	ESA #817.0	W-817A	S-817A

CROSSING INFORMATION

| | | |


CROSSING INFORMATION

XX" LINE MATERIALS

ALL PIPE IS XX" O.D.
API 5L-X-70 STEEL PIPE
FBE COATED

TRACT NUMBER		T-982	T-981-RX 380TH AVE NW	T-981	T-981A	T-980	T-979-RX 440TH ST NW	T-979	T-978-RX 370TH AVE NW	T-978	T-976	T-975A-RX 430TH ST NW	T-975A-DD	T-975A	
LAND USE		CROP	ROAD	CROP			ROAD	CROP	ROAD	CROP		ROAD	DITCH	CROP	

PLAN
1" = 500'

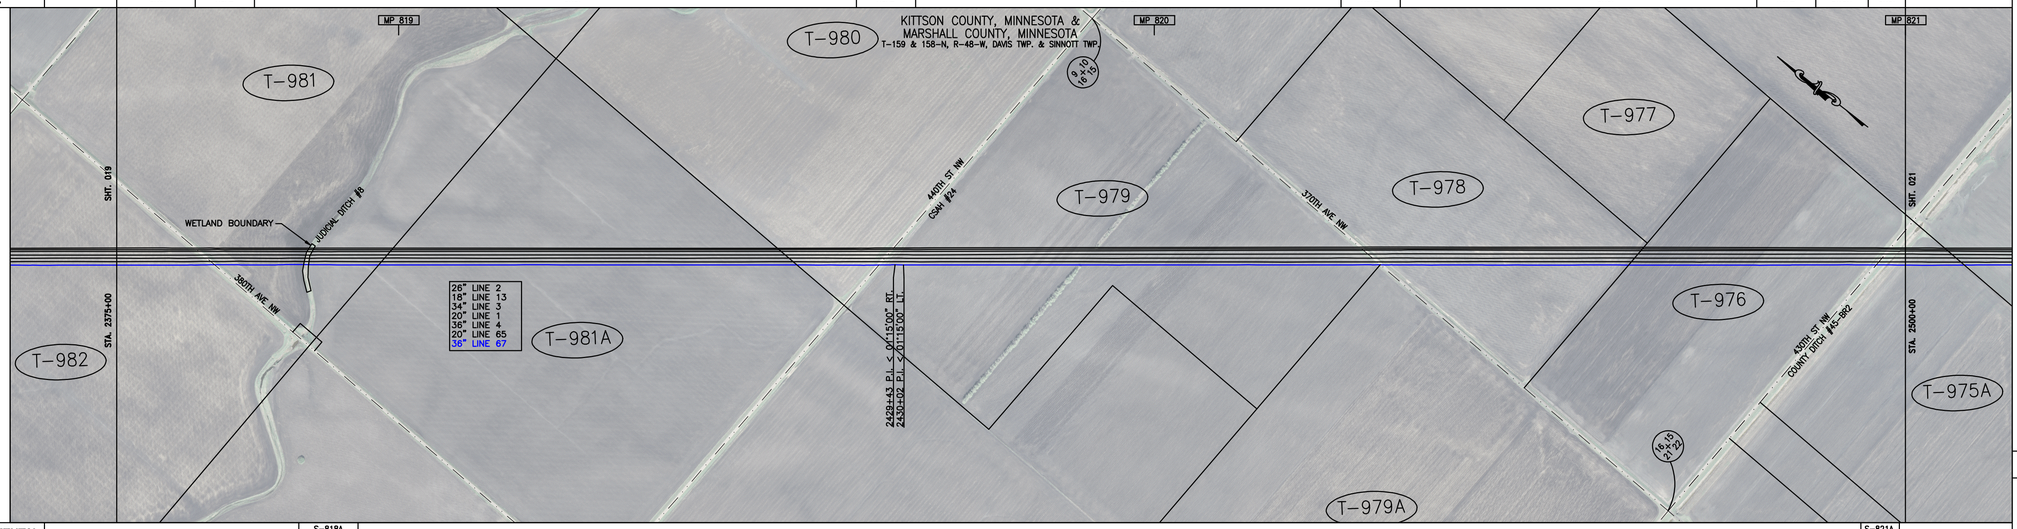

ENVIRONMENTAL

S-818A
W-818A

S-821A

CROSSING INFORMATION

| | | |


CROSSING INFORMATION

XX" LINE MATERIALS

ALL PIPE IS XX" O.D.
API 5L-X-70 STEEL PIPE
FBE COATED

TRACT NUMBER		T-975A	T-974	T-973	T-972	T-971-RX 360TH AVE NW	T-971	T-970-RX 420TH ST NW	T-970	T-968-RX 415TH ST NW	T-968	
LAND USE		CROP				ROAD	CROP	ROAD	CROP	ROAD	CROP	

PLAN
1" = 500'

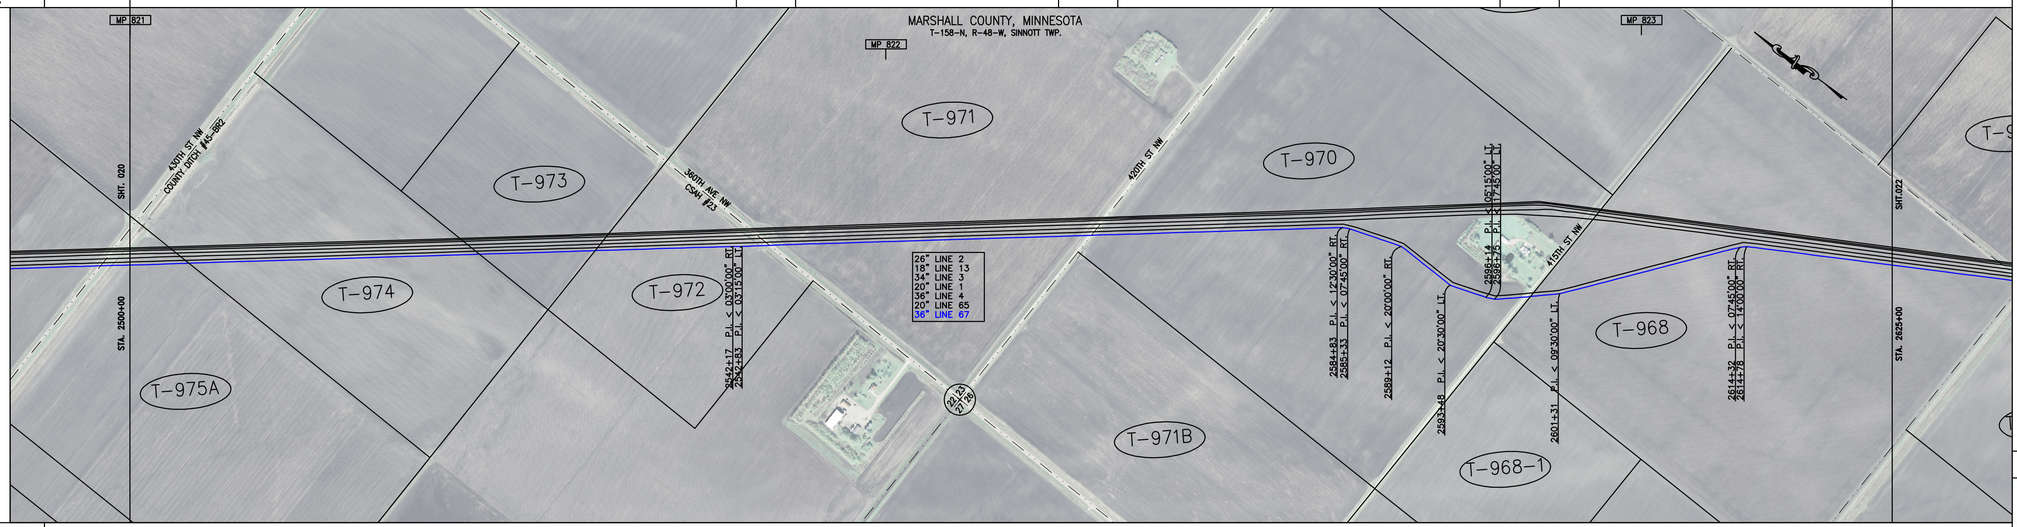

ENVIRONMENTAL

CROSSING INFORMATION

| | | | |


CROSSING INFORMATION

XX" LINE MATERIALS

ALL PIPE IS XX" O.D.
API 5L-X-70 STEEL PIPE
FBE COATED

TRACT NUMBER		T-968	T-967-RX 350TH AVE NW	T-967	T-966-RX 410TH ST NW	T-966-DD	T-966	T-964A-RX 400TH ST NW	T-964A	T-963A	T-963-RX 340TH AVE NW	T-963	T-963-DD	T-963
LAND USE		CROP	ROAD	CROP	ROAD	DITCH	CROP	ROAD	CROP		ROAD	CROP	DITCH	CROP

PLAN
1" = 500'

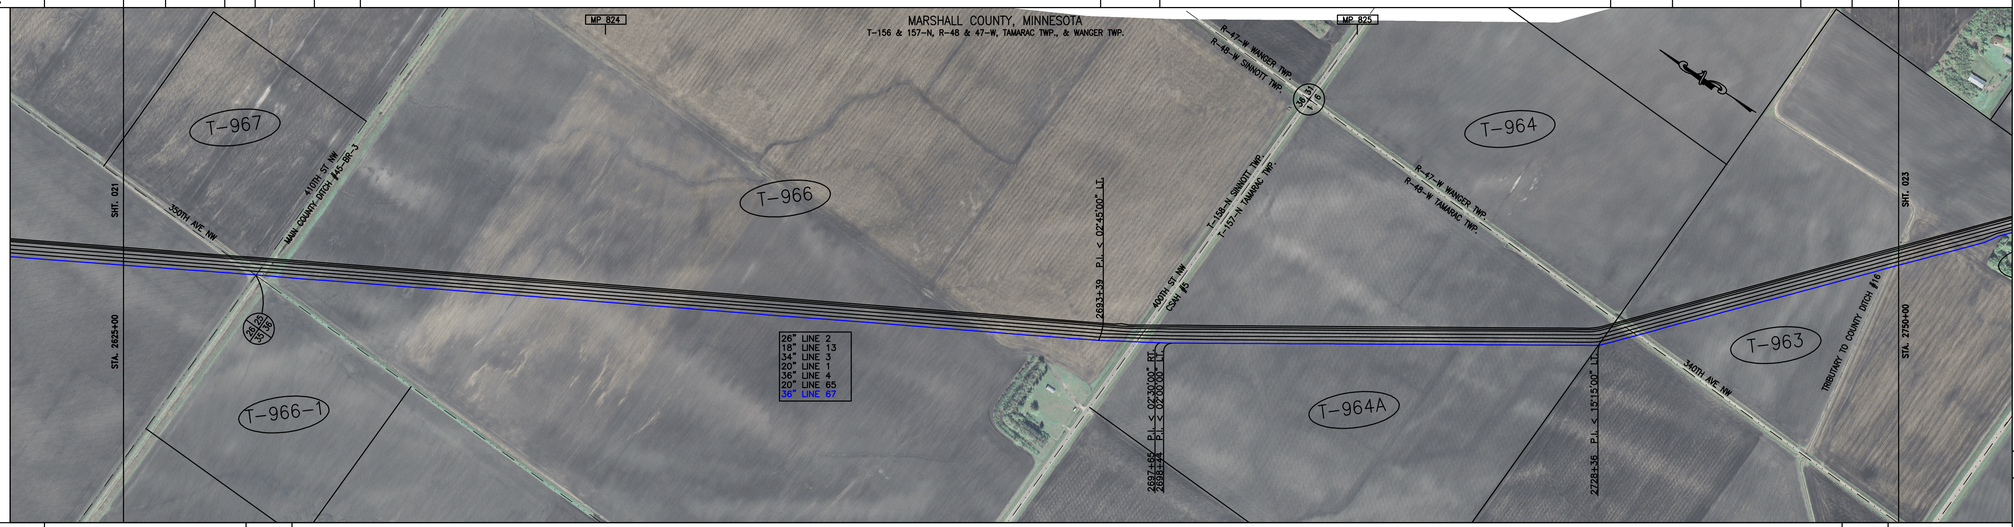

ENVIRONMENTAL S-823A S-825A

CROSSING INFORMATION

2633+63 CROP LINE
2633+84 ROAD R-O-W
2634+04 TOP OF BANK
2634+17 ROAD R-O-W
2634+27 PROPERTY LINE
2634+28 CROP LINE
2634+35 CL 410th ST NW
2634+57 TOP OF BANK
2634+98 TOL COUNTY DITCH #45-BR3
2635+40 ROAD R-O-W
2635+69 CL OF TRAIL ROAD
2635+89 CROP LINE
2638+19 CL DITCH
2638+36 CL DITCH
2647+13 CROP LINE
2663+92 CROP LINE
2683+39 P.I. < 02°45'00" LT.
2684+84 WATER LINE
2685+16 CROP LINE ELECTRIC
2685+28 TOP OF BANK
2685+30 ROAD R-O-W
2685+79 TOP OF BANK
2686+00 CL 400th ST NW
2686+03 SECTION LINE
2686+14 TOP OF BANK
2686+21 ROAD R-O-W
2686+58 CL DITCH
2686+68 CROP LINE
2686+71 BURIED TELEPHONE LINE
2687+49 ROAD R-O-W
2687+65 P.I. < 02°30'00" RT.
2688+44 P.I. < 02°00'00" LT.
2728+30 PROPERTY LINE
2728+36 P.I. < 15°15'00" LT.
2728+40 CROP LINE
2730+54 TOP OF BANK
2730+58 BURIED TELEPHONE LINE
2730+72 CL DITCH
2731+02 TOP OF BANK
2731+08 ROAD R-O-W
2731+10 SECTION LINE
2731+14 CL 340th AVE NW
2731+24 TOP OF BANK
2731+26 TOP OF BANK
2731+52 ROAD R-O-W
2731+57 TOP OF BANK
2731+63 CL DITCH
2731+69 CROP LINE
2749+12 TOP OF BANK
2749+14 CROP LINE
2749+66 TOP OF BANK
2749+70 CROP LINE
CL TRIBUTARY TO CO. DITCH #16


36" LINE MATERIALS

ALL PIPE IS 36" O.D.
API 5L-X-70 STEEL PIPE
FBE COATED

2625+00	2633+33	2635+94		2694+47	2694+60	2697+28	2697+41		2730+52	2731+73	2750+00
0.438" (833')	0.531" (261')	0.438" (5853')		0.469" (13')	0.562" (266')	0.469" (15')	0.438" (3311')		0.531" (121')	0.438" (1827')	

AS-BUILT

PIPE PROFILE
HORIZONTAL: 1" = 800'
VERTICAL: 1" = 100'

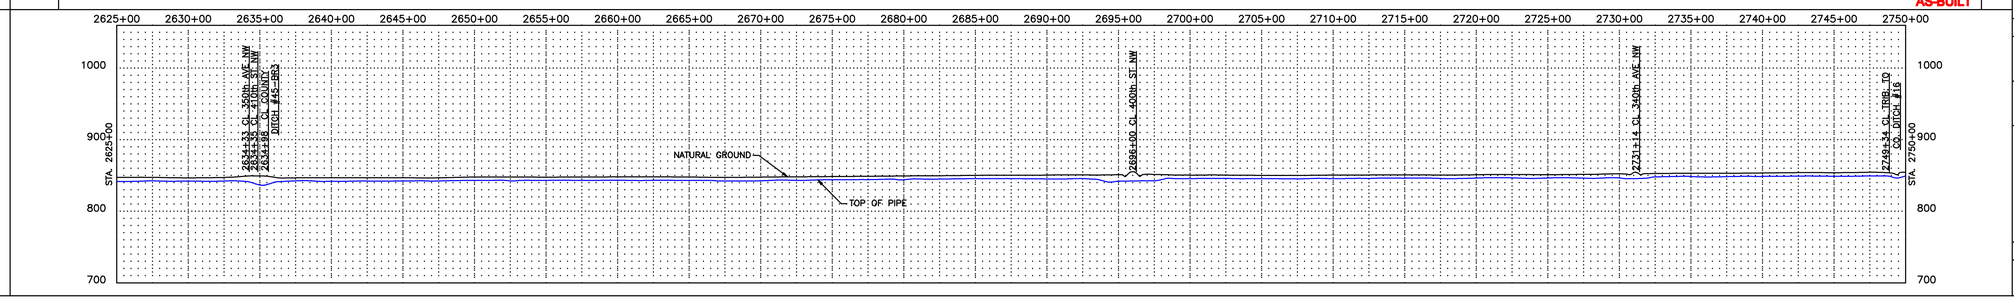

LEGEND

- INTERSTATE HIGHWAY
- US HIGHWAY
- STATE HIGHWAY
- CO. STATE AID HIGHWAYS
- COUNTY ROAD
- M. P. MARKER
- AERIAL M.P. MARKER
- CIVIL TOWNSHIP LINE
- FOREIGN PIPELINE
- SECTION LINES
- ROADS
- BURIED PHONE LINE
- BURIED POWER LINE
- OVERHEAD POWER LINE
- WATER LINE
- GAS LINE
- FIBER OPTIC CABLE LINE
- PROPERTY LINE
- RAILROADS
- WATER RIVERS, STREAMS, CREEKS, DITCHES
- ROCK SHIELD
- SET ON WEIGHTS
- CONCRETE COATING
- CASING
- MOV MOTOR OPERATED VALVE
- GATE VALVE
- TEE
- STOPPLE TEE
- REPAIR SLEEVE
- RECTIFIER
- WELD PLUS
- TEST LEAD

NOTES:

ENBRIDGE ENERGY # 1-800-858-5253
(L.C.) – LAND CONTRACT
RRX – RAILROAD CROSSING
WX – WATER CROSSING
RX – ROAD CROSSING
LWA – LOW WET AREA
WL – WETLAND (SEE WETLAND DELINEATION DRAWINGS REPORT)
GOPHER STATE ONE–CALL 1-800-252-1166
ALL STATIONING IN TRUE (PIPE) LENGTH

FIELD BOOK	FIELD BOOK	FIELD BOOK

NO.	REFERENCE DRAWINGS

REVISION	DATE	APPR.

SCALE	DATE	DRAWN	APPROVED	APPROVED
1"=500'		MM	CN	

800 400 200 100 0 200 500 1000
SCALE IN FEET

ENBRIDGE

AS–BUILT ALIGNMENT
ALBERTA CLIPPER 36" PIPELINE
MP 823.3 TO MP 825.7
STA. 2625+00 TO STA. 2750+00
MARSHALL COUNTY, MINNESOTA

DRAWING NUMBER	ROUTE SHEET
D–67–5.92–16941–022	022

CROSSING INFORMATION

XX" LINE MATERIALS

ALL PIPE IS XX" O.D.
API 5L-X-70 STEEL PIPE
FBE COATED

TRACT NUMBER		T-963	T-961	T-960-RX 390TH ST NW	T-960	T-959-RX 330TH AVE NW	T-959	T-958	T-957A	T-957C	T-957B	T-956-RX 380TH ST NW	T-956	T-955	
LAND USE		CROP		ROAD	CROP	ROAD	CROP					ROAD	CROP		

PLAN
1" = 500'




ENVIRONMENTAL

CROSSING INFORMATION

2754+64	CROP LINE	2765+49	CROP LINE	2771+35	P.I. < 02°45'00" LT.	2799+09	BURIED TELEPHONE LINE	2833+82	PROPERTY LINE	2839+89	PROPERTY LINE	2845+06	CROP LINE	2850+65	OVERHEAD ELECTRIC	2870+70	CROP LINE
2756+23	P.I. < 09°00'00" LT.	2766+30	PROPERTY LINE	2772+11	P.I. < 03°15'00" RT.	2799+28	CROP LINE	2834+82	CROP LINE			2848+05	PROPERTY LINE	2850+97	ROAD R-O-W	2870+71	SECTION LINE
2758+93	P.I. < 01°15'00" RT.	2768+30	BURIED CABLE			2799+39	TOP OF BANK	2835+07	P.I. < 05°00'00" RT.					2850+98	BURIED TELEPHONE LINE		
2760+36	P.I. < 08°45'00" RT.	2768+39	OVERHEAD ELECTRIC			2799+52	CL DITCH							2851+33	EDGE OF ROAD		
2762+38	P.I. < 08°45'00" LT.	2768+45	BURIED ELECTRIC LINE			2799+70	TOP OF BANK							2851+56	SECTION LINE		
2764+19	P.I. < 09°15'00" RT.	2768+50	ROAD R-O-W			2799+80	SECTION LINE							2851+57	EDGE OF ROAD		
		2768+72	BURIED CABLE			2799+81	CENTERLINE 330TH AVE NW							2851+57	CROP LINE		
		2768+80	EL COUNTY DITCH #16			2799+95	EDGE OF ROAD							2851+92	ROAD R-O-W		
		2768+80	BURIED TELEPHONE LINE			2800+17	CL DITCH										
		2769+16	CL DITCH			2800+23	ROAD R-O-W										
		2769+70	CLOSED, 1ST NW			2800+24	TOP OF BANK										
		2769+73	SECTION LINE			2800+38	CROP LINE										
		2770+03	EDGE OF ROAD			2800+44	BURIED TELEPHONE LINE										
		2770+48	CENTERLINE CULVERT			2811+20	CROP LINE										
		2770+59	OVERHEAD ELECTRIC			2811+49	PROPERTY LINE										
		2770+71	TOP OF BANK														
		2770+73	TOP OF BANK														
		2770+86	ROAD R-O-W														


36" LINE MATERIALS

ALL PIPE IS 36" O.D.
API 5L-X-70 STEEL PIPE
FBE COATED

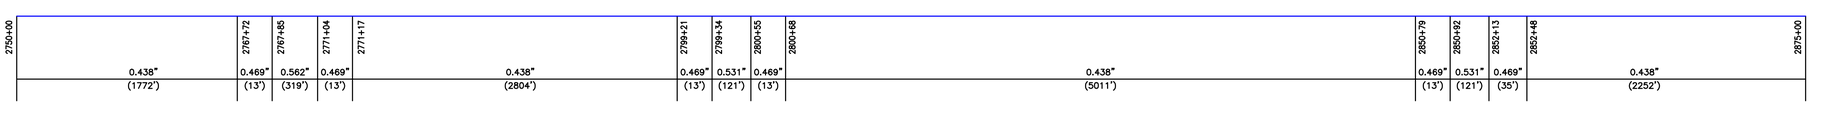

AS-BUILT

PIPE PROFILE
HORIZONTAL: 1" = 800'
VERTICAL: 1" = 100'

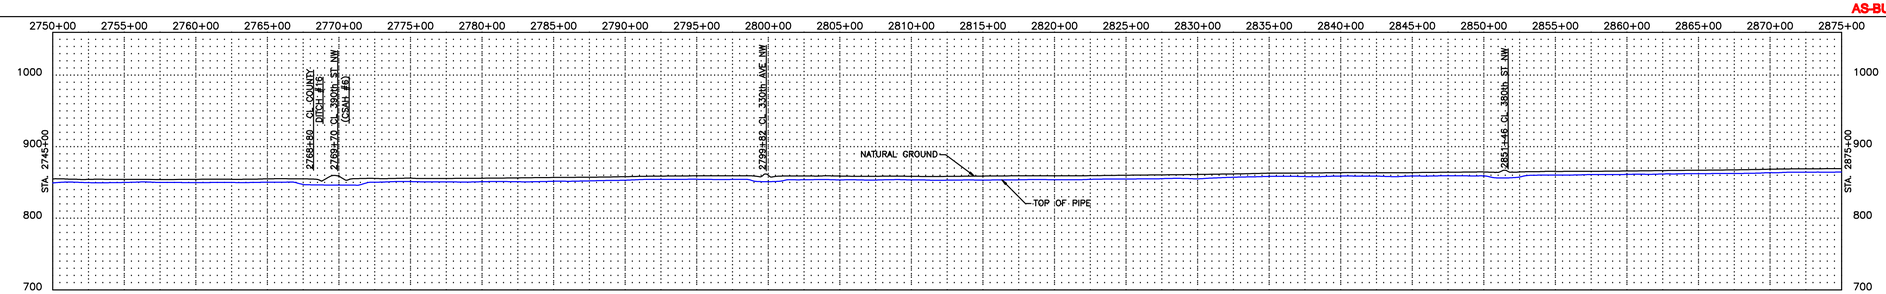

LEGEND

- INTERSTATE HIGHWAY
- US HIGHWAY
- STATE HIGHWAY
- CO. STATE AID HIGHWAYS
- COUNTY ROAD
- M. P. MARKER
- AERIAL M.P. MARKER
- CIVIL TOWNSHIP LINE
- FOREIGN PIPELINE
- SECTION LINES
- ROADS
- BURIED PHONE LINE
- BURIED POWER LINE
- OVERHEAD POWER LINE
- WATER LINE
- GAS LINE
- FIBER OPTIC CABLE LINE
- PROPERTY LINE
- RAILROADS
- WATER RIVERS, STREAMS, CREEKS, DITCHES
- ROCK SHIELD
- SET ON WEIGHTS
- CONCRETE COATING
- CASING
- MOV MOTOR OPERATED VALVE
- GATE VALVE
- TEE
- STOPPLE TEE
- REPAIR SLEEVE
- RECTIFIER
- WELD PLUS
- TEST LEAD

NOTES:

ENBRIDGE ENERGY # 1-800-858-5253
(L.C.) – LAND CONTRACT
RRX – RAILROAD CROSSING
WX – WATER CROSSING
RX – ROAD CROSSING
LWA – LOW WET AREA
WL – WETLAND (SEE WETLAND DELINEATION DRAWINGS REPORT)
GOPHER STATE ONE-CALL 1-800-252-1166
ALL STATIONING IN TRUE (PIPE) LENGTH

FIELD BOOK	FIELD BOOK	FIELD BOOK

NO.	REFERENCE DRAWINGS

REVISION	DATE	APPR.

SCALE	DATE	DRAWN	APPROVED	APPROVED
1"=500'		MM	CN	

800 400 200 100 0 200 500 1000
SCALE IN FEET

ENBRIDGE

AS-BUILT ALIGNMENT
ALBERTA CLIPPER 36" PIPELINE
MP 825.7 TO MP 828.1
STA. 2750+00 TO STA. 2875+00
MARSHALL COUNTY, MINNESOTA

DRAWING NUMBER	ROUTE SHEET
D-67-5.92-16942-023	023


CROSSING INFORMATION

XX" LINE MATERIALS

ALL PIPE IS XX" O.D.
API 5L-X-70 STEEL PIPE
FBE COATED

TRACT NUMBER	T-955	T-953-2	T-953-2-WX	T-953-2	T-953-1-1	T-953-1	T-953 T-953-1	T-953A	T-952-RX 310TH AVE NW	T-952	T-951	T-950	
LAND USE	CROP	TREES	RIVER	CROP					ROAD	CROP		TREES	CROP

PLAN
1" = 500'

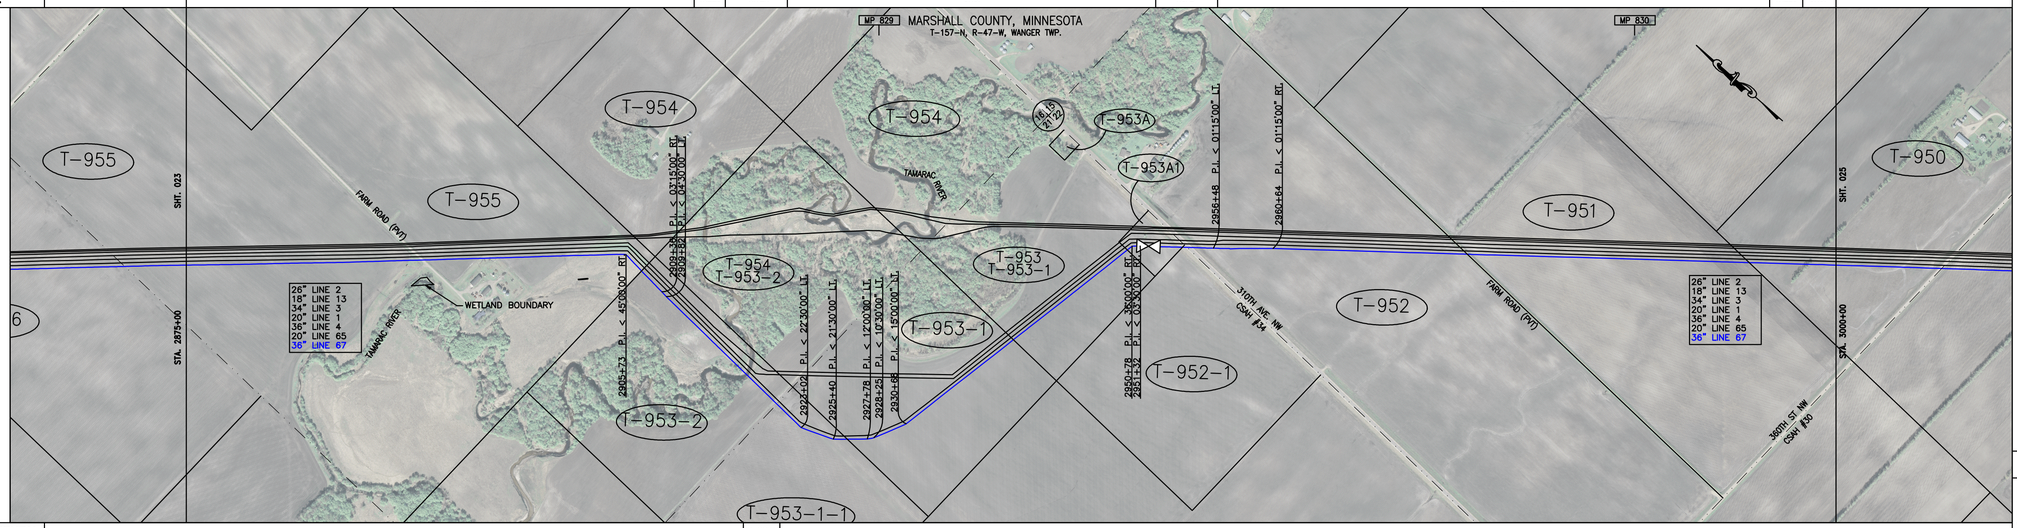

ENVIRONMENTAL S-828A

CROSSING INFORMATION

| | | | | |


CROSSING INFORMATION

XX" LINE MATERIALS

ALL PIPE IS XX" O.D.
API 5L-X-70 STEEL PIPE
FBE COATED

TRACT NUMBER		T-950	T-949-RX 360TH ST NW	T-949					T-948-RX 300TH AVE NW	T-948	T-947A				T-946	T-945-RX 350TH ST NW	T-945	T-944-RX 290TH AVE NW	T-944	T-943	
LAND USE		CROP	ROAD	CROP	TREES	CROP	TREES	CROP	ROAD	CROP	CROP	TREES	CROP	TREES	CROP	ROAD	CROP	ROAD	CROP		

PLAN
1" = 500'

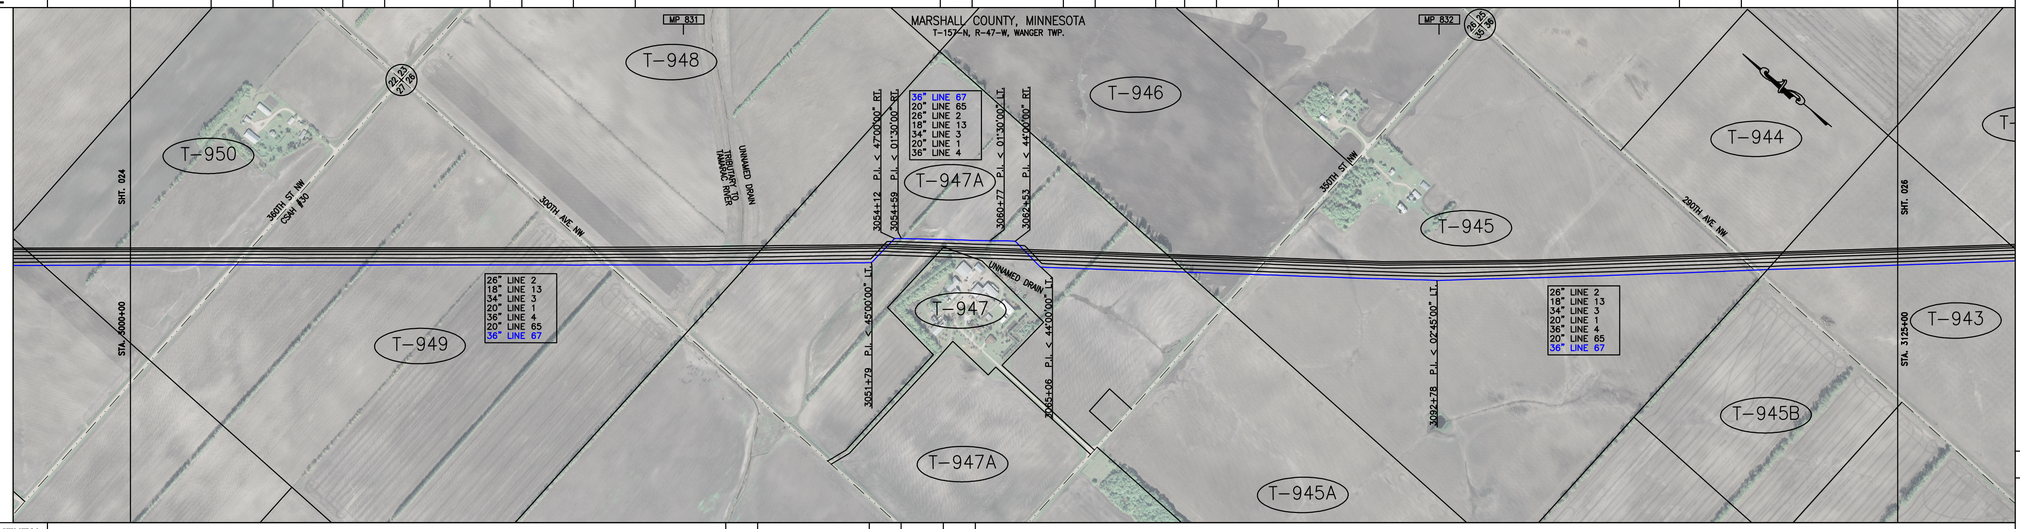

ENVIRONMENTAL

S-831A | S-831B | S-831B

CROSSING INFORMATION

| | | | | |


CROSSING INFORMATION

XX" LINE MATERIALS

ALL PIPE IS XX" O.D.
API 5L-X-70 STEEL PIPE
FBE COATED

TRACT NUMBER		T-943	T-942	T-941	T-940-RX 340TH ST NW	T-940							T-939-RX 280TH AVE NW	T-939	T-938	T-937	T-936	T-936A	T-935-RX 350TH ST NW	T-935	
LAND USE		CROP			ROAD	CROP	TREES	CROP	TREES	CROP	TREES	CROP	ROAD	CROP			TREES	CROP	OPEN	ROAD	CROP	

PLAN
1" = 500'

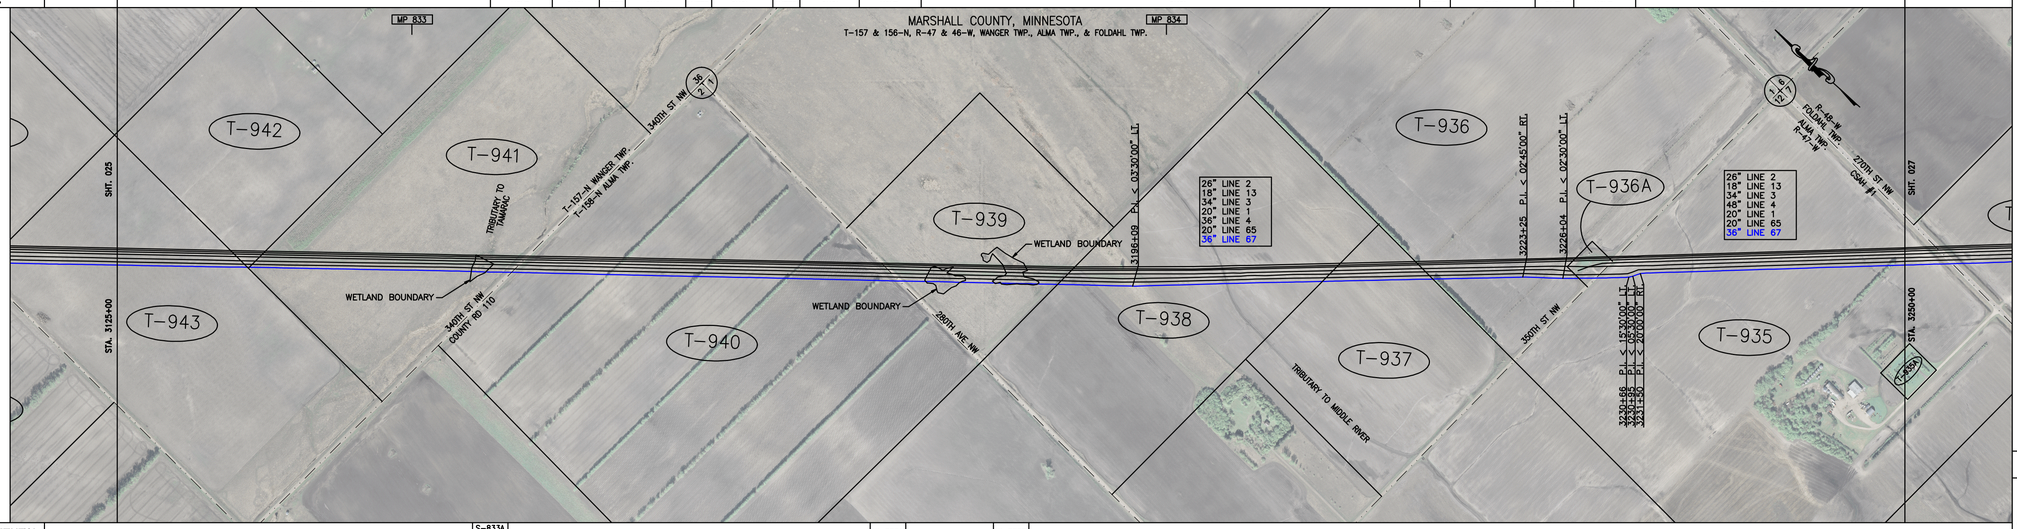
MARSHALL COUNTY, MINNESOTA
T-157 & 156-N, R-47 & 46-W, WANGER TWP., ALMA TWP., & FOLDAHL TWP.
MP 833
MP 834
SHT. 025
SHT. 027
STA. 3125+00
STA. 3250+00
T-942
T-941
T-943
T-940
T-939
T-938
T-937
T-936
T-936A
T-935
T-157-N WANGER TWP.
T-156-N ALMA TWP.
340TH ST NW
COUNTY RD 110
WETLAND BOUNDARY
WETLAND BOUNDARY
280TH AVE NW
TRIBUTARY TO MIDDLE RIVER
350TH ST NW
270TH ST NW
CSAH 7
R-46-W
FOLDAHL TWP.
ALMA TWP.
R-47-W
3198+09 P.I. < 02°30'00" LT.
3223+25 P.I. < 02°45'00" RT.
3228+04 P.I. < 02°30'00" LT.
3230+66 P.I. < 15°30'00" LT.
3231+85 P.I. < 06°30'00" LT.
3241+30 P.I. < 20°00'00" RT.
26" LINE 2
18" LINE 13
34" LINE 3
20" LINE 1
36" LINE 4
20" LINE 65
36" LINE 67
26" LINE 2
18" LINE 13
34" LINE 3
48" LINE 4
20" LINE 1
20" LINE 65
36" LINE 67


CROSSING INFORMATION

XX" LINE MATERIALS

ALL PIPE IS XX" O.D.
API 5L-X-70 STEEL PIPE
FBE COATED

TRACT NUMBER		T-935	T-934-RX 270TH AVE NW	T-934	T-933	T-932						T-931	T-931-RX 320TH ST NW	T-931	T-930-RX 260TH AVE NW	T-930A	T-930	T-929	T-928	T-927	T-926	
LAND USE		CROP	ROAD	CROP		TREES	CROP	TREES	DRIVE	OPEN	TREES	RIVER	OPEN	ROAD	CROP	ROAD	OPEN	OPEN	CROP	OPEN	CROP	

PLAN
1" = 500'

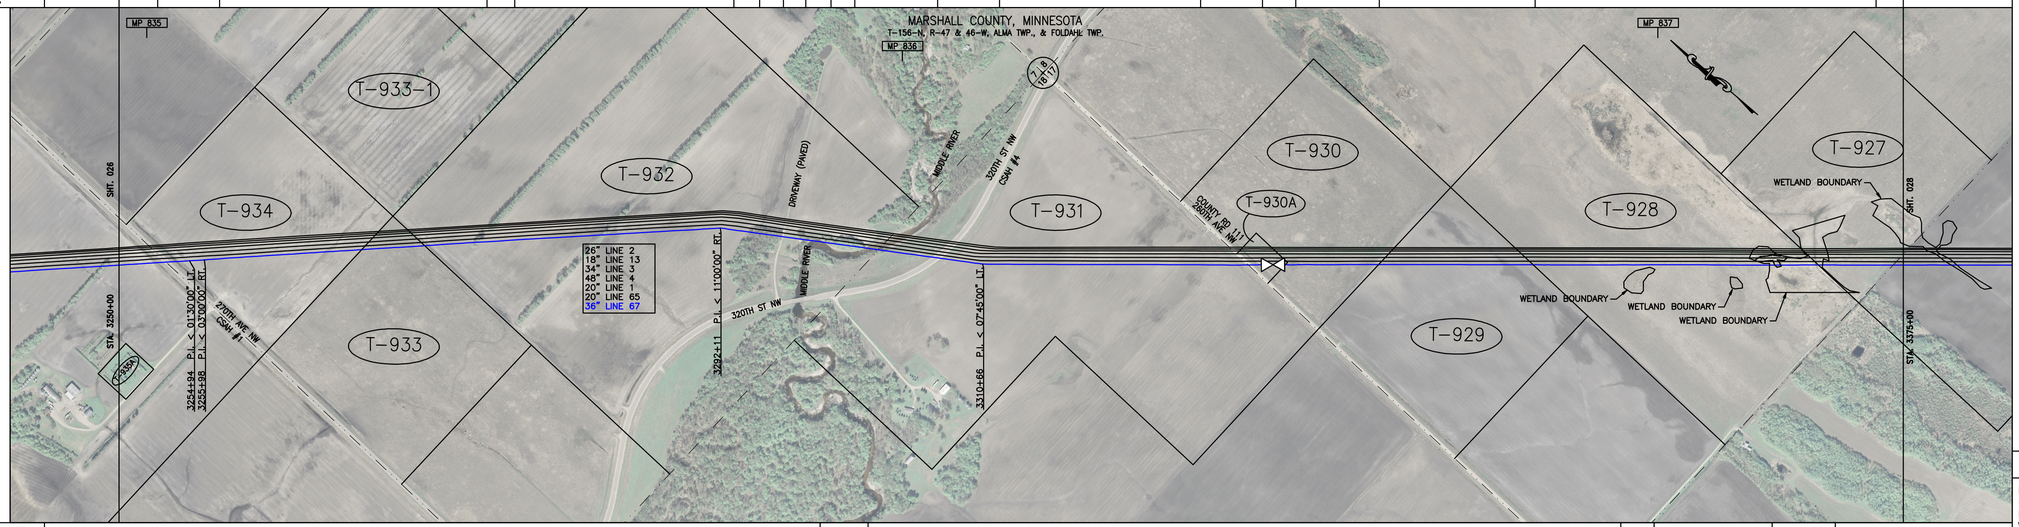


ENVIRONMENTAL																						
								S-836A										W-837E			W-837C	

CROSSING INFORMATION

3252+36 ROAD R-O-W
3252+45 TOP OF BANK
3252+64 BURIED ELECTRIC LINE
3253+09 TOP OF BANK
3253+16 EDGE OF ROAD
3253+32 CL 270th ST NW
3253+46 EDGE OF ROAD
3253+54 TOP OF BANK
3253+95 CL DITCH
3254+24 CROP LINE
3254+29 BURIED PHONE LINE
3254+29 OVERHEAD ELECTRIC LINE
3254+94 P.I. < 01°30'00" LT.
3255+98 P.I. < 03°00'00" RT.
3264+38 TOP OF BANK
3264+51 CL DITCH
3267+00 PROPERTY LINE
3271+41 PROPERTY LINE
3292+11 P.I. < 11°00'00" RT.
3294+28 CROP LINE
3296+34 BURIED CABLE
3296+46 EDGE OF ROAD
3296+58 CL DITCH
3296+69 EDGE OF ROAD
3302+12 OVERHEAD ELECTRIC
3302+44 CL MIDDLE RIVER
3303+29 EDGE OF WATER
3303+29 SECTION LINE
3306+74 ROAD R-O-W
3307+05 BURIED PHONE LINE
3307+25 EDGE OF ROAD
3307+45 CL 320th ST NW
3307+66 EDGE OF ROAD
3308+16 ROAD R-O-W
3308+33 BURIED PHONE LINE
3308+53 BURIED TELEPHONE LINE
3308+63 EDGE OF ROAD
3310+66 P.I. < 07°45'00" LT.
3328+35 CROP LINE
3328+38 OVERHEAD ELECTRIC
3328+38 ROAD R-O-W
3328+62 TOP OF BANK
3328+67 CL DITCH
3328+67 OVERHEAD ELECTRIC
3329+19 CL 260th AVE NW
3329+22 BURIED PHONE LINE
3329+22 TOP OF BANK
3329+36 EDGE OF ROAD
3330+05 BURIED ELECTRIC CABLE
3330+82 CL DITCH
3330+95 TOP OF BANK
3331+01 ROAD R-O-W
3331+15 WATER LINE
3331+62 PROPERTY LINE
3337+88 CROP LINE
3338+33 PROPERTY LINE
3349+05 CROP LINE
3349+13 PROPERTY LINE
3365+65 EDGE OF WETLAND
3368+86 CL DITCH
3369+06 PROPERTY LINE
3369+36 EDGE OF WETLAND
3374+11 CROP LINE
3374+28 SECTION LINE


36" LINE MATERIALS

ALL PIPE IS 36" O.D.
API 5L-X-70 STEEL PIPE
FBE COATED

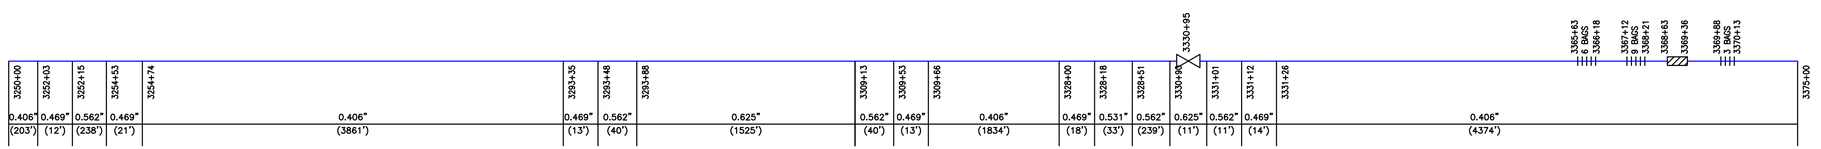

AS-BUILT

PIPE PROFILE
HORIZONTAL: 1" = 800'
VERTICAL: 1" = 100'

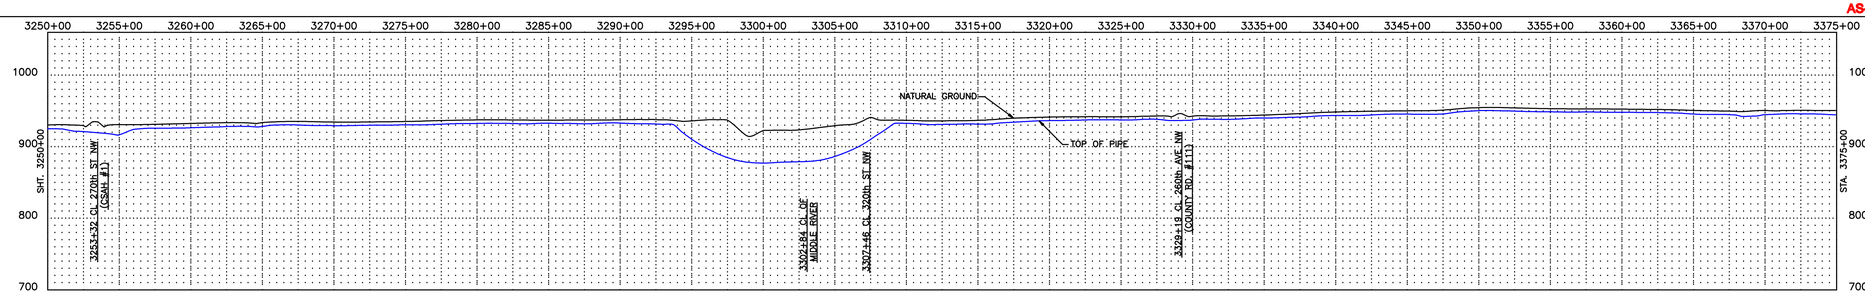

LEGEND

- INTERSTATE HIGHWAY
- US HIGHWAY
- STATE HIGHWAY
- CO. STATE AID HIGHWAYS
- COUNTY ROAD
- M. P. MARKER
- AERIAL M.P. MARKER
- CIVIL TOWNSHIP LINE
- FOREIGN PIPELINE
- SECTION LINES
- ROADS
- BURIED PHONE LINE
- BURIED POWER LINE
- OVERHEAD POWER LINE
- WATER LINE
- GAS LINE
- FIBER OPTIC CABLE LINE
- PROPERTY LINE
- RAILROADS
- WATER RIVERS, STREAMS, CREEKS, DITCHES
- ROCK SHIELD
- SET ON WEIGHTS
- CONCRETE COATING
- CASING
- MOTOR OPERATED VALVE
- GATE VALVE
- TEE
- STOPPLE TEE
- REPAIR SLEEVE
- RECTIFIER
- WELD PLUS
- TEST LEAD

NOTES:

ENBRIDGE ENERGY # 1-800-858-5253
(L.C.) – LAND CONTRACT
RRX – RAILROAD CROSSING
WX – WATER CROSSING
RX – ROAD CROSSING
LWA – LOW WET AREA
WL – WETLAND (SEE WETLAND DELINEATION DRAWINGS REPORT)
GOPHER STATE ONE–CALL 1-800-252-1166
ALL STATIONING IN TRUE (PIPE) LENGTH

FIELD BOOK	FIELD BOOK	FIELD BOOK

NO.	REFERENCE DRAWINGS

REVISION	DATE	APPR.

SCALE	DATE	DRAWN	APPROVED	APPROVED
1"=500'		MM	CN	

800 400 200 100 0 200 500 1000
SCALE IN FEET

ENBRIDGE

AS-BUILT ALIGNMENT
ALBERTA CLIPPER 36" PIPELINE
MP 834.9 TO MP 837.3
STA. 3250+00 TO STA. 3375+00
MARSHALL COUNTY, MINNESOTA

DRAWING NUMBER	ROUTE SHEET
D-67-5.92-16946-027	027

CROSSING INFORMATION

XX" LINE MATERIALS

ALL PIPE IS XX" O.D.
API 5L-X-70 STEEL PIPE
FBE COATED

| | | |


CROSSING INFORMATION

XX" LINE MATERIALS

ALL PIPE IS XX" O.D.
API 5L-X-70 STEEL PIPE
FBE COATED

TRACT NUMBER	T-921	T-920	T-918A-RX 290TH ST NW	T-918A	T-918	T-918B	T-917A	T-916A-RX 230TH AVE NW	T-916A	T-916	T-914-RX 280TH ST NW	T-914
LAND USE	TREES	CROP	ROAD	CROP	TREES	CROP	ROAD	CROP		ROAD	CROP	

PLAN
1" = 500'

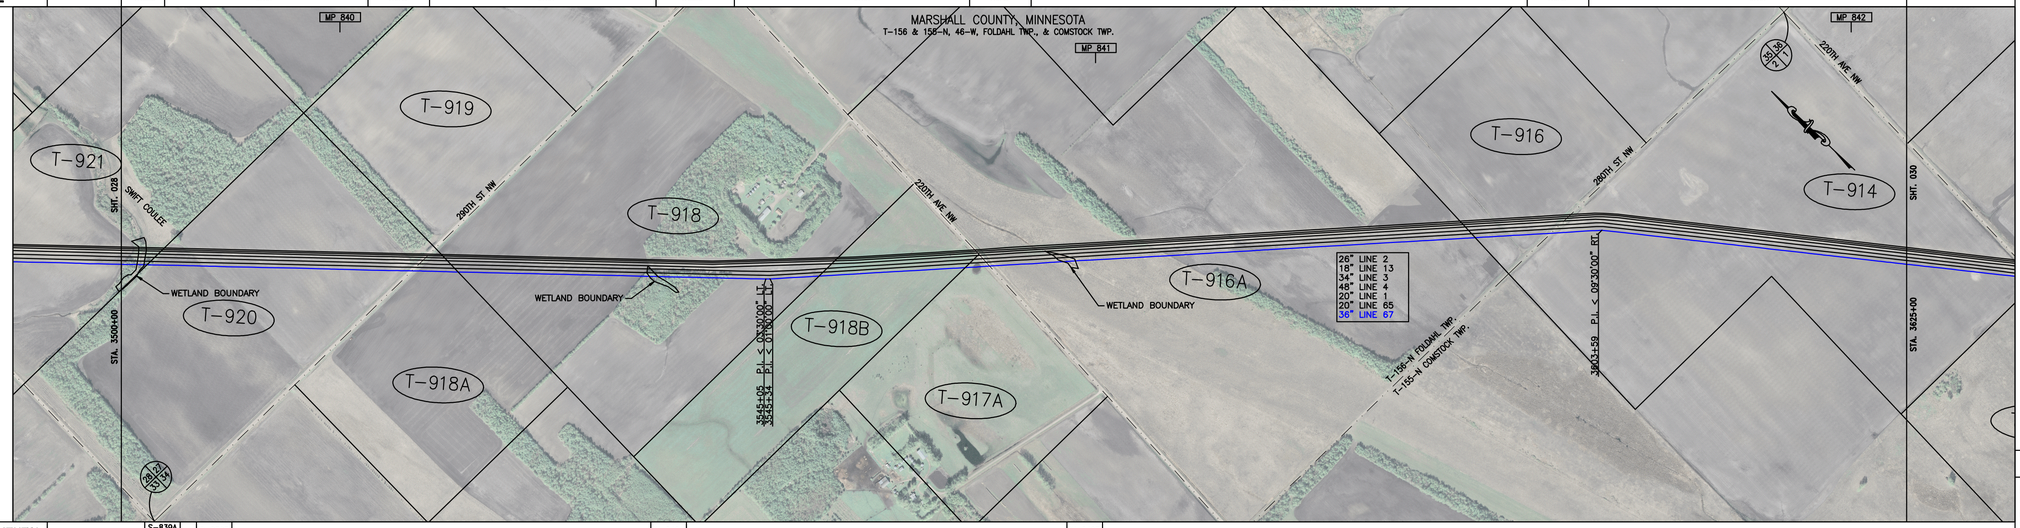


ENVIRONMENTAL	S-839A W-839A	S-839B	W-840A	W-840B

CROSSING INFORMATION

3500+20	CROP LINE	3519+85	ROAD R-O-W
3500+89	TOP OF BANK	3519+86	CROP LINE
3501+10	EDGE OF WETLAND	3520+15	EDGE OF ROAD
3501+59	EDGE OF WETLAND	3520+31	CL 280th ST NW
3501+65	TOP OF BANK	3520+31	STATION AHEAD
3501+85	TOP OF BANK	3520+48	EDGE OF ROAD
3502+07	CROP LINE	3520+67	RD DITCH
3502+24	CROP LINE	3520+77	ROAD R-O-W
3505+66	TOP OF BANK	3523+79	CROP LINE
3505+75	TOP OF BANK (ABANDONED)	3523+35	PROPERTY LINE
3505+86	TOP OF BANK		
3505+86	CROP LINE		
3536+45	CROP LINE	3545+05	P.I. < 03°30'00" LT.
3536+91	EDGE OF WETLAND	3545+34	P.I. < 01°00'00" LT.
3537+50	EDGE OF WETLAND		
3548+76	CROP LINE	3556+81	OVERHEAD ELECTRIC LINE
3549+03	CROP LINE	3559+00	PROPERTY LINE
		3559+05	CROP LINE
		3559+17	OVERHEAD ELECTRIC LINE
		3559+51	TOP OF BANK
		3560+06	EDGE OF WATER
		3560+18	TOP OF BANK
		3560+25	ROAD R-O-W
		3560+50	CL 230th AVE NW
		3560+67	STATION AHEAD
		3560+82	BURIED TELEPHONE LINE
		3561+02	RD DITCH
		3561+08	ROAD R-O-W
		3565+90	EDGE OF WETLAND
		3566+72	EDGE OF WETLAND
		3594+71	PROPERTY LINE
		3599+51	ROAD R-O-W
		3599+71	CROP LINE
		3599+93	EDGE OF ROAD
		3600+03	CL 280th ST NW
		3600+17	EDGE OF ROAD
		3600+44	RD DITCH
		3600+51	ROAD R-O-W
		3600+58	CROP LINE
		3603+59	P.I. < 09°30'00" RT.


36" LINE MATERIALS

ALL PIPE IS 36" O.D.
API 5L-X-70 STEEL PIPE
FBE COATED

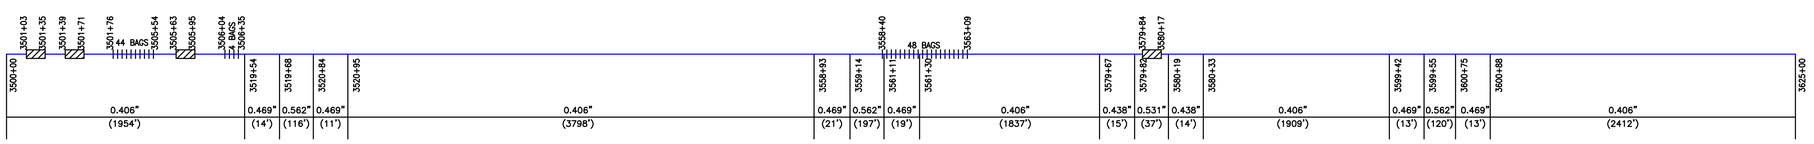

AS-BUILT

PIPE PROFILE
HORIZONTAL: 1" = 500'
VERTICAL: 1" = 100'

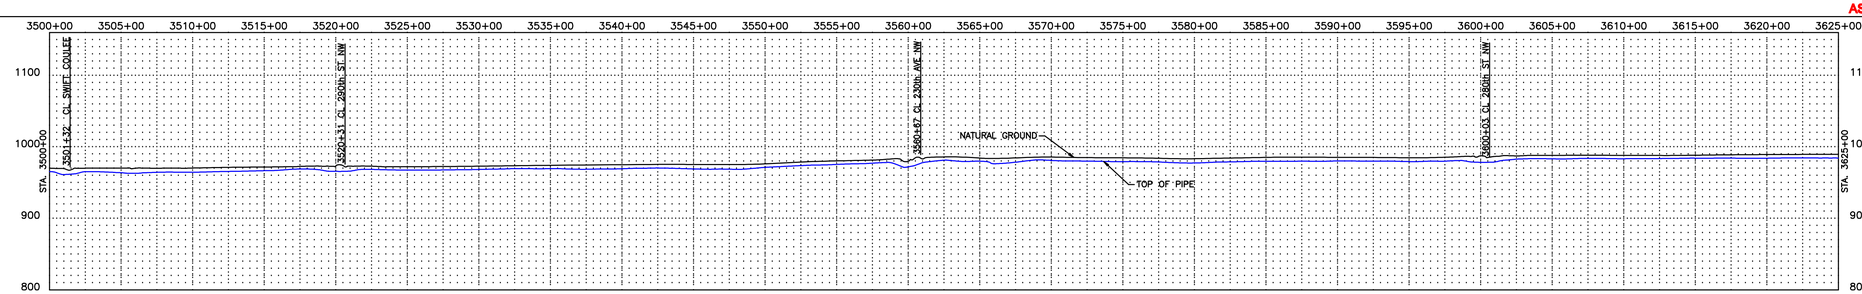

LEGEND

- INTERSTATE HIGHWAY
- US HIGHWAY
- STATE HIGHWAY
- CO. STATE AID HIGHWAYS
- COUNTY ROAD
- M. P. MARKER
- AERIAL M.P. MARKER
- CIVIL TOWNSHIP LINE
- FOREIGN PIPELINE
- SECTION LINES
- ROADS
- BURIED PHONE LINE
- BURIED POWER LINE
- OVERHEAD POWER LINE
- WATER LINE
- GAS LINE
- FIBER OPTIC CABLE LINE
- PROPERTY LINE
- RAILROADS
- WATER (RIVERS, STREAMS, CREEKS, DITCHES)
- ROCK SHIELD
- SET ON WEIGHTS
- CONCRETE COATING
- CASING
- MOTOR OPERATED VALVE
- GATE VALVE
- TEE
- STOPPLE TEE
- REPAIR SLEEVE
- RECTIFIER
- WELD PLUS
- TEST LEAD

NOTES:

ENBRIDGE ENERGY # 1-800-858-5253
(L.C.) – LAND CONTRACT
RRX – RAILROAD CROSSING
WX – WATER CROSSING
RX – ROAD CROSSING
LWA – LOW WET AREA
WL – WETLAND (SEE WETLAND DELINEATION DRAWINGS REPORT)
GOPHER STATE ONE-CALL 1-800-252-1166
ALL STATIONING IN TRUE (PIPE) LENGTH

FIELD BOOK	FIELD BOOK	FIELD BOOK

NO.	REFERENCE DRAWINGS

REVISION	DATE	APPR.

SCALE	DATE	DRAWN	APPROVED	APPROVED
1"=500'		MM	CN	

800 400 200 100 0 200 500 1000
SCALE IN FEET

ENBRIDGE

AS-BUILT ALIGNMENT
ALBERTA CLIPPER 36" PIPELINE
MP 839.7 TO MP 842.1
STA. 3500+00 TO STA. 3625+00
MARSHALL COUNTY, MINNESOTA

DRAWING NUMBER	ROUTE SHEET
D-67-5.92-16948-029	029


CROSSING INFORMATION

XX" LINE MATERIALS

ALL PIPE IS XX" O.D.
API 5L-X-70 STEEL PIPE
FBE COATED

TRACT NUMBER		T-914	T-911-RX 220TH AVE NW	T-911	T-912	T-911	T-910-RX 270TH ST NW	T-910	T-909A	T-909	T-908	T-907A-RX 210TH AVE NW	T-907A T-903-6	T-903-5A	T-903-5-1	T-906 T-903-5	
LAND USE		CROP	ROAD	CROP			ROAD	CROP	TREES	TREES / OPEN / TREES / RIVER / CROP	CROP / TREES / CROP	ROAD	CROP	OPEN	CROP		

PLAN
1" = 500'

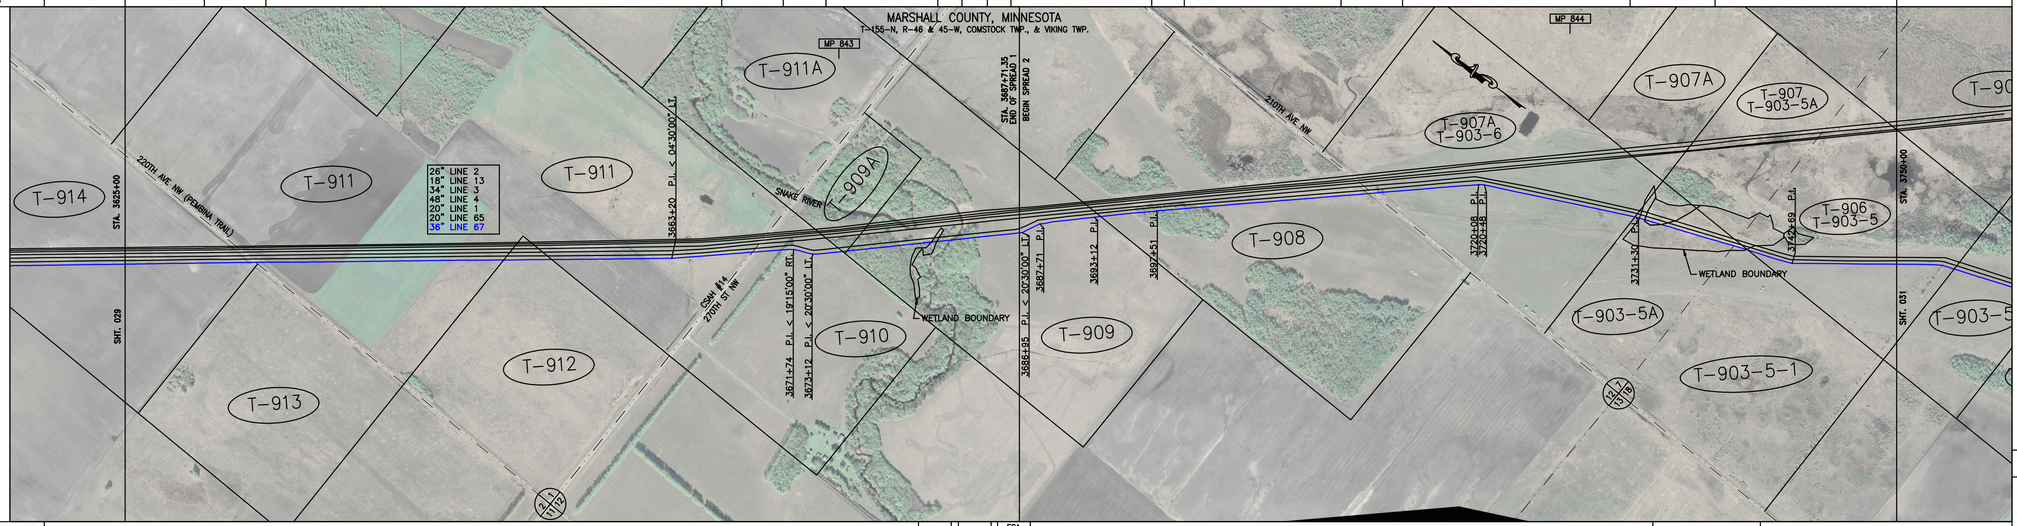

ENVIRONMENTAL

W-843A | S-843A | ESA #843.2 | W-844A

CROSSING INFORMATION

| | | |