
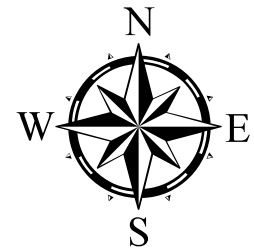


Overview

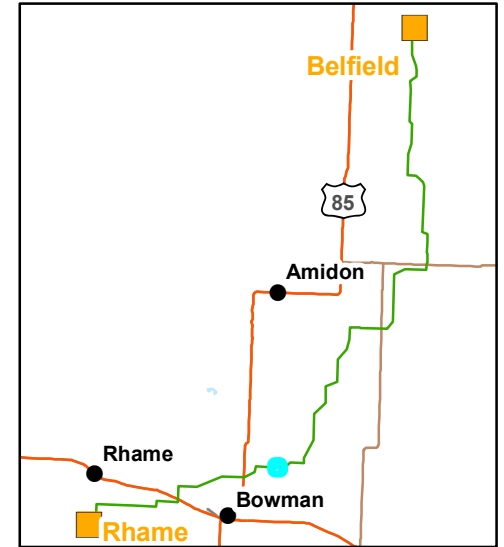

1 inch = 300 feet

Map Features

- Structures
- - - Transmission Route
- Old Route
- Townships
- Sections

04/15/2009