

**BASIN ELECTRIC
POWER COOPERATIVE**

1717 EAST INTERSTATE AVENUE
BISMARCK, NORTH DAKOTA 58503-0564
PHONE 701-223-0441
FAX: 701/224-5336



RECEIVED

February 2, 2010

FEB 05 2010

PUBLIC SERVICE COMMISSION

Darrell Nitschke
Executive Secretary
North Dakota Public Service Commission
600 East Boulevard, Dept. 408
Bismarck, ND 58505-0480

Re: Case No. PU-07-671
Williston to Tioga 230kV transmission line

Dear Mr. Nitschke:

Enclosed are ten (10) copies of the proposed route changes regarding the above entitled matter.

If you have any questions, please contact me at cjacobson@bepc.com or (701) 557-5413.

Sincerely,

Casey J. Jacobson
Attorney


ccj/ds
enclosures

cc: Annette Bendish
✓ Jerry Lien

42 PU-07-671 Filed: 2/5/2010 Pages: 2
Route Change Map

Basin Electric Power Cooperative

Casey Jacobson, Attorney

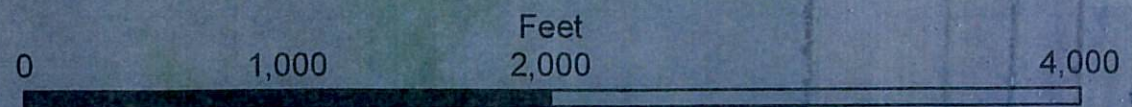

Map Features

- Current Structure Locations
- Old Structure Locations
- Transmission Route
- Townships

