

Jennifer Kraft

From: "Jennifer Kraft" <lakraft@ideaone.net>
To: <sfsheldon@nd.gov>
Sent: Tuesday, June 21, 2011 3:04 PM
Subject: Case No. PU-07-759
To: State of North Dakota Public Service Commission




Case No. PU-07-759

Cap-X Transmission Line

The proposed transmission line that could run through the west 1/2 of section 26 139-51 and west 1/2 of section 35 139-51, Dean, Jennifer, Arlyn, and Eleanor Kraft are opposed to the current site proposal. We feel the lines are too close to our runway 2ND0 and would create a hazard for aerial application activities off the runway and personal flights.

Yours truly,

Dean Kraft

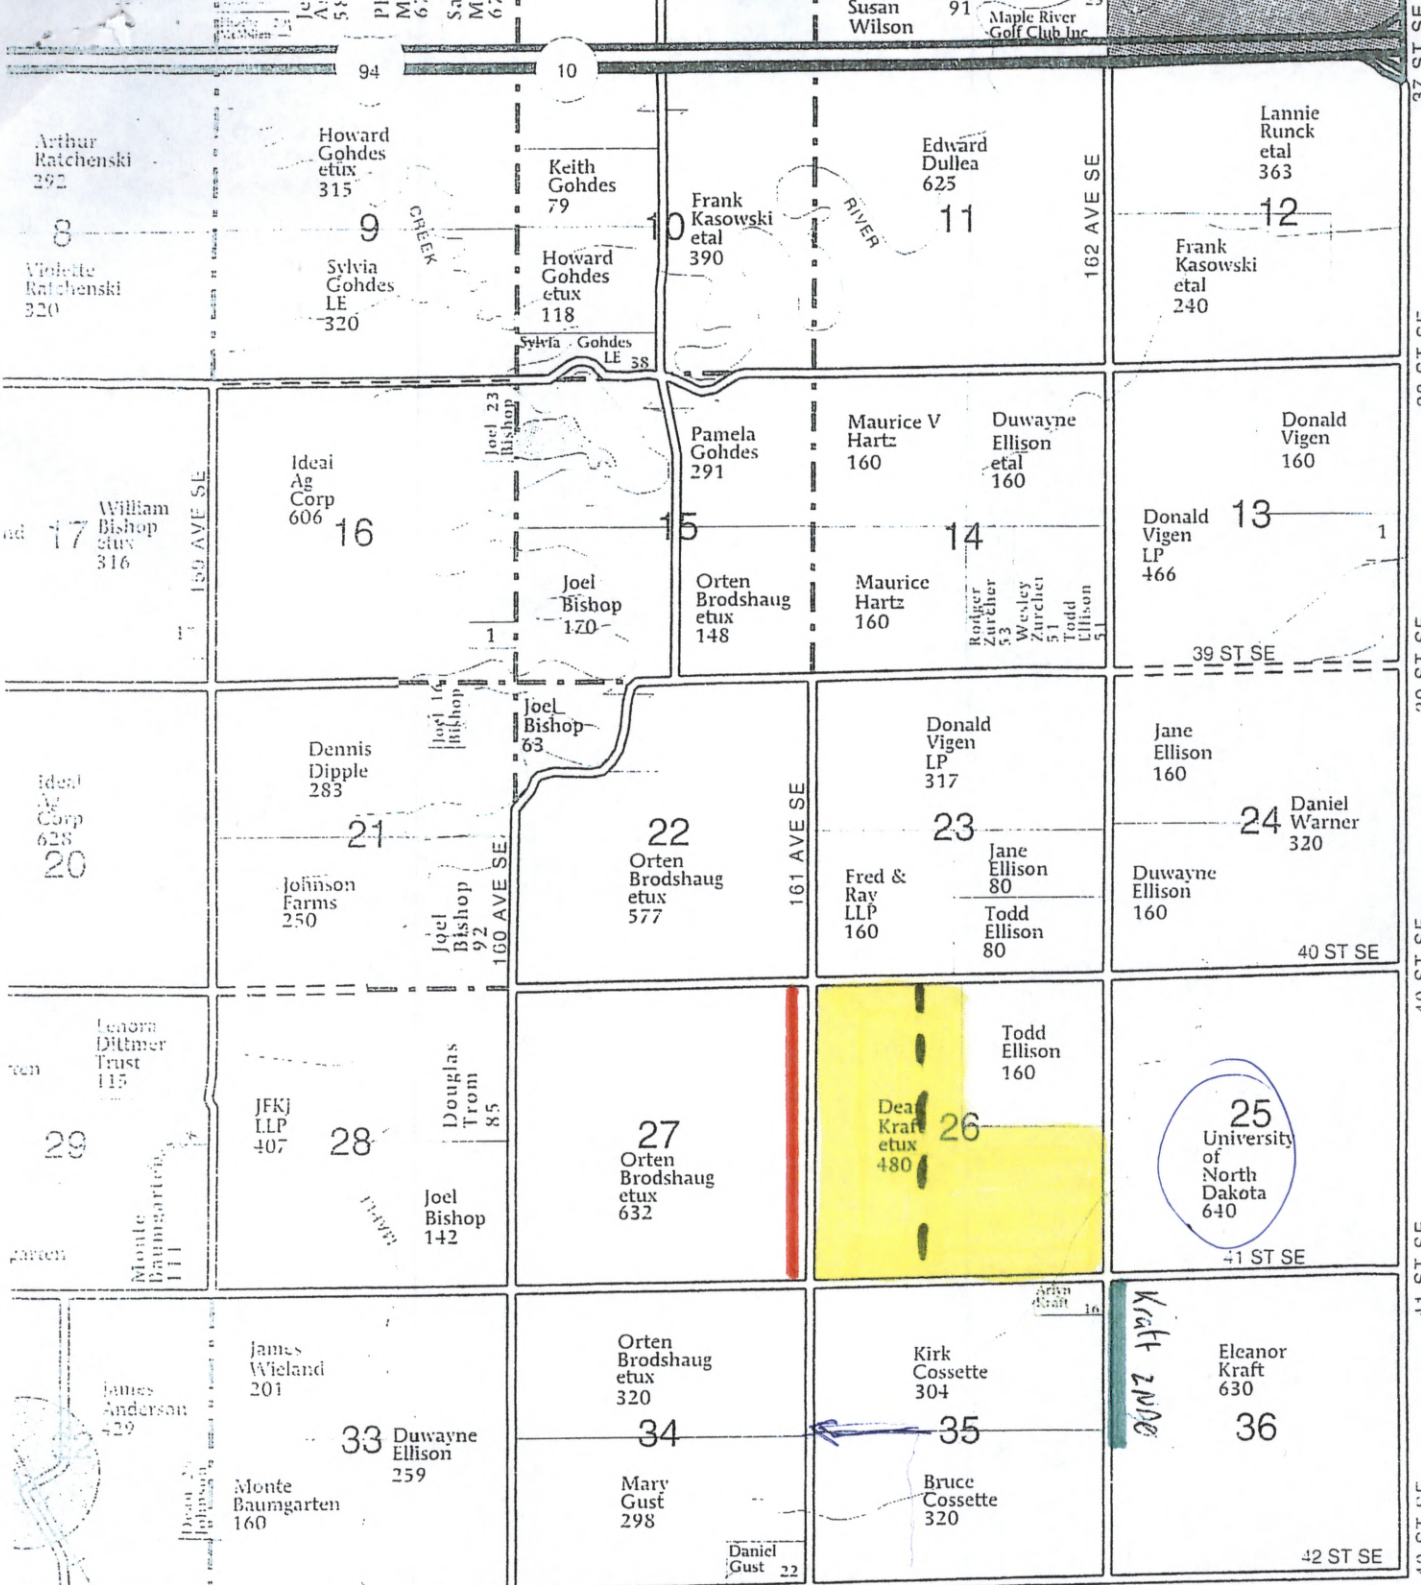

ADDISON TWP.

DN 16
shop, Joel 12
DN 17
shop, Joel 11
DN 30
Anderson, Jesse 12

- Preferred line placement
- Proposed line placement
- Runway

