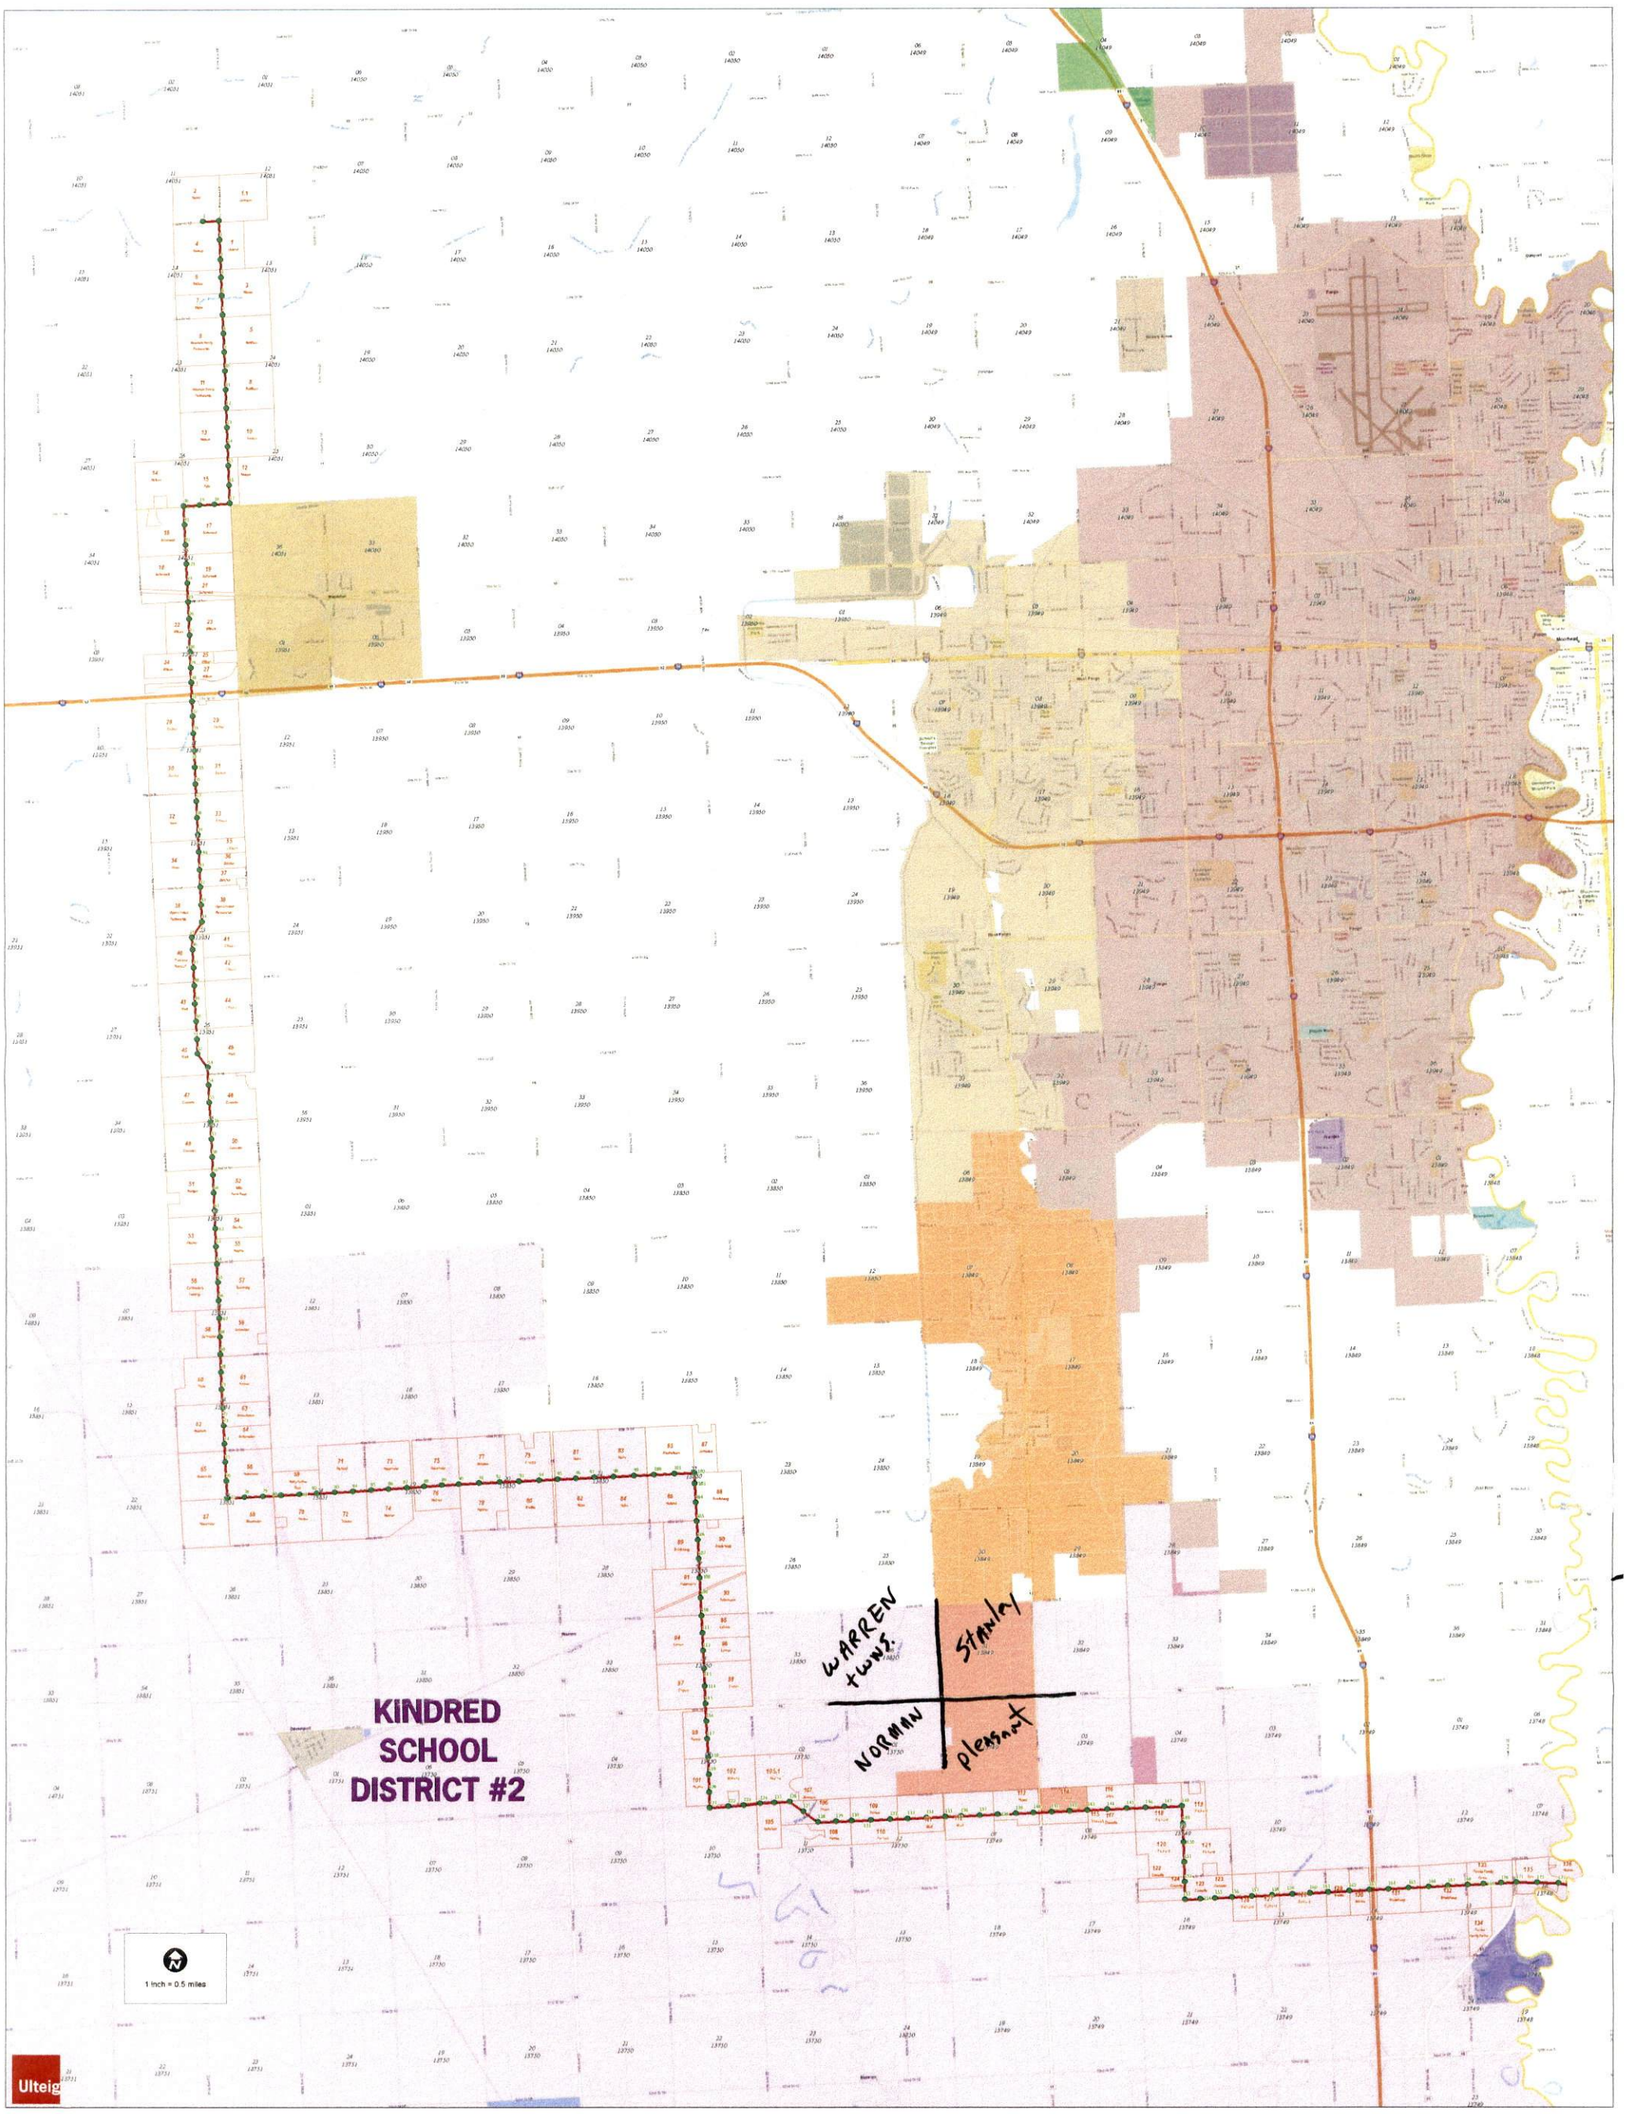

96 **PU-07-759** Filed: 1/30/2012 Pages: 3

Exhibits Reinke 1, 2, and 3

Northern States Power Company

EXHIBIT
REINKE
1

Tile B-2

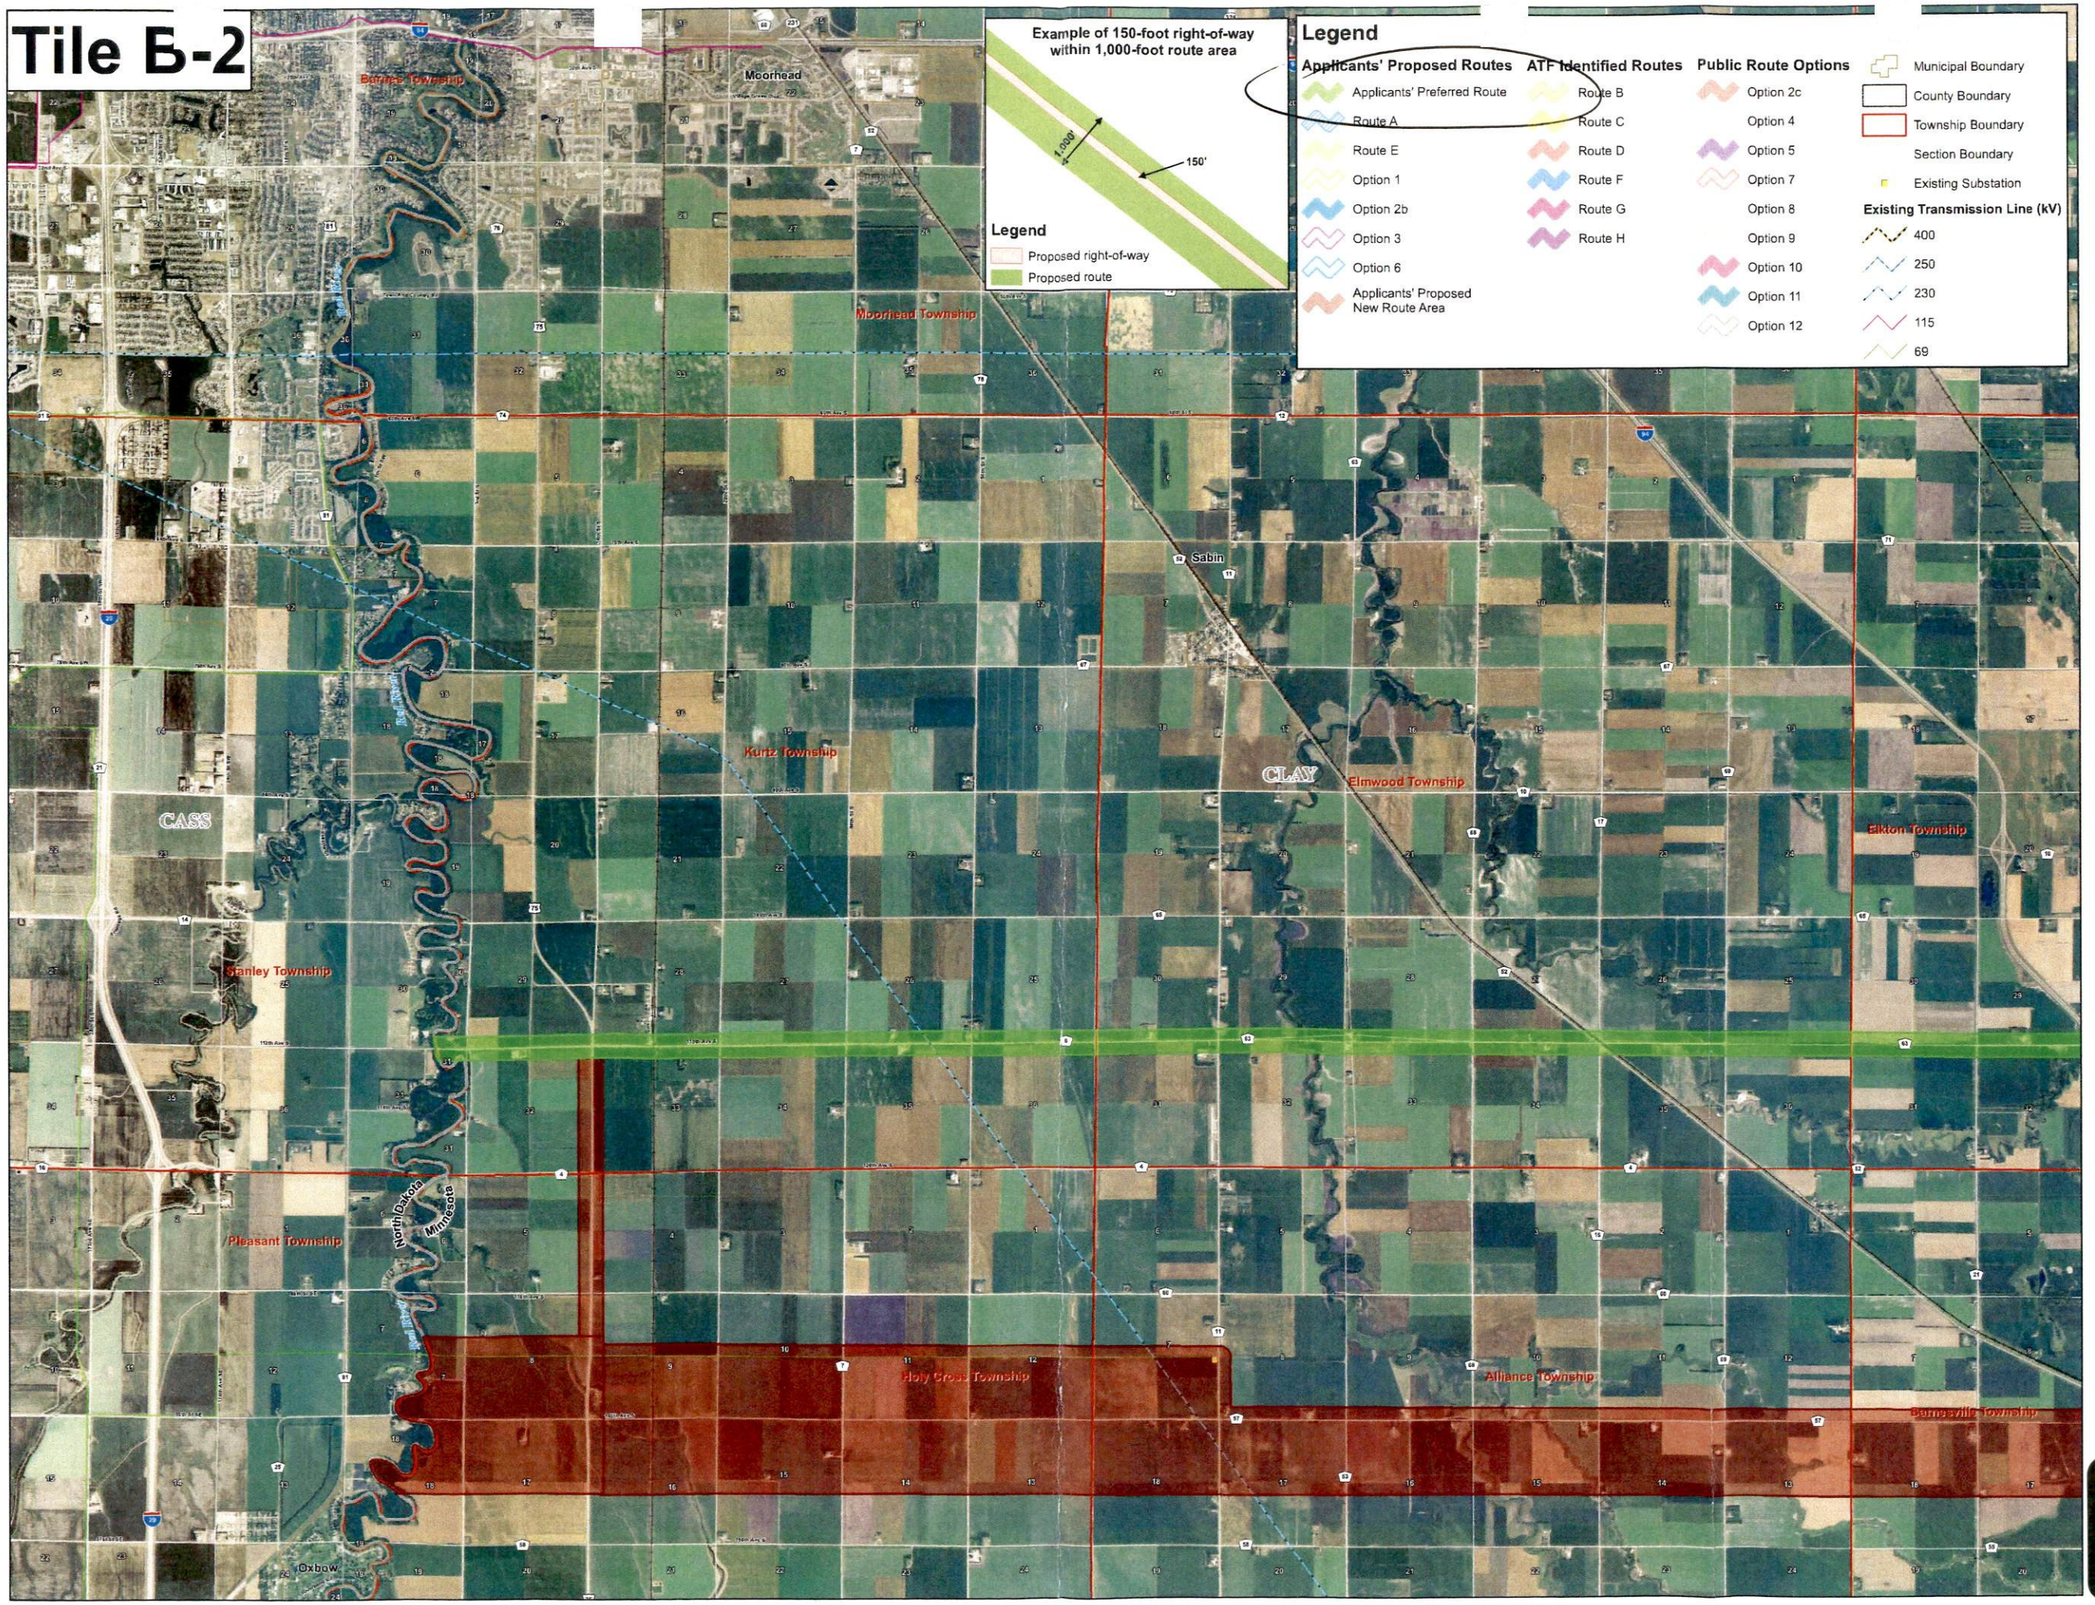

EXHIBIT
Reinke 2

Map 3

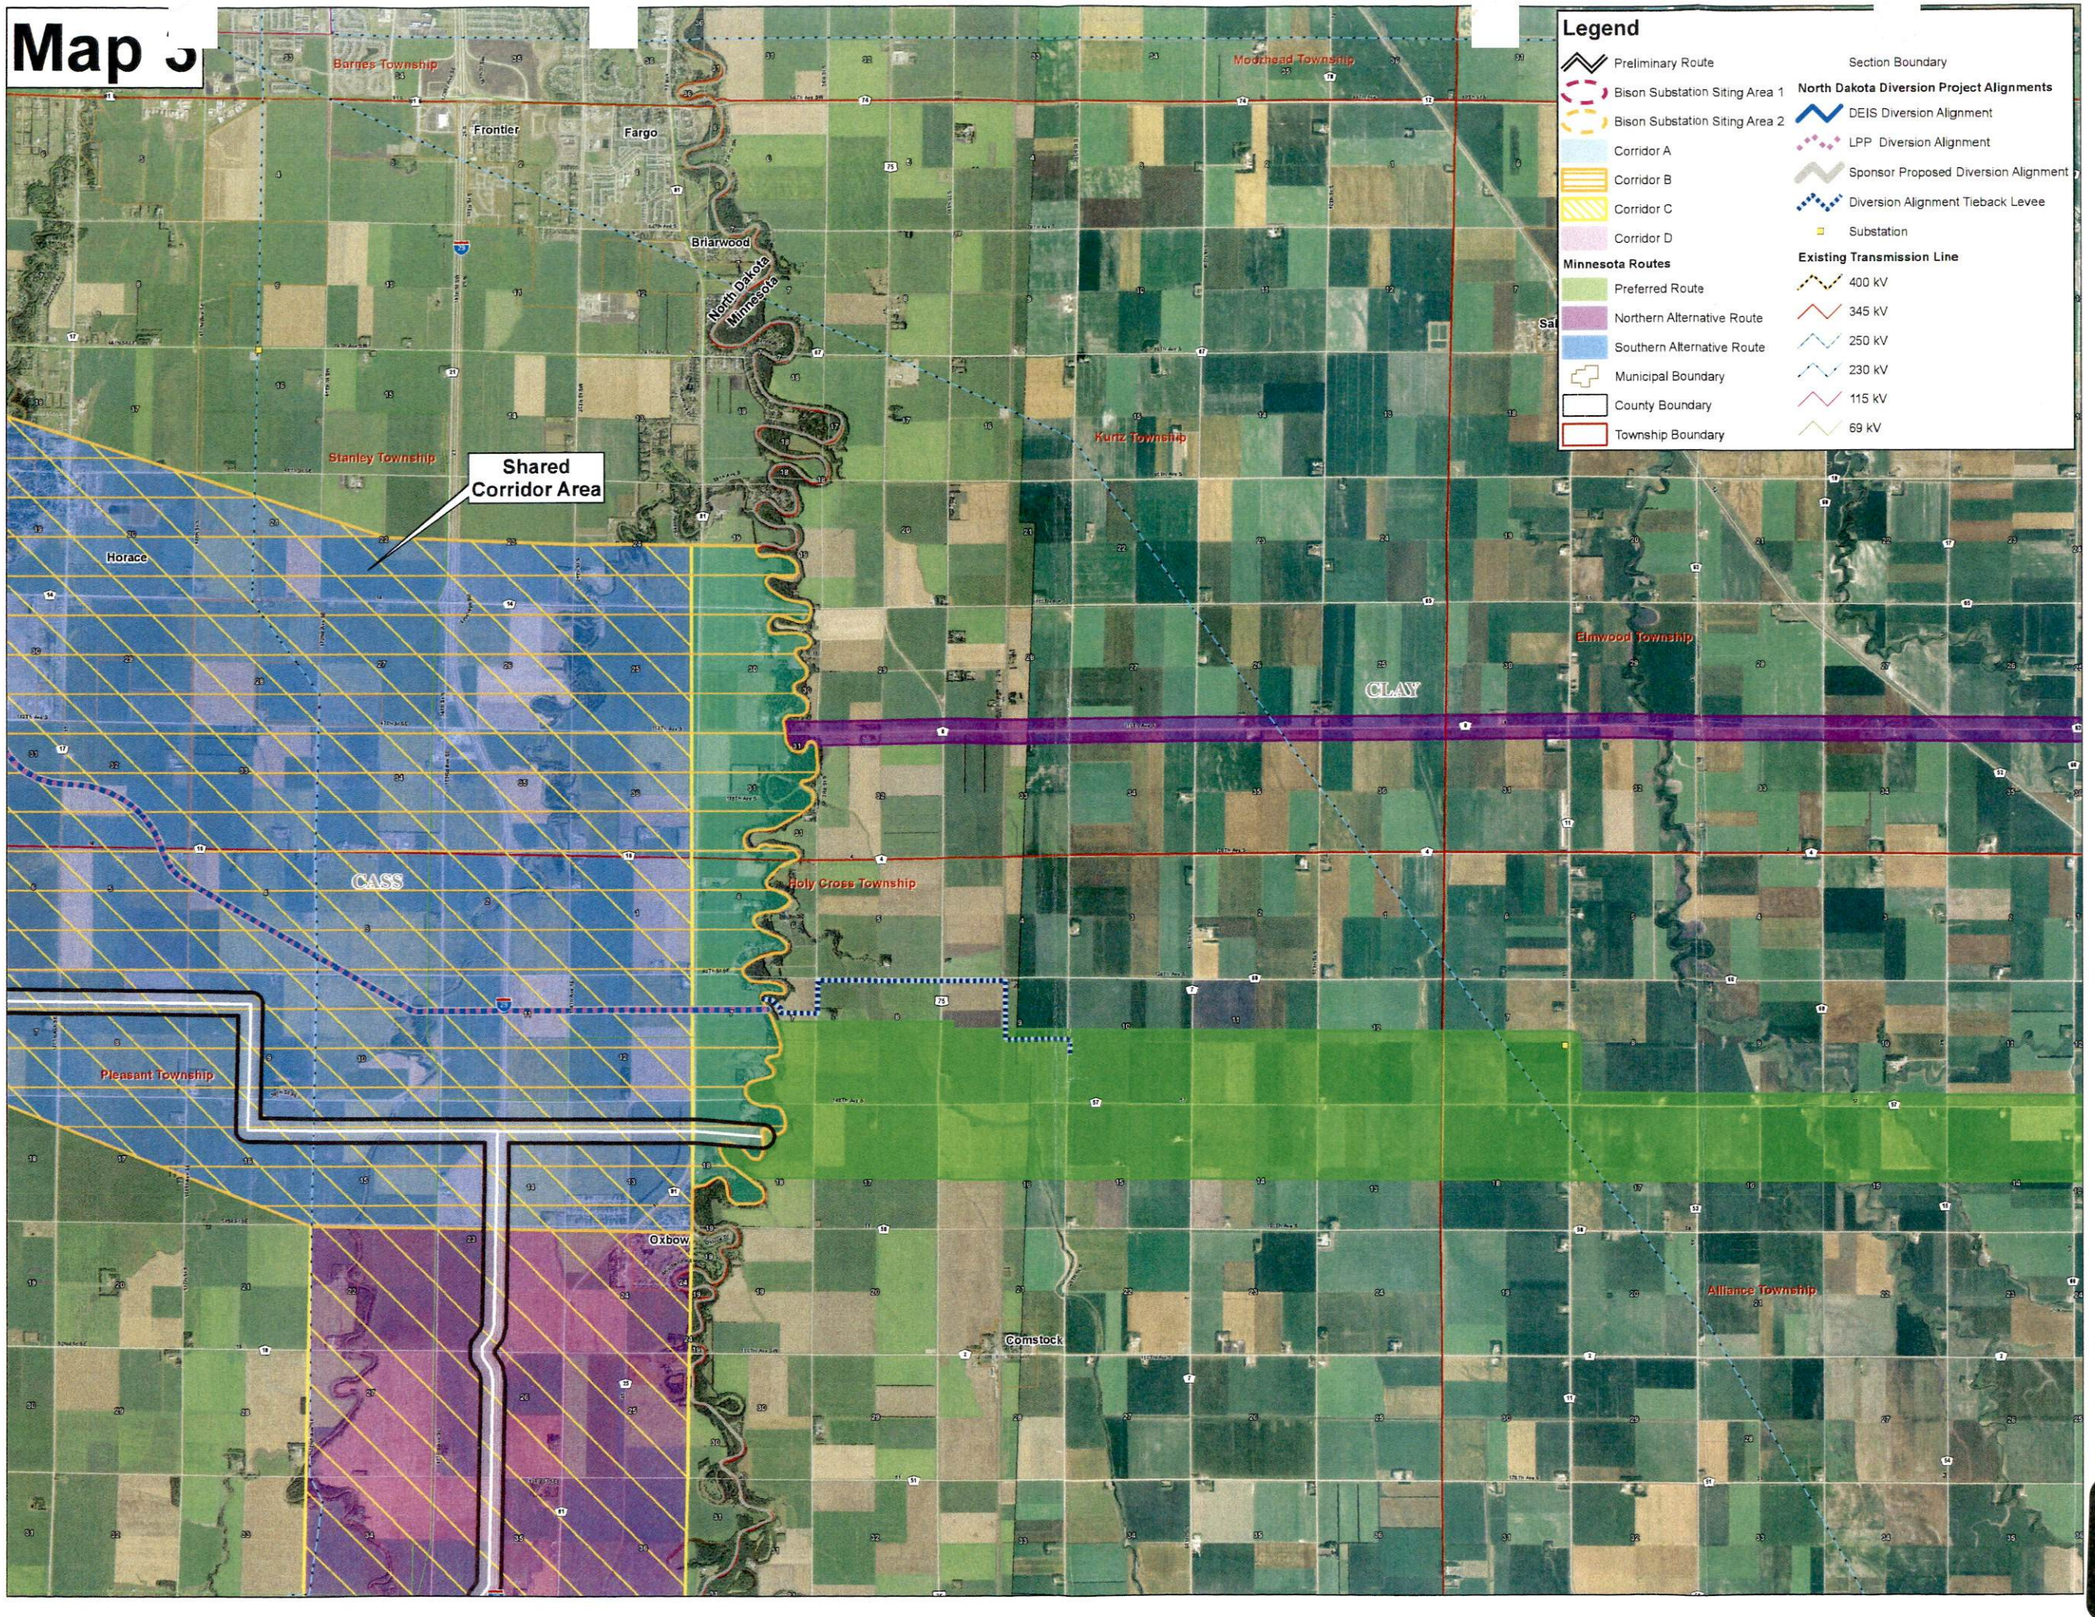

EXHIBIT
Rienke
3