


Luverne Wind Farm

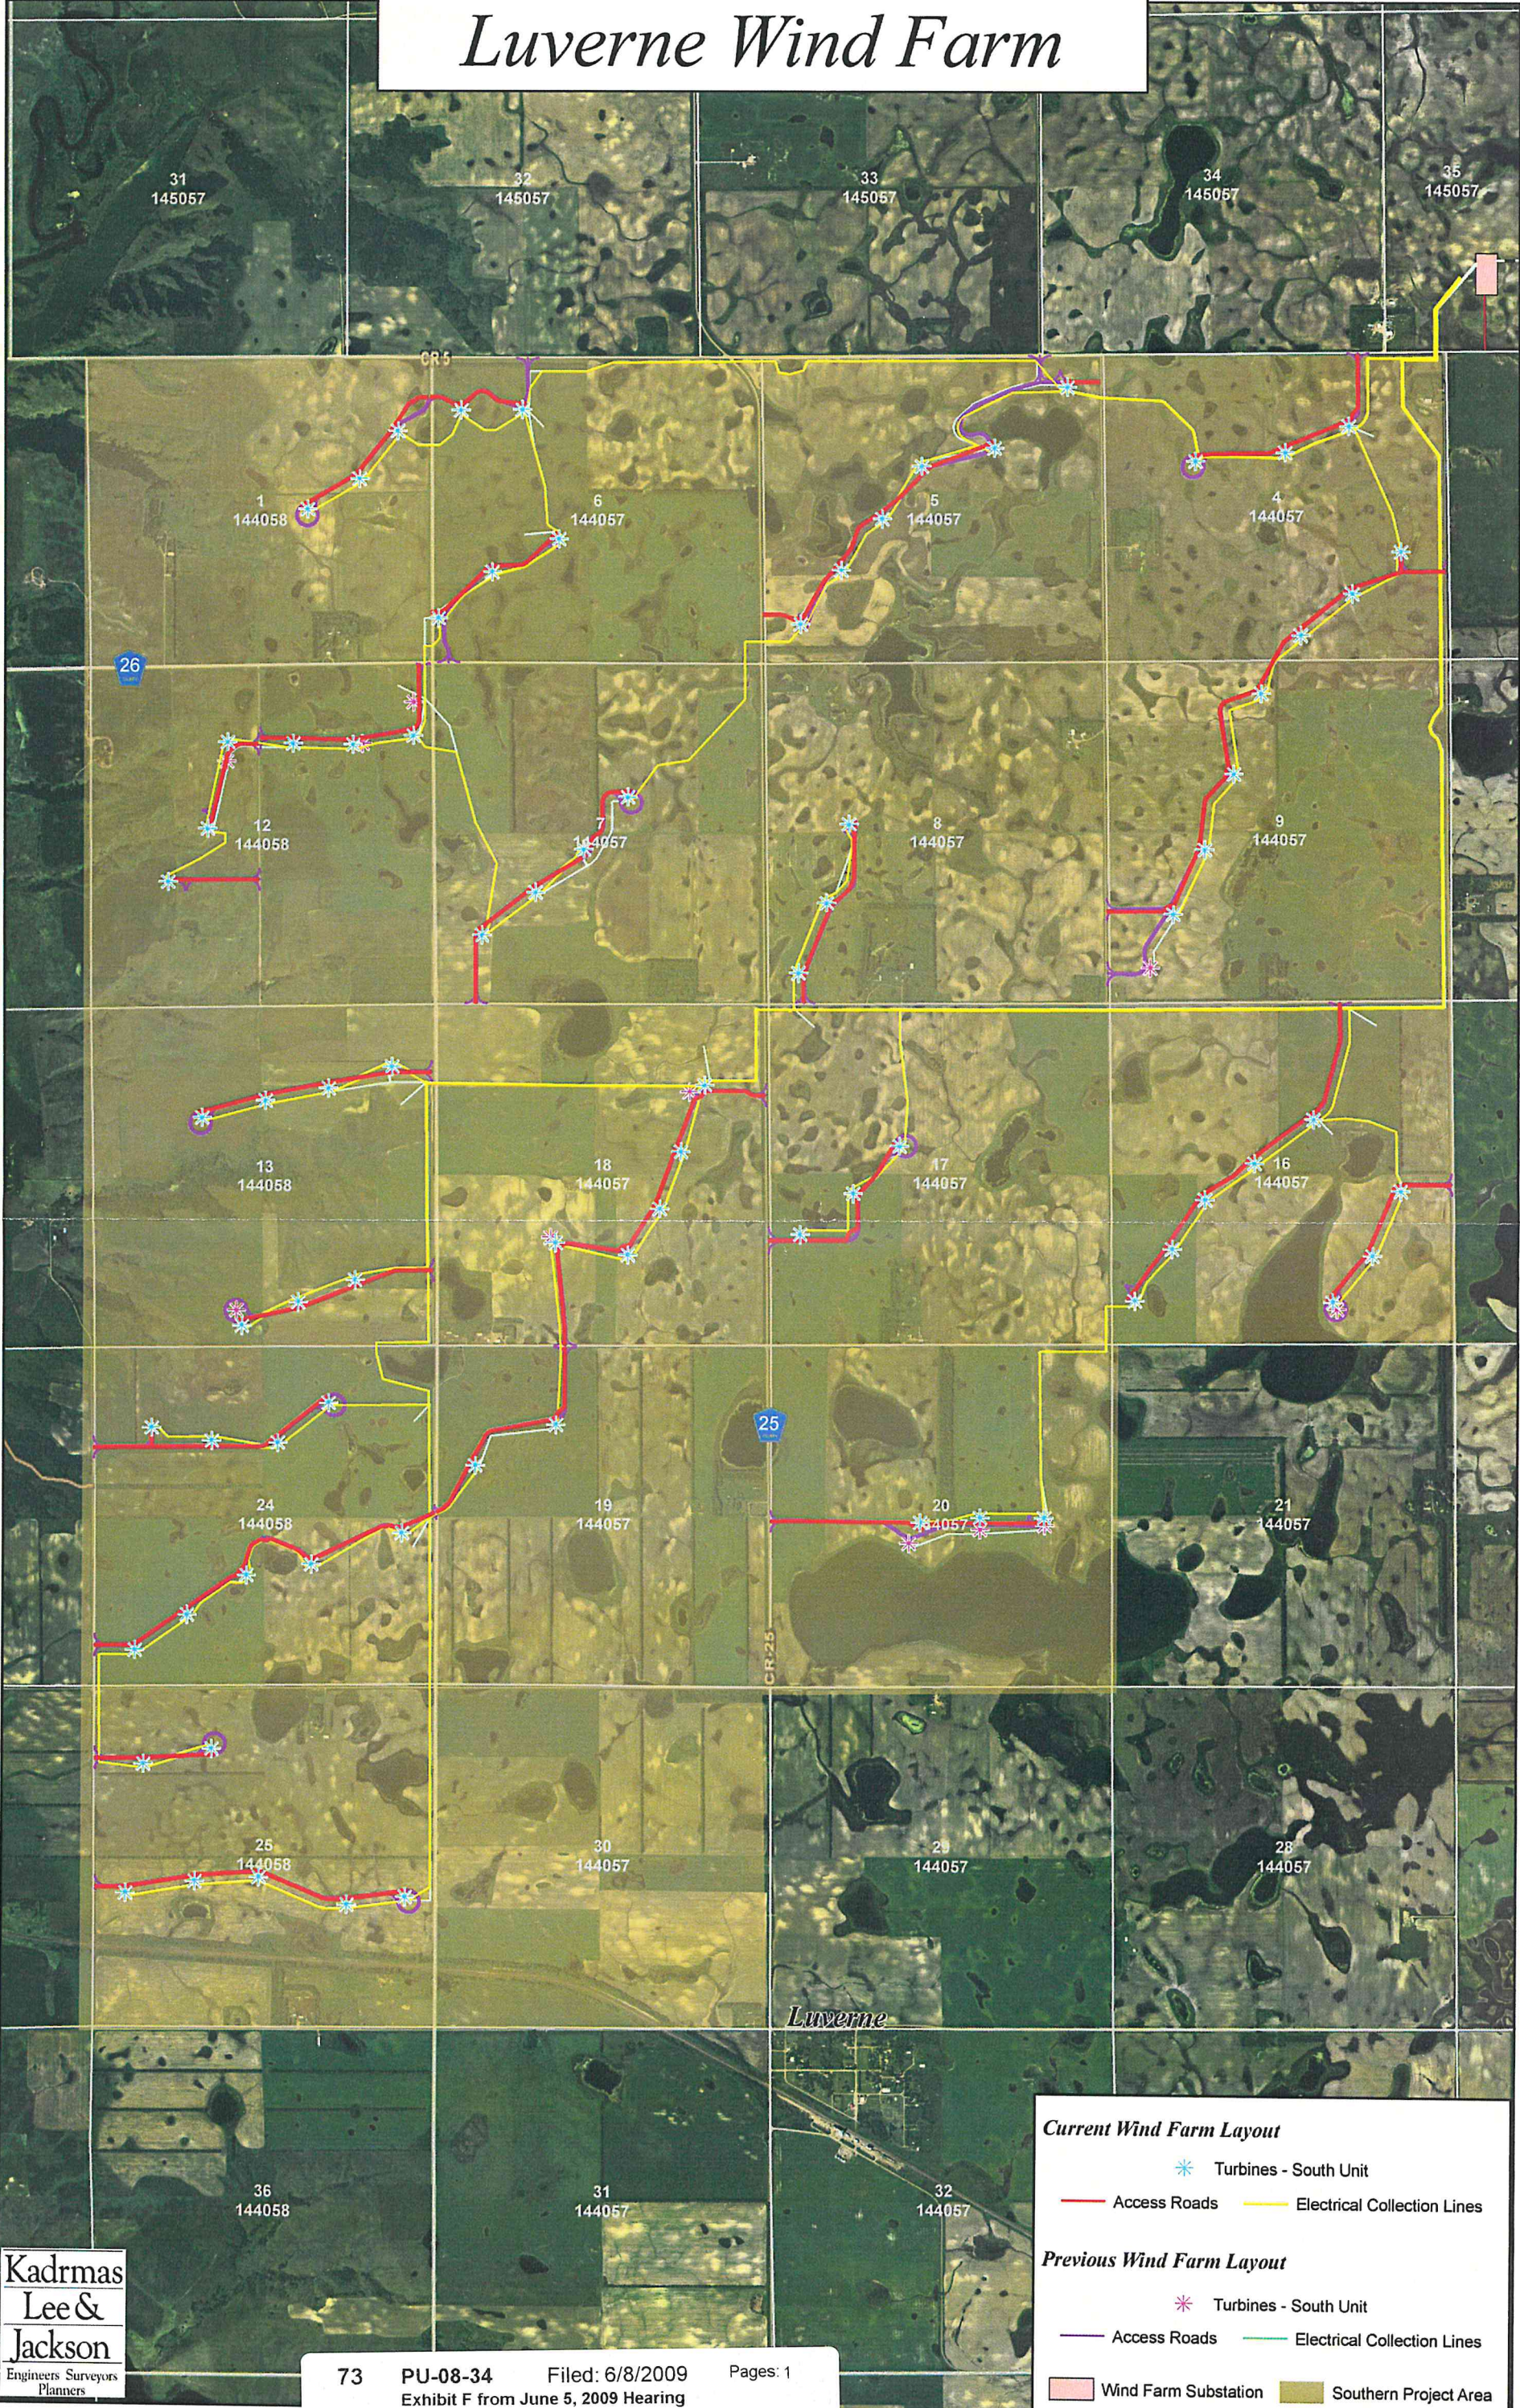

**Kadrmaz
Lee &
Jackson**
Engineers Surveyors
Planners