

Pillsbury-Fargo Generation Outlet

Minnkota Power
MPC COOPERATIVE, INC.

Your Touchstone Energy® Partner

GRIGGS COUNTY

STEELE COUNTY

TRAILL COUNTY

BARNES COUNTY

CASS COUNTY

NORTH DAKOTA
MINNESOTA

Proposed Pillsbury Substation

Existing Maple River Substation


Legend

- Substation
- Route Change
- Route
- ▨ Corridor
- ▭ County Boundary

Prepared By:
HDR
May 2008

0 7 14 Miles

Barnes & Cass Counties
NORTH DAKOTA

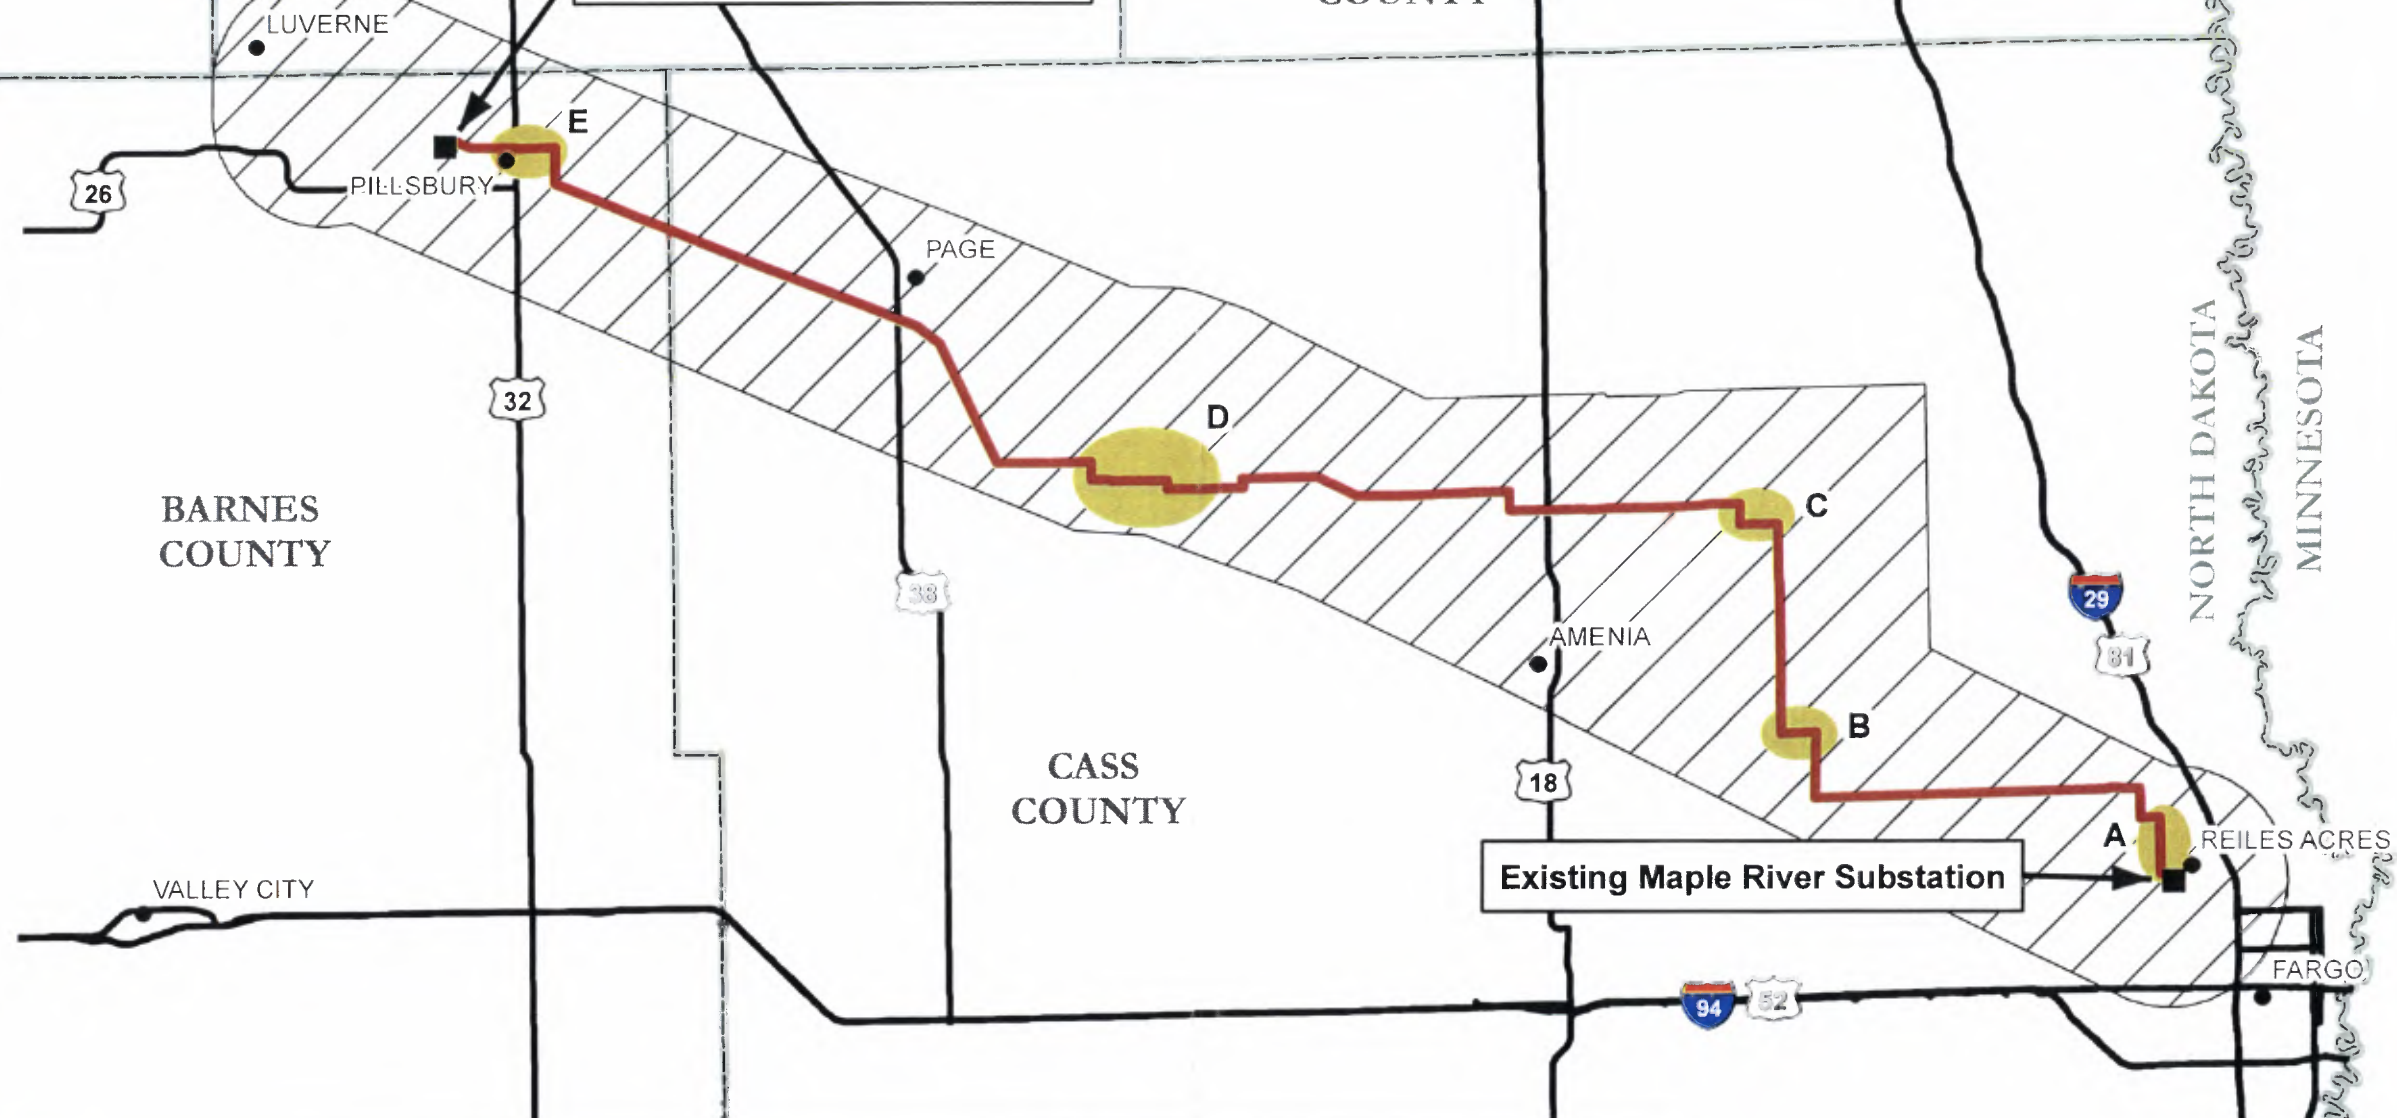


ORIGINAL

EXHIBIT
10

Pillsbury-Fargo Generation Outlet
Final Route Change - E

Minnkota Power
MPC COOPERATIVE, INC.

Your Touchstone Energy® Partner

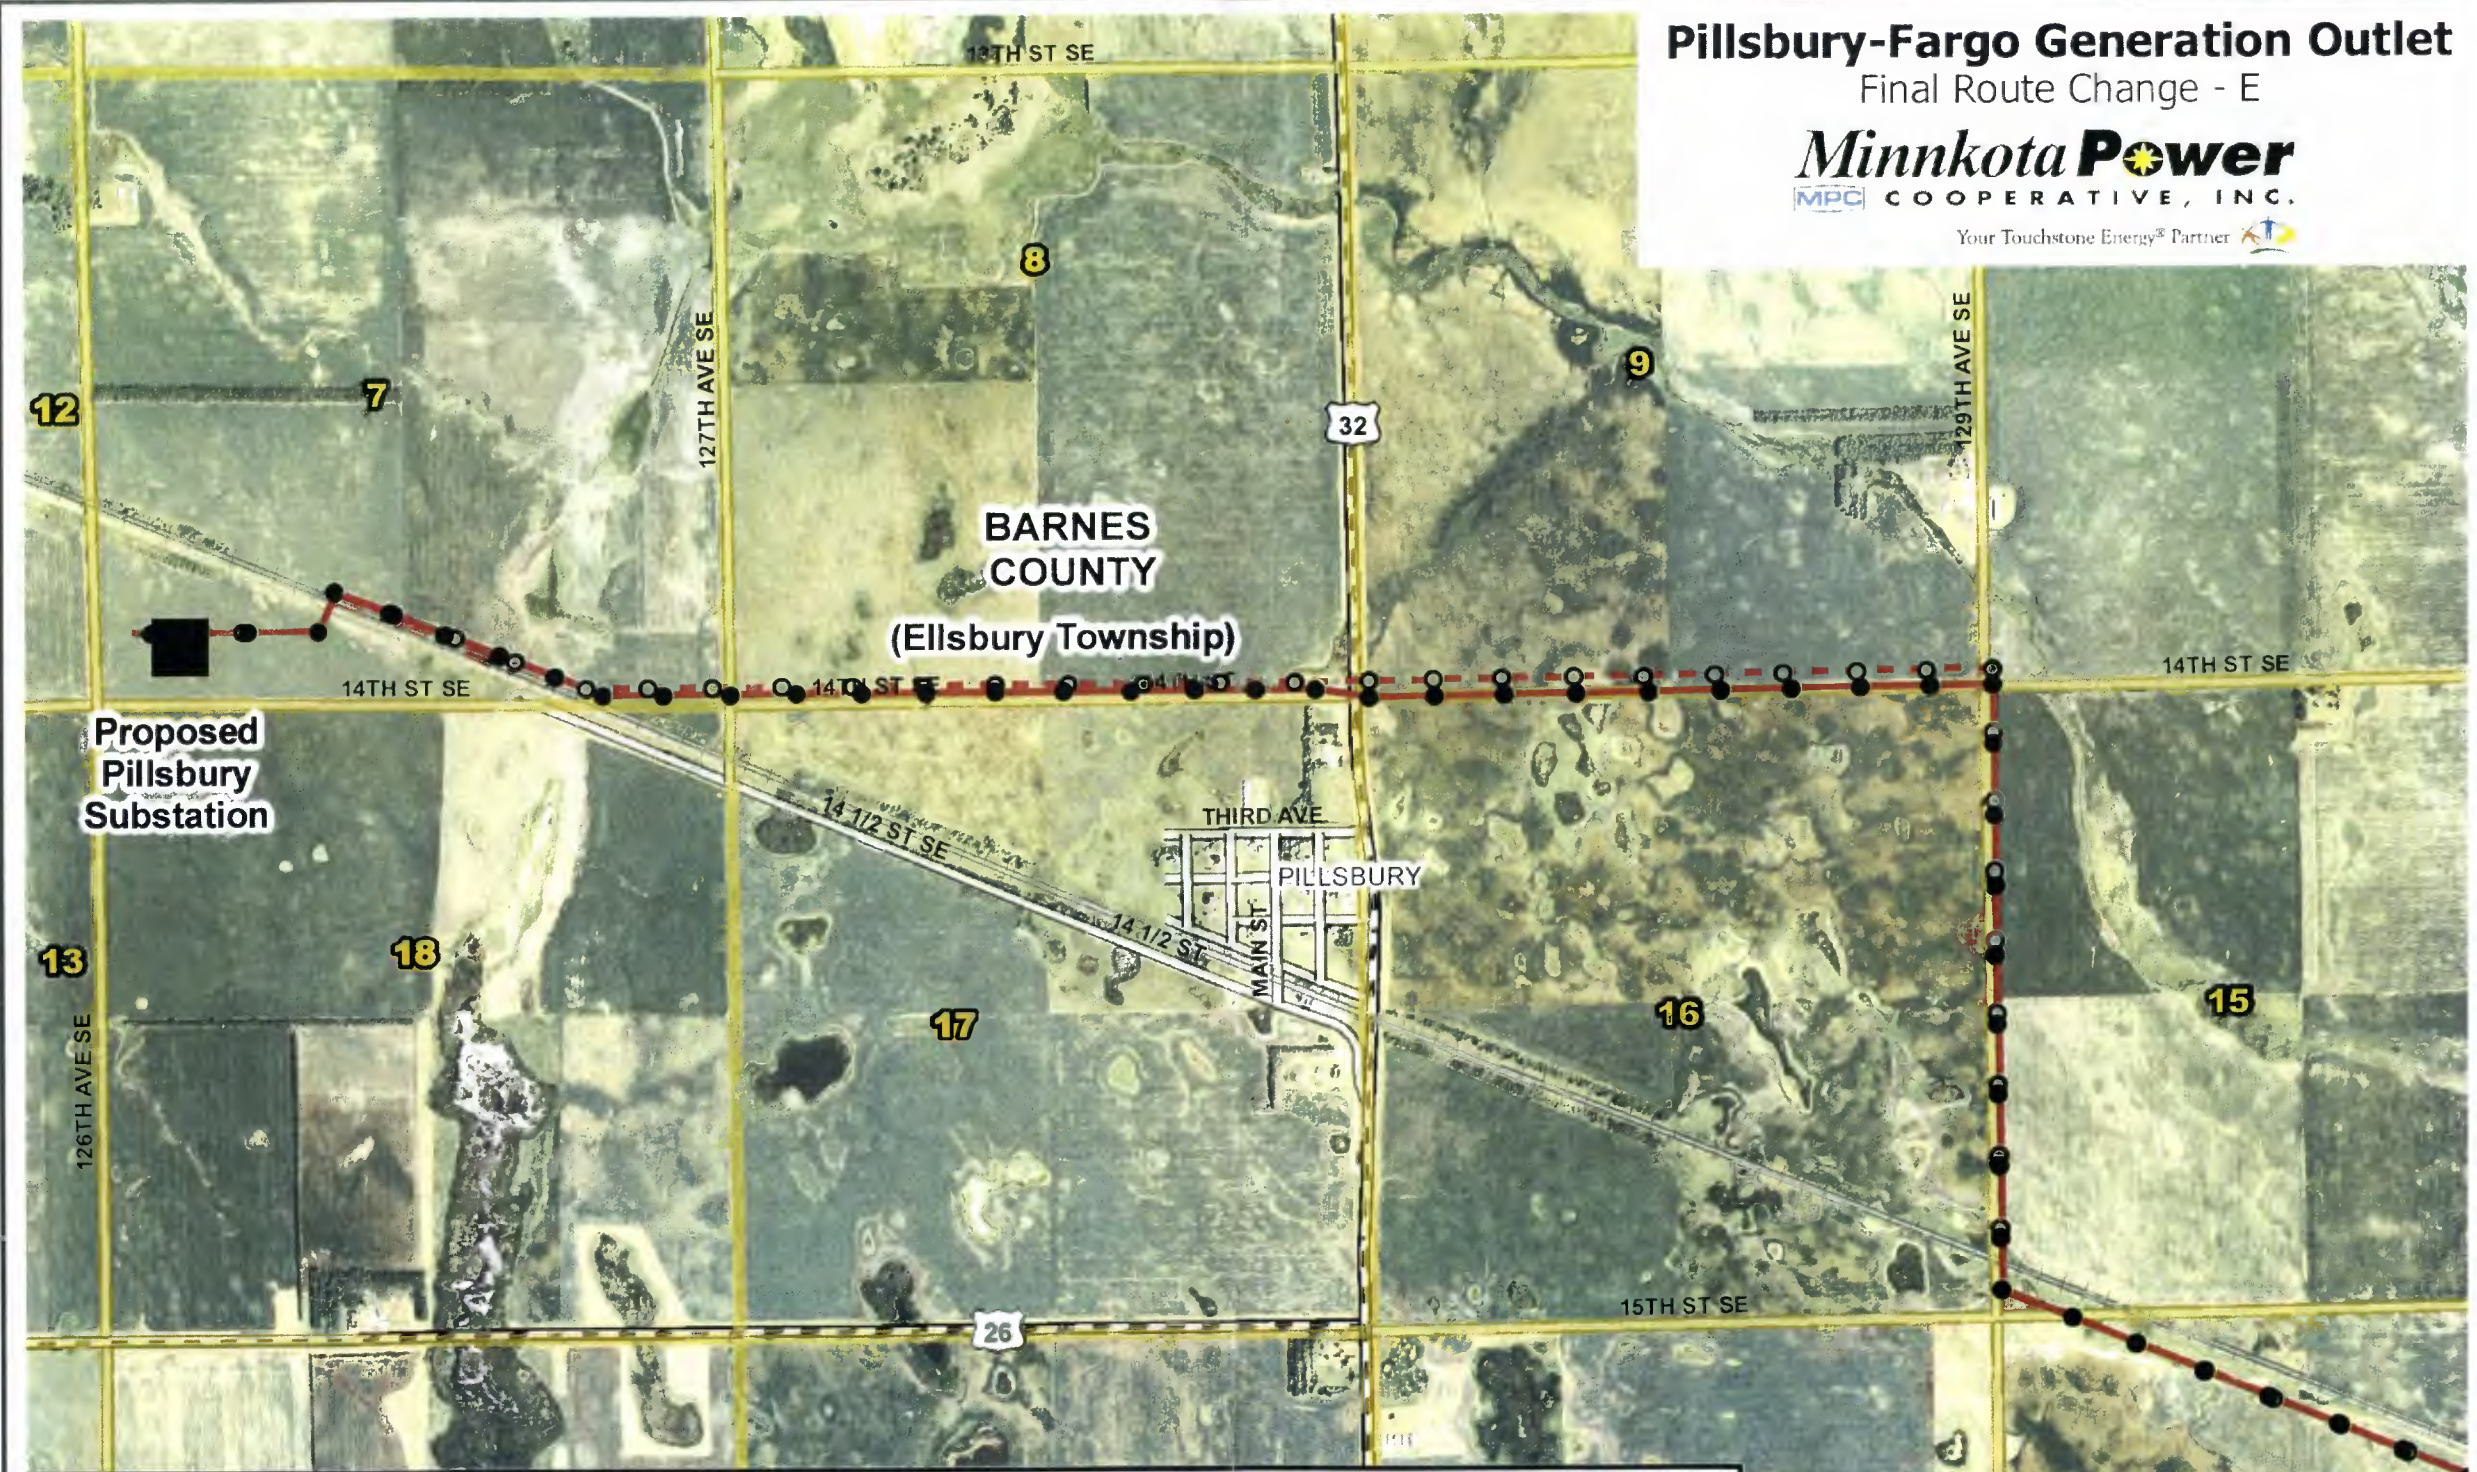

Legend


- Substation
- Line Structure Location (Dated 05/13/08)
- Line Structure Location (Dated 04/12/08)
- Section Boundaries
- Proposed Final Route (Dated 05/13/08)
- - - April Amended Route (Dated 04/12/08)

0 0.5 1 Miles

Prepared By:




May 2008

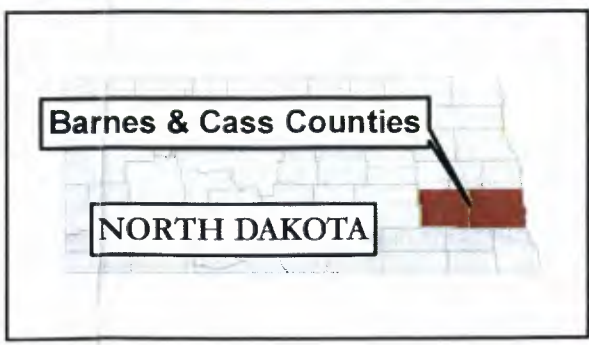

Pillsbury-Fargo Generation Outlet
Final Route Change - D

Minnkota Power
MPC COOPERATIVE, INC.

Your Touchstone Energy® Partner

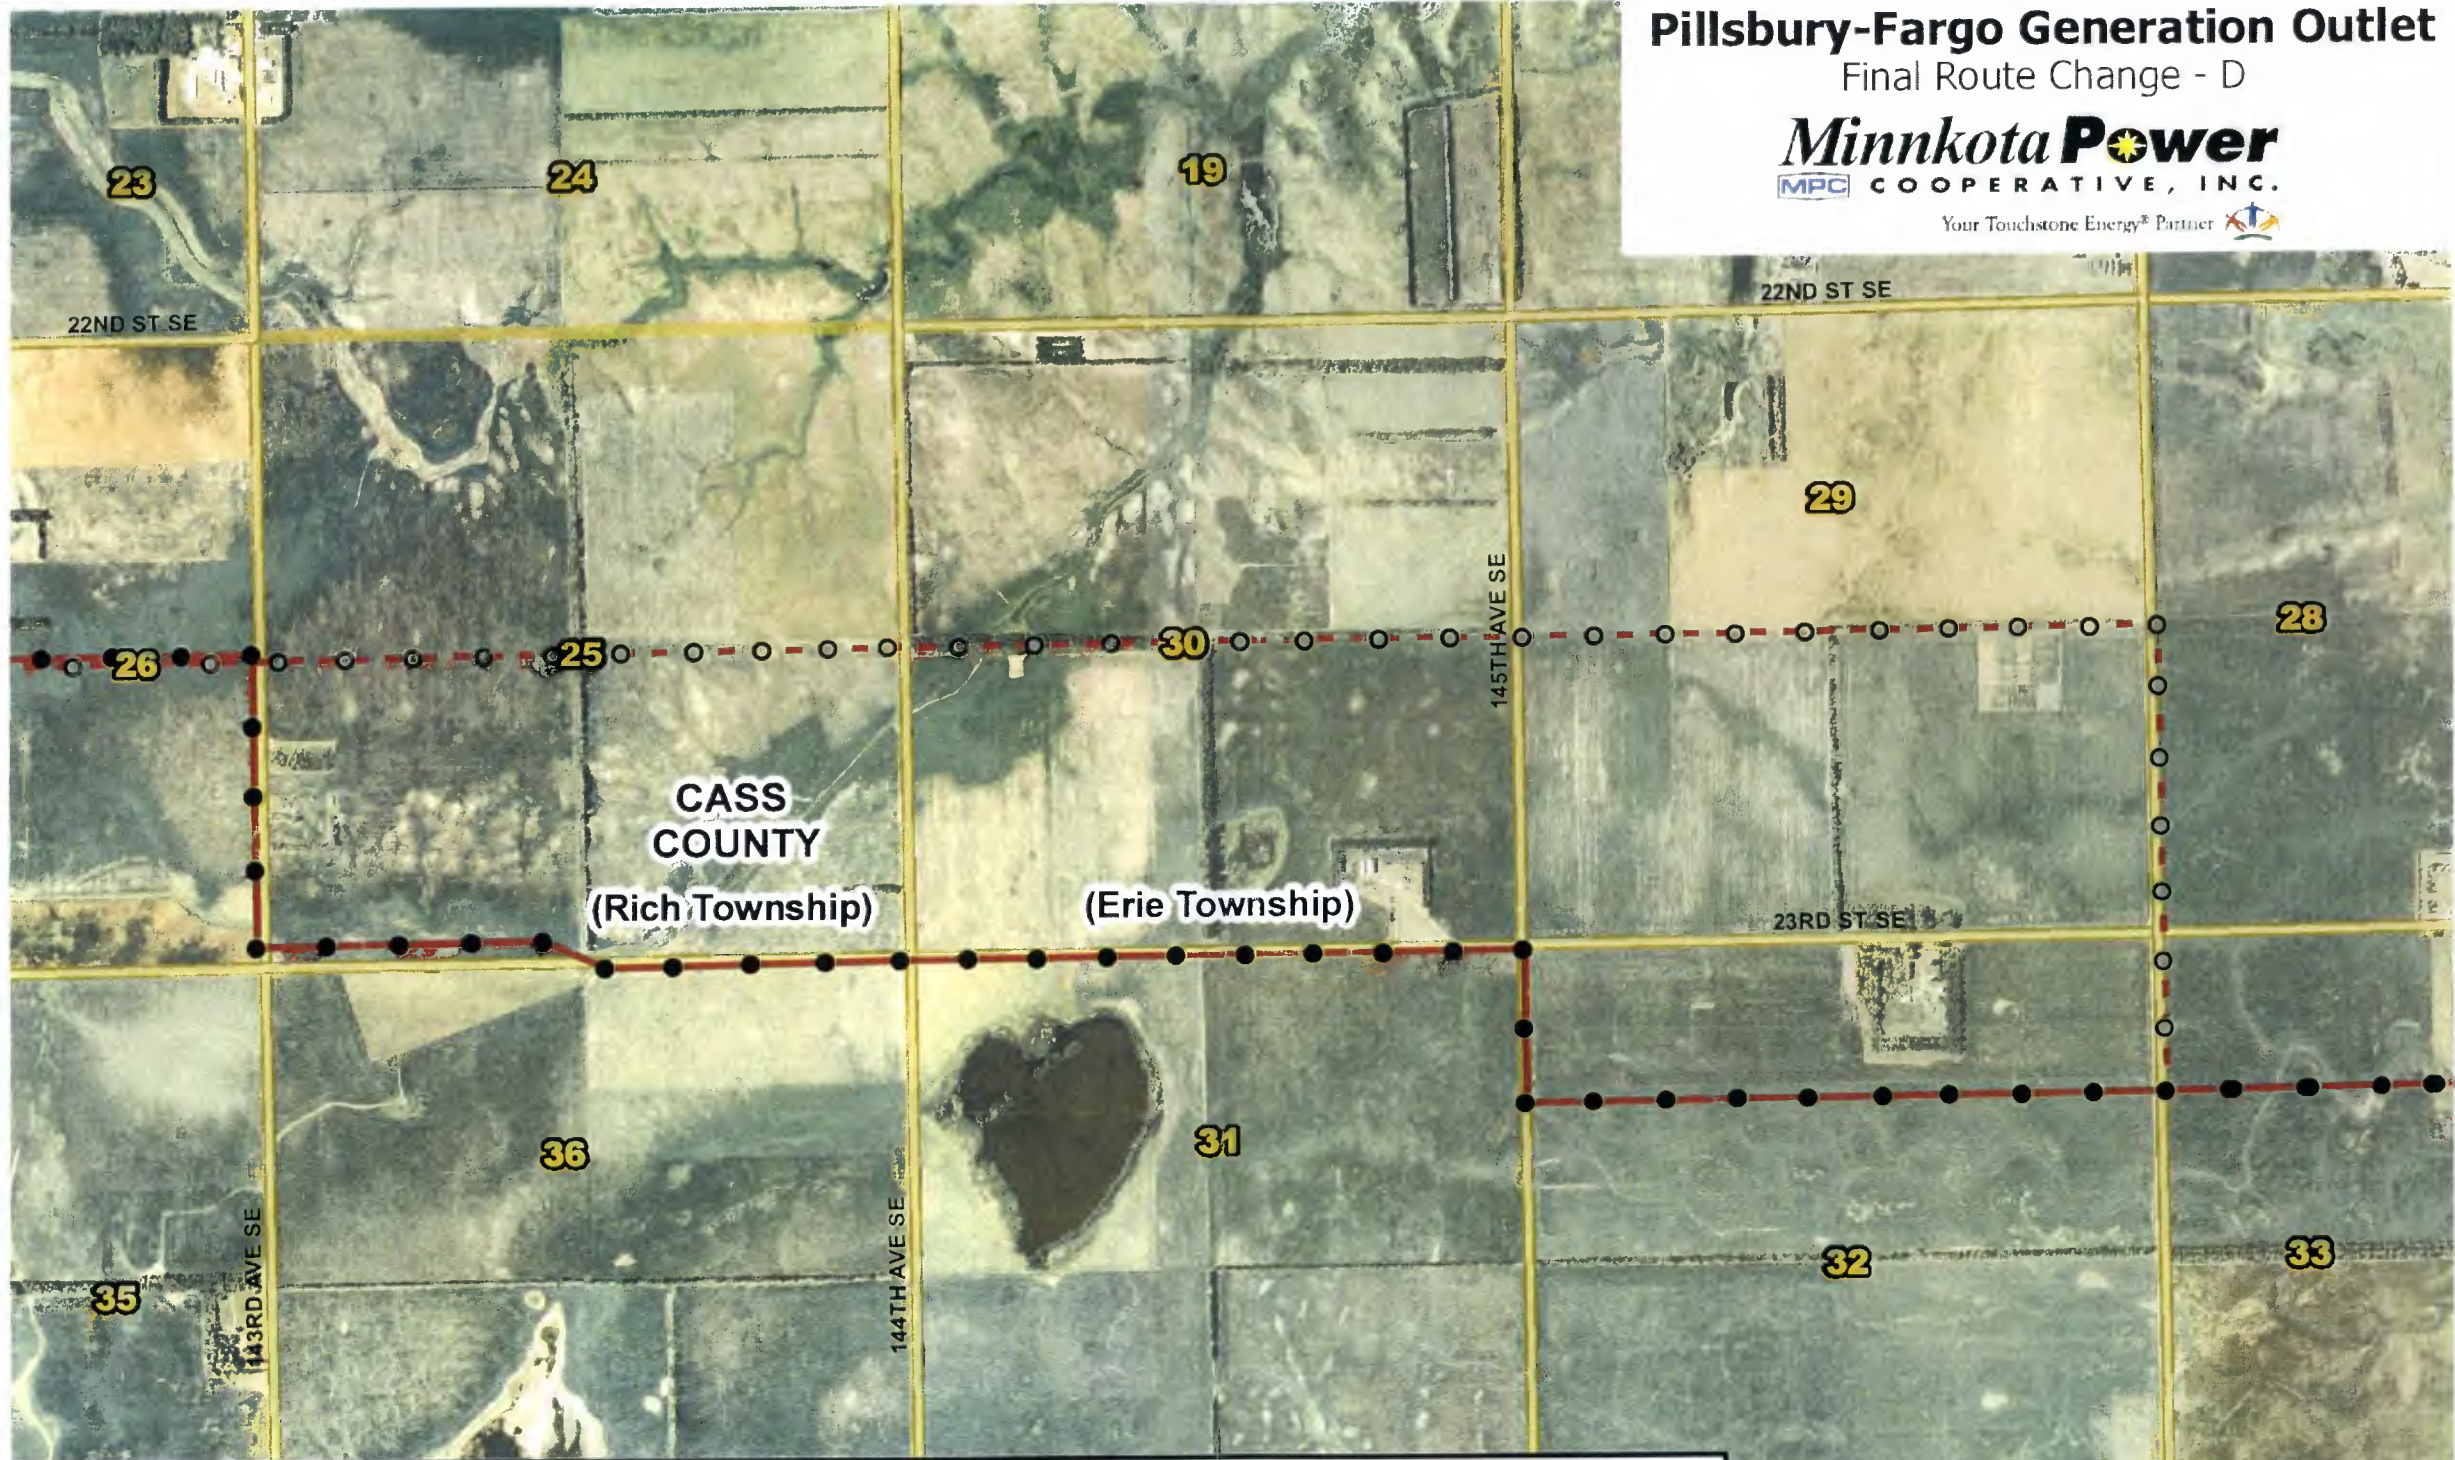

Legend


- Substation
- Line Structure Location (Dated 05/13/08)
- Line Structure Location (Dated 04/12/08)
- Section Boundaries
- Proposed Final Route (Dated 05/13/08)
- - - April Amended Route (Dated 04/12/08)




Prepared By:



May 2008

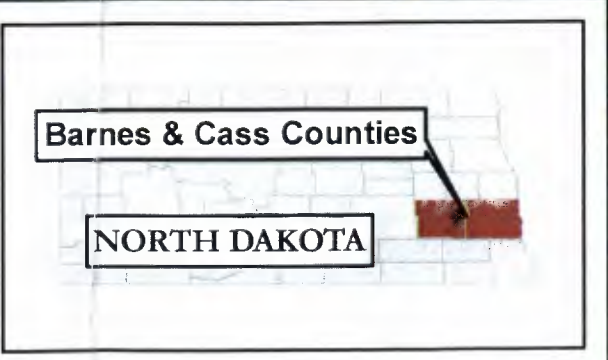


Pillsbury-Fargo Generation Outlet
Final Route Change - C

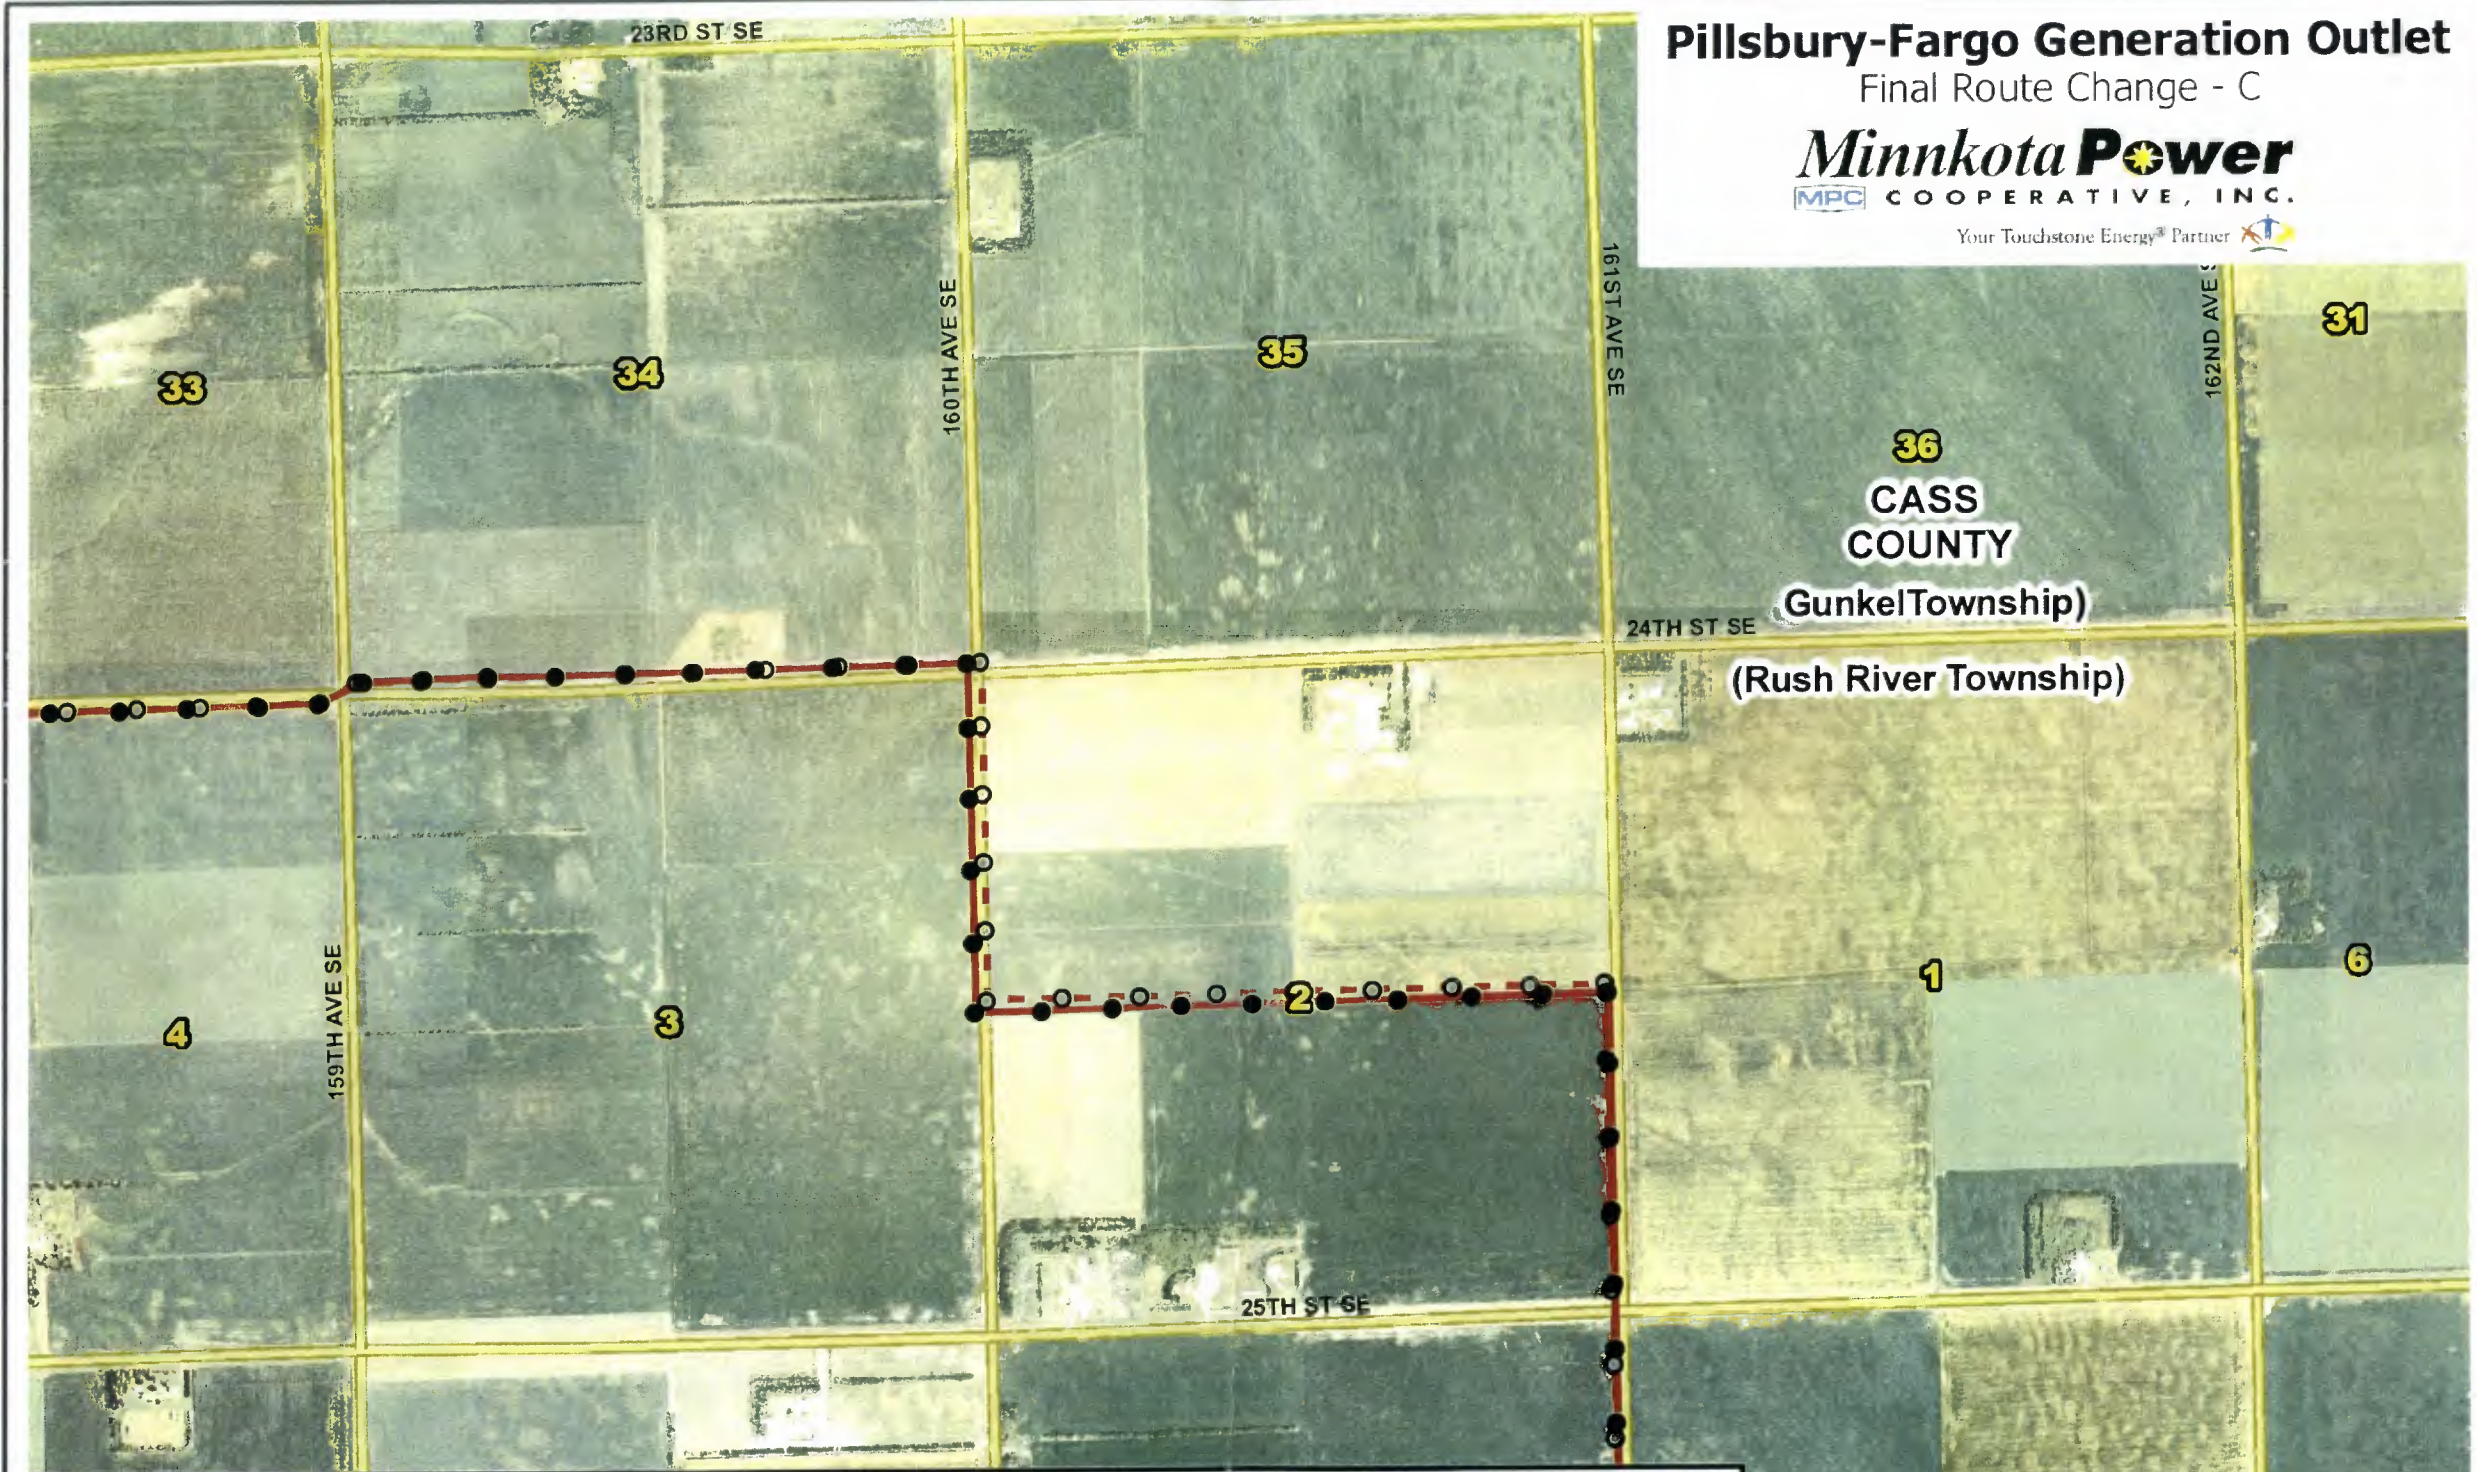


Legend


- Substation
- Line Structure Location (Dated 05/13/08)
- Line Structure Location (Dated 04/12/08)
- Section Boundaries
- Proposed Final Route (Dated 05/13/08)
- - - April Amended Route (Dated 04/12/08)

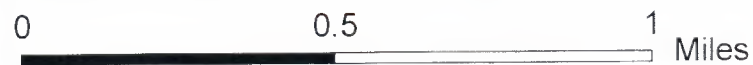

Prepared By:
HDR
May 2008

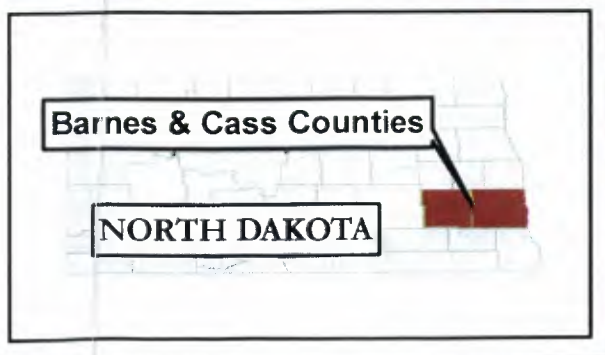


Pillsbury-Fargo Generation Outlet
Final Route Change - B

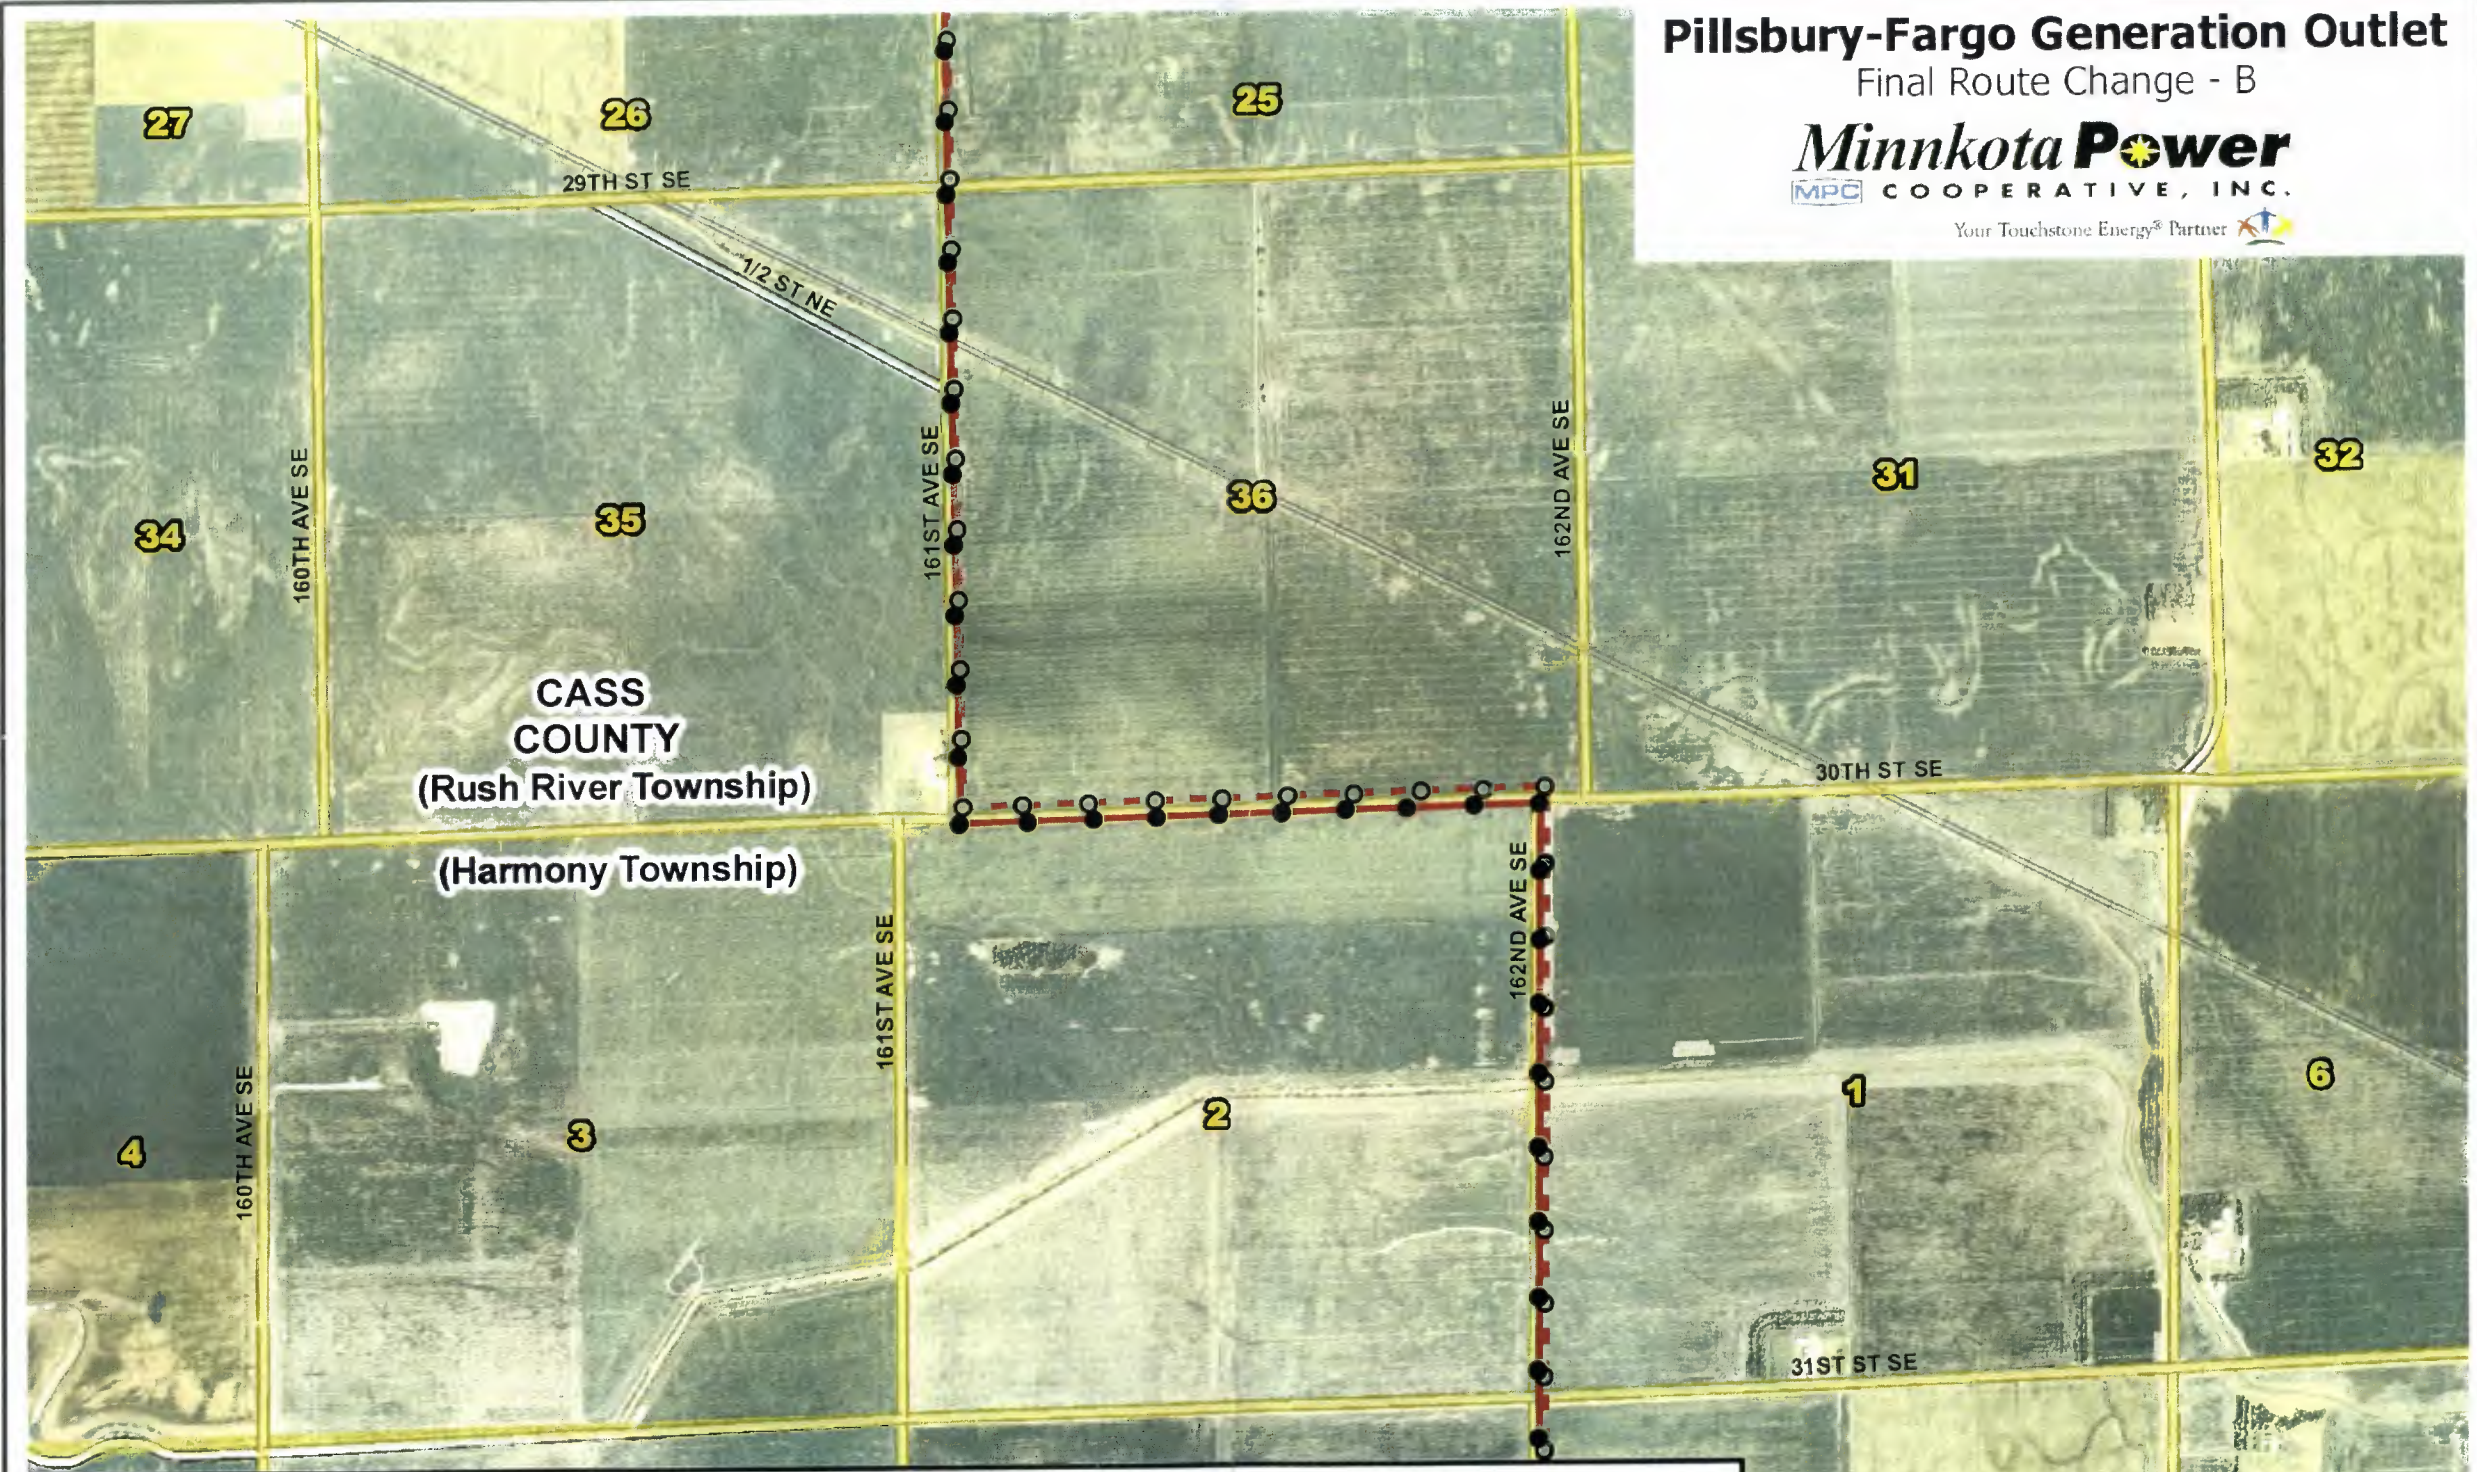

Legend

- Substation
 - Line Structure Location (Dated 05/13/08)
 - Line Structure Location (Dated 04/12/08)
 - Section Boundaries
 - Proposed Final Route (Dated 05/13/08)
 - - - April Amended Route (Dated 04/12/08)
- 0 0.5 1
Miles


Prepared By:
HDR
May 2008

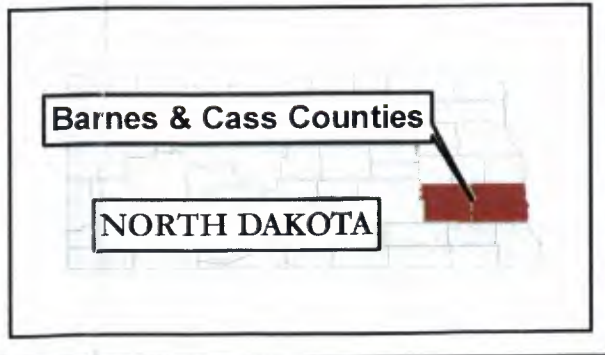

Pillsbury-Fargo Generation Outlet
Final Route Change - A


Minnkota Power
MPC COOPERATIVE, INC.

Your Touchstone Energy® Partner

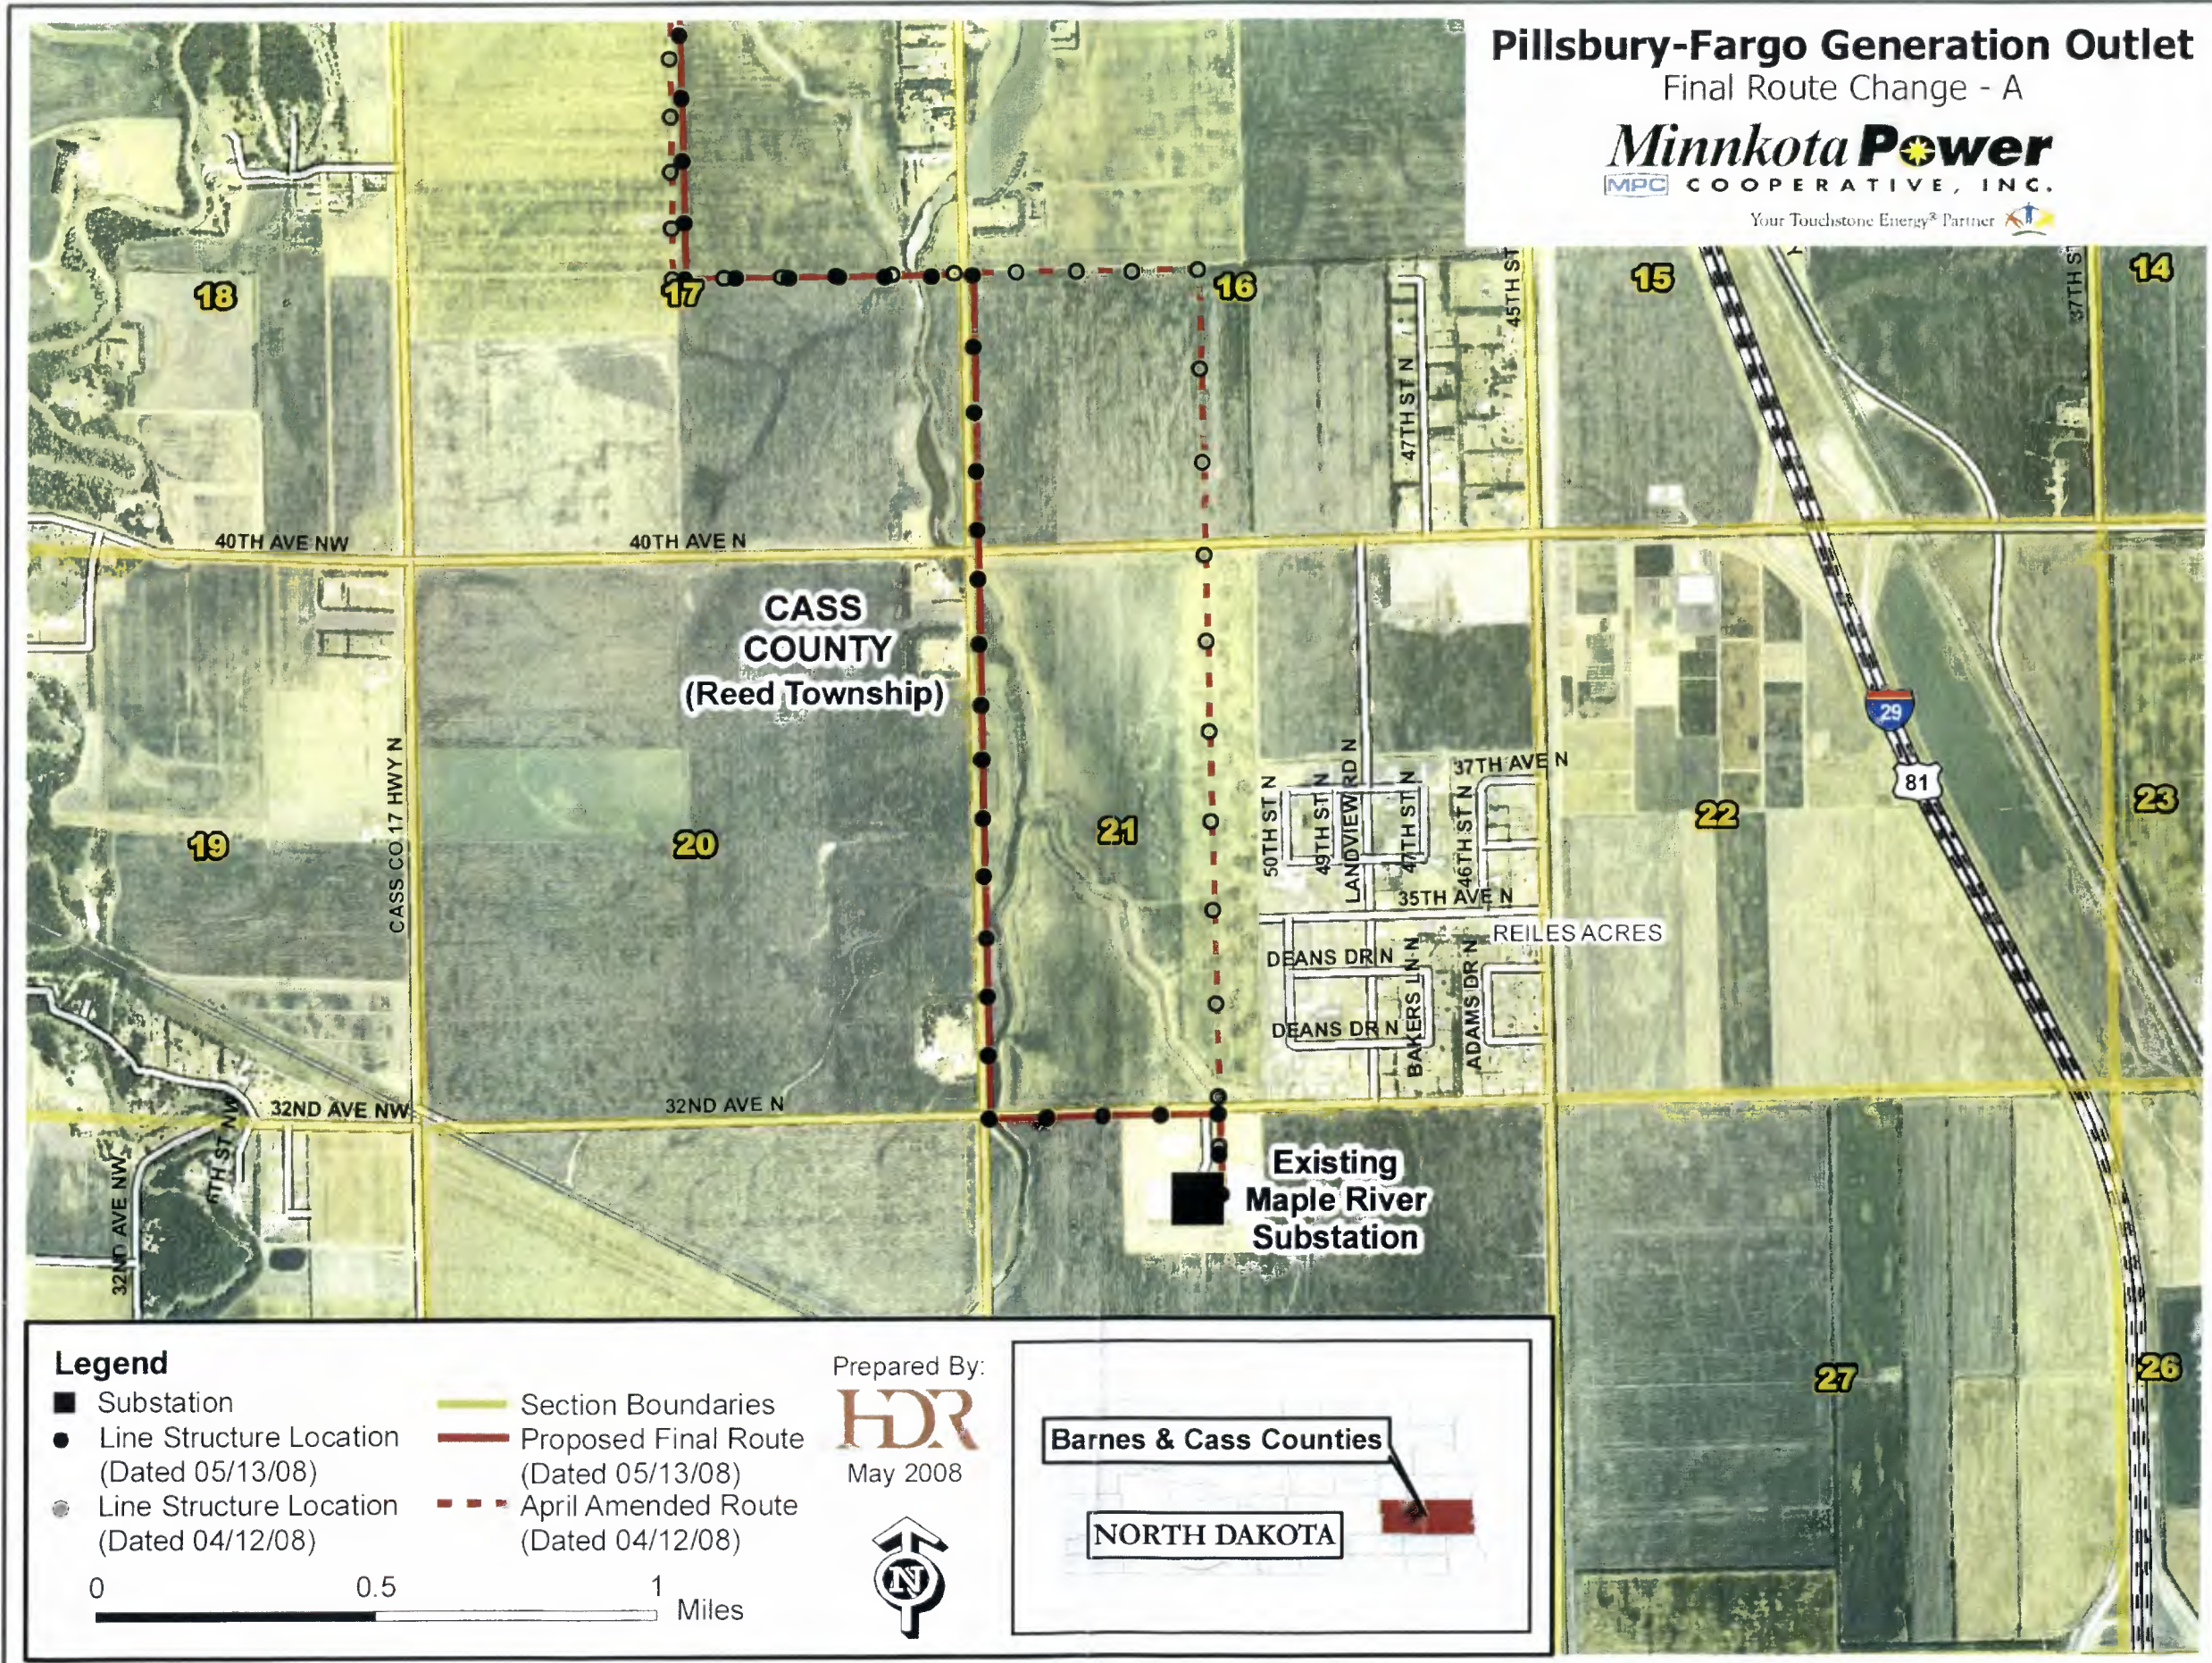

Legend

- Substation
- Line Structure Location (Dated 05/13/08)
- Line Structure Location (Dated 04/12/08)
- Section Boundaries
- Proposed Final Route (Dated 05/13/08)
- - - April Amended Route (Dated 04/12/08)

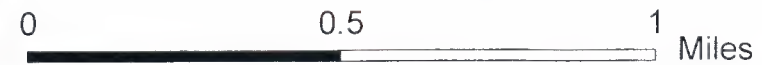

Prepared By:
HDR
May 2008

