




**TEMPORARY AUTHORITY PERMIT**  
**NORTH DAKOTA PUBLIC SERVICE COMMISSION**  
**PUBLIC UTILITIES**  
 SFN 50560 (6-96)

Date 04-09-08	Time 8:30 AM	<input checked="" type="checkbox"/> a.m. <input type="checkbox"/> p.m.	Name of Utility Otter Tail Power Company	Telephone Number 701-252-0540
Name of Person Calling Leon Kremer			Name of Coop Serving Cass County Electric	
Name of Customer Bob Satrom		Location Sec 25 Twp 141 R 54-W		
Address 2895 144th Ave SE			County Cass	
City Ayr		State ND	Zip Code 58007	
Name of Nearest City Absaraka			Distance to the City 3.5 miles	
When will service be extended? May 2008		Type of Service <input checked="" type="checkbox"/> Residence <input type="checkbox"/> Storage <input type="checkbox"/> Grain Bin <input type="checkbox"/> Other		
Extension Length to Most Economical Point of Service Utility: 150 feet Coop: 1 mile		Extension <input type="checkbox"/> Overhead <input checked="" type="checkbox"/> Underground		
Has customer signed request for service? <input checked="" type="checkbox"/> Yes <input type="checkbox"/> No		Will cooperative protest application? <input type="checkbox"/> Yes <input type="checkbox"/> No		
Name of Person Contacted (PSC Use)		Date of Contact (PSC Use)	Time (PSC Use) <input type="checkbox"/> a.m. <input type="checkbox"/> p.m.	
Estimated Cost of Extension \$2,500.00		Estimated Revenue \$2,400 per year		
Under what rate filed with the Public Service Commission will customer be served? 129/190 Residential/Dual Use				
Will extension cross over coop lines? <input type="checkbox"/> Yes <input checked="" type="checkbox"/> No		Will extension cross over railroad tracks? <input type="checkbox"/> Yes <input checked="" type="checkbox"/> No		
Temporary Authority Authorized By <input type="checkbox"/> Telephone <input type="checkbox"/> Letter		Date Authorized		
Authorized By (Name of Commissioner)				

Extension must be made from most economical point of service.

Comments:

Bob Satrom is currently an Otter Tail Customer

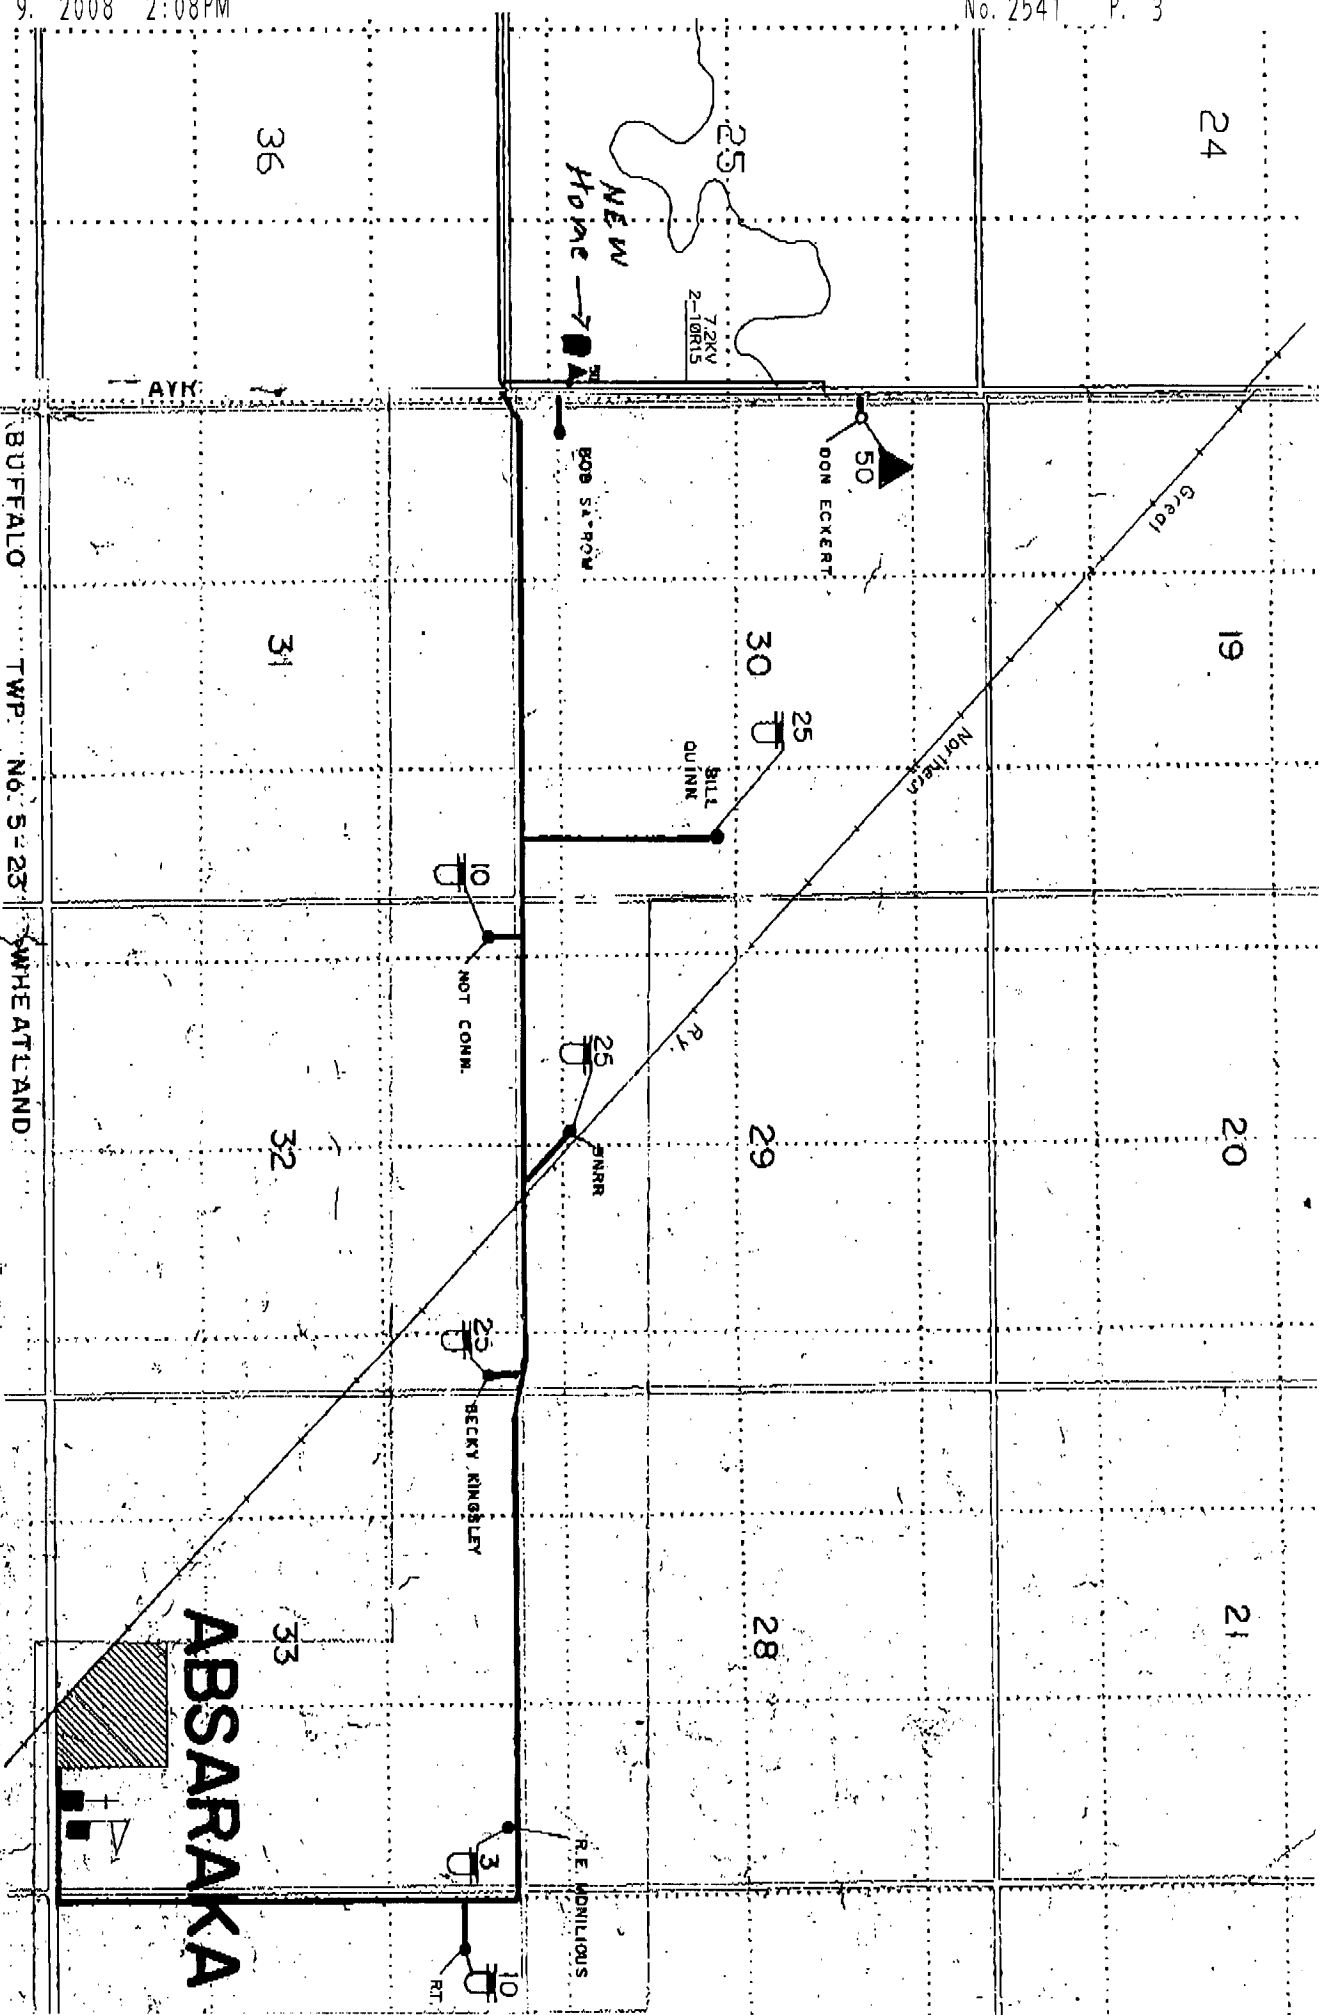

BUFFALO TWP. NO. 5-23 WHEATLAND

ABSARAKA



Date: 4/09/08

FAX Transmittal Pages to follow including this page 3

	<u>Fax</u>	<u>Phone</u>
To: Illona Jeffcoat-Sacco	701-328-2410	
From: Colleen Lebahn	701-253-4717	1-218-739-8597

re: Bob Sateom

**Confidentiality Notice:** The information included in this e-mail and any attachment is intended only for the personal and confidential use of the individual or entity to which they are addressed. This message, including attachments, may be or may contain privileged and confidential customer information. If you as the reader are not the intended recipient, you are hereby notified that you have received this communication in error and that any retention, review, use or distribution of this communication or the information contained in it is strictly prohibited. If you received this e-mail in error, destroy it immediately and please notify the sender of this message.

This transmittal and accompanying documents are intended only for the use of the person addressed above.

If you do not receive all pages or have trouble receiving this fax, please call \_\_\_\_\_