


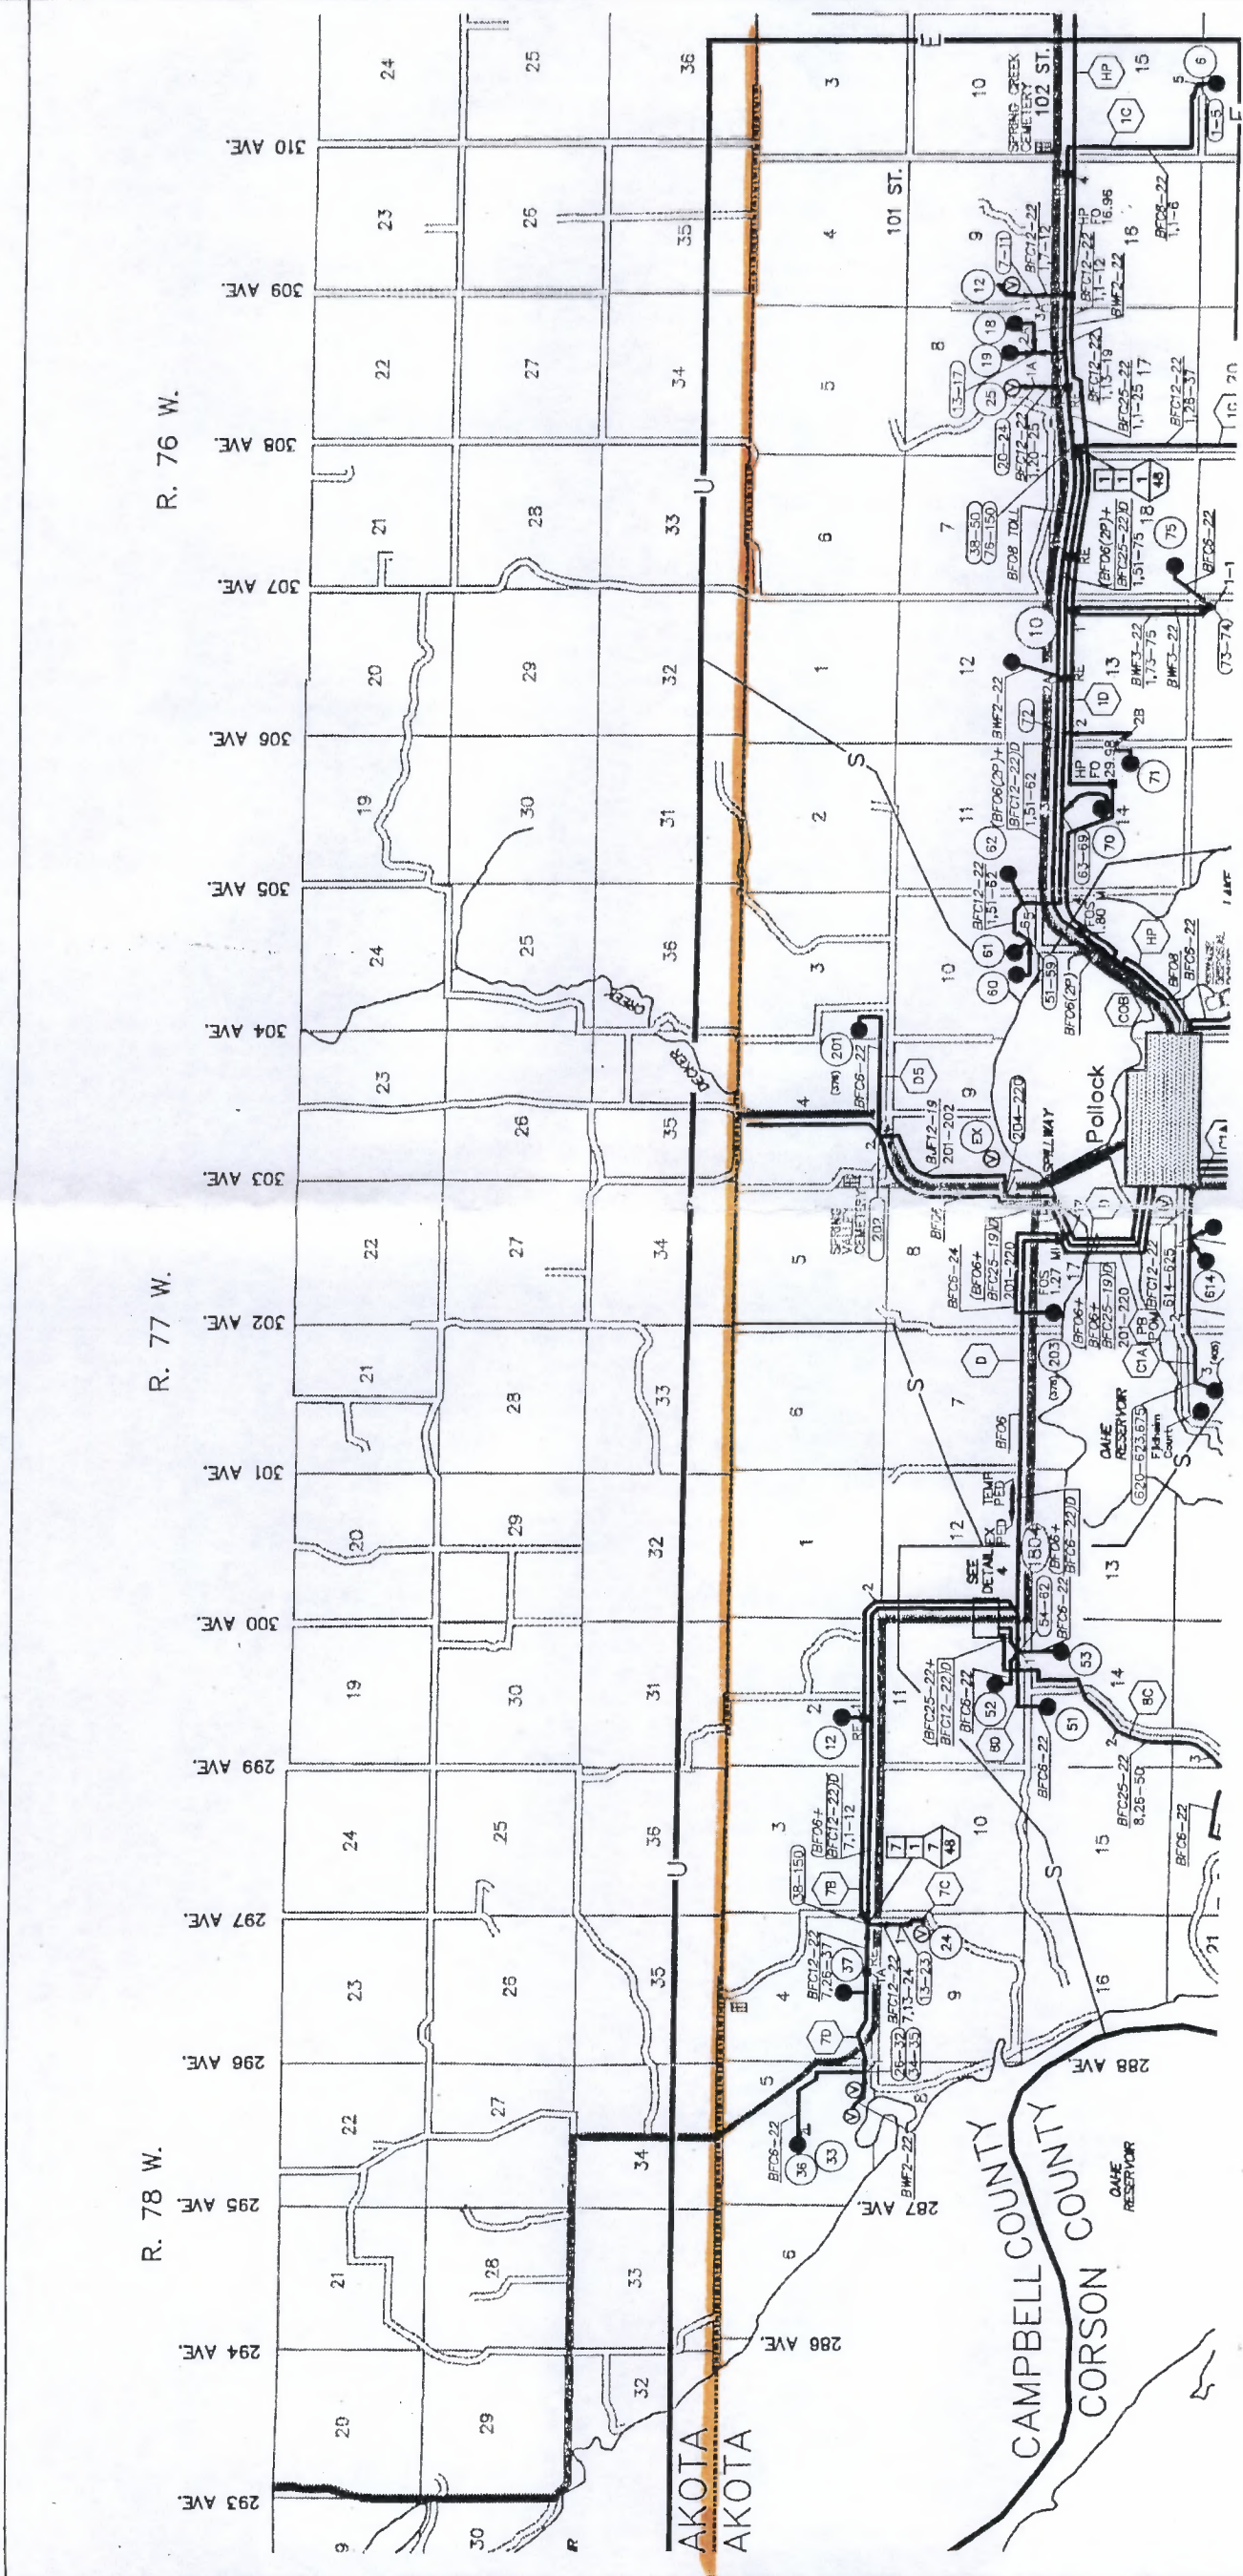

old Boundary
new Boundary



PROPOSED BOUNDARY CONCURRENCE:

 John Tormoehlen
 General Manager
 Valley Telecommunications
 Cooperative Assn., Inc.
 Date 9-14-07

 Derrick Bulawa
 GM/CEO
 BEK Communications
 Date 10-26-07



FINLEY ENGINEERING
COMPANY, INC.
P.O. BOX 1598 - Bismarck, ND 58502

POLLOCK EXCHANGE
NORTH BOUNDARY

Valley Telecommunications Cooperative Association
Herreid, South Dakota
SD509

REVISION	DATE	CHANGE OR ADDITION	DWN BY:	DATE:	SHEET:
KAR	4/5/07	Added Exchange View Layout	KR	4/5/07	1 OF 1