


old Boundary  
new Boundary

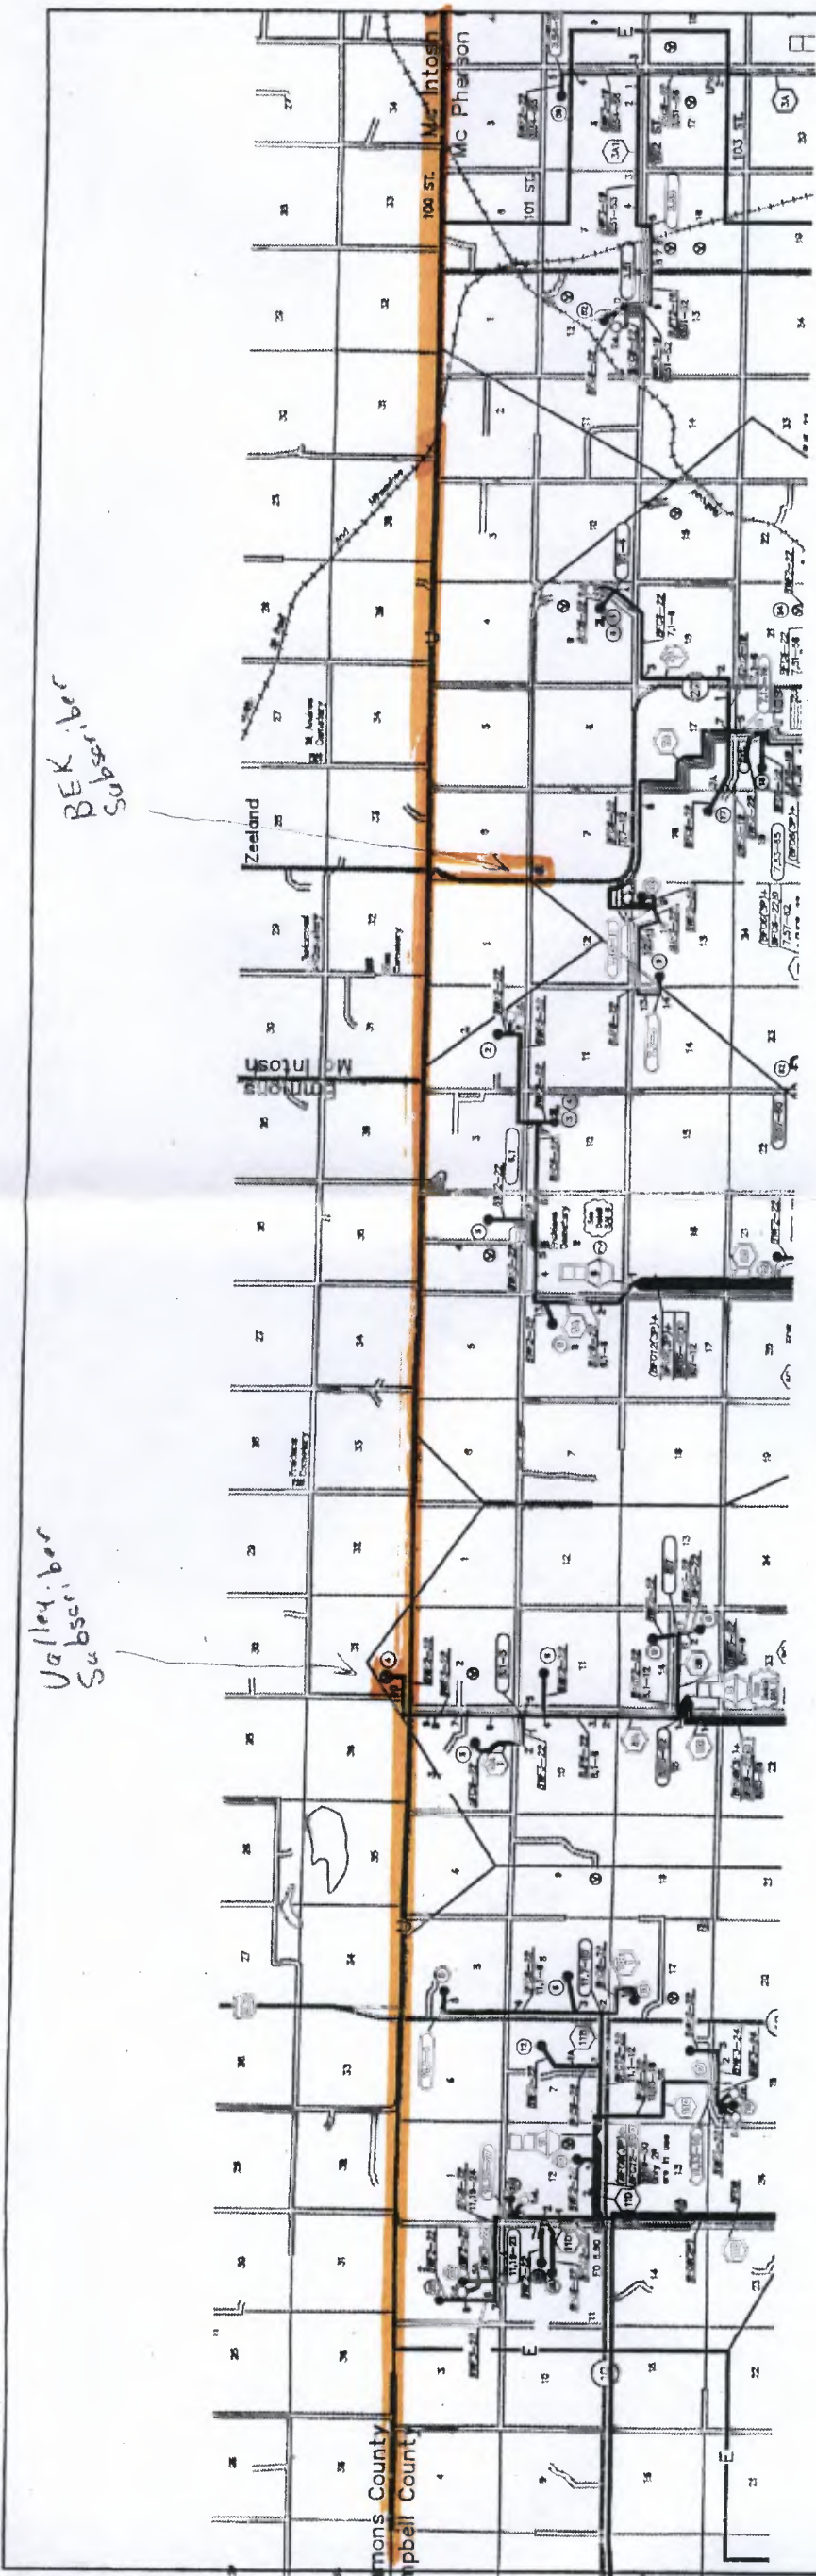

NOTICE: BOUNDARY CONCURRENCE:

John Tormoehlen  
General Manager  
Valley Telecommunications  
Cooperative Assn., Inc.

Derrick Bulawa  
GM/CEO  
BEK Communications

9-14-07  
Date

10-26-07  
Date



FINLEY ENGINEERING  
COMPANY, INC.

P.O. BOX 1698 - Bismarck, ND 58502

CHANGE OR ADDITION

Added Exchange View Layout

REVISION

DATE

4/6/07

KAR

HERREID EXCHANGE  
NORTH BOUNDARY

Valley Telecommunications Cooperative Association  
Herreid, South Dakota  
SD509

DATE: 4/5/07

DWN BY: KR

DWG NO:

SHEET: 1 OF 1