

Exam Date: 08/11/2008

Equity Cooperative Elevator Company of S

Page: 1

Examiner: 2

PO Box 218

Sheyenne, ND

County:

Phone: 701-996-2231

CCC Number:

Location/Container Numbers/Comments	Section	Capacity
<b>PART A - ADDITIONAL SPACE TO BE INCLUDED UNDER LICENSE</b>		
201	A	47,902
202	A } <i>new construction</i>	59,830
203	A }	87,244
204	A }	10,351
205	A } <i>hopper Tanks</i>	10,351
206	A }	2,864
207	A }	2,864
208	A }	3,933
001	D }	3,933
002	D } <i>hopper Tanks moved from Sheyenne to Oberon</i>	2,864
003	D }	2,864
004	D }	2,864
<b>Total:</b>		<b>237,864</b>

**PART B - SPACE TO BE DELETED UNDER LICENSE**

210	C - <i>moved</i>	2,913
101	D }	5,479
102	D } <i>destroyed</i>	5,479
103	D }	5,479
104	D }	5,479
105	D }	5,479
106	D }	5,479
031	A <i>destroyed</i>	15,014
<b>Total:</b>		<b>50,801</b>

**PART C - ALL SPACE TO BE INCLUDED UNDER LICENSE**

A	468,000	
B	122,000	
C	255,000	
D	32,000	
E	75,000	
<b>Total:</b>		<b>952,000</b>

**PART D - TOTAL CAPACITY BY FUNCTIONAL UNIT**

Oberon	281	C D	287,000
Sheyenne	282	A B E	665,000
<b>Total:</b>			<b>952,000</b>

Exam Date:08/11/2008

Equity Cooperative Elevator Company of S

Examiner: 2

PO Box 218  
 Sheyenne, ND  
 County:

Status	Section	Bin Number	Bin Type	Base Point	Diameter or Bu/Ft (Irreg)	Length	Width	Side wall	Add for Hopper	Ded. for Obst.	Effective Depth	Add for Peak Capac.	Depth for Capac.	Bushels per Foot	Base Pack%	Bushel Capacity with Pack
--------	---------	------------	----------	------------	---------------------------	--------	-------	-----------	----------------	----------------	-----------------	---------------------	------------------	------------------	------------	---------------------------

## Facility: Oberon

### Section: C

C	001		Square	work floor	0.000	10.60	6.100	39.00	0.00	0.00	39.000	0.000	39.0	52.0	4.50	2,119
C	002		Square	work floor	0.000	5.000	3.800	39.00	0.00	0.00	39.000	0.000	39.0	15.3	2.00	609
C	003		Square	work floor	0.000	5.000	3.800	39.00	0.00	0.00	39.000	0.000	39.0	15.3	2.00	609
C	004		Square	work floor	0.000	5.000	5.400	40.00	0.00	0.00	40.000	0.000	40.0	21.7	2.00	885
C	006		Square	work floor	0.000	5.000	4.900	40.00	0.00	0.00	40.000	0.000	40.0	19.7	2.00	804
C	007 T		Square	work floor	0.000	11.00	5.000	40.00	0.00	0.00	40.000	0.000	40.0	44.2	3.50	1,830
C	007 B		Square	work floor - top 40	0.000	11.20	10.10	14.00	0.00	0.00	14.000	0.000	14.0	90.9	5.80	1,347
C	009		Square	work floor	0.000	10.60	5.400	42.00	0.00	0.00	42.000	0.000	42.0	46.0	4.00	2,009
C	010 T		Square	work floor	0.000	10.60	4.900	42.00	0.00	0.00	42.000	0.000	42.0	41.8	3.50	1,817
C	010 B		Square	work floor -top 42'	0.000	11.20	10.40	12.00	0.00	0.00	12.000	0.000	12.0	93.6	5.80	1,188
C	011 T		Square	work floor	0.000	10.10	4.900	42.00	0.00	0.00	42.000	0.000	42.0	39.8	3.00	1,722
C	011 B		Square	work floor - top 42'	0.000	11.20	10.10	12.00	0.00	0.00	12.000	0.000	12.0	90.9	5.80	1,154
C	012		Square	work floor	0.000	10.10	5.400	37.00	0.00	0.00	37.000	0.000	37.0	43.8	3.50	1,678
C	013		Square	work floor	0.000	10.10	6.100	38.00	0.00	0.00	38.000	0.000	38.0	49.5	4.20	1,960
C	015 T		Irregular	work floor - 10.1 X 6.5 less	33.000	0.000	0.000	9.500	0.00	0.00	9.500	0.000	9.5	33.0	2.50	322
C	015 B		Square	work floor - top 9.5'	0.000	10.10	6.500	28.50	0.00	0.00	28.500	0.000	28.5	52.8	4.50	1,573
C	016		Square	work floor	0.000	10.10	5.400	42.00	0.00	0.00	42.000	0.000	42.0	43.8	3.50	1,904
C	017 T		Square	work floor	0.000	10.10	4.900	42.00	0.00	0.00	42.000	0.000	42.0	39.8	3.00	1,722
C	017 B		Square	work floor - top 42'	0.000	11.20	10.10	12.00	0.00	0.00	12.000	0.000	12.0	90.9	5.80	1,154
C	018		Square	work floor	0.000	10.60	5.400	42.00	0.00	0.00	42.000	0.000	42.0	46.0	4.00	2,009
C	019		Square	work floor	0.000	10.60	4.900	29.00	0.00	0.00	29.000	0.000	29.0	41.8	3.50	1,254

Exam Date:08/11/2008

Equity Cooperative Elevator Company of S

Page: 2

Examiner: 2

PO Box 218  
Sheyenne, ND

County:

Status	Section	Bin Number	Bin Type	Base Point	Diameter or Bu/Ft (Irreg.)	Length	Width	Side wall	Add for Hopper	Det. for Obst.	Effective Depth	Add for Peak Capac.	Depth	Bushels per Foot	Base Pack%	Bushel Capacity with Pack
--------	---------	------------	----------	------------	-------------------------------	--------	-------	--------------	----------------------	----------------------	--------------------	------------------------------	-------	------------------------	---------------	------------------------------

## Facility: Oberon

### Section: C

C		022 T	Square	work floor	0.000	10.10	4.900	42.00	0.00	0.00	42.000	0.000	42.0	39.8	3.00	1,722
C		022 B	Square	work floor - top 42'	0.000	11.20	10.10	12.00	0.00	0.00	12.000	0.000	12.0	90.9	5.80	1,154
C		023	Square	work floor	0.000	10.10	5.400	42.00	0.00	0.00	42.000	0.000	42.0	43.8	3.50	1,904
C		024	Square	work floor	0.000	10.10	3.500	39.00	0.00	0.00	39.000	0.000	39.0	28.4	2.50	1,136
C		026	Square	work floor	0.000	10.60	6.500	39.00	0.00	0.00	39.000	0.000	39.0	55.4	4.80	2,265
C		101 T	Square	work floor	0.000	10.30	9.700	43.00	0.00	0.00	43.000	0.000	43.0	80.3	5.50	3,643
C		101 B	Square	work floor - top 43'	0.000	14.30	9.400	8.000	0.00	0.00	8.000	0.000	8.0	108.1	6.20	919
C		102 T	Square	work floor	0.000	10.30	9.800	43.00	0.00	0.00	43.000	0.000	43.0	81.1	5.50	3,679
C		102 B	Square	work floor - top 43'	0.000	14.30	9.600	8.000	0.00	0.00	8.000	0.000	8.0	110.4	6.20	938
C		103 T	Square	work floor	0.000	10.30	9.700	43.00	0.00	0.00	43.000	0.000	43.0	80.3	5.50	3,643
C		103 B	Square	work floor - top 43'	0.000	14.30	9.700	8.000	0.00	0.00	8.000	0.000	8.0	111.5	6.20	947
C		104	Square	work floor	0.000	11.00	9.700	43.00	0.00	0.00	43.000	0.000	43.0	85.8	5.80	3,903
C		105 T	Square	work floor	0.000	10.30	9.700	43.00	0.00	0.00	43.000	0.000	43.0	80.3	5.50	3,643
C		105 B	Square	work floor - top 43'	0.000	14.30	9.500	8.000	0.00	0.00	8.000	0.000	8.0	109.2	6.20	928
C		107	Square	work floor	0.000	11.00	9.700	43.00	0.00	0.00	43.000	0.000	43.0	85.8	5.80	3,903
C		108 T	Square	work floor	0.000	10.00	9.700	43.00	0.00	0.00	43.000	0.000	43.0	78.0	5.50	3,538
C		108 B	Square	work floor - top 43'	0.000	12.20	9.500	8.000	0.00	0.00	8.000	0.000	8.0	93.2	5.80	789
C		109 T	Square	work floor	0.000	10.00	9.700	43.00	0.00	0.00	43.000	0.000	43.0	78.0	5.50	3,538
C		109 B	Square	work floor - top 43'	0.000	12.20	9.700	8.000	0.00	0.00	8.000	0.000	8.0	95.1	6.00	807
C		110 T	Square	work floor	0.000	10.00	9.800	43.00	0.00	0.00	43.000	0.000	43.0	78.8	5.50	3,574
C		110 B	Square	work floor - top 43'	0.000	12.20	9.600	8.000	0.00	0.00	8.000	0.000	8.0	94.1	6.00	798

Status	Section	Bin Number	Bin Type	Base Point	Diameter or Bu/Ft (Irreg.)	Length	Width	Side wall	Add for Hopper	Del. for Obst.	Effective Depth	Add for Peak	Depth for Capac.	Bushels per Foot	Base Pack%	Bushel Capacity with Pack
--------	---------	------------	----------	------------	----------------------------	--------	-------	-----------	----------------	----------------	-----------------	--------------	------------------	------------------	------------	---------------------------

## Facility: Oberon

### Section: C

C		111 T	Square	work floor	0.000	10.00	9.700	43.00	0.00	0.00	43.000	0.000	43.0	78.0	5.50	3,538
C		111 B	Square	work floor - top 43'	0.000	12.20	9.400	8.000	0.00	0.00	8.000	0.000	8.0	92.2	5.80	781
C		112	Square	work floor	0.000	11.00	9.700	44.00	0.00	0.00	44.000	0.000	44.0	85.8	5.80	3,994
C		113	Square	work floor	0.000	11.00	9.800	43.00	0.00	0.00	43.000	0.000	43.0	86.7	5.80	3,944
C		201	Peaked	top of sidewall	24.000	0.000	0.000	37.30	0.00	0.00	37.300	1.400	38.7	363.7	7.80	15,173
C		202	Peaked	top of sidewall	24.000	0.000	0.000	37.30	0.00	0.00	37.300	1.400	38.7	363.7	7.80	15,173
C		203	Peaked	top of sidewall	24.000	0.000	0.000	37.30	0.00	0.00	37.300	1.400	38.7	363.7	7.80	15,173
C		204	Peaked	top of sidewall	48.000	0.000	0.000	64.50	0.00	0.00	64.500	3.400	67.9	1454.6	10.0	108,644
C		205	Peaked	top of sidewall	18.000	0.000	0.000	48.00	0.00	0.00	48.000	1.100	49.1	204.6	6.00	10,649
<b>Bin count: 51</b>												<b>Facility: Oberon Section: C Total:</b>		<b>254,109</b>		
												<b>To Even:</b>		<b>255,000</b>		

### Section: D

Added	D	001	Peaked	top of sidewall	16.000	0.000	0.000	20.00	2.00	0.00	22.000	1.000	23.0	161.6	5.80	3,933
Added	D	002	Peaked	top of sidewall	15.500	0.000	0.000	15.00	2.00	0.00	17.000	0.900	17.9	151.7	5.50	2,864
Added	D	003	Peaked	top of sidewall	15.500	0.000	0.000	15.00	2.00	0.00	17.000	0.900	17.9	151.7	5.50	2,864
Added	D	004	Peaked	top of sidewall	15.500	0.000	0.000	15.00	2.00	0.00	17.000	0.900	17.9	151.7	5.50	2,864
	D	005	Peaked	top of sidewall	18.000	0.000	0.000	16.00	2.00	0.00	18.000	1.100	19.1	204.6	6.00	4,142
	D	006	Peaked	top of sidewall	16.000	0.000	0.000	20.00	2.00	0.00	22.000	1.000	23.0	161.6	5.80	3,933
	D	007	Peaked	top of sidewall	16.000	0.000	0.000	20.00	2.00	0.00	22.000	1.000	23.0	161.6	5.80	3,933

Exam Date: 08/11/2008

Equity Cooperative Elevator Company of S

Page: 4

Examiner: 2

PO Box 218  
Sheyenne, ND

County:

Status	Section	Bin Number	Bin Type	Base Point	Diameter or Bu/Ft (Irreg.)	Length	Width	Side wall	Add for Hopper	Ded. for Obst.	Effective Depth	Add for Peak	Depth Capac.	Bushels per Foot	Base Pack%	Bushel Capacity with Pack
--------	---------	------------	----------	------------	-------------------------------	--------	-------	--------------	----------------------	----------------------	--------------------	--------------------	-----------------	------------------------	---------------	------------------------------

**Facility: Oberon**

**Section: D**

D	008		Peaked	top of sidewall	17.600	0.000	0.000	16.00	0.00	0.00	16.000	1.100	17.1	195.6	6.00	3,546
D	009		Peaked	top of sidewall	17.600	0.000	0.000	16.00	0.00	0.00	16.000	1.100	17.1	195.6	6.00	3,546

Bin count: 9      Facility: Oberon Section: D Total: **31,625**

To Even: **32,000**

Exam Date:08/11/2008  
 Examiner: 2

Equity Cooperative Elevator Company of S  
 PO Box 218  
 Sheyenne, ND  
 County:

Status	Section	Bin Number	Bin Type	Base Point	Diameter or Bu/Ft (Irreg.)	Length	Width	Side wall	Add for Hopper	Red. for Obst.	Effective Depth	Add for Peak Capac.	Depth	Bushels per Foot	Base Pack%	Bushel Capacity with Pack
--------	---------	------------	----------	------------	----------------------------	--------	-------	-----------	----------------	----------------	-----------------	---------------------	-------	------------------	------------	---------------------------

## Facility: Sheyenne

### Section: A

A	001	Square	work floor		0.000	6.800	5.200	54.00	0.00	0.00	54.000	0.000	54.0	28.4	2.50	1,572
A	002	Square	work floor		0.000	8.300	5.900	50.00	0.00	0.00	50.000	0.000	50.0	39.4	3.00	2,029
A	003	Square	work floor		0.000	6.900	5.200	54.00	0.00	0.00	54.000	0.000	54.0	28.8	2.50	1,594
A	004 T	Square	work floor		0.000	6.800	5.100	15.00	0.00	0.00	15.000	0.000	15.0	27.9	2.50	429
A	004 M	Square	work floor - top 15'		0.000	14.00	5.100	38.00	0.00	0.00	38.000	0.000	38.0	57.4	4.80	2,286
A	004B	Square	work floor - top & middle 53'		0.000	14.00	10.30	14.00	0.00	0.00	14.000	0.000	14.0	115.9	6.20	1,724
A	005	Square	work floor		0.000	6.900	5.100	15.50	0.00	0.00	15.500	0.000	15.5	28.3	2.50	450
A	006	Square	work floor		0.000	6.900	5.900	48.00	0.00	0.00	48.000	0.000	48.0	32.7	2.50	1,609
A	007	Square	work floor		0.000	6.800	5.900	50.00	0.00	0.00	50.000	0.000	50.0	32.3	2.50	1,655
A	008	Square	work floor		0.000	6.800	6.300	50.00	0.00	0.00	50.000	0.000	50.0	34.4	3.00	1,772
A	009	Square	work floor		0.000	6.900	6.300	48.00	0.00	0.00	48.000	0.000	48.0	34.9	3.00	1,725
A	010	Square	work floor		0.000	8.300	6.300	50.00	0.00	0.00	50.000	0.000	50.0	42.0	3.50	2,174
A	011 T	Square	work floor		0.000	10.50	6.900	46.00	0.00	0.00	46.000	0.000	46.0	58.2	4.80	2,805
A	011 B	Square	work floor - top 46'		0.000	14.00	10.50	21.00	0.00	0.00	21.000	0.000	21.0	118.2	6.20	2,636
A	012	Square	work floor		0.000	10.50	6.800	49.50	0.00	0.00	49.500	0.000	49.5	57.4	4.80	2,977
A	015 T	Irregular	work floor - 10.5 x 8.3 with		47.000	0.000	0.000	12.00	0.00	0.00	12.000	0.000	12.0	47.0	4.00	587
A	015 B	Square	work floor - top 12'		0.000	10.50	8.300	36.00	0.00	0.00	36.000	0.000	36.0	70.1	5.20	2,655
A	016	Square	work floor		0.000	10.50	8.000	50.00	0.00	0.00	50.000	0.000	50.0	67.5	5.20	3,551
A	017	Square	work floor		0.000	10.50	6.800	46.00	0.00	0.00	46.000	0.000	46.0	57.4	4.80	2,767
A	018	Square	work floor		0.000	8.000	6.300	49.00	0.00	0.00	49.000	0.000	49.0	40.5	3.00	2,045
A	019	Square	work floor		0.000	13.10	6.800	49.00	0.00	0.00	49.000	0.000	49.0	71.6	5.20	3,690

Exam Date:08/11/2008  
 Examiner: 2

Equity Cooperative Elevator Company of S  
 PO Box 218  
 Sheyenne, ND  
 County:

Status	Section	Bin Number	Bin Type	Base Point	Diameter or Bu/Ft (Irreg).	Length	Width	Side wall	Add for Hopper	Ded. for Obst.	Effective Depth	Add for Peak	Depth for Capac.	Bushels per Foot	Base Pack%	Bushel Capacity with Pack
--------	---------	------------	----------	------------	----------------------------	--------	-------	-----------	----------------	----------------	-----------------	--------------	------------------	------------------	------------	---------------------------

## Facility: Sheyenne

### Section: A

A		020 T	Square	work floor	0.000	10.50	6.800	46.00	0.00	0.00	46.000	0.000	46.0	57.4	4.80	2,767
A		020 B	Square	work floor - top 46'	0.000	14.00	10.50	21.00	0.00	0.00	21.000	0.000	21.0	118.2	6.20	2,636
A		022	Square	work floor	0.000	13.10	6.800	48.50	0.00	0.00	48.500	0.000	48.5	71.6	5.20	3,654
A		023	Square	work floor	0.000	8.000	5.900	50.00	0.00	0.00	50.000	0.000	50.0	37.9	3.00	1,952
A		024 T	Square	work floor	0.000	14.00	5.100	53.00	0.00	0.00	53.000	0.000	53.0	57.4	4.80	3,188
A		024 B	Square	work floor - top 53'	0.000	14.00	10.30	14.00	0.00	0.00	14.000	0.000	14.0	115.9	6.20	1,724
A		025	Square	work floor	0.000	6.800	5.200	53.00	0.00	0.00	53.000	0.000	53.0	28.4	2.50	1,543
A		026	Square	work floor	0.000	6.800	5.200	53.00	0.00	0.00	53.000	0.000	53.0	28.4	2.50	1,543
A		029	Square	work floor	0.000	5.000	4.400	49.00	0.00	0.00	49.000	0.000	49.0	17.7	2.00	884
A		030	Square	work floor	0.000	10.30	4.100	49.50	0.00	0.00	49.500	0.000	49.5	33.9	2.50	1,720
A		101 T	Square	work floor	0.000	11.50	10.30	58.00	0.00	0.00	58.000	0.000	58.0	95.2	6.00	5,853
A		101 B	Square	work floor - top 58'	0.000	15.20	10.30	9.000	0.00	0.00	9.000	0.000	9.0	125.9	6.50	1,207
A		102 T	Square	work floor	0.000	11.50	10.50	58.00	0.00	0.00	58.000	0.000	58.0	97.1	6.00	5,970
A		102 B	Square	work floor - top 58'	0.000	15.20	10.50	9.000	0.00	0.00	9.000	0.000	9.0	128.3	6.50	1,230
A		103	Square	work floor	0.000	12.00	10.50	58.00	0.00	0.00	58.000	0.000	58.0	101.3	6.00	6,228
A		104 T	Square	work floor	0.000	11.50	10.50	58.00	0.00	0.00	58.000	0.000	58.0	97.1	6.00	5,970
A		104 B	Square	work floor - top 58'	0.000	15.20	10.50	9.000	0.00	0.00	9.000	0.000	9.0	128.3	6.50	1,230
A		105	Square	work floor	0.000	12.00	10.50	58.00	0.00	0.00	58.000	0.000	58.0	101.3	6.00	6,228
A		106 T	Square	work floor	0.000	11.50	10.50	58.00	0.00	0.00	58.000	0.000	58.0	97.1	6.00	5,970
A		106 B	Square	work floor - top 58'	0.000	15.20	10.50	9.000	0.00	0.00	9.000	0.000	9.0	128.3	6.50	1,230
A		107 T	Square	work floor	0.000	11.50	10.50	58.00	0.00	0.00	58.000	0.000	58.0	97.1	6.00	5,970

Exam Date:08/11/2008

Equity Cooperative Elevator Company of S

Page: 7

Examiner: 2

PO Box 218  
Sheyenne, ND

County:

Status	Section	Bin Number	Bin Type	Base Point	Diameter		Side	Add	Ded.	Effective	Add	Depth	Bushels	Base	Bushel Capacity
					or Bu/Ft (Irreg).	Length									

## Facility: Sheyenne

### Section: A

A	107 B	Square	work floor - top 58'	0.000	15.20	10.50	9.000	0.00	0.00	9.000	0.000	9.0	128.3	6.50	1,230	
A	108 T	Square	work floor	0.000	11.50	10.30	58.00	0.00	0.00	58.000	0.000	58.0	95.2	6.00	5,853	
A	108 B	Square	work floor - top 58'	0.000	15.20	10.30	9.000	0.00	0.00	9.000	0.000	9.0	125.9	6.50	1,207	
A	109	Square	work floor	0.000	12.00	10.30	58.00	0.00	0.00	58.000	0.000	58.0	99.4	6.00	6,111	
A	110 T	Square	work floor	0.000	11.50	10.60	58.00	0.00	0.00	58.000	0.000	58.0	98.0	6.00	6,025	
A	110 B	Square	work floor - top 58'	0.000	15.20	10.60	9.000	0.00	0.00	9.000	0.000	9.0	129.5	6.50	1,242	
A	111	Square	work floor	0.000	12.00	10.50	58.00	0.00	0.00	58.000	0.000	58.0	101.3	6.00	6,228	
A	112 T	Square	work floor	0.000	11.50	10.50	58.00	0.00	0.00	58.000	0.000	58.0	97.1	6.00	5,970	
A	112 B	Square	work floor - top 58'	0.000	15.20	10.50	9.000	0.00	0.00	9.000	0.000	9.0	128.3	6.50	1,230	
A	113 T	Square	work floor	0.000	11.50	10.30	58.00	0.00	0.00	58.000	0.000	58.0	95.2	6.00	5,853	
A	113 B	Square	work floor - top 58'	0.000	15.20	10.30	9.000	0.00	0.00	9.000	0.000	9.0	125.9	6.50	1,207	
A	115	Square	work floor	0.000	12.00	10.30	58.00	0.00	0.00	58.000	0.000	58.0	99.4	6.00	6,111	
A	116 T	Square	work floor	0.000	11.50	10.30	58.00	0.00	0.00	58.000	0.000	58.0	95.2	6.00	5,853	
A	116 B	Square	work floor - top 58'	0.000	15.20	10.30	9.000	0.00	0.00	9.000	0.000	9.0	125.9	6.50	1,207	
A	117 T	Square	work floor	0.000	11.50	10.50	58.00	0.00	0.00	58.000	0.000	58.0	97.1	6.00	5,970	
A	117 B	Square	work floor - top 58'	0.000	15.20	10.50	9.000	0.00	0.00	9.000	0.000	9.0	128.3	6.50	1,230	
A	118 T	Square	work floor	0.000	11.50	10.60	58.00	0.00	0.00	58.000	0.000	58.0	98.0	6.00	6,025	
A	118 B	Square	work floor - top 58'	0.000	15.20	10.60	9.000	0.00	0.00	9.000	0.000	9.0	129.5	6.50	1,242	
A	119	Square	work floor	0.000	12.00	10.60	58.00	0.00	0.00	58.000	0.000	58.0	102.3	6.00	6,289	
Added	A	201	Peaked	top of sidewall at eave	32.700	0.000	0.000	62.80	0.00	0.00	62.800	2.000	64.8	675.1	9.50	47,902
Added	A	202	Peaked	top of sidewall at eave	35.700	0.000	0.000	65.50	0.00	0.00	65.500	2.100	67.6	804.6	10.0	59,830

Status	Section	Bin Number	Bin Type	Base Point	Diameter or Bu/Ft (Irreg.)	Length	Width	Side wall	Add for Hopper	Det. for Obst.	Effective Depth	Add for Peak	Depth for Capac.	Bushels per Foot	Base Pack%	Bushel Capacity with Pack
--------	---------	------------	----------	------------	----------------------------	--------	-------	-----------	----------------	----------------	-----------------	--------------	------------------	------------------	------------	---------------------------

## Facility: Sheyenne

Added	A	203	Peaked	top of sidewall at eave	41.800	0.000	0.000	69.40	0.00	0.00	69.400	2.500	71.9	1103.1	10.0	87,244
Added	A	204	Peaked	top of sidewall - hopper bin	24.000	0.000	0.000	22.00	3.00	0.00	25.000	1.400	26.4	363.7	7.80	10,351
Added	A	205	Peaked	top of sidewall - hopper bin	24.000	0.000	0.000	22.00	3.00	0.00	25.000	1.400	26.4	363.7	7.80	10,351
Added	A	206	Peaked	top of sidewall - hopper bin	15.500	0.000	0.000	15.00	2.00	0.00	17.000	0.900	17.9	151.7	5.50	2,864
Added	A	207	Peaked	top of sidewall - hopper bin	15.500	0.000	0.000	15.00	2.00	0.00	17.000	0.900	17.9	151.7	5.50	2,864
Added	A	208	Peaked	top of sidewall - hopper bin	16.000	0.000	0.000	20.00	2.00	0.00	22.000	1.000	23.0	161.6	5.80	3,933
Added	A	301	Peaked	top of sidewall	35.800	0.000	0.000	58.75	0.00	0.00	58.750	2.100	60.9	809.2	10.0	54,208

Bin count: 70 Facility: Sheyenne Section: A Total: **467,059**  
To Even: **468,000**

## Section: B

B	001	Square	work floor	0.000	5.700	3.500	52.50	0.00	0.00	52.500	0.000	52.5	16.0	2.00	857
B	003	Square	work floor	0.000	5.000	4.100	52.00	0.00	0.00	52.000	0.000	52.0	16.5	2.00	875
B	004 T	Square	work floor	0.000	11.20	6.000	21.00	0.00	0.00	21.000	0.000	21.0	54.0	4.50	1,185
B	004 B	Square	work floor - top 21'	0.000	11.20	10.60	49.50	0.00	0.00	49.500	0.000	49.5	95.4	6.00	5,005
B	005	Square	work floor	0.000	11.20	4.600	20.00	0.00	0.00	20.000	0.000	20.0	41.4	3.50	857
B	006	Square	work floor	0.000	5.700	3.500	52.50	0.00	0.00	52.500	0.000	52.5	16.0	2.00	857
B	007	Square	work floor	0.000	10.60	5.700	51.00	0.00	0.00	51.000	0.000	51.0	48.6	4.20	2,583
B	008	Square	work floor	0.000	10.60	5.800	51.00	0.00	0.00	51.000	0.000	51.0	49.4	4.20	2,625
B	009	Square	work floor	0.000	11.20	10.60	70.00	0.00	0.00	70.000	0.000	70.0	95.4	6.00	7,079

Exam Date:08/11/2008

Equity Cooperative Elevator Company of S

Page: 9

Examiner: 2

PO Box 218  
 Sheyenne, ND  
 County:

Status	Section	Bin Number	Bin Type	Base Point	Diameter or Bu/Ft (Irreg.)	Length	Width	Side wall	Add for Hopper	Depth for Obsi	Effective Depth	Add for Peak	Depth for Capac.	Bushels per Foot	Base Pack%	Bushel Capacity with Pack
--------	---------	------------	----------	------------	----------------------------	--------	-------	-----------	----------------	----------------	-----------------	--------------	------------------	------------------	------------	---------------------------

## Facility: Sheyenne

### Section: B

B		010	Square	work floor	0.000	7.300	5.800	52.00	0.00	0.00	52.000	0.000	52.0	34.0	2.50	1,812
B		012 T	Square	work floor	0.000	7.600	7.300	15.00	0.00	0.00	15.000	0.000	15.0	44.6	3.50	692
B		012 B	Square	work floor - top 15'	0.000	11.20	7.300	37.00	0.00	0.00	37.000	0.000	37.0	65.7	5.00	2,553
B		015	Square	work floor	0.000	11.20	7.400	51.50	0.00	0.00	51.500	0.000	51.5	66.6	5.00	3,602
B		016	Square	work floor	0.000	11.20	10.60	70.00	0.00	0.00	70.000	0.000	70.0	95.4	6.00	7,079
B		017	Square	work floor	0.000	7.400	5.800	52.00	0.00	0.00	52.000	0.000	52.0	34.5	3.00	1,848
B		018	Square	work floor	0.000	10.60	5.800	51.00	0.00	0.00	51.000	0.000	51.0	49.4	4.20	2,625
B		020	Square	work floor	0.000	10.60	5.700	51.00	0.00	0.00	51.000	0.000	51.0	48.6	4.20	2,583
B		021 T	Square	work floor	0.000	11.00	7.000	53.00	0.00	0.00	53.000	0.000	53.0	61.9	4.80	3,438
B		021 B	Square	work floor- top 53'	0.000	11.00	10.60	17.00	0.00	0.00	17.000	0.000	17.0	93.7	5.80	1,685
B		022	Square	work floor	0.000	11.00	4.100	51.00	0.00	0.00	51.000	0.000	51.0	36.3	3.00	1,907
B		023	Square	work floor	0.000	7.400	5.700	52.00	0.00	0.00	52.000	0.000	52.0	33.9	2.50	1,807
B		024	Square	work floor	0.000	5.400	4.100	52.00	0.00	0.00	52.000	0.000	52.0	17.8	2.00	945
B		101	Peaked	top of sidewall	32.900	0.000	0.000	42.70	0.00	0.00	42.700	2.000	44.7	683.4	9.50	33,450
B		102	Peaked	top of sidewall	32.900	0.000	0.000	42.70	0.00	0.00	42.700	2.000	44.7	683.4	9.50	33,450
<b>Bin count: 24</b>													<b>Facility: Sheyenne Section: B Total:</b>		<b>121,399</b>	
													<b>To Even:</b>		<b>122,000</b>	

Exam Date:08/11/2008

Equity Cooperative Elevator Company of S

Page: 10

Examiner: 2

PO Box 218  
Sheyenne, ND  
County:

Status	Section	Bin Number	Bin Type	Base Point	Diameter or Bu/Ft (Irreg):	Length	Width	Side wall	Add for Hopper	Ded. for Obst.	Effective Depth	Add for Peak	Depth for Capac.	Bushels per Foot	Base Pack%	Bushel Capacity with Pack
--------	---------	------------	----------	------------	----------------------------	--------	-------	-----------	----------------	----------------	-----------------	--------------	------------------	------------------	------------	---------------------------

## Facility: Sheyenne

### Section: E

E	001	Flat	zero top of sidewall 14'		0.000	120.5	50.00	14.00	0.00	0.00	14.000	0.000	14.0	4843.2	10.0	74,586
Bin count: 1																
Facility: Sheyenne Section: E Total: <u>74,586</u>																
To Even: <u>75,000</u>																

**Overall Licensed Bin Capacity for:**  
**Equity Cooperative Elevator Company of S**

Bin count: 155

**Licensed Capacity:** 948,778 Bu.  
 (includes pack)

**Licensed Capacity (to even):** 952,000 Bu.  
 (includes pack and section totals are rounded up to next highest 1000)

EQUITY CO-OP ELEV. CO. of SHEYENNE  
 SHEYENNE N.D.  
 SECTION A




RRV&W RR

011	012	015	016	017	020	101	102	104	118	117	116
09	08	10	18	019	022	109	103	105	119	111	115
06	07	02	23								
05	04	30	29		024	108	107	106	110	112	113
03	01	XX	XX	26	25						

driveway


Office

Mill

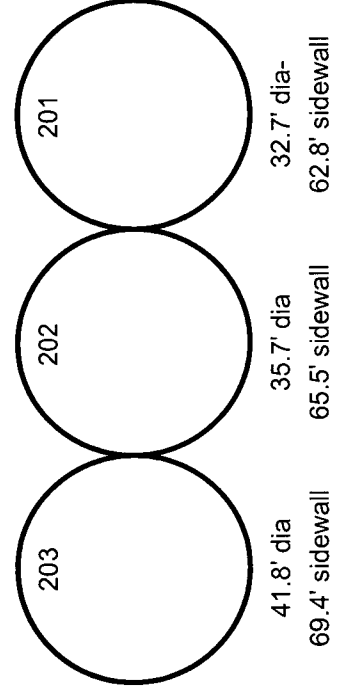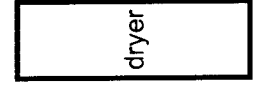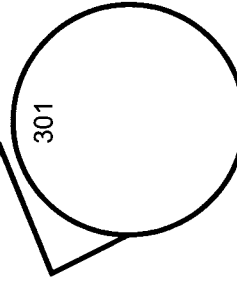



RRV&W RAIL

SECTION B

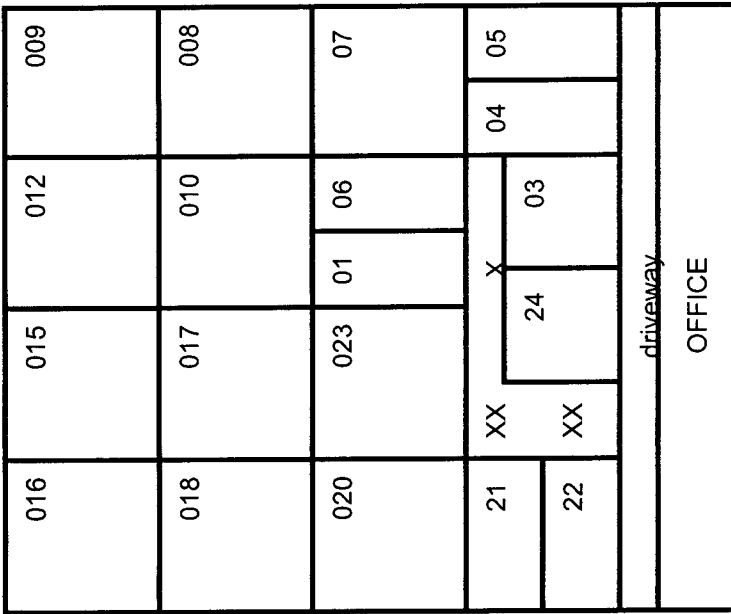


Section B is 275' S of Sec A


SECTION A  
 hopper tanks

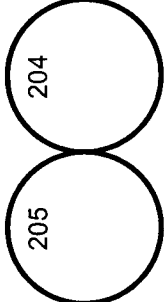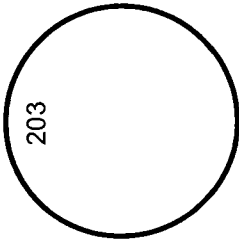


#204 & 205  
 24' dia - 9' hopper  
 22' sidewall

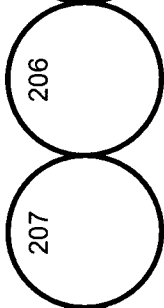

#206 & 207  
 15.5' dia - 6' hopper  
 15' sidewall

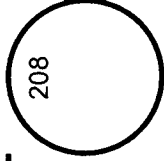

#208  
 16' dia  
 6' hopper  
 20' sidewall

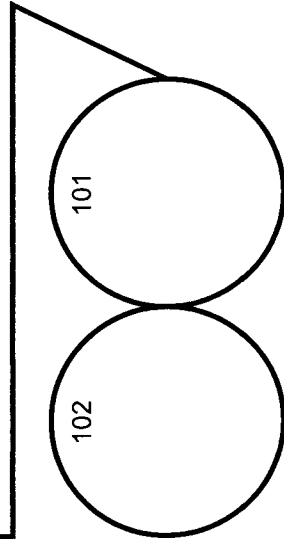

32.9' dia  
 42.7' sidewall

BNSF RAIL

SECTION C

105	103	102	101
107	104	113	112
108	109	110	111

SECTION C



017	016	015	013	012	011
019	018	026	001	009	010
022	023	24	X 02	007	
			X 03	04	06

driveway

SECTION C


measure #13 both sides or partition

SECTION C

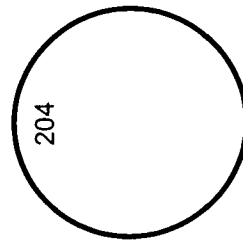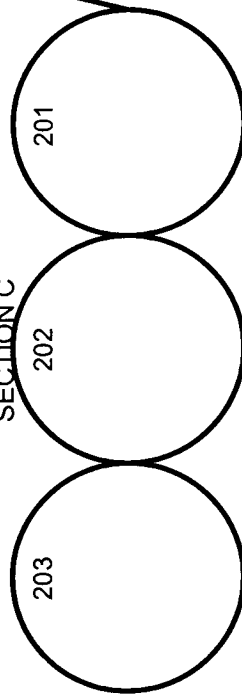


SECTION D

Indicated 2 blocks south of Sec. C

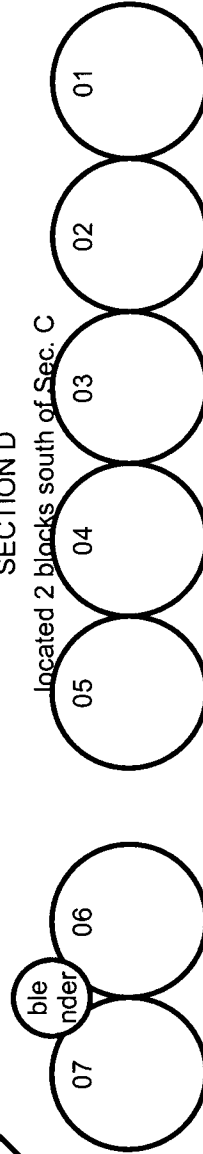

city street

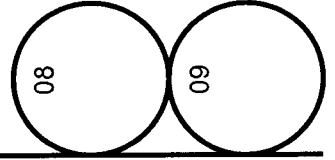

- tank #5  
18' dia - 16' sidewall  
6' hopper
- tanks #1-6-7  
16' dia. - 20' sidewall  
6' hopper
- tanks 2-3-4  
15.5' dia - 15' sidewall  
6' hopper
- tanks 8&9  
17.6' dia- 16' sidewall

SECTION D

EQUITY CO-OP ELEVATOR OF SHEYENNE  
SHEYENNE ND  
SECTION E

flat storage building

located 3 blocks south of Section B

Base dimensions

120.5' Length x 50.0' Width  
sidewall ht. 14.0'  
crossbars 13.8' ht.

