

Client ID: 2025

NDPSC Statement of Capacities

10/20/2008 11:09:26 AM

Exam Date: 10/20/2008

Cando Farmers Grain & Oil Cooperative, I

Page: 1

Examiner: 2

PO Box 456

Cando, ND

County:

Phone: 701-968-4446

CCC Number:

Location/Container Numbers/Comments	Section	Capacity
PART A - ADDITIONAL SPACE TO BE INCLUDED UNDER LICENSE		
024	A-E New construction Egeland	152,721
201	A 2 New construction Cando	251,941
202	A)	251,941
001	E } North Bin site	55,293
002	E)	55,293
Total:		767,189

PART B - SPACE TO BE DELETED UNDER LICENSE

106 N	A }	12,703
107 N	A } Destroyed	12,703
108 N	A)	12,703
109 N	A)	12,703
003	E } North site not licensed	55,293
004	E)	55,293
Total:		161,398

PART C - ALL SPACE TO BE INCLUDED UNDER LICENSE

A	863,000	
A-E Egeland	266,000	
B	20,000	
C	160,000	
D	63,000	
E North bin site	111,000	
N Doodles site	112,000	
Total:		1,595,000

PART D - TOTAL CAPACITY BY FUNCTIONAL UNIT

Cando 1016	A B C D E N	1,329,000
Egeland 1162	A-E	266,000
Total:		1,595,000

Current Bond \$389,000 - 1,150,000 bushels
 increase bond to \$470,000 1,600,000 bushels

Exam Date: 10/20/2008
Examiner: 2

Cando Farmers Grain & Oil Cooperative, I
PO Box 456
Cando, ND
County:

Status	Section	Bin Number	Bin Type	Base Point	Diameter or Bu/Ft (Ireg):	Length	Width	Side wall	Add for Hopper	Ded. for Obs.	Effective Depth	Add for Peak	Depth for Capac.	Bushels per Foot	Base Pack%	Bushel Capacity with Pack
--------	---------	------------	----------	------------	---------------------------	--------	-------	-----------	----------------	---------------	-----------------	--------------	------------------	------------------	------------	---------------------------

Facility: Cando

Section: A

A	002	Square	bin floor		0.000	7.200	5.700	52.00	0.00	0.00	52.000	0.000	52.0	33.0	2.50	1,759
A	003	Square	bin floor		0.000	7.200	4.300	49.00	0.00	0.00	49.000	0.000	49.0	24.9	2.50	1,251
A	004	Square	bin floor		0.000	10.70	4.300	23.00	0.00	0.00	23.000	0.000	23.0	37.0	3.00	877
A	005 T	Square	bin floor		0.000	10.70	6.400	22.00	0.00	0.00	22.000	0.000	22.0	55.0	4.50	1,264
A	005 B	Square	bin floor - 22'		0.000	10.90	10.70	47.00	0.00	0.00	47.000	0.000	47.0	93.8	5.80	4,665
A	006	Square	bin floor		0.000	13.20	10.90	66.00	0.00	0.00	66.000	0.000	66.0	115.7	6.20	8,109
A	007	Square	bin floor		0.000	10.70	5.700	50.00	0.00	0.00	50.000	0.000	50.0	49.0	4.20	2,553
A	008	Square	bin floor		0.000	13.20	5.700	46.00	0.00	0.00	46.000	0.000	46.0	60.5	4.80	2,917
A	009	Square	bin floor		0.000	13.20	5.900	48.00	0.00	0.00	48.000	0.000	48.0	62.6	5.00	3,155
A	011	Square	bin floor		0.000	13.20	10.90	66.00	0.00	0.00	66.000	0.000	66.0	115.7	6.20	8,109
A	012	Square	bin floor		0.000	10.70	5.900	50.00	0.00	0.00	50.000	0.000	50.0	50.7	4.50	2,649
A	013	Square	bin floor		0.000	10.90	10.70	69.00	0.00	0.00	69.000	0.000	69.0	93.8	5.80	6,847
A	015 T	Iregular	bin floor - 10.9x7.2 less		29.000	0.000	0.000	14.00	0.00	0.00	14.000	0.000	14.0	29.0	2.50	416
A	015 B	Square	bin floor - top 14'		0.000	10.90	7.200	35.00	0.00	0.00	35.000	0.000	35.0	63.1	5.00	2,319
A	016	Square	bin floor		0.000	7.200	5.900	52.00	0.00	0.00	52.000	0.000	52.0	34.1	3.00	1,826
A	017	Square	bin floor		0.000	10.90	7.400	49.00	0.00	0.00	49.000	0.000	49.0	64.8	5.00	3,334
A	018	Square	bin floor		0.000	10.90	10.70	69.00	0.00	0.00	69.000	0.000	69.0	93.8	5.80	6,847
A	019	Square	bin floor		0.000	10.70	5.900	50.00	0.00	0.00	50.000	0.000	50.0	50.7	4.50	2,649
A	020	Square	bin floor		0.000	13.20	10.90	66.00	0.00	0.00	66.000	0.000	66.0	115.7	6.20	8,109
A	021	Square	bin floor		0.000	7.400	5.900	52.00	0.00	0.00	52.000	0.000	52.0	35.1	3.00	1,880
A	022	Square	bin floor		0.000	13.20	12.10	47.00	0.00	0.00	47.000	0.000	47.0	128.4	6.50	6,427

Exam Date: 10/20/2008
Examiner: 2

Cando Farmers Grain & Oil Cooperative, I
PO Box 456
Cando, ND
County:

Status	Section	Bin Number	Bin Type	Base Point	Diameter or Bu/Ft (Irrig.)	Length	Width	Side wall	Add for Hopper	Ded. for Obst.	Effective Depth	Add for Peak	Depth for Capac.	Bushels per Foot	Base Pack%	Bushel Capacity with Pack
--------	---------	------------	----------	------------	----------------------------	--------	-------	-----------	----------------	----------------	-----------------	--------------	------------------	------------------	------------	---------------------------

Facility: Cando

Section: A

A		024	Square	bin floor	0.000	10.70	5.700	50.00	0.00	0.00	50.000	0.000	50.0	49.0	4.20	2,553
A		025	Square	bin floor	0.000	13.20	10.90	66.00	0.00	0.00	66.000	0.000	66.0	115.7	6.20	8,109
A		026	Square	bin floor	0.000	10.90	10.70	69.00	0.00	0.00	69.000	0.000	69.0	93.8	5.80	6,847
A		027	Square	bin floor	0.000	7.400	4.300	49.00	0.00	0.00	49.000	0.000	49.0	25.6	2.50	1,285
A		028	Square	bin floor	0.000	7.400	5.700	52.00	0.00	0.00	52.000	0.000	52.0	33.9	2.50	1,807
A		101 S	Peaked	top of sidewall	32.900	0.000	0.000	64.80	0.00	0.00	64.800	2.000	66.8	683.4	9.50	49,988
A		102 S	Peaked	top of sidewall	32.900	0.000	0.000	64.80	0.00	0.00	64.800	2.000	66.8	683.4	9.50	49,988
A		103 N	Peaked	top of sidewall	23.900	0.000	0.000	24.00	0.00	0.00	24.000	1.400	25.4	360.6	7.80	9,873
A		104 N	Peaked	top of sidewall	42.000	0.000	0.000	58.70	0.00	0.00	58.700	2.500	61.2	1113.7	10.0	74,974
A		105 N	Peaked	top of sidewall	42.000	0.000	0.000	58.70	0.00	0.00	58.700	2.500	61.2	1113.7	10.0	74,974
Added	A	201	Peaked	top of sidewall	77.500	0.000	0.000	55.00	0.00	0.00	55.000	5.400	60.4	3792.0	10.0	251,941
Added	A	202	Peaked	top of sidewall	77.500	0.000	0.000	55.00	0.00	0.00	55.000	5.400	60.4	3792.0	10.0	251,941

Bin count: 33 Facility: Cando Section: A Total: 862,242

To Even: 863,000

Section: B

B		001	Peaked	top of sidewall	14.600	0.000	0.000	17.00	2.20	0.00	19.200	0.900	20.1	134.6	5.50	2,854
B		002	Peaked	top of sidewall	14.600	0.000	0.000	17.00	2.20	0.00	19.200	0.900	20.1	134.6	5.50	2,854
B		003	Peaked	top of sidewall	14.600	0.000	0.000	17.00	2.20	0.00	19.200	0.900	20.1	134.6	5.50	2,854
B		004	Peaked	top of sidewall	14.600	0.000	0.000	17.00	2.20	0.00	19.200	0.900	20.1	134.6	5.50	2,854

Exam Date: 10/20/2008
Examiner: 2

Cando Farmers Grain & Oil Cooperative, I
PO Box 456
Cando, ND
County:

Status	Section	Bin Number	Bin Type	Base Point	Diameter or Bu/Ft (Irreg.)	Length	Width	Side wall	Add for Hopper	Ded. for Obst.	Effective Depth	Add for Peak	Depth for Capac.	Bushels per Foot	Base Pack%	Bushel Capacity with Pack
--------	---------	------------	----------	------------	----------------------------	--------	-------	-----------	----------------	----------------	-----------------	--------------	------------------	------------------	------------	---------------------------

Facility: Cando

B	005		Peaked	top of sidewall	14.600	0.000	0.000	15.00	2.20	0.00	17.200	0.900	18.1	134.6	5.50	2,570
B	006		Peaked	top of sidewall	14.600	0.000	0.000	15.00	2.20	0.00	17.200	0.900	18.1	134.6	5.50	2,570
B	007		Peaked	top of sidewall	14.600	0.000	0.000	15.00	2.20	0.00	17.200	0.900	18.1	134.6	5.50	2,570

Bin count: 7

Facility: Cando Section: B Total: **19,126**

To Even: **20,000**

Section: C

C	001		Square	bin floor	0.000	9.500	3.500	52.00	0.00	0.00	52.000	0.000	52.0	26.7	2.50	1,423
C	002		Square	bin floor	0.000	9.500	6.000	52.00	0.00	0.00	52.000	0.000	52.0	45.8	4.00	2,477
C	003		Square	bin floor	0.000	7.500	2.500	30.00	0.00	0.00	30.000	0.000	30.0	15.1	2.00	462
C	005 T		Square	bin floor	0.000	9.500	6.000	52.00	0.00	0.00	52.000	0.000	52.0	45.8	4.00	2,477
C	005 B		Square	bin floor - top 52'	0.000	12.50	9.500	18.00	0.00	0.00	18.000	0.000	18.0	95.5	6.00	1,822
C	006		Square	bin floor	0.000	9.500	6.000	52.00	0.00	0.00	52.000	0.000	52.0	45.8	4.00	2,477
C	007 T		Square	bin floor	0.000	9.500	6.000	52.00	0.00	0.00	52.000	0.000	52.0	45.8	4.00	2,477
C	007 B		Square	bin floor - top 52'	0.000	12.50	9.500	18.00	0.00	0.00	18.000	0.000	18.0	95.5	6.00	1,822
C	008 T		Square	bin floor	0.000	9.500	6.000	52.00	0.00	0.00	52.000	0.000	52.0	45.8	4.00	2,477
C	008 B		Square	bin floor - top 52'	0.000	12.50	9.500	18.00	0.00	0.00	18.000	0.000	18.0	95.5	6.00	1,822
C	009		Square	bin floor	0.000	9.500	6.000	52.00	0.00	0.00	52.000	0.000	52.0	45.8	4.00	2,477
C	010		Square	bin floor	0.000	9.500	6.500	52.00	0.00	0.00	52.000	0.000	52.0	49.6	4.20	2,687
C	011		Square	bin floor	0.000	9.500	6.500	52.00	0.00	0.00	52.000	0.000	52.0	49.6	4.20	2,687

Exam Date: 10/20/2008
 Examiner: 2

Cando Farmers Grain & Oil Cooperative, I
 PO Box 456
 Cando, ND
 County:

Status	Section	Bin Number	Bin Type	Base Point	Diameter or Bu/Ft (Irreg):	Length	Width	Side wall	Add for Hopper	Ded. for Obst.	Effective Depth	Add for Peak	Depth for Capac.	Bushels per Foot	Base Pack%	Bushel Capacity with Pack
--------	---------	------------	----------	------------	----------------------------	--------	-------	-----------	----------------	----------------	-----------------	--------------	------------------	------------------	------------	---------------------------

Facility: Cando

Section: C

C		012	Square	bin floor	0.000	9.500	6.500	52.00	0.00	0.00	52.000	0.000	52.0	49.6	4.20	2,687
C		013 T	Square	bin floor	0.000	9.500	6.000	52.00	0.00	0.00	52.000	0.000	52.0	45.8	4.00	2,477
C		013 B	Square	bin floor- top 52'	0.000	12.50	9.500	18.00	0.00	0.00	18.000	0.000	18.0	95.5	6.00	1,822
C		013A	Square	bin floor	0.000	9.500	6.000	52.00	0.00	0.00	52.000	0.000	52.0	45.8	4.00	2,477
C		014	Square	bin floor	0.000	9.500	6.000	52.00	0.00	0.00	52.000	0.000	52.0	45.8	4.00	2,477
C		015	Square	bin floor	0.000	9.500	6.500	52.00	0.00	0.00	52.000	0.000	52.0	49.6	4.20	2,687
C		018 T	Square	bin floor	0.000	9.500	6.000	52.00	0.00	0.00	52.000	0.000	52.0	45.8	4.00	2,477
C		018 B	Square	bin floor- top 52'	0.000	12.50	9.500	18.00	0.00	0.00	18.000	0.000	18.0	95.5	6.00	1,822
C		019 T	Square	bin floor	0.000	9.500	6.000	52.00	0.00	0.00	52.000	0.000	52.0	45.8	4.00	2,477
C		019 B	Square	bin floor- top 52'	0.000	12.50	9.500	18.00	0.00	0.00	18.000	0.000	18.0	95.5	6.00	1,822
C		019A	Square	bin floor	0.000	9.500	6.000	52.00	0.00	0.00	52.000	0.000	52.0	45.8	4.00	2,477
C		020	Square	bin floor	0.000	9.500	3.500	52.00	0.00	0.00	52.000	0.000	52.0	26.7	2.50	1,423
C		101	Square	bin floor	0.000	11.00	9.500	43.00	0.00	0.00	43.000	0.000	43.0	84.0	5.80	3,821
C		102	Square	bin floor	0.000	11.00	9.500	43.00	0.00	0.00	43.000	0.000	43.0	84.0	5.80	3,821
C		104	Square	bin floor	0.000	9.500	5.500	17.00	0.00	0.00	17.000	0.000	17.0	42.0	3.50	739
C		105	Square	bin floor	0.000	9.500	5.500	17.00	0.00	0.00	17.000	0.000	17.0	42.0	3.50	739
C		106	Square	bin floor	0.000	11.00	9.500	43.00	0.00	0.00	43.000	0.000	43.0	84.0	5.80	3,821
C		108	Square	bin floor	0.000	11.00	9.500	43.00	0.00	0.00	43.000	0.000	43.0	84.0	5.80	3,821
C		109	Square	bin floor	0.000	11.00	9.500	43.00	0.00	0.00	43.000	0.000	43.0	84.0	5.80	3,821
C		110	Square	bin floor	0.000	9.500	5.500	30.00	0.00	0.00	30.000	0.000	30.0	42.0	3.50	1,304
C		111 U	Square	bin floor	0.000	9.500	5.500	11.00	0.00	0.00	11.000	0.000	11.0	42.0	3.50	478

Exam Date: 10/20/2008
 Examiner: 2

Cando Farmers Grain & Oil Cooperative, I
 PO Box 456
 Cando, ND
 County:

Status	Section	Bin Number	Bin Type	Base Point	Diameter or Bu/Ft (Irreg.)	Length	Width	Side wall	Add for Hopper	Ded. for Obst.	Effective Depth	Add for Peak	Depth for Capac.	Bushels per Foot	Base Pack%	Bushel Capacity with Pack
--------	---------	------------	----------	------------	----------------------------	--------	-------	-----------	----------------	----------------	-----------------	--------------	------------------	------------------	------------	---------------------------

Facility: Cando

Section: C

C	111 L	Square	bin floor -measure 1/2 way	0.000	9.500	5.500	11.00	0.00	0.00	11.000	0.000	11.0	42.0	3.50	478
C	112	Square	bin floor	0.000	11.00	9.500	43.00	0.00	0.00	43.000	0.000	43.0	84.0	5.80	3,821
C	113	Square	bin floor	0.000	9.500	5.500	31.00	0.00	0.00	31.000	0.000	31.0	42.0	3.50	1,348
C	201	Square	bin floor	0.000	14.30	10.50	59.50	0.00	0.00	59.500	0.000	59.5	120.7	6.50	7,649
C	202 T	Square	bin floor	0.000	15.00	10.50	53.00	0.00	0.00	53.000	0.000	53.0	126.6	6.50	7,146
C	202 B	Square	bin floor - top 53'	0.000	10.30	10.00	7.000	0.00	0.00	7.000	0.000	7.0	82.8	5.50	612
C	203	Square	bin floor	0.000	14.30	10.50	59.50	0.00	0.00	59.500	0.000	59.5	120.7	6.50	7,649
C	204 T	Square	bin floor	0.000	15.00	10.50	53.00	0.00	0.00	53.000	0.000	53.0	126.6	6.50	7,146
C	204 B	Square	bin floor - top 53'	0.000	10.50	10.00	7.000	0.00	0.00	7.000	0.000	7.0	84.4	5.80	625
C	205	Square	bin floor	0.000	14.30	10.50	59.50	0.00	0.00	59.500	0.000	59.5	120.7	6.50	7,649
C	206 T	Square	bin floor	0.000	15.00	10.50	53.00	0.00	0.00	53.000	0.000	53.0	126.6	6.50	7,146
C	206 B	Square	bin floor - top 53'	0.000	10.50	10.00	7.000	0.00	0.00	7.000	0.000	7.0	84.4	5.80	625
C	207	Square	bin floor	0.000	14.30	10.50	59.50	0.00	0.00	59.500	0.000	59.5	120.7	6.50	7,649
C	208 T	Square	bin floor	0.000	15.00	10.50	53.00	0.00	0.00	53.000	0.000	53.0	126.6	6.50	7,146
C	208 B	Square	bin floor - top 53'	0.000	10.50	10.00	7.000	0.00	0.00	7.000	0.000	7.0	84.4	5.80	625
C	209	Square	bin floor	0.000	14.30	10.50	59.50	0.00	0.00	59.500	0.000	59.5	120.7	6.50	7,649
C	210 T	Square	bin floor	0.000	15.00	10.50	53.00	0.00	0.00	53.000	0.000	53.0	126.6	6.50	7,146
C	210 B	Square	bin floor - top 53'	0.000	10.30	10.00	7.000	0.00	0.00	7.000	0.000	7.0	82.8	5.50	612

Bin count: 52

Facility: Cando Section: C Total: 159,798

To Even: 160,000

Exam Date: 10/20/2008
Examiner: 2

Cando Farmers Grain & Oil Cooperative, I
PO Box 456
Cando, ND
County:

Status	Section	Bin Number	Bin Type	Base Point	Diameter or Bu/Ft (Irreg):	Length	Width	Side wall	Add for Hopper	Ded. for Obst.	Effective Depth	Add for Peak	Depth for Capac.	Bushels per Foot	Base Pack%	Bushel Capacity with Pack
--------	---------	------------	----------	------------	----------------------------	--------	-------	-----------	----------------	----------------	-----------------	--------------	------------------	------------------	------------	---------------------------

Facility: Cando

<u>Section: D</u>																	
D		001	Quonset	se diagram		0.000	148.0	49.30	10.00	0.00	0.00	10.000	0.000	10.0	5700.1	10.0	62,702

Bin count: 1
 Facility: Cando Section: D Total: 62,702
 To Even: 63,000

<u>Section: E</u>																	
Added	E	001	Peaked	top of sidewall		47.900	0.000	0.000	31.80	0.00	0.00	31.800	2.900	34.7	1448.6	10.0	55,293
Added	E	002	Peaked	top of sidewall		47.900	0.000	0.000	31.80	0.00	0.00	31.800	2.900	34.7	1448.6	10.0	55,293

Bin count: 2
 Facility: Cando Section: E Total: 110,586
 To Even: 111,000

<u>Section: N</u>																	
N		001E	Peaked	top of sidewall Noodles tank		47.900	0.000	0.000	32.00	0.00	0.00	32.000	2.900	34.9	1448.6	10.0	55,612
N		002W	Peaked	top of sidewall Noodles tank		47.900	0.000	0.000	32.00	0.00	0.00	32.000	2.900	34.9	1448.6	10.0	55,612

Bin count: 2
 Facility: Cando Section: N Total: 111,224
 To Even: 112,000

Exam Date: 10/20/2008
 Examiner: 2

Cando Farmers Grain & Oil Cooperative, I
 PO Box 456
 Cando, ND
 County:

Status	Section	Bin Number	Bin Type	Base Point	Diameter or Bu/Ft (Irreg):	Length	Width	Side wall	Add for Hopper	Dec. for Obst.	Effective Depth	Add for Peak	Depth for Capac.	Bushels per Foot	Base Pack%	Bushel Capacity with Pack
--------	---------	------------	----------	------------	----------------------------	--------	-------	-----------	----------------	----------------	-----------------	--------------	------------------	------------------	------------	---------------------------

Facility: Egeland

Section: A-E

A-E	002		Square	bin floor	0.000	8.900	4.000	43.00	0.00	0.00	43.000	0.000	43.0	28.6	2.50	1,261
A-E	003		Square	bin floor	0.000	10.90	8.900	67.00	0.00	0.00	67.000	0.000	67.0	78.0	5.50	5,513
A-E	004		Square	bin floor	0.000	12.10	5.100	50.00	0.00	0.00	50.000	0.000	50.0	49.6	4.20	2,584
A-E	005 T		Square	bin floor	0.000	12.10	5.300	50.00	0.00	0.00	50.000	0.000	50.0	51.6	4.50	2,696
A-E	005 B		Square	bin floor	0.000	12.10	10.90	17.00	0.00	0.00	17.000	0.000	17.0	106.0	6.20	1,914
A-E	007		Square	bin floor	0.000	12.10	6.900	50.00	0.00	0.00	50.000	0.000	50.0	67.1	5.20	3,529
A-E	008 T		Square	bin floor	0.000	8.900	5.300	50.00	0.00	0.00	50.000	0.000	50.0	37.9	3.00	1,952
A-E	008 B		Square	bin floor	0.000	10.90	8.900	17.00	0.00	0.00	17.000	0.000	17.0	78.0	5.50	1,399
A-E	009		Square	bin floor	0.000	8.900	5.100	50.00	0.00	0.00	50.000	0.000	50.0	36.5	3.00	1,880
A-E	012 T		Square	bin floor	0.000	6.800	2.600	13.00	0.00	0.00	13.000	0.000	13.0	14.2	2.00	189
A-E	012 B		Square	bin floor-top 13'	0.000	8.900	6.800	37.00	0.00	0.00	37.000	0.000	37.0	48.6	4.20	1,874
A-E	013		Square	bin floor	0.000	8.900	6.800	50.00	0.00	0.00	50.000	0.000	50.0	48.6	4.20	2,532
A-E	014		Square	bin floor	0.000	8.900	5.100	50.00	0.00	0.00	50.000	0.000	50.0	36.5	3.00	1,880
A-E	015		Square	bin floor	0.000	8.900	5.300	50.00	0.00	0.00	50.000	0.000	50.0	37.9	3.00	1,952
A-E	015 B		Square	bin floor	0.000	10.90	8.900	17.00	0.00	0.00	17.000	0.000	17.0	78.0	5.50	1,399
A-E	017		Square	bin floor	0.000	12.10	5.100	50.00	0.00	0.00	50.000	0.000	50.0	49.6	4.20	2,584
A-E	018		Square	bin floor	0.000	12.10	5.100	50.00	0.00	0.00	50.000	0.000	50.0	49.6	4.20	2,584
A-E	019		Square	bin floor	0.000	12.10	6.800	50.00	0.00	0.00	50.000	0.000	50.0	66.1	5.00	3,470
A-E	020 U		Square	bin floor	0.000	10.90	8.900	43.00	0.00	0.00	43.000	0.000	43.0	78.0	5.50	3,538
A-E	020 L		Square	blind msre thru hole manlift	0.000	10.90	8.900	18.50	0.00	0.00	18.500	0.000	18.5	78.0	5.50	1,522
A-E	021		Square	bin floor	0.000	4.800	4.000	51.00	0.00	0.00	51.000	0.000	51.0	15.4	2.00	801

Exam Date: 10/20/2008
 Examiner: 2

Cando Farmers Grain & Oil Cooperative, I
 PO Box 456
 Cando, ND
 County:

Status	Section	Bin Number	Bin Type	Base Point	Diameter or Bu/Ft (Irreg):	Length	Width	Side wall	Add for Hopper	Det. for Obst.	Effective Depth	Add for Peak	Depth for Capac.	Bushels per Foot	Base Pack%	Bushel Capacity with Pack
--------	---------	------------	----------	------------	----------------------------	--------	-------	-----------	----------------	----------------	-----------------	--------------	------------------	------------------	------------	---------------------------

Facility: Egeland

Section: A-E

	A-E	022	Peaked	top of sidewall	26.700	0.000	0.000	66.00	0.00	0.00	66.000	1.600	67.6	450.1	8.20	32,922
	A-E	023	Peaked	top of sidewall	26.700	0.000	0.000	66.00	0.00	0.00	66.000	1.600	67.6	450.1	8.20	32,922
Added	A-E	024	Peaked	top of sidewall	59.700	0.000	0.000	57.50	0.00	0.00	57.500	4.200	61.7	2250.2	10.0	152,721


Bin count: 24
 Facility: Egeland Section: A-E Total: **265,618**
 To Even: **266,000**

Overall Licensed Bin Capacity for:
 Cando Farmers Grain & Oil Cooperative, I
 Bin count: 121

Licensed Capacity: _____ (includes pack)
Licensed Capacity (to even): **1,595,000 Bu.**
 (includes pack and section totals are rounded up to next highest 1000)

CANDO FARMERS GRAIN & OIL CO-OP INC.
 CANDO N.D.
 SECTION A


BNSF RAIL

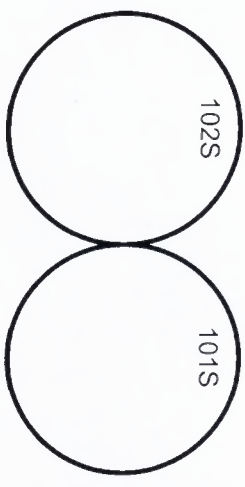


SECTION A

020	018	017	015	013	011
	019	021	016	012	009
			scale		
022	024	028	002	007	008
		XX	XX	05	006
025	026	027	003	04	
Office					

SECTION A

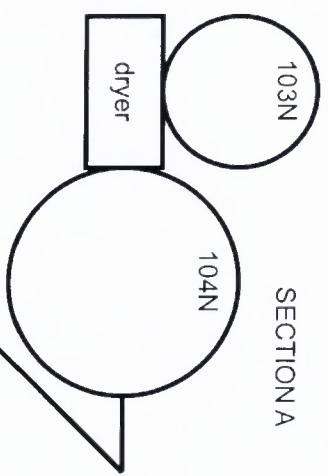

SECTION A

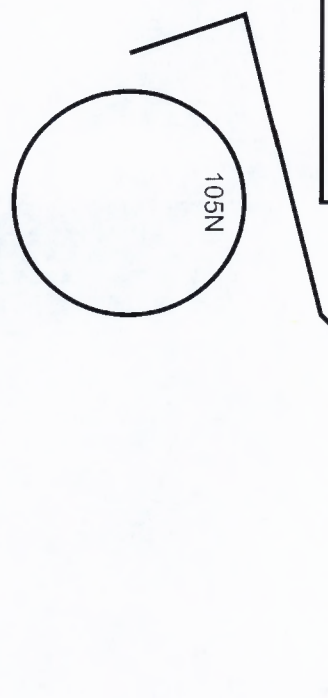

105N




Section B



Section N consists of two tanks at Noodles by Leonardo

CANDO FARMERS GRAIN & OIL CO-OP INC.
CANDO N.D.
SECTION A

BNSF RAIL

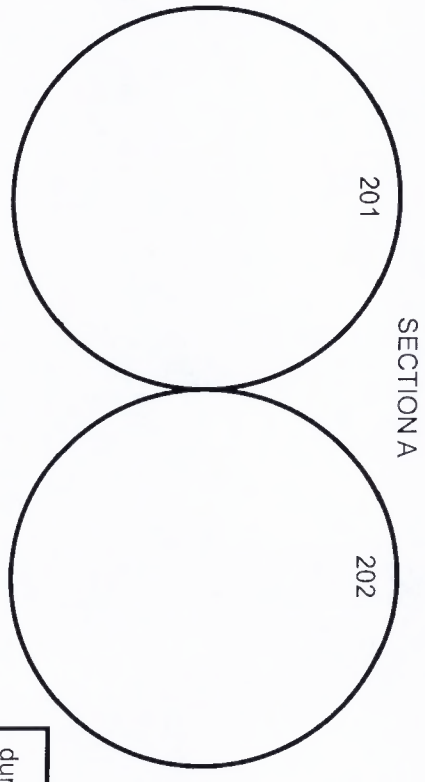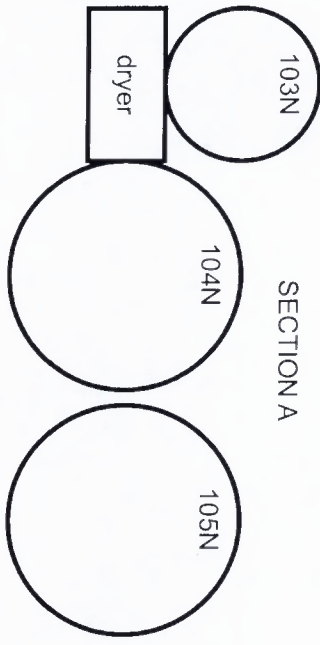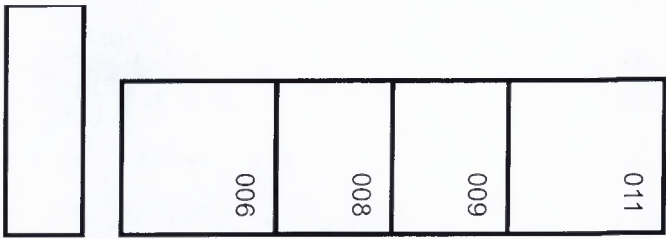


new construction
77.5' diameter - 55' sidewall



XX
XX
Section E - 2 blocks
north

SECTION E
2 blocks north of Section A

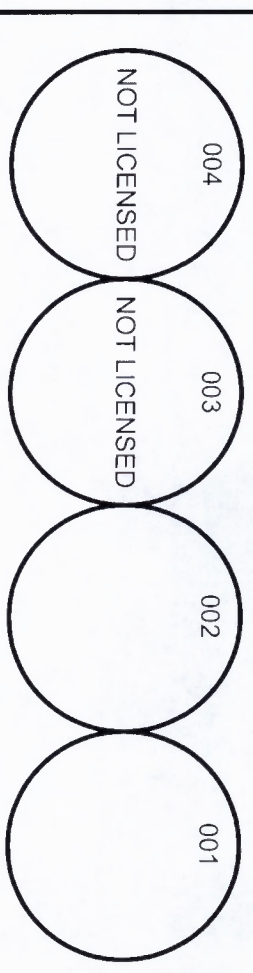

CANDO FARMERS GRAIN & OIL COOPERATIVE INC.

EGELAND Location

Section A-E

Northern Plains Rail




008	009	012	013	014	015
005	004	007	019	018	017
003	002	XX	021	020L	020U
		scale			

driveway & scale

Offfice

SECTION A-E



Note- measure 20L thru hole in manlift well 19.5' above floor

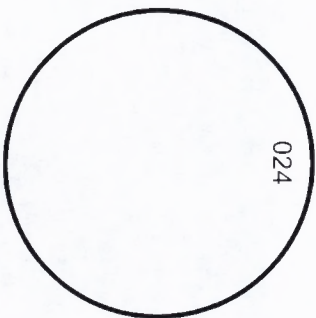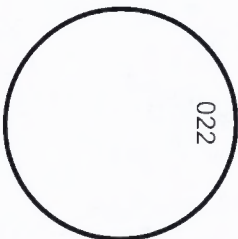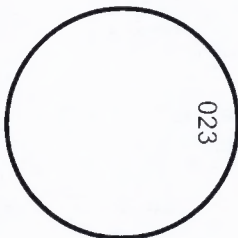

new construction
59.7' diameter
sidewall ht. of 57.5'
(58.75' sidewall less 15" aeration floor)

CANDO FARMERS GRAIN & OIL CO-OP INC.
 CANDO N.D.
 SECTION C

BNSF RAIL

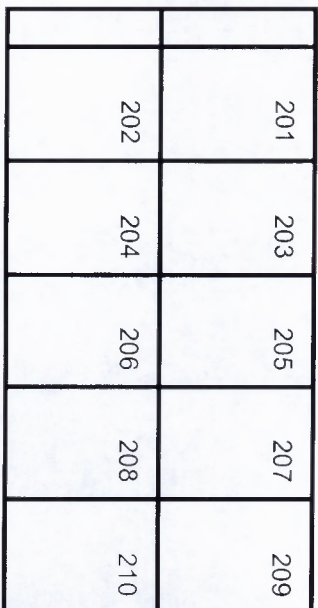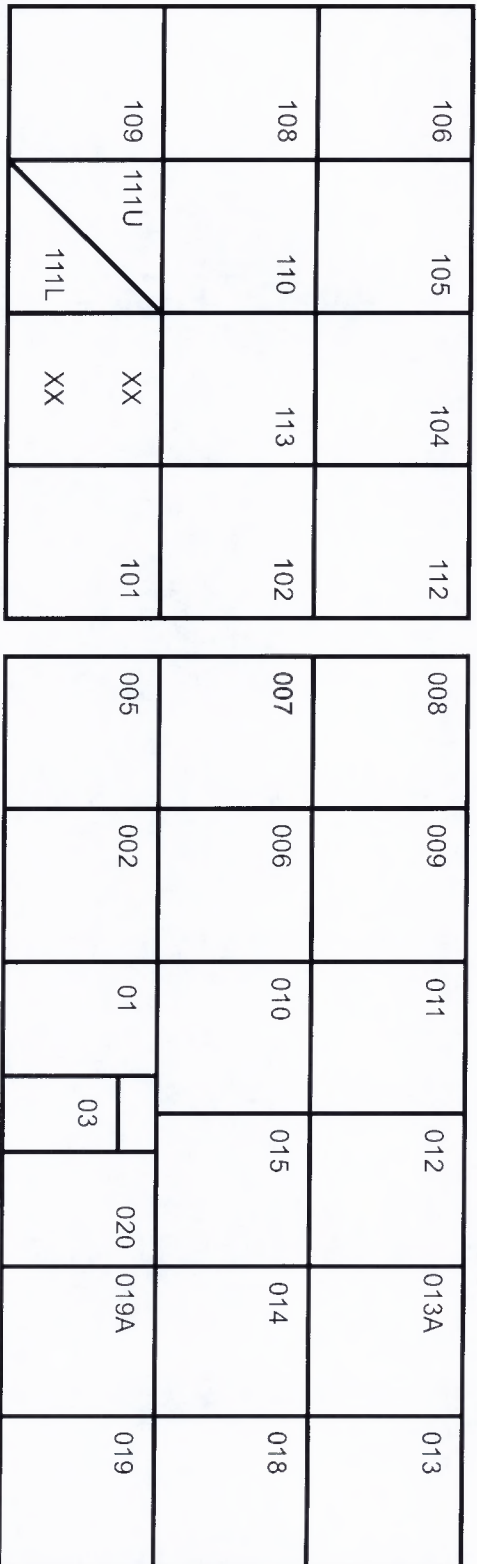


bin 111L -measure 1/2 way up man lift well

CANDO FARMERS GRAIN & OIL COOP INC.

CANDO ND

Section D

quonset 001

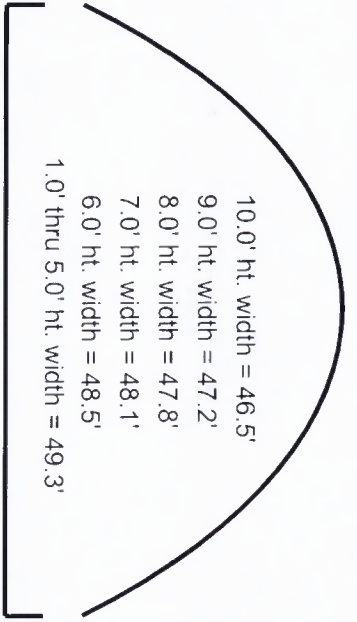

Basic Dimensions

base 148.0' L x 49.3' W

foundation ht. 3.0'

east side straight wall top to floor = 11.5'

1.0' ht. thru 5.0' ht. same width = 49.3'

center of overhead ceiling to floor 23.0'

bottom center drag auger to floor 18.5'

west side wall bulge in insulation - 11.5' to floor

