



ST. HILAIRE SEED COMPANY, INC.

PO BOX 85

ST. HILAIRE, MN 56754

PH. 218-964-5407 FAX 218-964-5415

FACSIMILE TRANSMITTAL SHEET

TO: Sue/Tim	FROM: Beth Sisler
COMPANY: Public Service Commission	DATE: NOVEMBER 4, 2008
FAX NUMBER: 701-328-2410	TOTAL NO. OF PAGES INCLUDING COVER:
PHONE NUMBER: 701-328-4097	RE: Cummins Ag

URGENT FOR REVIEW PLEASE COMMENT PLEASE REPLY PLEASE RECYCLE

NOTES/COMMENTS: ©

In regards to the Bean Storage at Cummings Ag :

We have reviewed the information you provided and we agree to the addition of two tanks at the Cummings Ag location.

Thank you;

Sincerely,

Craig Anderson

The documents contained within this fax transmission contain confidential information which is legally privileged. The information is intended for use by the addressed recipient named above. If you are not the intended recipient, you are hereby notified that any disclosure, copying, distribution or unauthorized acquisition in reliance on the contents of this fax transmission except its direct delivery to the intended recipient is strictly prohibited. If you have received the fax in error, please notify us immediately at the telephone number listed above. Thank you.

17 GE-08-329 Filed: 11/4/2008 Pages: 4
Request - Capacity Increase at Cummings (Two Tanks)

St. Hilaire Seed Company, Inc.

Craig Anderson

10/27/2008 13:35 7013282410

NDPSC

PAGE 02/04

Client ID: 2943

NDPSC Statement of Capacities

10/27/2008 01:58:45 PM

Exam Date: 08/13/2008

St. Hilaire Seed Company, Inc.

Page: 1

Examiner: 1

PO Box 85
St. Hilaire, MN
County:
Phone: 218-964-5407
CCC Number:

Location/Container Numbers/Comments	Section	Capacity
PART A - ADDITIONAL SPACE TO BE INCLUDED UNDER LICENSE		
101	G3 Grafton	8,900
102	G3	8,900
006-B	Z3 Cummings Ag Section B-006	32,676
210	Z3 section A	32,676
Total:		83,152

PART B - SPACE TO BE DELETED UNDER LICENSE

202	C	4,787
203	C	4,787
204	C	4,787
303	C	31,577
304	C	31,577
305	C	31,577
Total:		109,092

PART C - ALL SPACE TO BE INCLUDED UNDER LICENSE

B	99,000	
C	277,000	
D	170,000	
G	18,000	
Z	86,000	
Total:		630,000


PART D - TOTAL CAPACITY BY FUNCTIONAL UNIT

Crystal 1151	D	170,000
Cummings Ag 2000	Z	86,000
Garske 1152	C	277,000
Grafton 1000	G	18,000
Hamilton 1133	B	99,000
Total:		630,000

Sue

OCTOBER 22, 2008


CUMMINGS AG INC.
CUMMINGS N.D.

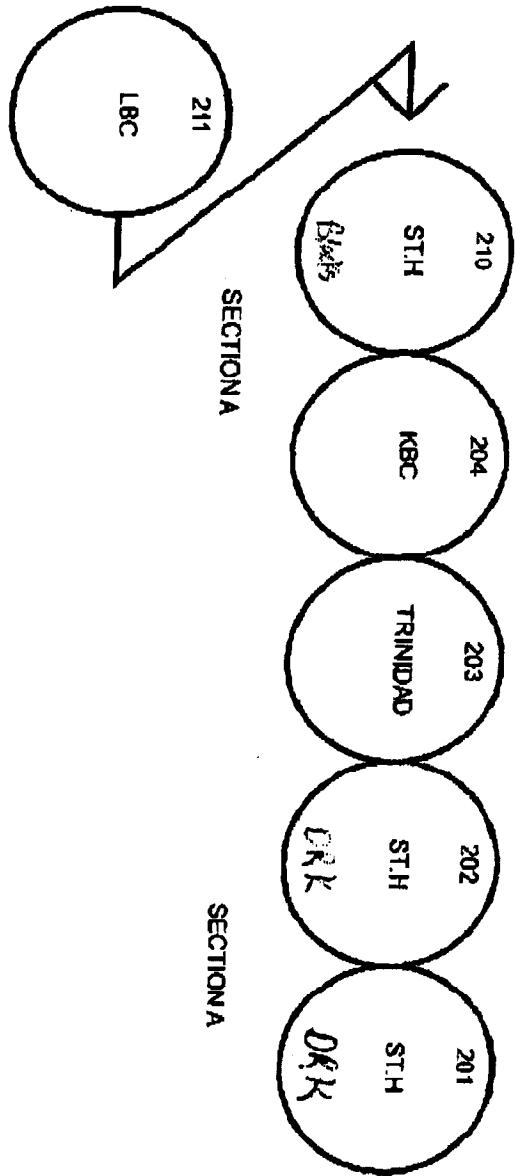

SECTION A


SECTION A

SECTION A

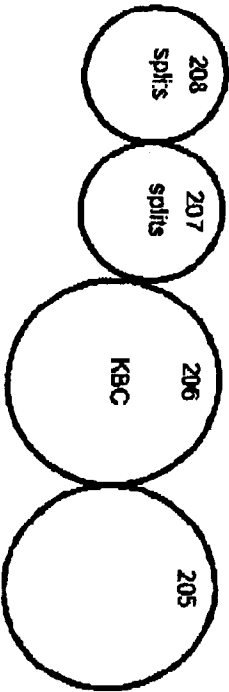

SECTION A

Mailing address
Cummings Ag Inc.
P.O. Box 152
Burton N.D. 58218

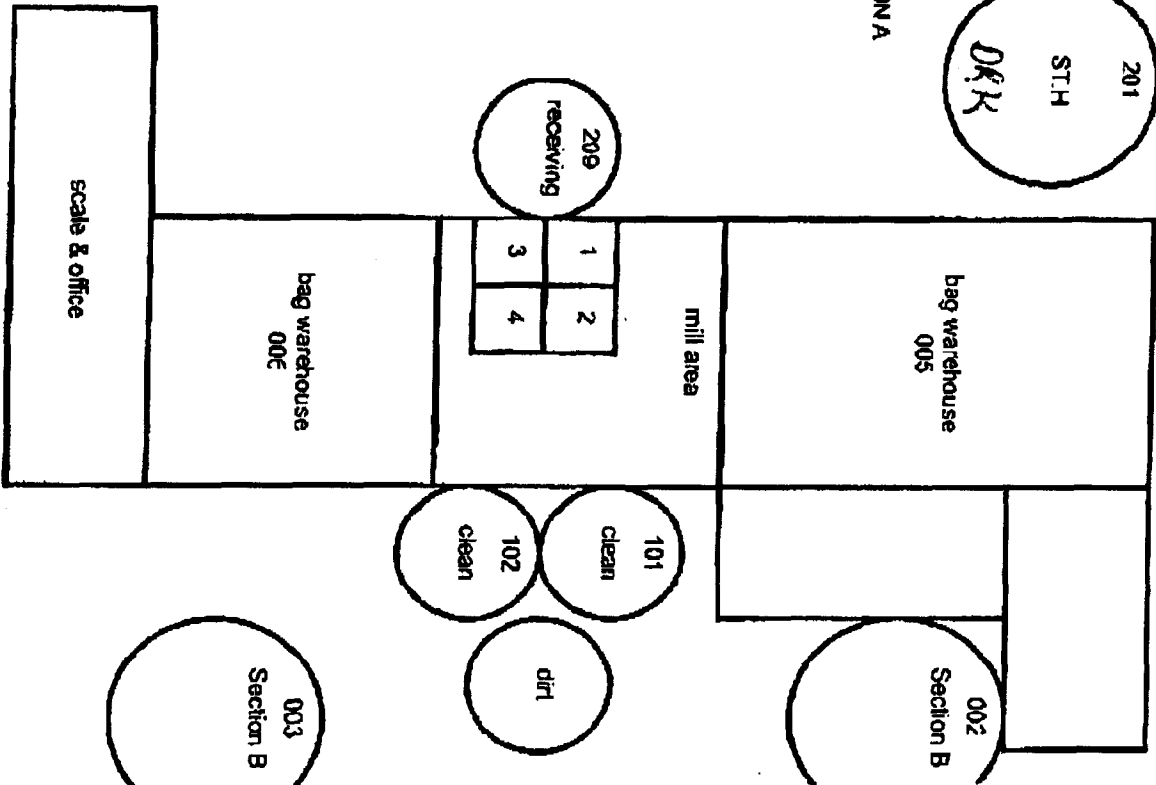



10/27/2008 13:35

7013202410

NDPSC




PAGE 04/04

OCTOBER 22 2008

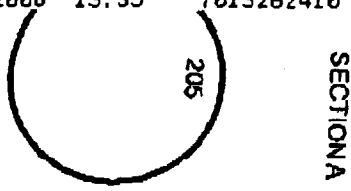
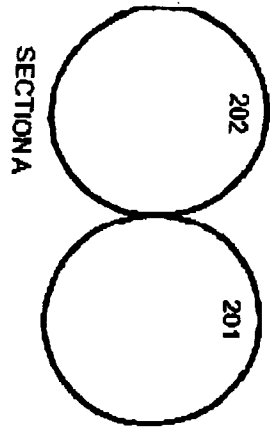


SECTION A

CUMMINGS AG INC.
CUMMINGS N.D.

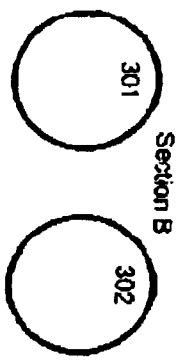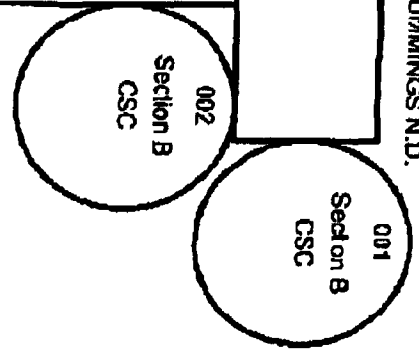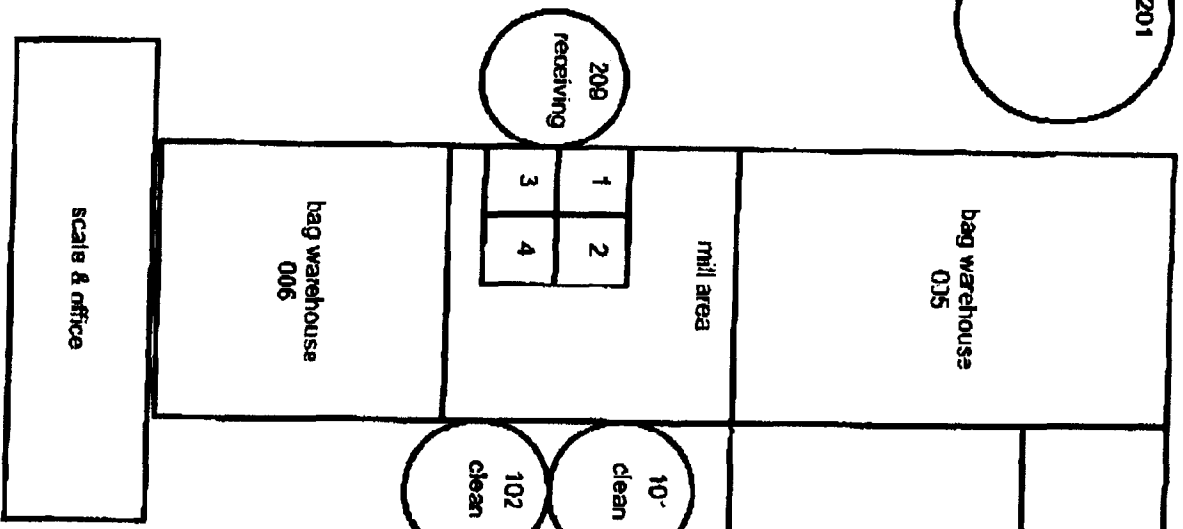

floating hoppers

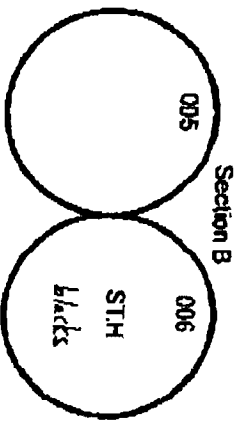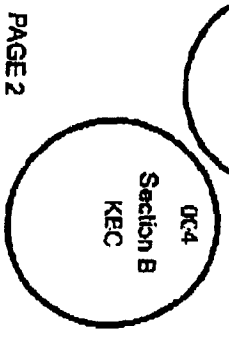

Mailing address
 Cummings Ag Inc.
 P.O. Box 152
 Euxton N.D. 58218

PAGE 2