

Licensing Division
600 E Boulevard Ave – Dept 408
Bismarck, ND 58505-0480
701/328-4103 – phone
701/328-2410 – fax

Public Service Commission

Fax

To: Tom Grabanski- Grabanski Grain LLC **From:** Timothy Erdmann

Fax: 701-352-0121 **Pages:** 4

Phone: 701-360-0088 **Date:** 09-03-08

Re: New construction at Licensed warehouse site

Urgent **For Review** **Please Comment** **Please Reply** **Please Recycle**

● **Comments:** Last week I stopped at your grain storage site at Grafton to measure the St. Hilaire Seed receiving tanks and took the time to measure your new bin construction. I have included a statement of capacity, bin chart, and diagram of the site including all tanks. The new tanks will have to be included in your licensed capacity if connected by overhead conveyors from the existing facility. If new construction stands alone and filled by portable auger or conveyor preventing mixing of your farm grain versus your customers' grain it may be exempt from licensing. Total capacity of the facility is 439,000 bushels requiring a bond of \$225,000 versus the existing bond of \$137,500. Please inform the Licensing Office of your intentions regarding the new construction.

Thank you,

5 **GE-08-397** Filed: 9/3/2008 Pages: 4
**Fax Including Statement of Capacities, Bin Charts,
and Bin Diagrams**

Public Service Commission

Exam Date:09/02/2008

Grabanski Grain , LLC
223 W 17th St.
Grafton , ND
County: Walsh
Phone: 701-360-0088
CCC Number:

Page: 1

Examiner: 2

Location/Container Numbers/Comments	Section	Capacity
PART A - ADDITIONAL SPACE TO BE INCLUDED UNDER LICENSE		
001	A	54,743
002	A	54,743
003	A	54,743
004	A	54,743
005	A	54,743
006	A	54,743
007	A } <i>New construction</i>	54,975
008	A }	54,743
		Total: 438,176

PART B - SPACE TO BE DELETED UNDER LICENSE

<NO BINS DELETED>

Total: 0

PART C - ALL SPACE TO BE INCLUDED UNDER LICENSE

A	439,000
Total: 439,000	

PART D - TOTAL CAPACITY BY FUNCTIONAL UNIT

Grafton 1191	A	439,000
		Total: 439,000

current Bond \$ 137,500 = 275,000 bushels

required Bond To License New construction \$ 225,000 439,000 bushels or a maximum of 450,000 bushels

Exam Date:09/02/2008
 Examiner: 2

Grabanski Grain , LLC
 223 W 17th St.
 Grafton , ND
 County: Walsh

Status	Section	Bin Number	Bin Type	Base Point	Diameter or Bu/Ft (Irrig.)	Length	Width	Side wall	Add for Hopper	Ded. for Obst.	Effective Depth	Add for Peak	Depth for Capac.	Bushels per Foot	Base Pack%	Bushel Capacity with Pack
--------	---------	------------	----------	------------	----------------------------	--------	-------	-----------	----------------	----------------	-----------------	--------------	------------------	------------------	------------	---------------------------

Facility: Grafton


Section: A

Added	A	001	Peaked		47.800	0.000	0.000	31.60	0.00	0.00	31.600	2.900	34.5	1442.5	10.0	54,743
Added	A	002	Peaked		47.800	0.000	0.000	31.60	0.00	0.00	31.600	2.900	34.5	1442.5	10.0	54,743
Added	A	003	Peaked		47.800	0.000	0.000	31.60	0.00	0.00	31.600	2.900	34.5	1442.5	10.0	54,743
Added	A	004	Peaked		47.800	0.000	0.000	31.60	0.00	0.00	31.600	2.900	34.5	1442.5	10.0	54,743
Added	A	005	Peaked		47.800	0.000	0.000	31.60	0.00	0.00	31.600	2.900	34.5	1442.5	10.0	54,743
Added	A	006	Peaked		47.800	0.000	0.000	31.60	0.00	0.00	31.600	2.900	34.5	1442.5	10.0	54,743
Added	A	007	Peaked		47.900	0.000	0.000	31.60	0.00	0.00	31.600	2.900	34.5	1448.6	10.0	54,975
Added	A	008	Peaked		47.800	0.000	0.000	31.60	0.00	0.00	31.600	2.900	34.5	1442.5	10.0	54,743
Bin count: 8															438,176	
Facility: Grafton Section: A Total:															438,176	
To Even:															439,000	

<u>Overall Licensed Bin Capacity for:</u>	
Grabanski Grain , LLC	438,176 Bu.
Bin count: 8	
Licensed Capacity (to even):	
(includes pack and section totals are rounded up to next highest 1000)	439,000 Bu.

GRABRANSKI GRAIN LLC
GRAFTON ND

located west of Grafton south of John Deere dealership

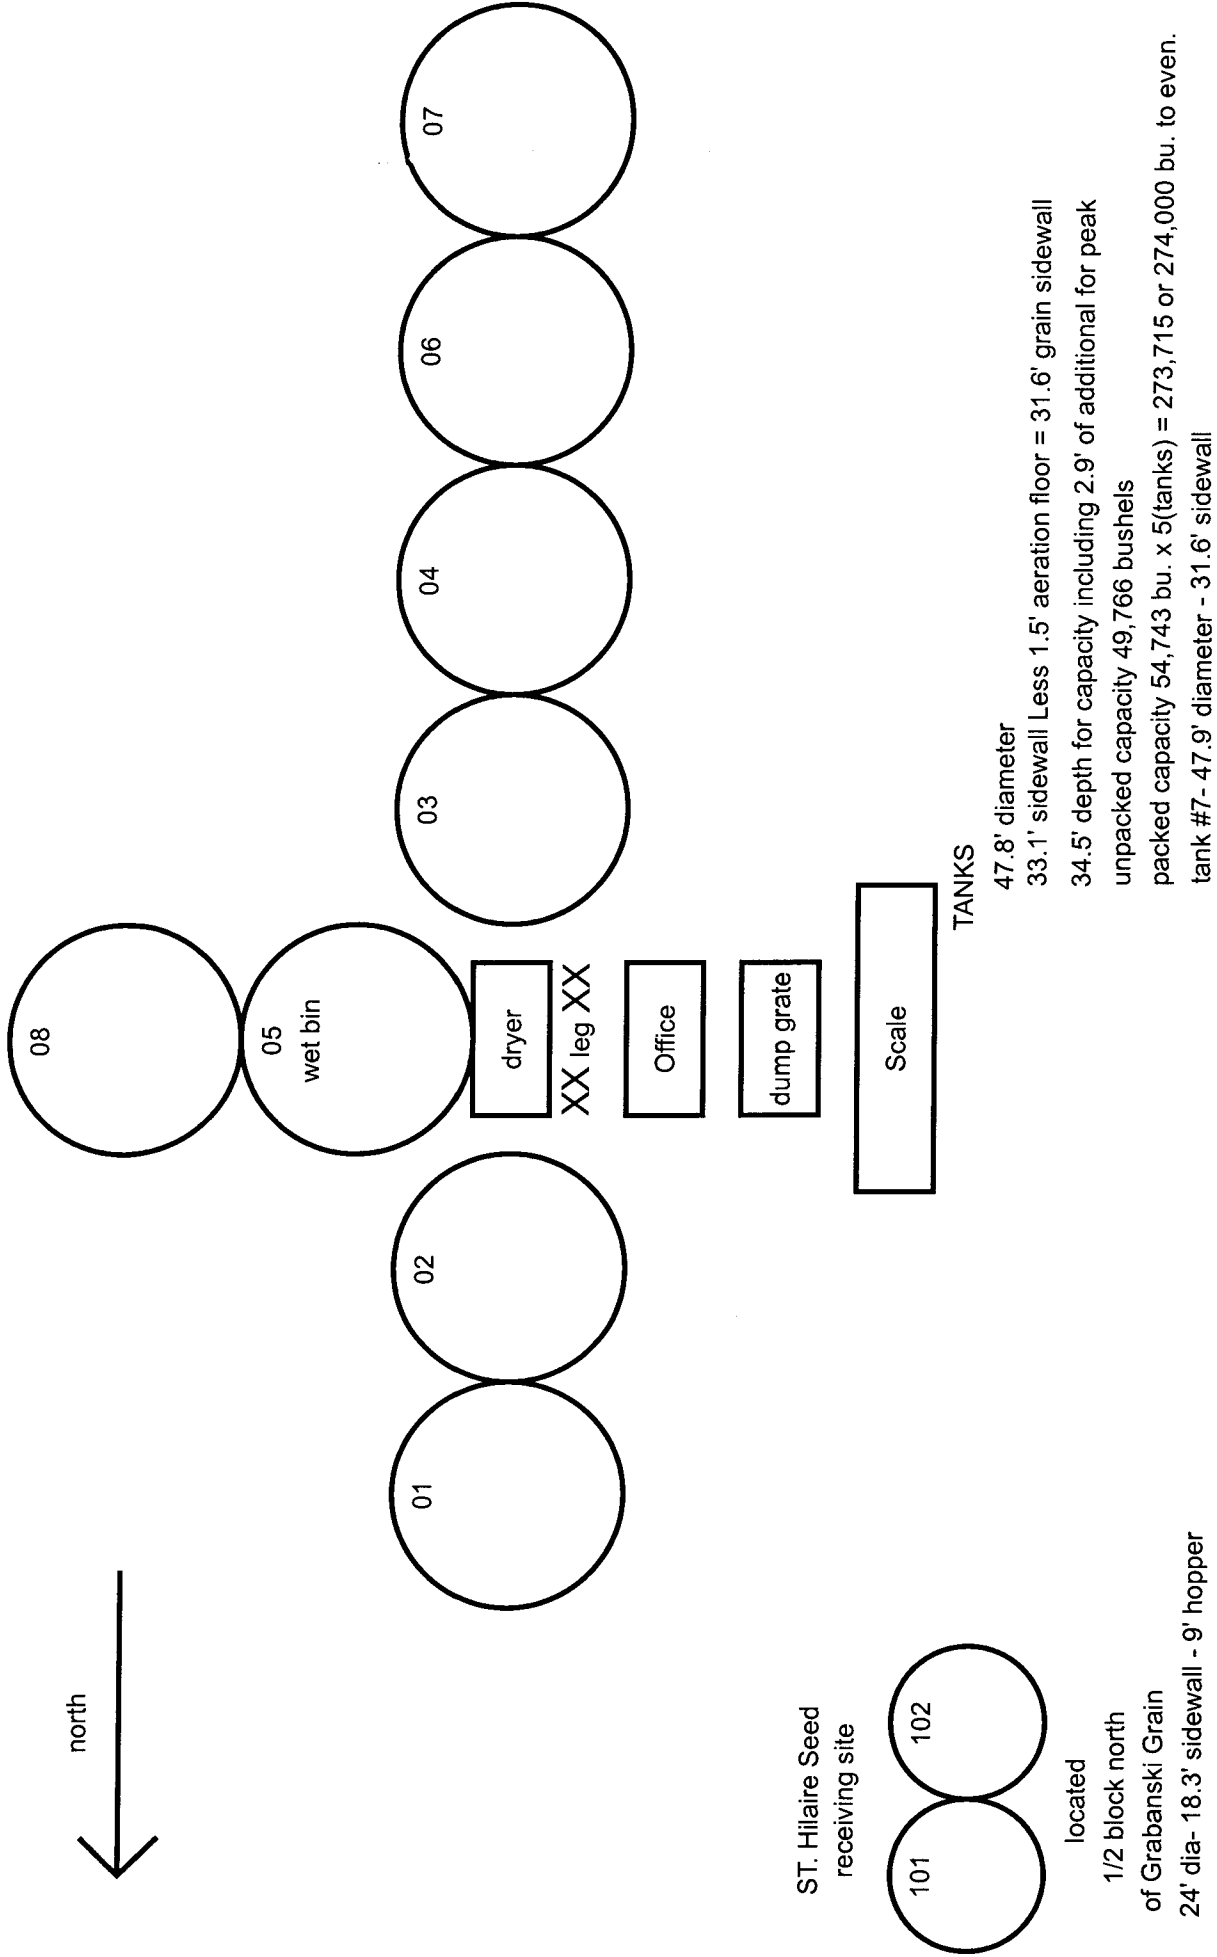

north

08

05

wet bin

dryer

XX leg XX

Office

dump grate

Scale

TANKS

47.8' diameter

33.1' sidewall Less 1.5' aeration floor = 31.6' grain sidewall

34.5' depth for capacity including 2.9' of additional for peak
unpacked capacity 49,766 bushels

packed capacity 54,743 bu. x 5(tanks) = 273,715 or 274,000 bu. to even.
tank #7- 47.9' diameter - 31.6' sidewall

01

02

04

03

06

07

ST. Hilaire Seed
receiving site

101

102

located

1/2 block north

of Grabanski Grain

24' dia- 18.3' sidewall - 9' hopper