


SEE DRAWING
534-P-04013
FOR PIPING DETAILS
(TANK CONNECTIONS)

SEE DRAWING
534-P-04014
FOR PIPING DETAILS
(TANK PIPELINES)

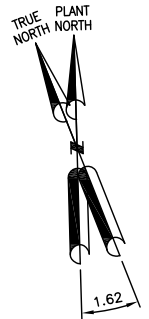


1	ISSUED FOR AS-BUILT	2/26/10	JRW	ADJ
NO	REVISION	DATE	APPR	BY

ENBRIDGE PIPELINES (NORTH DAKOTA) LLC

BEAVER LODGE STATION
PLOT PLAN

PROJECT: ENBRIDGE - 2534-04		
SCALE: N.T.S.	DATE: 5/30/08	DRAWN: ADJ
CHECK:	APPR:	DATE:

DWG. NO. 534-P-04001

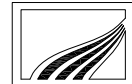
Rooney Engineering, Inc.
12201 E. Arapahoe Rd.
Centennial, CO 80112
(303) 792-5911