



J-SONS INC., CONTRACTORS


1100 Industrial Drive ● Bismarck, ND 58501 ● Phone (701) 224-1164 ● FAX (701) 258-5684

EMAIL jsonsinc@jsonsinc.com ● WEBSITE www.jsonsinc.com

- BUILDING IN CONCRETE, WOOD OR STEEL
- FERTILIZER PLANTS
- GRAIN ELEVATORS
- FEED MILLS

October 24, 2008

Public Service Commission
Attention: Executive Secretary
600 E Boulevard Ave Dept 408
Bismarck, ND 58505-0480

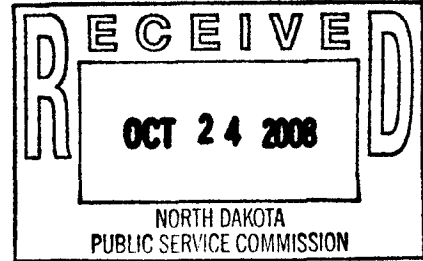

RE: Ray Farmers Union Elevator Rail Clearance Variance

Dear Executive Secretary,


Enclosed please find Section Drawing and Bulk Weigher Site Plan Drawing G-4 for explanation of infringement into the rail clearance at the Ray Farmers Union Elevator in Ray, ND. We are requesting a 3 ¾ inch rail variance infringement.

Sincerely,


Mike LaBere,
Vice President,
J-Sons Inc.

MLL/srd
Enclosures

RECEIVED
OCT 24 2008
NORTH DAKOTA
PUBLIC SERVICE COMMISSION

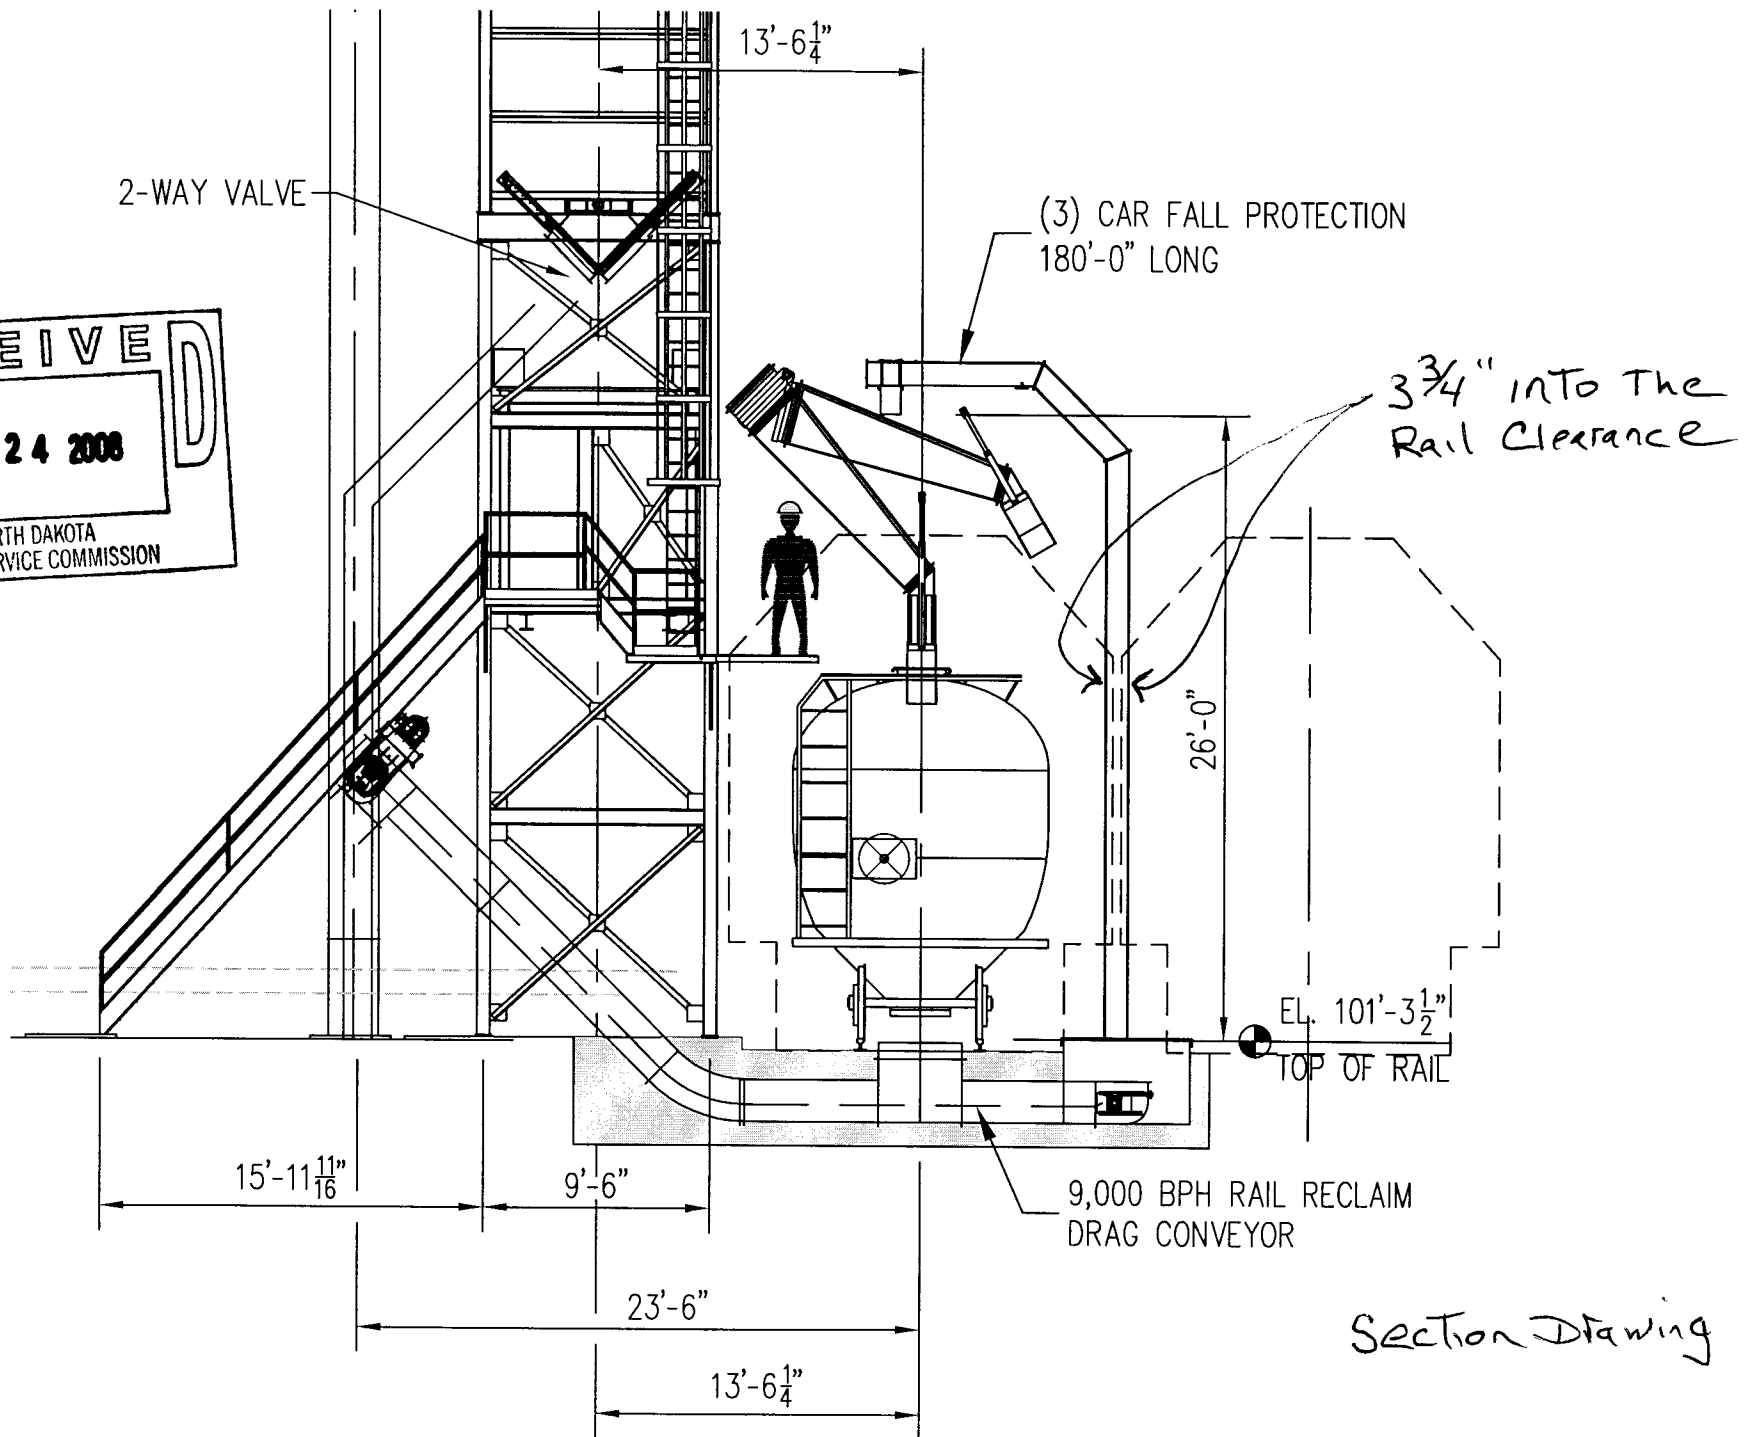

Section Drawing

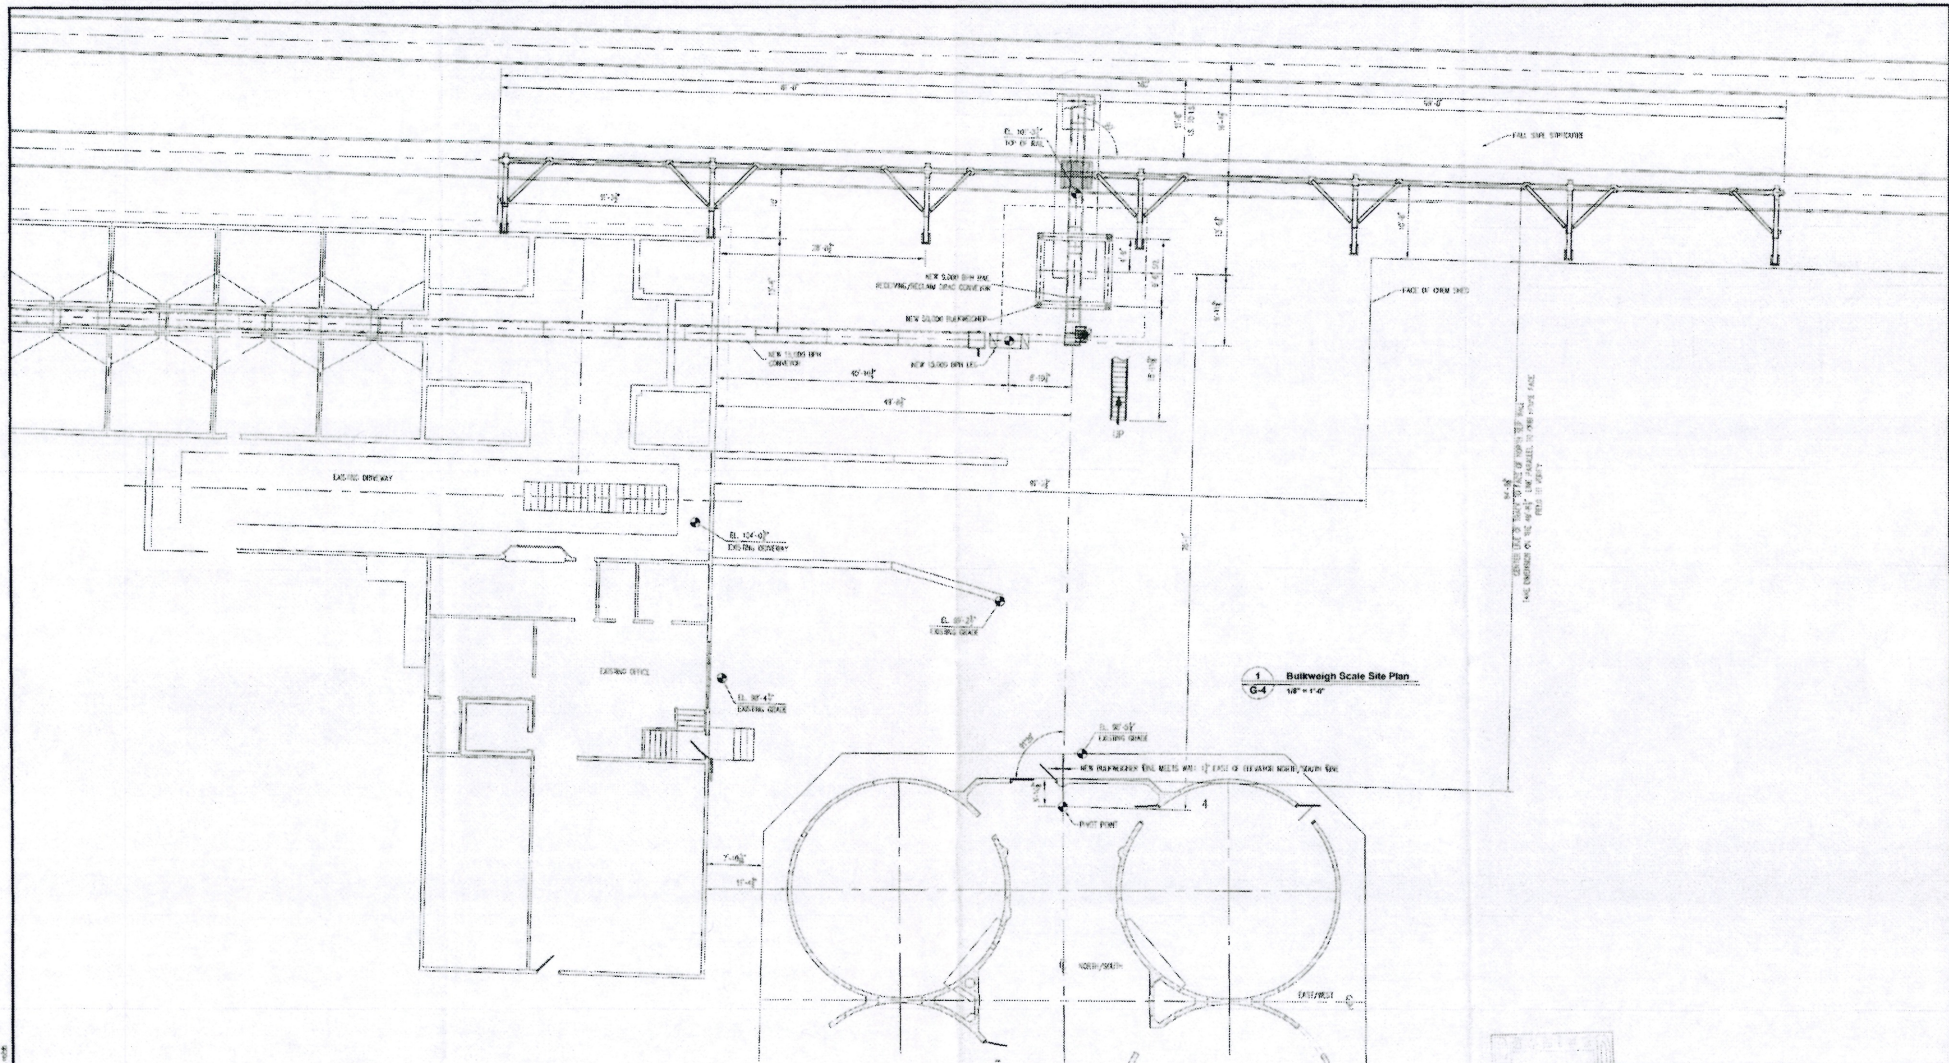

1 Bulkweigh Scale Site Plan
1/8" = 1'-0"

NOT FOR CONSTRUCTION


		Farmers Union Elevator Ray, North Dakota	
Bulk Weigher Site Plan		08-102	

