

Exam Date: 11/13/2008

Country Grain Cooperative, Inc.

Page: 1

Examiner: 1

Route 3 Box 84

Jamestown, ND

County:

Phone: 701-763-6147

CCC Number:

Location/Container Numbers/Comments	Section	Capacity
PART A - ADDITIONAL SPACE TO BE INCLUDED UNDER LICENSE		
ground	G	319,727
209	A	331,488
106 T	B	3,019
108 T	B	3,989
ground	C	299,609
		Total:
		957,832

PART B - SPACE TO BE DELETED UNDER LICENSE

106 M	B	1,024
106B	B	1,515
108 B	B	1,530
		Total:
		4,069

PART C - ALL SPACE TO BE INCLUDED UNDER LICENSE

A	1,174,000
B	740,000
C	300,000
E	140,000
F	47,000
G	320,000
Total:	
2,721,000	

PART D - TOTAL CAPACITY BY FUNCTIONAL UNIT

Cleveland 133	B C	1,040,000
Eldridge 142	A G	1,494,000
Windsor 134	E F	187,000
Total:		2,721,000

Exam Date: 11/13/2008

Country Grain Cooperative, Inc.

Page: 1

Examiner: 1

Route 3 Box 84
Jamestown, ND

County:

Status	Section	Bin Number	Bin Type	Base Point	Diameter or Bu/Ft (Irreg.)	Length	Width	Side wall	Add for Hopper	Ded. for Obst.	Effective Depth	Add for Peak Capac.	Depth for	Bushels per Foot	Base Pack%	Bushel Capacity with Pack
--------	---------	------------	----------	------------	----------------------------	--------	-------	-----------	----------------	----------------	-----------------	---------------------	-----------	------------------	------------	---------------------------

Facility: Cleveland

Section: B

B	001		Square	work floor	0.000	10.00	3.500	42.00	0.00	0.00	42.000	0.000	42.0	28.1	2.50	1,210
B	002		Square	work floor	0.000	6.000	4.000	42.00	0.00	0.00	42.000	0.000	42.0	19.3	2.00	827
B	003		Square	work floor	0.000	5.000	3.300	36.00	0.00	0.00	36.000	0.000	36.0	13.3	2.00	489
B	004 T		Square	work floor	0.000	6.500	6.000	13.00	0.00	0.00	13.000	0.000	13.0	31.4	2.50	418
B	004 B		Square	work floor -TOP 13'	0.000	10.00	6.000	25.00	0.00	0.00	25.000	0.000	25.0	48.2	4.20	1,256
B	005		Square	work floor	0.000	5.000	3.300	36.00	0.00	0.00	36.000	0.000	36.0	13.3	2.00	489
B	006 T		Square	work floor	0.000	10.00	4.500	38.00	0.00	0.00	38.000	0.000	38.0	36.2	3.00	1,417
B	006 B		Square	work floor -top 38'	0.000	11.00	10.00	19.00	0.00	0.00	19.000	0.000	19.0	88.4	5.80	1,777
B	007		Square	work floor	0.000	5.000	3.300	36.00	0.00	0.00	36.000	0.000	36.0	13.3	2.00	489
B	008		Square	work floor	0.000	8.500	6.500	42.00	0.00	0.00	42.000	0.000	42.0	44.4	3.50	1,930
B	009		Square	work floor	0.000	11.00	4.500	36.00	0.00	0.00	36.000	0.000	36.0	39.8	3.00	1,476
B	010		Square	work floor	0.000	10.00	6.000	40.00	0.00	0.00	40.000	0.000	40.0	48.2	4.20	2,009
B	011		Square	work floor	0.000	10.00	6.500	42.00	0.00	0.00	42.000	0.000	42.0	52.3	4.50	2,296
B	012 T		Square	work floor	0.000	10.00	4.500	40.00	0.00	0.00	40.000	0.000	40.0	36.2	3.00	1,491
B	012 B		Square	work floor -top 40'	0.000	11.00	10.00	17.00	0.00	0.00	17.000	0.000	17.0	88.4	5.80	1,590
B	013		Square	work floor	0.000	10.00	6.000	40.00	0.00	0.00	40.000	0.000	40.0	48.2	4.20	2,009
B	014 T		Square	work floor	0.000	10.00	4.500	38.00	0.00	0.00	38.000	0.000	38.0	36.2	3.00	1,417
B	014 B		Square	work floor -top 38'	0.000	11.00	10.00	19.00	0.00	0.00	19.000	0.000	19.0	88.4	5.80	1,777
B	015 T		Square	work floor	0.000	10.00	4.500	40.00	0.00	0.00	40.000	0.000	40.0	36.2	3.00	1,491
B	015 B		Square	work floor -top 40'	0.000	11.00	10.00	17.00	0.00	0.00	17.000	0.000	17.0	88.4	5.80	1,590
B	016		Square	work floor	0.000	10.00	6.000	38.00	0.00	0.00	38.000	0.000	38.0	48.2	4.20	1,909

Exam Date: 11/13/2008

Country Grain Cooperative, Inc.

Page: 2

Examiner: 1

Route 3 Box 84
Jamestown, ND

County:

Status	Section	Bin Number	Bin Type	Base Point	Diameter or Bu/Ft (Irreg.)	Length	Width	Side wall	Add for Hopper	Ded. for Obst.	Effective Depth	Add for Peak	Depth for Capac.	Bushels per Foot	Base Pack%	Bushel Capacity with Pack
--------	---------	------------	----------	------------	-------------------------------	--------	-------	--------------	----------------------	----------------------	--------------------	--------------------	------------------------	------------------------	---------------	------------------------------

Facility: Cleveland

Section: B

B	017 T		Square	work floor	0.000	10.00	4.500	38.00	0.00	0.00	38.000	0.000	38.0	36.2	3.00	1,417
B	017 B		Square	work floor -top 38'	0.000	11.00	10.00	19.00	0.00	0.00	19.000	0.000	19.0	88.4	5.80	1,777
B	018		Square	work floor	0.000	10.00	6.500	40.00	0.00	0.00	40.000	0.000	40.0	52.3	4.50	2,186
B	019		Square	work floor	0.000	10.00	6.000	38.00	0.00	0.00	38.000	0.000	38.0	48.2	4.20	1,909
B	020		Square	work floor	0.000	10.00	6.500	40.00	0.00	0.00	40.000	0.000	40.0	52.3	4.50	2,186
B	0CB		Square	work floor	0.000	6.000	3.000	13.00	0.00	0.00	13.000	0.000	13.0	14.5	2.00	193
B	101 T		Square	work floor	0.000	11.50	11.00	54.00	0.00	0.00	54.000	0.000	54.0	101.7	6.00	5,822
B	101 B		Square	work floor -top 54'	0.000	14.00	11.50	11.00	0.00	0.00	11.000	0.000	11.0	129.4	6.50	1,515
B	102		Square	work floor	0.000	11.50	10.50	54.00	0.00	0.00	54.000	0.000	54.0	97.1	6.00	5,558
B	103 T		Square	work floor	0.000	11.50	11.00	54.00	0.00	0.00	54.000	0.000	54.0	101.7	6.00	5,822
B	103 B		Square	work floor -top 54'	0.000	14.00	11.50	11.00	0.00	0.00	11.000	0.000	11.0	129.4	6.50	1,515
B	104 T		Square	work floor	0.000	11.50	11.00	54.00	0.00	0.00	54.000	0.000	54.0	101.7	6.00	5,822
B	104 B		Square	work floor - top 54'	0.000	14.00	11.50	11.00	0.00	0.00	11.000	0.000	11.0	129.4	6.50	1,515
B	105		Square	work floor	0.000	11.50	10.50	54.00	0.00	0.00	54.000	0.000	54.0	97.1	6.00	5,558
Added	B	106 T	Irregular	work floor need actual	101.70	11.25	11.25	28.00	0.00	0.00	28.000	0.000	28.0	101.7	6.00	3,019
	B	107 T	Square	work floor	0.000	11.50	11.00	54.00	0.00	0.00	54.000	0.000	54.0	101.7	6.00	5,822
	B	107 B	Square	work floor -top 54'	0.000	14.00	11.50	11.00	0.00	0.00	11.000	0.000	11.0	129.4	6.50	1,515
Added	B	108 T	Square	work floor -need an actual	104.50	11.50	11.00	37.00	0.00	0.00	37.000	0.000	37.0	101.7	6.00	3,989
	B	109	Square	work floor	0.000	11.50	10.50	54.00	0.00	0.00	54.000	0.000	54.0	97.1	6.00	5,558
	B	111	Peaked	top of sidewall	37.100	0.000	0.000	60.60	0.00	0.00	60.600	2.200	62.8	869.0	10.0	60,030
	B	112	Peaked	top of sidewall	40.300	0.000	0.000	71.60	0.00	0.00	71.600	2.400	74.0	1025.4	10.0	83,468

Exam Date: 11/13/2008

Country Grain Cooperative, Inc.

Page: 3

Examiner: 1

Route 3 Box 84
Jamestown, ND

County:

Status	Section	Bin Number	Bin Type	Base Point	Diameter or Bu/Ft (Irreg.)	Length	Width	Side wall	Add for Hopper	Ded. for Obst.	Effective Depth	Add for Peak	Depth for Capac.	Bushels per Foot	Base Pack%	Bushel Capacity with Pack
--------	---------	------------	----------	------------	----------------------------	--------	-------	-----------	----------------	----------------	-----------------	--------------	------------------	------------------	------------	---------------------------

Facility: Cleveland

Section: B

B		113	Peaked	top of sidewall	42.000	0.000	0.000	74.80	0.00	0.00	74.800	2.500	77.3	1113.7	10.0	94,698
B		114	Peaked	top of sidewall	38.000	0.000	0.000	68.00	0.00	0.00	68.000	2.300	70.3	911.7	10.0	70,502
B		115	Peaked	top of sidewall	49.700	0.000	0.000	34.50	0.00	0.00	34.500	3.500	38.0	1559.5	10.0	65,187
B		116	Peaked	top of sidewall	49.700	0.000	0.000	34.50	0.00	0.00	34.500	3.500	38.0	1559.5	10.0	65,187
B		117	Peaked	top of sidewall	68.000	0.000	0.000	54.90	0.00	0.00	54.900	4.800	59.7	2919.4	10.0	191,717
B		118	Peaked	top of sidewall	15.000	0.000	0.000	19.25	2.30	0.00	21.550	0.900	22.5	142.1	5.50	3,373
B		201	Peaked	top of side wall	15.800	0.000	0.000	17.00	2.25	0.00	19.250	0.900	20.2	157.6	5.80	3,369
B		202	Peaked	top of side wall	15.800	0.000	0.000	17.00	2.25	0.00	19.250	0.900	20.2	157.6	5.80	3,369
B		203	Peaked	top of side wall	15.800	0.000	0.000	17.00	2.25	0.00	19.250	0.900	20.2	157.6	5.80	3,369
B		204	Peaked	top of side wall	15.800	0.000	0.000	17.00	2.25	0.00	19.250	0.900	20.2	157.6	5.80	3,369
Bin count: 52														Facility: Cleveland Section: B Total:		739,693
														To Even:		740,000

Section: C

Added	C	ground	Temporary	top of sidewall	17.000	300.0	100.0	3.900	0.00	0.00	3.900	7.600	11.5	23684.5	10.0	299,609
Bin count: 1														Facility: Cleveland Section: C Total:		299,609
														To Even:		300,000

Exam Date: 11/13/2008

Country Grain Cooperative, Inc.

Page: 4

Examiner: 1

Route 3 Box 84
Jamestown, ND

County:

Status	Section	Bin Number	Bin Type	Base Point	Diameter or Bu/Ft (Irreg.)		Side wall	Add for Hopper	Ded. for Obst.	Effective Depth	Add for Peak Capac.	Depth per Foot	Base Pack%	Bushel Capacity with Pack
					Length	Width								

Facility: Eldridge

Section: A

A	001	Square	floor over bins	0.000	7.300	12.30	52.50	0.00	0.00	52.500	0.000	52.5	72.2	5.20	3,988
A	003	Square	floor over bins	0.000	7.300	4.000	50.50	0.00	0.00	50.500	0.000	50.5	23.5	2.00	1,211
A	004	Square	floor over bins	0.000	11.00	5.200	54.00	0.00	0.00	54.000	0.000	54.0	46.0	4.00	2,583
A	005 T	Square	floor over bins	0.000	11.00	5.500	54.00	0.00	0.00	54.000	0.000	54.0	48.6	4.20	2,734
A	005B	Square	floor over bin T54'	0.000	10.70	10.80	16.00	0.00	0.00	16.000	0.000	16.0	92.9	5.80	1,572
A	006	Square	floor over bin	0.000	13.30	11.20	69.00	0.00	0.00	69.000	0.000	69.0	119.7	6.20	8,771
A	007	Square	floor over bin	0.000	5.500	6.500	52.50	0.00	0.00	52.500	0.000	52.5	28.7	2.50	1,545
A	008	Square	floor over bin	0.000	13.30	12.30	52.50	0.00	0.00	52.500	0.000	52.5	131.5	6.50	7,353
A	009	Square	floor over bin	0.000	5.500	12.30	52.50	0.00	0.00	52.500	0.000	52.5	54.4	4.50	2,985
A	010	Square	floor over bin	0.000	13.30	11.00	69.00	0.00	0.00	69.000	0.000	69.0	117.6	6.20	8,617
A	012	Square	floor over bin	0.000	11.00	11.00	70.00	0.00	0.00	70.000	0.000	70.0	97.3	6.00	7,220
A	014 T	Square	floor over bin	0.000	7.300	5.200	16.00	0.00	0.00	16.000	0.000	16.0	30.5	2.50	500
A	014B	Square	floor over bin T16'	0.000	7.300	11.00	36.50	0.00	0.00	36.500	0.000	36.5	64.5	5.00	2,472
A	015	Square	floor over bin	0.000	5.500	5.500	52.50	0.00	0.00	52.500	0.000	52.5	24.3	2.50	1,308
A	016	Square	floor over bin	0.000	7.300	16.00	46.00	0.00	0.00	46.000	0.000	46.0	93.9	5.80	4,570
A	017 T	Square	floor over bin	0.000	11.20	11.20	60.00	0.00	0.00	60.000	0.000	60.0	100.8	6.00	6,411
A	017B	Square	floor over bin T60'	0.000	10.70	14.80	10.00	0.00	0.00	10.000	0.000	10.0	127.3	6.50	1,356
A	018 T	Square	floor over bin	0.000	7.300	7.400	41.00	0.00	0.00	41.000	0.000	41.0	43.4	3.50	1,841
A	018B	Square	floor over bin T41'	0.000	7.300	12.30	11.50	0.00	0.00	11.500	0.000	11.5	72.2	5.20	873
A	019	Square	floor over bin	0.000	11.00	12.20	60.00	0.00	0.00	60.000	0.000	60.0	107.9	6.20	6,875
A	021	Square	floor over bin	0.000	6.000	5.200	51.00	0.00	0.00	51.000	0.000	51.0	25.1	2.50	1,312

Exam Date: 11/13/2008

Country Grain Cooperative, Inc.

Page: 5

Examiner: 1

Route 3 Box 84
Jamestown, ND

County:

Status	Section	Bin Number	Bin Type	Base Point	Diameter or Bu/Ft (Irreg.)	Length	Width	Side wall	Add for Hopper	Ded. for Obst.	Effective Depth	Add for Peak	Depth for Capac.	Bushels per Foot	Base Pack%	Bushel Capacity with Pack
--------	---------	------------	----------	------------	----------------------------	--------	-------	-----------	----------------	----------------	-----------------	--------------	------------------	------------------	------------	---------------------------

Facility: Eldridge

Section: A

A		022 T	Square	floor over bin	0.000	11.20	5.500	51.00	0.00	0.00	51.000	0.000	51.0	49.5	4.20	2,631
A		022B	Square	floor over bin T5'1"	0.000	10.70	10.80	19.00	0.00	0.00	19.000	0.000	19.0	92.9	5.80	1,867
A		023	Square	floor over bin	0.000	5.500	5.200	51.00	0.00	0.00	51.000	0.000	51.0	23.0	2.00	1,196
A		024	Square	floor over bin	0.000	7.300	4.000	51.00	0.00	0.00	51.000	0.000	51.0	23.5	2.00	1,223
A		101	Square	floor over bin	0.000	13.70	12.20	60.00	0.00	0.00	60.000	0.000	60.0	134.4	6.50	8,588
A		102 T	Square	floor over bin	0.000	13.70	11.20	60.00	0.00	0.00	60.000	0.000	60.0	123.3	6.50	7,879
A		102B	Square	floor over bin T6'0"	0.000	13.40	14.80	9.000	0.00	0.00	9.000	0.000	9.0	159.4	7.00	1,535
A		103 T	Square	floor over bin	0.000	13.70	11.20	60.00	0.00	0.00	60.000	0.000	60.0	123.3	6.50	7,879
A		103B	Square	floor over bin T6'0"	0.000	13.40	14.80	9.000	0.00	0.00	9.000	0.000	9.0	159.4	7.00	1,535
A		104	Square	floor over bin	0.000	11.80	12.20	60.00	0.00	0.00	60.000	0.000	60.0	115.7	6.20	7,372
A		105 T	Square	floor over bin	0.000	11.80	11.20	60.00	0.00	0.00	60.000	0.000	60.0	106.2	6.20	6,767
A		105B	Square	floor over bin T6'0"	0.000	11.50	14.80	9.000	0.00	0.00	9.000	0.000	9.0	136.8	6.50	1,311
A		106 T	Square	floor over bin	0.000	11.80	11.20	60.00	0.00	0.00	60.000	0.000	60.0	106.2	6.20	6,767
A		106B	Square	floor over bin T6'0"	0.000	11.50	14.80	9.000	0.00	0.00	9.000	0.000	9.0	136.8	6.50	1,311
A		107 T	Square	floor over bin	0.000	11.40	11.20	60.00	0.00	0.00	60.000	0.000	60.0	102.6	6.00	6,525
A		107B	Square	floor over bin T6'0"	0.000	11.10	14.80	9.000	0.00	0.00	9.000	0.000	9.0	132.1	6.50	1,266
A		108 T	Square	floor over bin	0.000	11.40	11.20	60.00	0.00	0.00	60.000	0.000	60.0	102.6	6.00	6,525
A		108B	Square	floor over bin T6'0"	0.000	11.10	14.80	9.000	0.00	0.00	9.000	0.000	9.0	132.1	6.50	1,266
A		109	Square	floor over bin	0.000	11.40	12.20	60.00	0.00	0.00	60.000	0.000	60.0	111.8	6.20	7,124
A		201	Peaked	eave	36.000	0.000	0.000	64.00	0.00	0.00	64.000	2.200	66.2	818.2	10.0	59,582
A		202	Peaked	eave	36.000	0.000	0.000	64.00	0.00	0.00	64.000	2.200	66.2	818.2	10.0	59,582

Exam Date: 11/13/2008

Country Grain Cooperative, Inc.

Page: 6

Examiner: 1

Route 3 Box 84
Jamestown, ND

County:

Status	Section	Bin Number	Bin Type	Base Point	Diameter or Bu/Ft (Irreg.)	Length	Width	Side wall	Add for Hopper	Ded. for Obst.	Effective Depth	Add for Peak	Depth for Capac.	Bushels per Foot	Base Pack%	Bushel Capacity with Pack
--------	---------	------------	----------	------------	-------------------------------	--------	-------	--------------	----------------------	----------------------	--------------------	--------------------	------------------------	------------------------	---------------	------------------------------

Facility: Eldridge

Section: A

A		203	Peaked	eave	36.000	0.000	0.000	64.00	0.00	0.00	64.000	2.200	66.2	818.2	10.0	59,582
A		204	Peaked	eave	33.000	0.000	0.000	62.30	0.00	0.00	62.300	2.000	64.3	687.5	9.50	48,406
A		205	Peaked	eave	33.000	0.000	0.000	64.00	0.00	0.00	64.000	2.000	66.0	687.5	9.50	49,686
A		206	Peaked	eave	42.000	0.000	0.000	61.20	0.00	0.00	61.200	2.500	63.7	1113.7	10.0	78,037
A		207	Peaked	eave	48.000	0.000	0.000	61.00	0.00	0.00	61.000	3.400	64.4	1454.6	10.0	103,044
A		208	Peaked	eave	74.500	0.000	0.000	53.80	0.00	0.00	53.800	5.200	59.0	3504.1	10.0	227,416
A		209	Peaked	top of sidewall	74.500	0.000	0.000	80.75	0.00	0.00	80.750	5.200	86.0	3504.1	10.0	331,488

Bin count: 49

Facility: Eldridge Section: A Total:

1,173,487

To Even:

1,174,000

Section: G

Added	G	ground	Temporary	see diagram	19.300	252.6	122.7	3.800	0.00	0.00	3.800	8.500	12.3	23631.0	10.0	319,727
-------	---	--------	-----------	-------------	--------	-------	-------	-------	------	------	-------	-------	------	---------	------	---------

Bin count: 1

Facility: Eldridge Section: G Total:

319,727

To Even:

320,000

Exam Date: 11/13/2008
 Examiner: 1

Country Grain Cooperative, Inc.
 Route 3 Box 84
 Jamestown, ND
 County:

Status	Section	Bin Number	Bin Type	Base Point	Diameter or Bu/Ft (Irreg.)	Length	Width	Side wall	Add for Hopper	Ded. for Obst.	Effective Depth	Add for Peak	Depth for Capac.	Bushels per Foot	Base Pack%	Bushel Capacity with Pack
--------	---------	------------	----------	------------	----------------------------	--------	-------	-----------	----------------	----------------	-----------------	--------------	------------------	------------------	------------	---------------------------

Facility: Windsor

Section: E

E	002		Square	work floor	0.000	11.50	5.000	10.00	0.00	0.00	10.000	0.000	10.0	46.2	4.00	480
E	003 T		Square	work floor	0.000	11.50	2.000	10.00	0.00	0.00	10.000	0.000	10.0	18.5	2.00	189
E	003 B		Square	work floor -top 10'	0.000	11.50	7.500	39.00	0.00	0.00	39.000	0.000	39.0	69.3	5.20	2,844
E	004		Square	work floor	0.000	7.500	6.000	31.00	0.00	0.00	31.000	0.000	31.0	36.2	3.00	1,156
E	005		Square	work floor	0.000	7.500	5.000	34.00	0.00	0.00	34.000	0.000	34.0	30.1	2.50	1,049
E	007		Square	work floor	0.000	7.500	6.500	34.00	0.00	0.00	34.000	0.000	34.0	39.2	3.00	1,373
E	008		Square	work floor	0.000	7.500	6.000	31.00	0.00	0.00	31.000	0.000	31.0	36.2	3.00	1,156
E	009		Square	work floor	0.000	7.500	5.000	34.00	0.00	0.00	34.000	0.000	34.0	30.1	2.50	1,049
E	010		Square	work floor	0.000	7.500	6.500	34.00	0.00	0.00	34.000	0.000	34.0	39.2	3.00	1,373
E	011		Square	work floor	0.000	11.50	7.500	49.00	0.00	0.00	49.000	0.000	49.0	69.3	5.20	3,573
E	012		Square	work floor	0.000	7.500	6.500	34.00	0.00	0.00	34.000	0.000	34.0	39.2	3.00	1,373
E	014		Square	work floor	0.000	7.500	6.500	34.00	0.00	0.00	34.000	0.000	34.0	39.2	3.00	1,373
E	015		Square	work floor	0.000	11.50	7.500	49.00	0.00	0.00	49.000	0.000	49.0	69.3	5.20	3,573
E	016		Square	work floor	0.000	11.50	7.500	49.00	0.00	0.00	49.000	0.000	49.0	69.3	5.20	3,573
E	018		Square	work floor	0.000	7.500	6.500	34.00	0.00	0.00	34.000	0.000	34.0	39.2	3.00	1,373
E	019		Square	work floor	0.000	7.500	6.500	34.00	0.00	0.00	34.000	0.000	34.0	39.2	3.00	1,373
E	020		Square	work floor	0.000	11.50	7.500	49.00	0.00	0.00	49.000	0.000	49.0	69.3	5.20	3,573
E	021		Square	work floor	0.000	11.50	7.500	49.00	0.00	0.00	49.000	0.000	49.0	69.3	5.20	3,573
E	022		Square	work floor	0.000	7.500	4.000	34.00	0.00	0.00	34.000	0.000	34.0	24.1	2.50	839
E	101 T		Square	work floor	0.000	13.00	10.00	43.00	0.00	0.00	43.000	0.000	43.0	104.5	6.00	4,764
E	101 B		Square	work floor -top 43'	0.000	13.00	12.50	11.00	0.00	0.00	11.000	0.000	11.0	130.6	6.50	1,530

Exam Date: 11/13/2008

Country Grain Cooperative, Inc.

Page: 8

Examiner: 1

Route 3 Box 84
Jamestown, ND

County:

Status	Section	Bin Number	Bin Type	Base Point	Diameter or Bu/Ft (Irreg.)	Length	Width	Side wall	Add for Hopper	Ded. for Obst.	Effective Depth	Add for Peak Capac.	Depth per Foot	Bushels per Foot	Base Pack%	Bushel Capacity with Pack
--------	---------	------------	----------	------------	----------------------------	--------	-------	-----------	----------------	----------------	-----------------	---------------------	----------------	------------------	------------	---------------------------

Facility: Windsor

Section: E

E		102 T	Square	work floor	0.000	13.00	10.00	43.00	0.00	0.00	43.000	0.000	43.0	104.5	6.00	4,764
E		102 B	Square	work floor -top 43'	0.000	13.00	12.50	11.00	0.00	0.00	11.000	0.000	11.0	130.6	6.50	1,530
E		103 T	Square	work floor	0.000	13.00	10.00	43.00	0.00	0.00	43.000	0.000	43.0	104.5	6.00	4,764
E		103 B	Square	work floor -top 43'	0.000	13.00	12.50	11.00	0.00	0.00	11.000	0.000	11.0	130.6	6.50	1,530
E		104	Square	work floor	0.000	13.00	10.00	42.00	0.00	0.00	42.000	0.000	42.0	104.5	6.00	4,652
E		105	Square	work floor	0.000	13.00	10.00	42.00	0.00	0.00	42.000	0.000	42.0	104.5	6.00	4,652
E		106	Square	work floor	0.000	13.00	10.00	42.00	0.00	0.00	42.000	0.000	42.0	104.5	6.00	4,652
E		107 T	Square	work floor	0.000	13.00	10.00	43.00	0.00	0.00	43.000	0.000	43.0	104.5	6.00	4,764
E		107 B	Square	work floor -top 43'	0.000	13.00	12.50	11.00	0.00	0.00	11.000	0.000	11.0	130.6	6.50	1,530
E		108 T	Square	work floor	0.000	13.00	10.00	43.00	0.00	0.00	43.000	0.000	43.0	104.5	6.00	4,764
E		108 B	Square	work floor -top 43'	0.000	13.00	12.50	11.00	0.00	0.00	11.000	0.000	11.0	130.6	6.50	1,530
E		109 T	Square	work floor	0.000	13.00	10.00	43.00	0.00	0.00	43.000	0.000	43.0	104.5	6.00	4,764
E		109 B	Square	work floor -top 43'	0.000	13.00	12.50	11.00	0.00	0.00	11.000	0.000	11.0	130.6	6.50	1,530
E		201 T	Square	work floor	0.000	14.50	10.50	39.00	0.00	0.00	39.000	0.000	39.0	122.4	6.50	5,084
E		201 B	Square	work floor -top 39'	0.000	14.50	12.00	10.00	0.00	0.00	10.000	0.000	10.0	139.9	6.80	1,494
E		202 T	Square	work floor	0.000	14.50	10.50	39.00	0.00	0.00	39.000	0.000	39.0	122.4	6.50	5,084
E		202 B	Square	work floor -top 39'	0.000	14.50	12.00	10.00	0.00	0.00	10.000	0.000	10.0	139.9	6.80	1,494
E		203 T	Square	work floor	0.000	14.50	10.50	39.00	0.00	0.00	39.000	0.000	39.0	122.4	6.50	5,084
E		203 B	Square	work floor -top 39'	0.000	14.50	12.00	10.00	0.00	0.00	10.000	0.000	10.0	139.9	6.80	1,494
E		204	Square	work floor	0.000	14.50	8.500	42.00	0.00	0.00	42.000	0.000	42.0	99.1	6.00	4,412
E		205	Square	work floor	0.000	14.50	8.500	42.00	0.00	0.00	42.000	0.000	42.0	99.1	6.00	4,412

Exam Date: 11/13/2008

Country Grain Cooperative, Inc.
Route 3 Box 84
Jamestown, ND

Examiner: 1

County:

Status	Section	Bin Number	Bin Type	Base Point	Diameter or Bu/Ft (Irreg.)	Length	Width	Side wall	Add for Hopper	Ded. for Obst.	Effective Depth	Add for Peak	Depth for Capac.	Bushels per Foot	Base Pack%	Bushel Capacity with Pack
--------	---------	------------	----------	------------	----------------------------	--------	-------	-----------	----------------	----------------	-----------------	--------------	------------------	------------------	------------	---------------------------

Facility: Windsor

Section: E

E	206	Square	work floor		0.000	14.50	8.500	42.00	0.00	0.00	42.000	0.000	42.0	99.1	6.00	4,412
E	207 T	Square	work floor		0.000	14.50	10.50	39.00	0.00	0.00	39.000	0.000	39.0	122.4	6.50	5,084
E	207 B	Square	work floor -top 39'		0.000	14.50	12.00	10.00	0.00	0.00	10.000	0.000	10.0	139.9	6.80	1,494
E	208 T	Square	work floor		0.000	14.50	10.50	39.00	0.00	0.00	39.000	0.000	39.0	122.4	6.50	5,084
E	208 B	Square	work floor -top 39'		0.000	14.50	12.00	10.00	0.00	0.00	10.000	0.000	10.0	139.9	6.80	1,494
E	209 T	Square	work floor		0.000	14.50	10.50	39.00	0.00	0.00	39.000	0.000	39.0	122.4	6.50	5,084
E	209 B	Square	work floor -top 39'		0.000	14.50	12.00	10.00	0.00	0.00	10.000	0.000	10.0	139.9	6.80	1,494
Bin count: 49													Facility: Windsor Section: E Total:		139,289	
													To Even:		140,000	

Section: F

F	100	Quonset	bottom u trough 17'		0.000	120.0	41.50	11.00	0.00	0.00	11.000	0.000	11.0	3806.8	10.0	46,064
Bin count: 1													Facility: Windsor Section: F Total:		46,064	
													To Even:		47,000	

Overall Licensed Bin Capacity for:

Country Grain Cooperative, Inc.

Bin count: 153

Licensed Capacity: _____ (Includes pack)

Licensed Capacity (to even): _____ (Includes pack and section totals are rounded up to next highest 1000)

2,717,869 Bu.

2,721,000 Bu.


COUNTRY GRAIN CO-OP INC

ELDRIDGE ND

CLEVELAND location

SECTION B

BNSF Rail

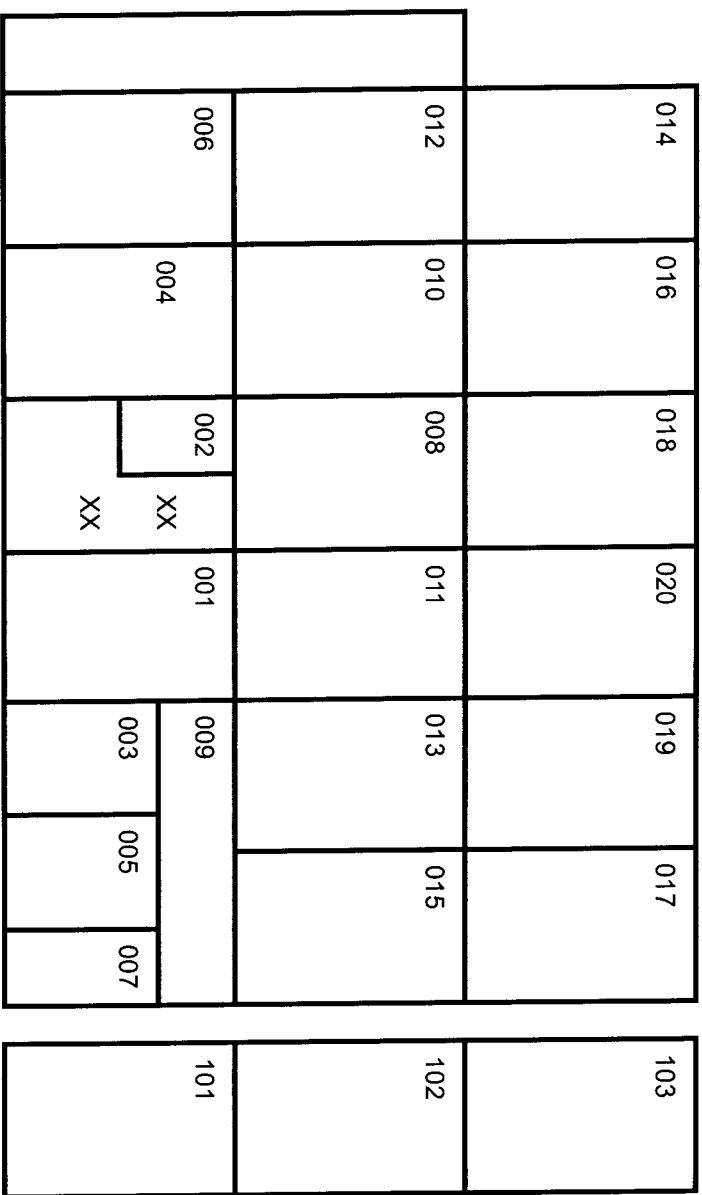

Ground storage NE of elevator

slant wall bunker

100' W x 300'L

4.0" grain slant wall ht.

skate ring curved on east end

Section A

ZERO points


elevator and annex -- floor over bins

tanks -- top of sidewall


COUNTRY GRAIN CO-OP INC.
 ELDRIDGE ND
 CLEVELAND location
 SECTION B

BNSF Rail


017	103	106	108
015	102	hoppered	hoppered
009	101	104	107
007			

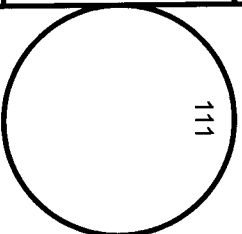


37.1' dia
60.6' sidewall

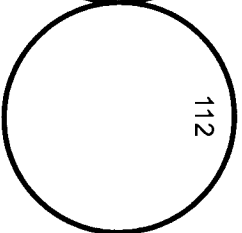


40.3' dia
71.6' sidewall

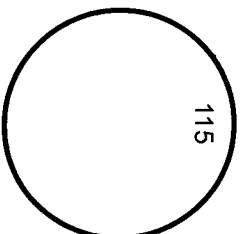


tank 15&16
49.7' dia
34.5' sidewall

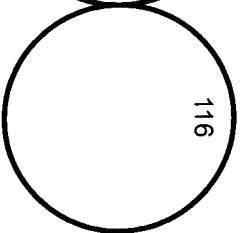

XX
XX

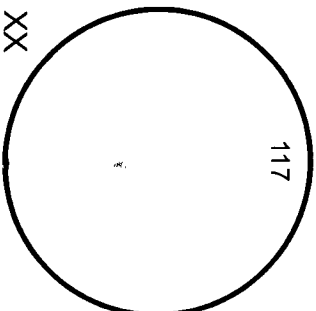


68' dia
54.9' sidewall
conveyor space - raised floor

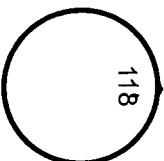

Section B


Zero Points

elevator & annex floor over bins
 tanks - top of sidewall
 bin 106 & 108 have been hoppered with side unload capacity reduced
 load-out bins bottoms not used

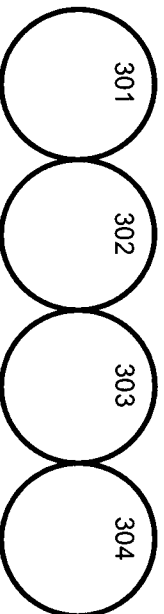


COUNTRY GRAIN CO-OP INC.
ELDRIDGE ND
CLEVELAND LOCATION
SECTION C
ground storage Licensed capacity 300,000 bu.



50' radius

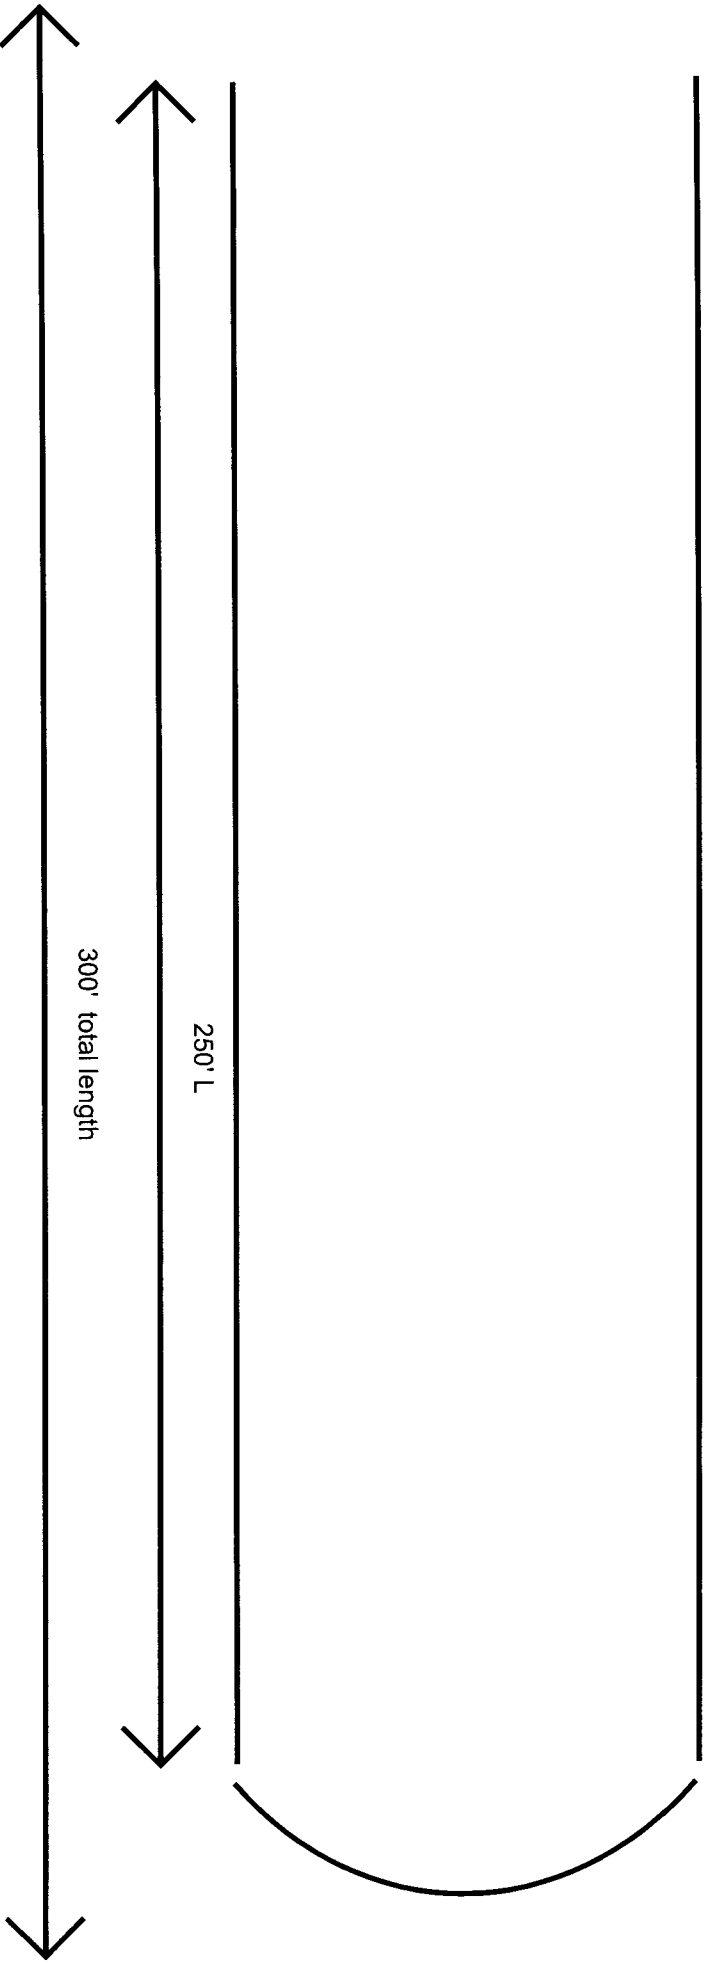


total length 300'
width = 100' at base or ground
grain slant wall is 4.0' ht
dimensions at ground 300.0'L x 100.0'W
at 2.0" ht (1/2 grain wall ht.) 301.5' L x 103.'W
at 4.0' ht (top of grain wall) 303' L x 106' W
asphalt pad 100' W x 300' L

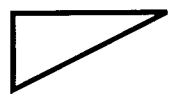

303' L
301.5' L
300' L

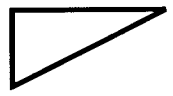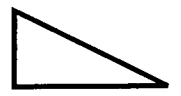


106' W
103' W
100' W

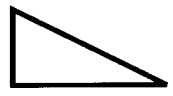





COUNTRY GRAIN CO-OP INC.
ELDRIDGE ND.

SECTION G

ground storage bunker
located south of main elevator
licensed capacity 320,000 bu.

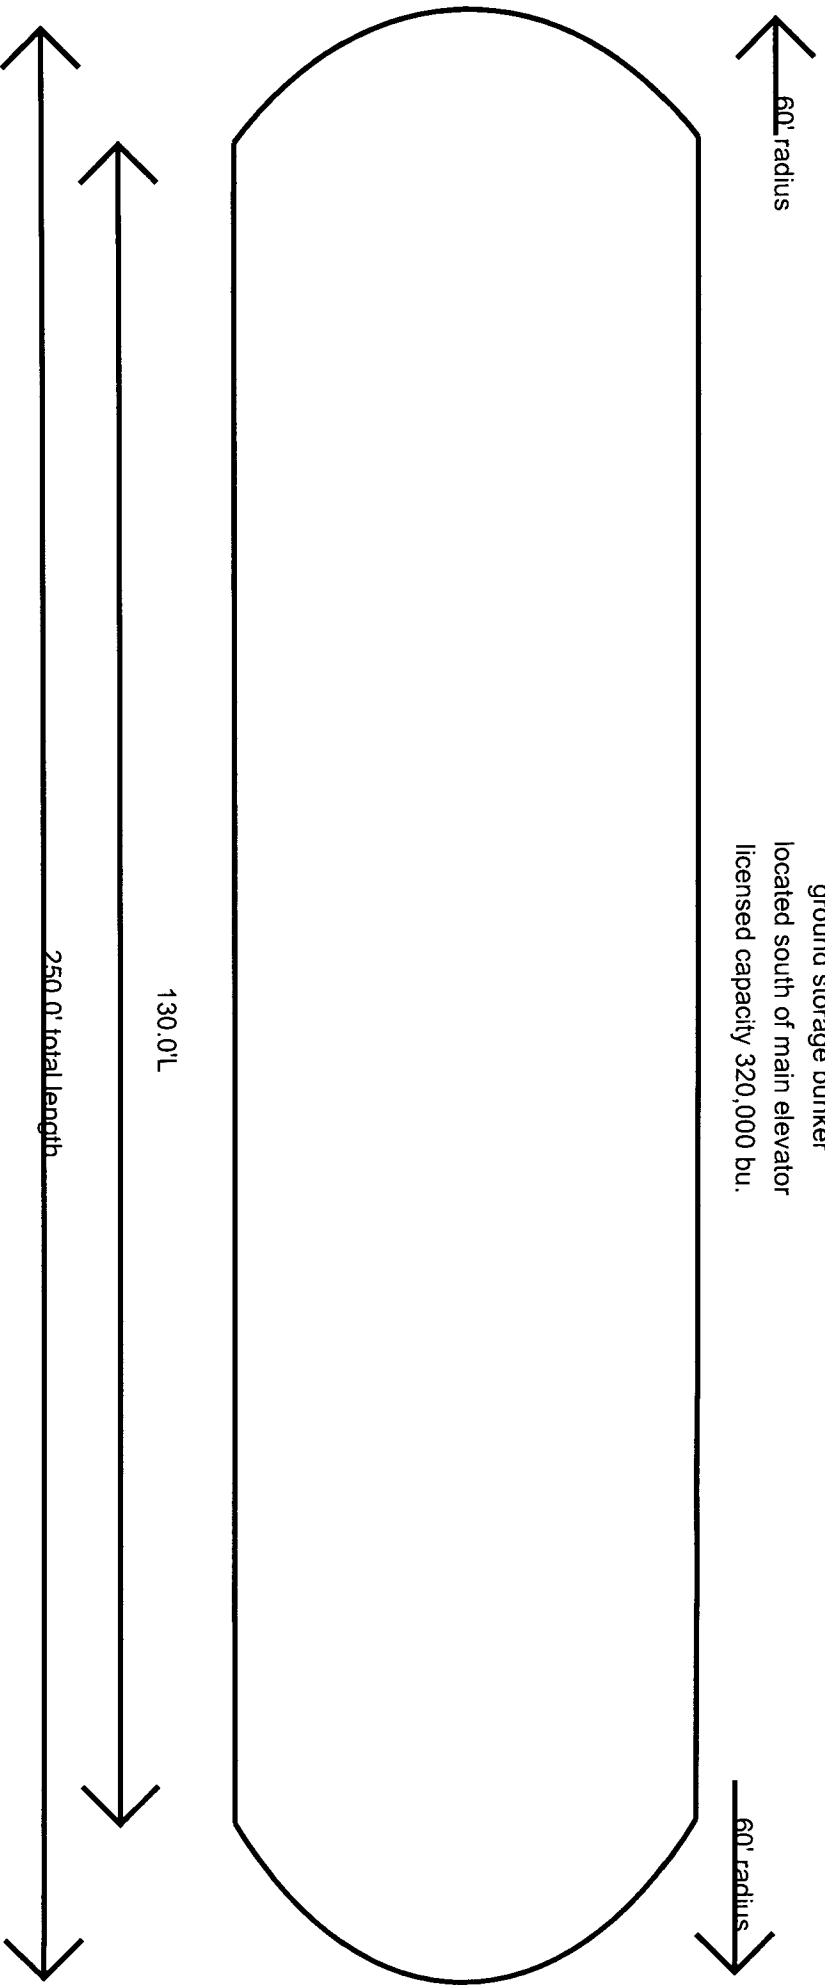


total length 250'
width = 120.0' at base or ground
grain slant wall is 3.8' ht
dimensions at ground 250.0'L x 120.0'W
at 1.9' ht (1/2 grain wall ht.) 252.8'L x 122.8'W
at 3.8' ht (top of grain wall) 255.5'L x 125.5'W

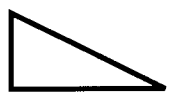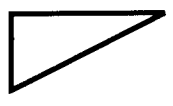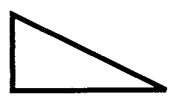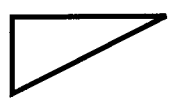

255.5'L
252.8'L
250.0'L
125.5'W
122.8'W
120.0'W

COUNTRY GRAIN CO-OP INC
 ELDRIDGE ND
 WINDSOR location
 SECTION E

BNSF RAIL

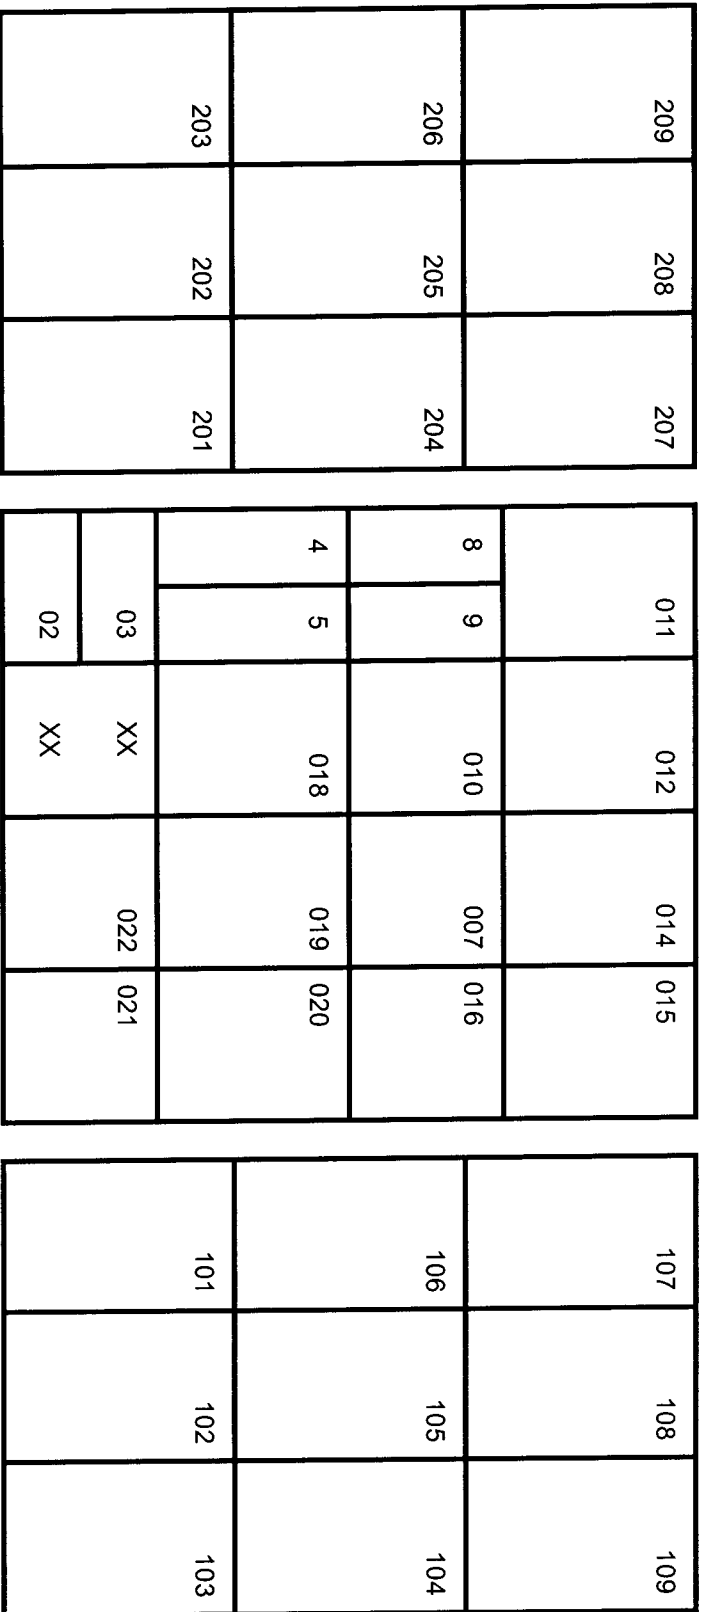


Section E

ZERO POINTS -- Elevator and annexes -- Floor over Bins

COUNTRY GRAIN CO-OP INC
ELDRIDGE ND

SECTION F
at WINDSOR

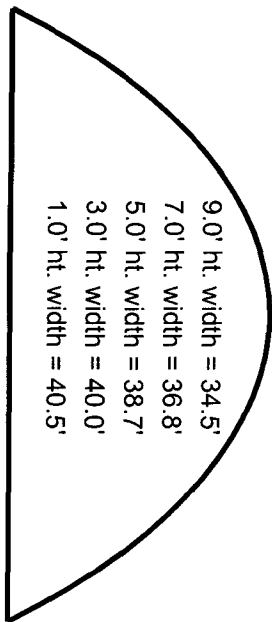

- base dimensions 120' x 41.5'
- bottom u-trough to floor 17.0'
- sidewall u-trough 2.0' on center
- 1st sidewall seam 3.0' to floor
- 2nd sidewall seam 9.0'
- 3rd sidewall seam 10.75'

F-#100

