

Hamre, John G.

From: Fahn, Patrick J.
Sent: Monday, August 10, 2009 4:19 PM
To: Hamre, John G.
Subject: FW: Daily report 8-6-09(PU-08-844)
Attachments: Whiting Pipeline.xls

John - please docket this email and the next email in 08-844 from Whiting and then forward to Commissioners, PUD and Legal.

Patrick Fahn
Director-Compliance and Competitive Markets
Email: pfahn@nd.gov
Phone: (701) 328-4077

North Dakota Public Service Commission
600 E Boulevard
Bismarck ND 58505-0480
Fax: (701) 328-2410

-----Original Message-----

From: Steve Meagher [mailto:Steve.Meagher@whiting.com]
Sent: Monday, August 10, 2009 3:54 PM
To: Fahn, Patrick J.
Subject: FW: Daily report 8-6-09(PU-08-844)

Mr Fahn, this is last weeks update, sending a map in anothe email, Steve Meagher

From: Jeffrey Carlson [mailto:JCarlson@gwddesign.net]
Sent: Fri 8/7/2009 10:05 AM
To: William Herrmann
Cc: Steve Meagher; William E. Kovar
Subject: FW: Daily report 8-6-09

Bill,

Attached is the report you asked for. Please let me know if you have any questions.

Thanks,
Jeff

From: William E. Kovar [mailto:kovar_we@pearldc.com]
Sent: Friday, August 07, 2009 8:19 AM
To: Jeffrey Carlson
Subject: FW: Daily report 8-6-09

44 PU-08-844 Filed 08/10/2009 Pages: 7
Whiting Weekly Progress Report 8-6-09
Whiting Oil and Gas Corporation

Jeff,

Here is the copy of the report you asked for. It was raining this morning so the crews shut down for the weekend. We will get back to it on Monday.

Bill Kovar
Construction Manager

Pearl Development Company
1082 East Brundage Lane
Sheridan, Wyoming 82801
USA

voice: 1.303.672.8090
fax: 1.307.672.8091
email: kovar_we@pearlhc.com
website: www.pearlhc.com <<http://www.pearlhc.com/>>

Information contained in this communication is confidential and is intended only for the use of the addressee. Unauthorized use, disclosure, or copying is strictly prohibited and may be unlawful. If you have received this communication in error, please immediately notify the sender by calling 1.307.672.8090.

From: William E. Kovar
Sent: Thu 8/6/2009 7:58 PM
To: steve.meagher@whiting.com
Cc: Jay A. Yale; Eddie C. Relaford; Jess L. Sams; Josh B. Hinkle
Subject: Daily report 8-6-09

Steve things are moving along good.

Welded 6732' for 75%
Trenched, lowered in and back filled 3000' for 22%

Had 2 line crossings, 1 road crossing and installed 1000' of rock guard. I meet with Jeff Carlson and Nexen today and got a plan for both ends of the pipeline.

Bill Kovar
Construction Manager

Pearl Development Company
1082 East Brundage Lane
Sheridan, Wyoming 82801
USA

voice: 1.303.672.8090
fax: 1.307.672.8091
email: kovar_we@pearlhc.com
website: www.pearlhc.com <<http://www.pearlhc.com/>>

Information contained in this communication is confidential and is intended only for the use of the addressee. Unauthorized use, disclosure, or copying is strictly prohibited and may be unlawful. If you have received this communication in error, please immediately notify the sender by calling 1.307.672.8090.



Client:	Whiting Petroleum Corp.
Project:	Nexen 8" pipeline
Location:	Stanley N.D
Job #:	40-0177
AFE / WO #	08-1057

Issue:	
Rev.:	1
By:	WEK
Approved:	
Commission case #	PU-08-844

Estimated Date Complete 9/12/09

Percent Complete to Date 50%

WEATHER 8AM	Sunny	Thursday, August 06, 2009				WEATHER 4PM	Sunny
TEMPERATURE 8AM	52					TEMPERATURE 4PM	76

Equipment	QTY	Hours	Companies On Work Site	Supervisors		Operators / Welders		Laborers	
				# People	Hours	# People	Hours	# People	Hours
Mower	1	0	Pearl	2	11				
Blade	2	0	F & D Oil Field Maintenance	4	11	14	11	13	11
Dozer	1	11							
Track Hoe	4	11							
Side Boom	4	11							
Daily Totals		99	Daily Totals	6	66	14	154	13	143
Project Totals		1134	Project Totals	111	1225	201	2237	263	2492

Operation	Date Started	Ft. Today	Ft. To Date	% Complete	Operation	Date Started	Ft. Today	Ft. To Date	% Complete
ROW Mowed	7/13/2009	0	94404	100%	Trenching	7/30/2009	3000	16362	22%
ROW Built	7/13/2009	0	94404	100%	Lower In	7/30/2009	3000	16362	22%
Stringing	7/15/2009	0	94404	100%	Backfill	7/30/2009	3000	16362	22%
Bending	7/19/2009	0	94404	100%	Clean Up				
Welding	7/27/2009	6732	69300	75%					

X - Ray	# Today	# To Date	Company	Daily Cost	Total Cost to Date
Line Welds	159	1565	N/A Per Client Request	\$0.00	\$0.00
Tie in's	7	26			
Repairs	6	59			
Cut outs	0	2			

RECORD OF DAYS EVENTS

Welded 153 joints for 6732' for 75%, trenched, lowered in and backfilled 3000' for 22%, continued county road bore, X-rayed 159 line welds, 7 tie in welds and 6 repair welds with 6 repairs.

NEXT DAYS WORK

Continue welding, trenching and bores.

SAFETY REVIEW

Safe driving

VISITORS

None

Bill Kovar
SITE MANAGER

Hamre, John G.

From: Fahn, Patrick J.
Sent: Monday, August 10, 2009 4:19 PM
To: Hamre, John G.
Subject: FW: Emailing: Oil Discharge Line Weekly Status Map - 090807 PU-08-844
Attachments: Oil Discharge Line Weekly Status Map - 090807.pdf

Patrick Fahn
Director-Compliance and Competitive Markets
Email: pfahn@nd.gov
Phone: (701) 328-4077

North Dakota Public Service Commission
600 E Boulevard
Bismarck ND 58505-0480
Fax: (701) 328-2410

-----Original Message-----

From: Steve Meagher [mailto:Steve.Meagher@whiting.com]
Sent: Monday, August 10, 2009 3:55 PM
To: Fahn, Patrick J.
Subject: FW: Emailing: Oil Discharge Line Weekly Status Map - 090807 PU-08-844

Hope this helps SM

From: Mike Madler [mailto:mike.madler@ecs-gps.com]
Sent: Fri 8/7/2009 9:39 AM
To: Steve Meagher
Cc: kovar_we@pearlhc.com
Subject: Emailing: Oil Discharge Line Weekly Status Map - 090807

Steve,


Attached is weekly status map for the 8" Oil Discharge. Let me know if you need changes, etc. Thanks.

Mike

The message is ready to be sent with the following file or link attachments:

Oil Discharge Line Weekly Status Map - 090807

Note: To protect against computer viruses, e-mail programs may prevent sending or receiving certain types of file attachments. Check your e-mail security settings to determine how attachments are handled.

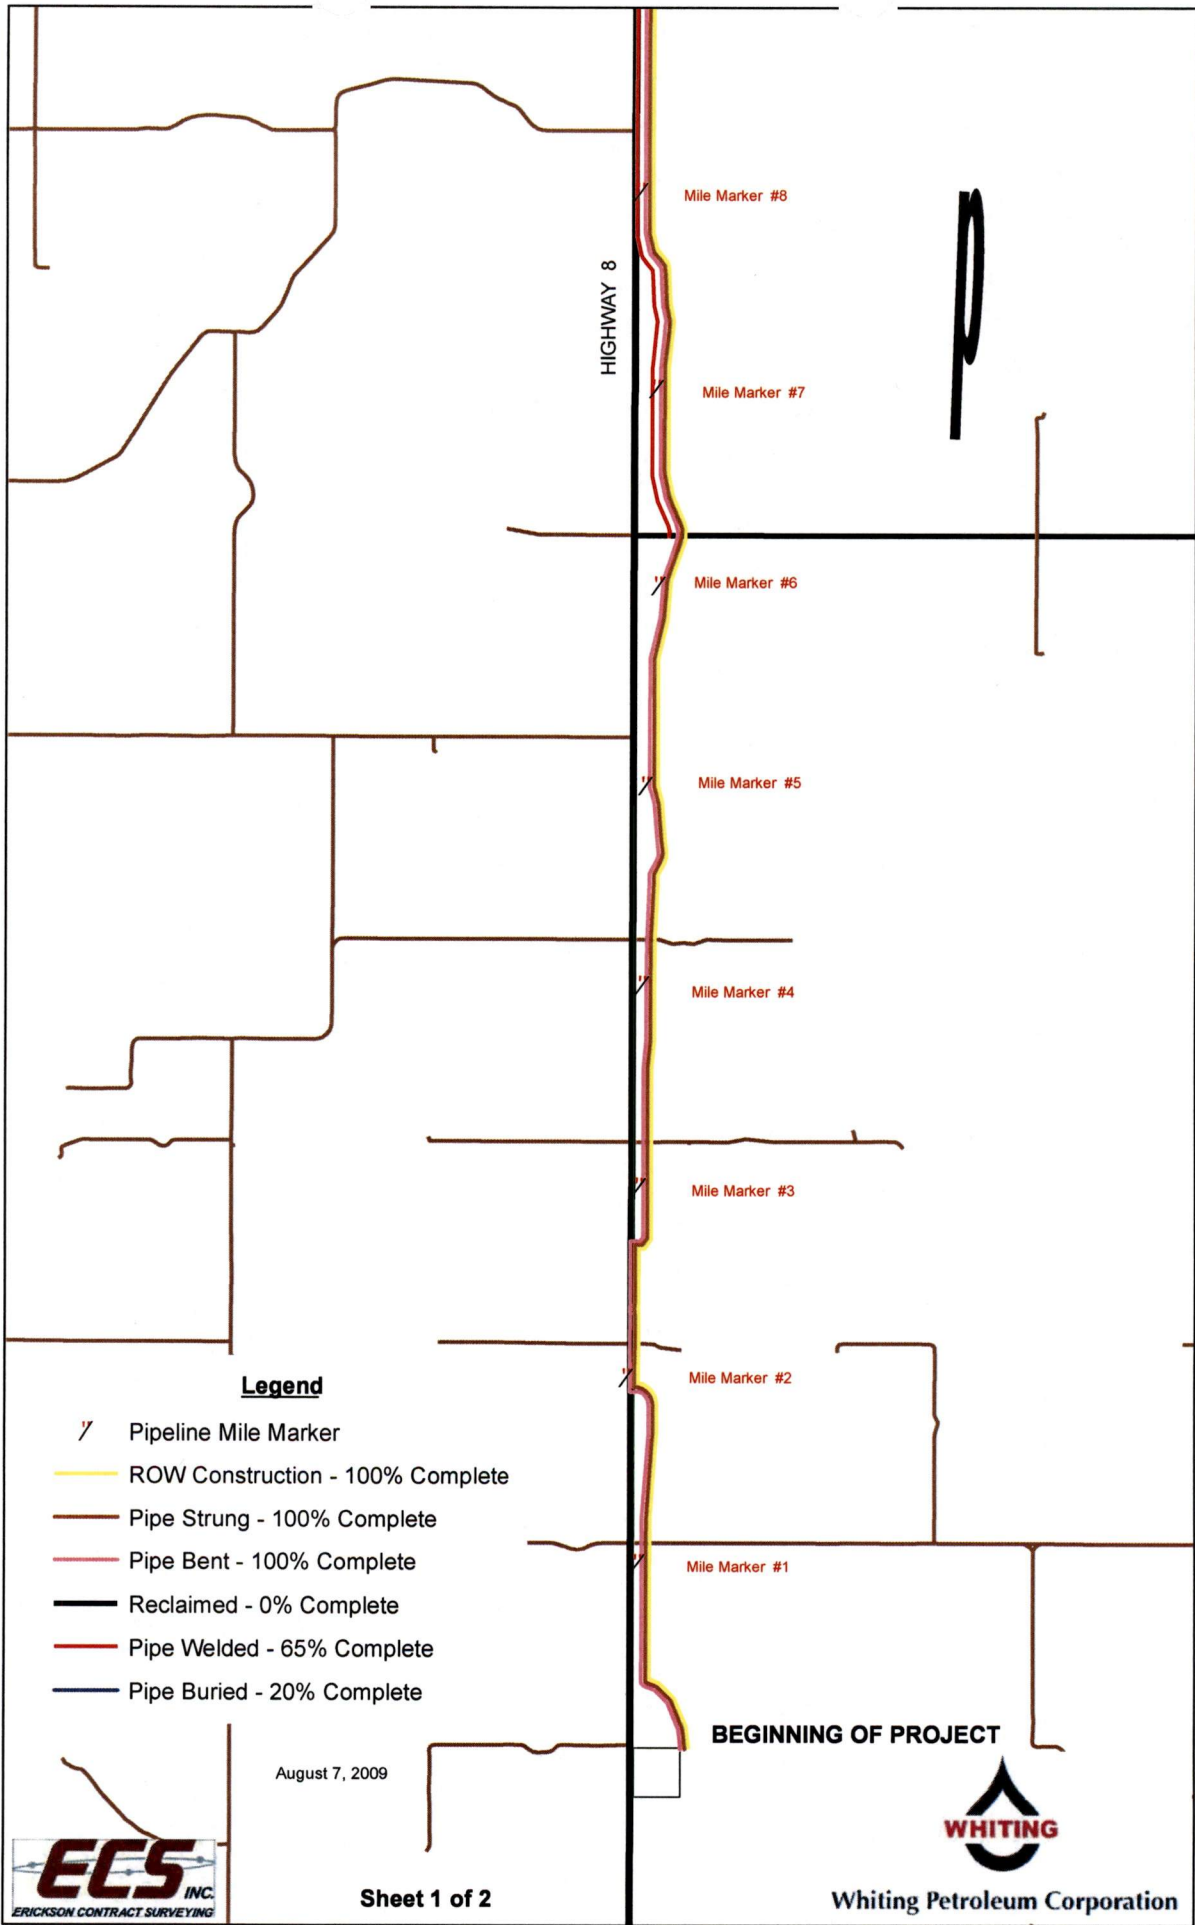

Legend

- ∕ Pipeline Mile Marker
- ROW Construction - 100% Complete
- Pipe Strung - 100% Complete
- Pipe Bent - 100% Complete
- Reclaimed - 0% Complete
- Pipe Welded - 65% Complete
- Pipe Buried - 20% Complete

August 7, 2009

BEGINNING OF PROJECT



