

**Hamre, John G.**

---

**From:** Fahn, Patrick J.  
**Sent:** Tuesday, August 18, 2009 10:39 AM  
**To:** Hamre, John G.  
**Subject:** FW: Oil Discharge Line Weekly Status Map - 090814 PU-08-844  
**Attachments:** Oil Discharge Line Weekly Status Map - 090814.pdf

John - please docket in 08-844 from Whiting and then forward to Commissioners, PUD and Legal

Patrick Fahn  
Director-Compliance and Competitive Markets  
Email: [pfahn@nd.gov](mailto:pfahn@nd.gov)  
Phone: (701) 328-4077

North Dakota Public Service Commission  
600 E Boulevard  
Bismarck ND 58505-0480  
Fax: (701) 328-2410

-----Original Message-----

From: Steve Meagher [mailto:[Steve.Meagher@whiting.com](mailto:Steve.Meagher@whiting.com)]  
Sent: Monday, August 17, 2009 6:59 AM  
To: Brent Miller; Fahn, Patrick J.; William Herrmann  
Subject: FW: Oil Discharge Line Weekly Status Map - 090814 PU-08-844

Just got this this morning so will forward it on, hope it helps sm

---

From: Mike Madler [mailto:[mike.madler@ecs-gps.com](mailto:mike.madler@ecs-gps.com)]  
Sent: Fri 8/14/2009 1:39 PM  
To: Steve Meagher  
Subject: Oil Discharge Line Weekly Status Map - 090814

Steve,


Attached is weekly map for PSC. Is this what you had in mind? Do you still want to continue to do it on a weekly basis through the project? Let me know. Thanks.

Mike





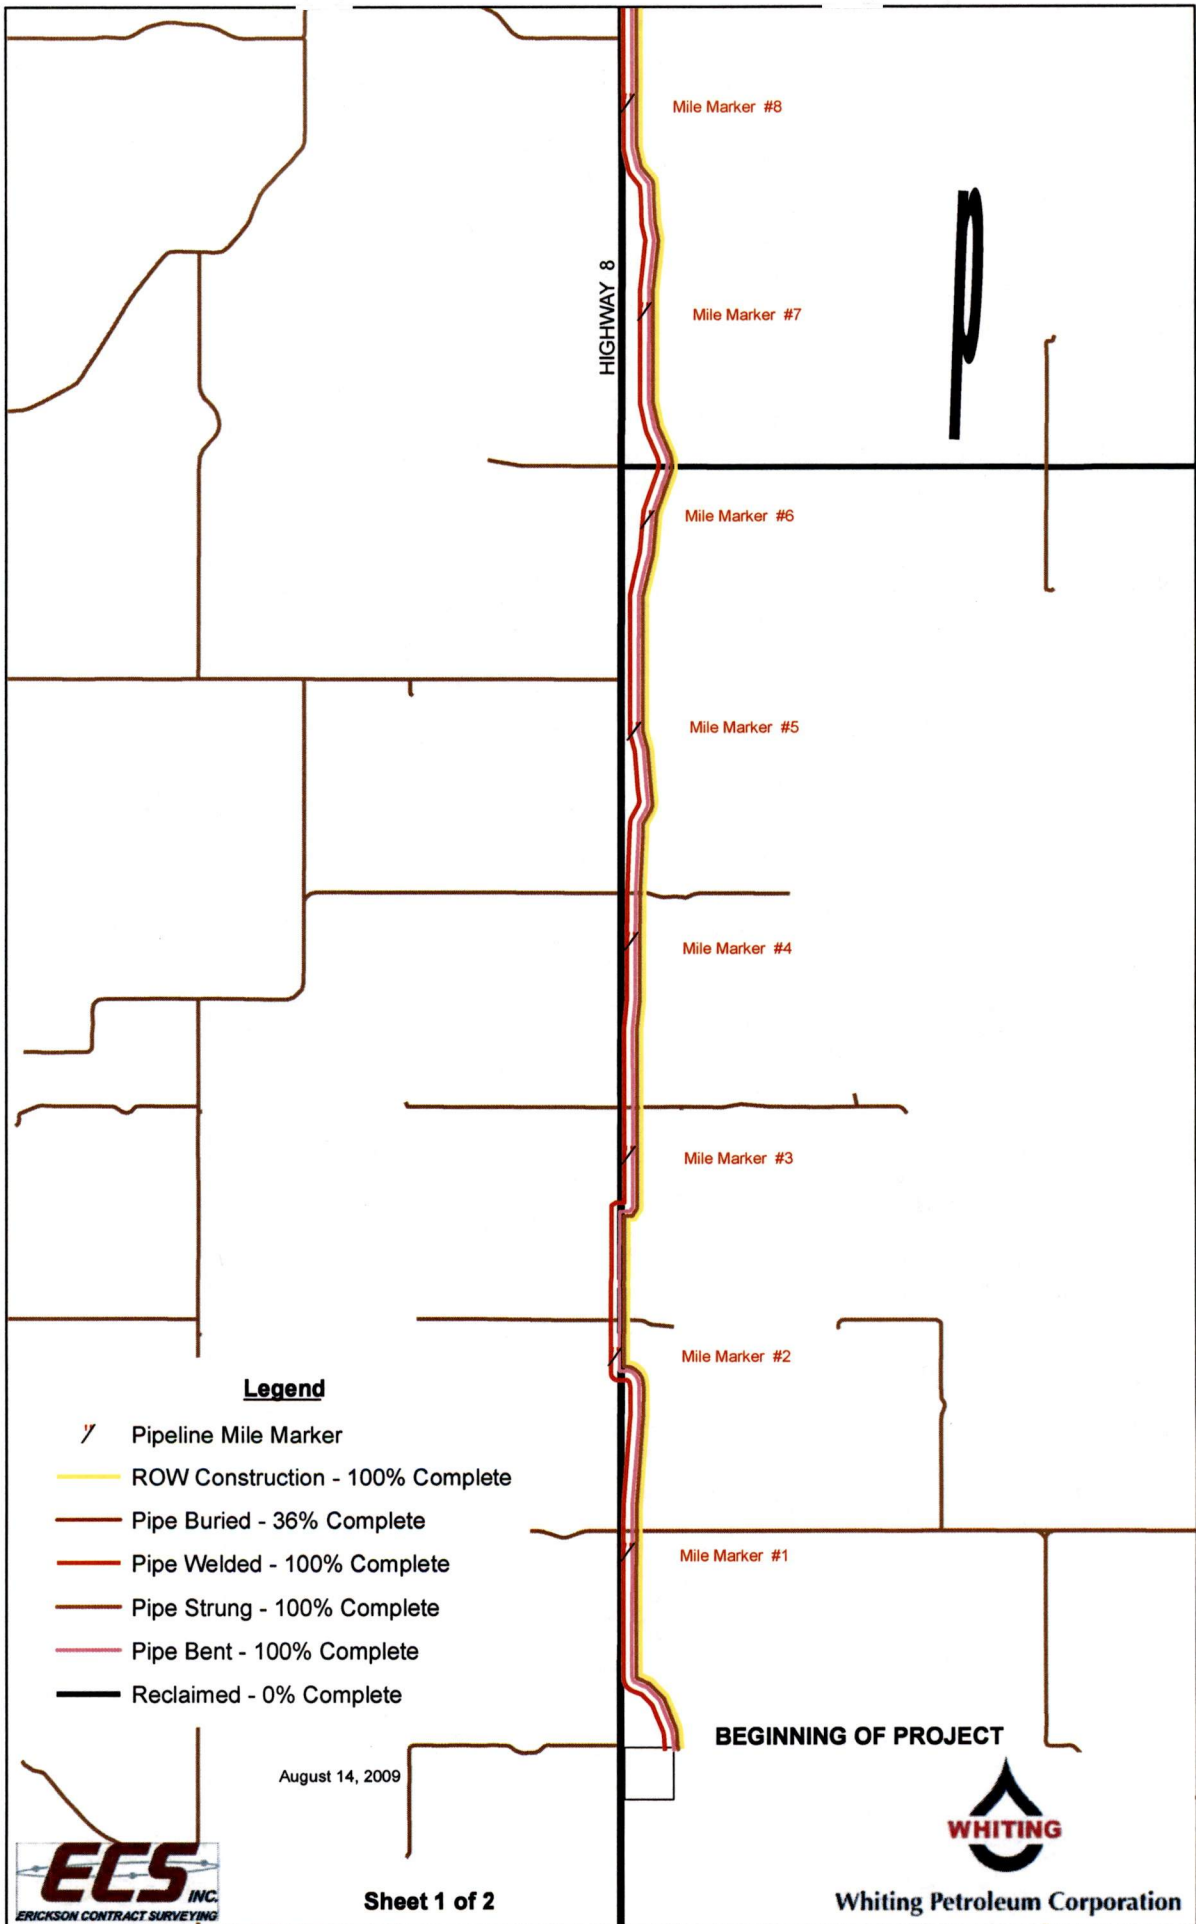


The message is ready to be sent with the following file or link attachments:

Oil Discharge Line Weekly Status Map - 090814


46 PU-08-844 Filed 08/14/2009 Pages: 3  
Whiting Weekly Progress Report 08-14-2009  
Whiting Oil and Gas Corporation







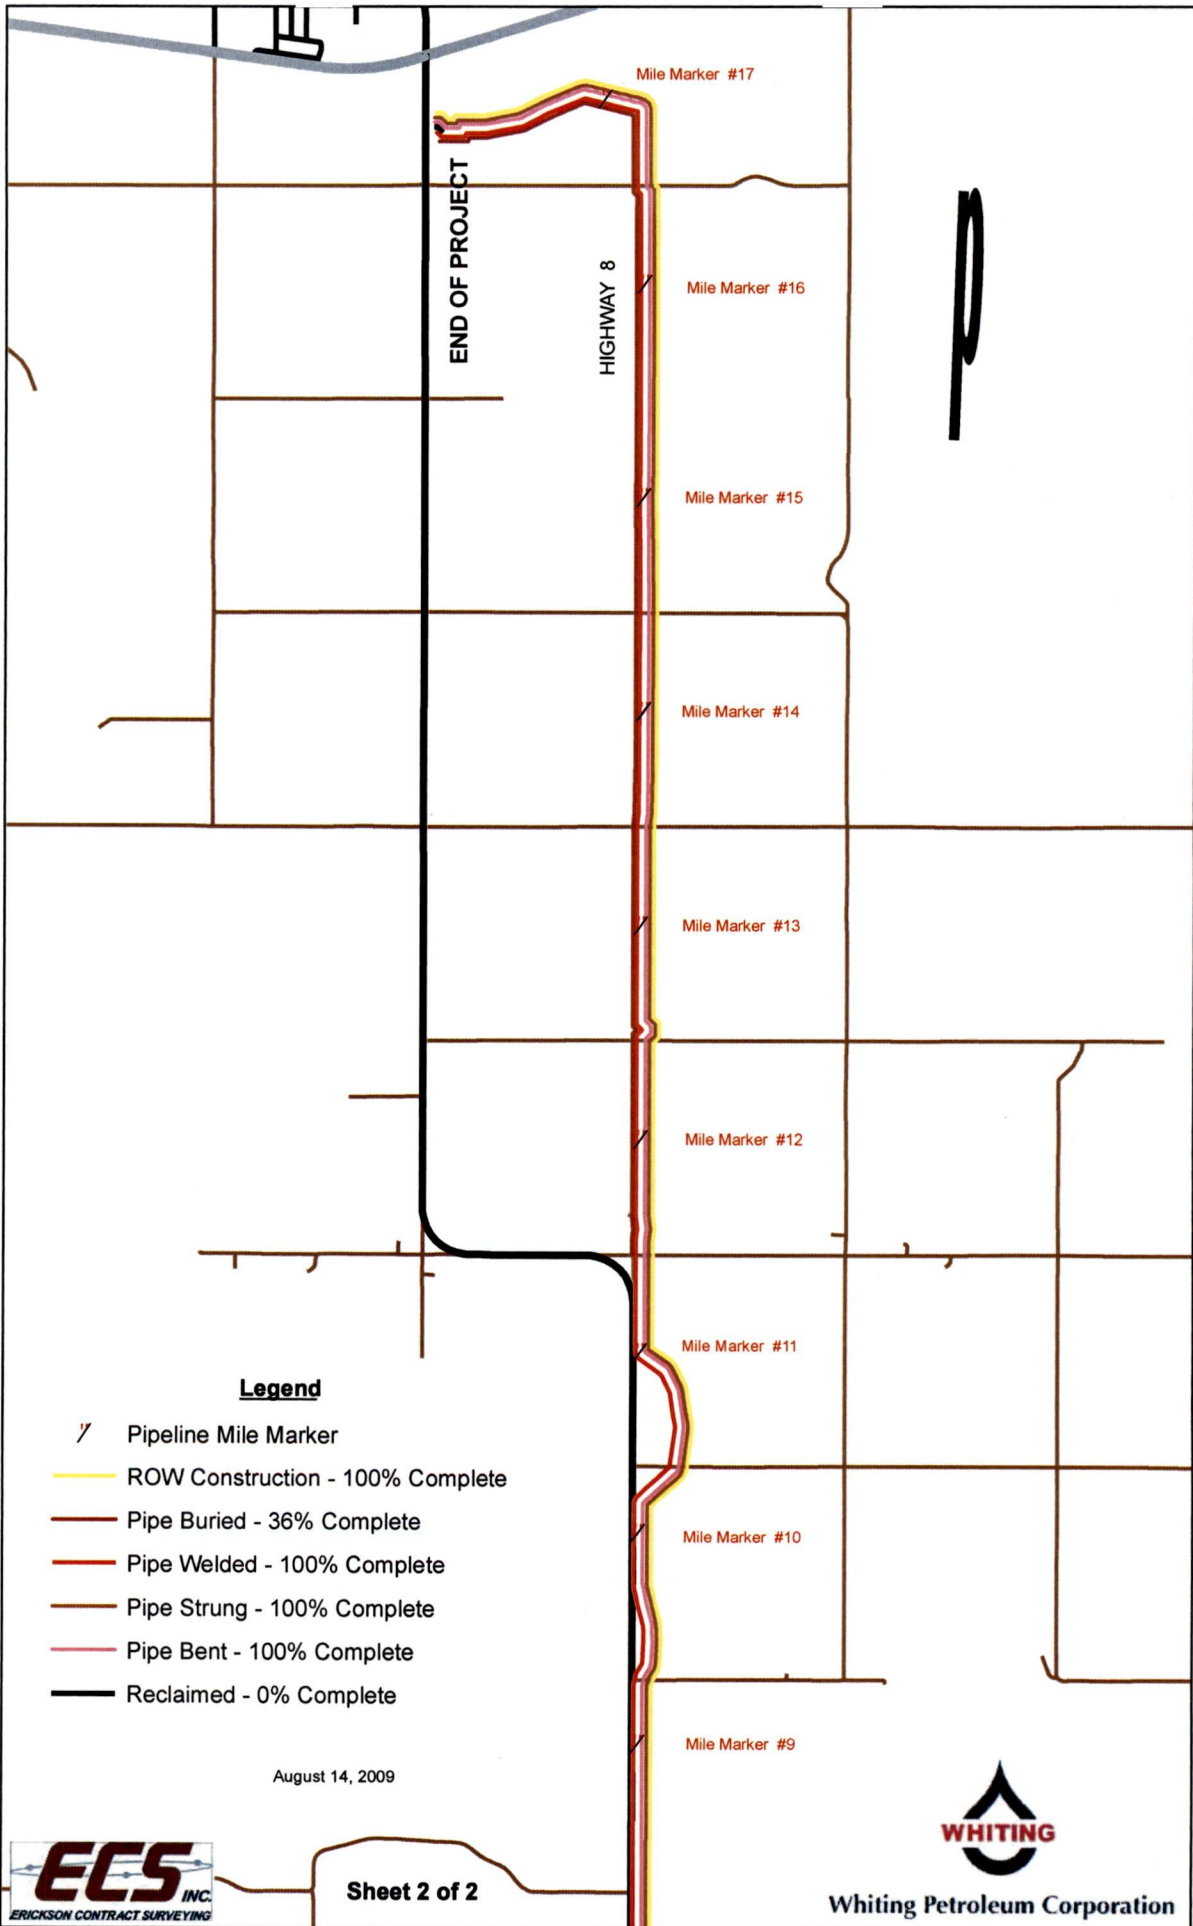


**Legend**

-  Pipeline Mile Marker
-  ROW Construction - 100% Complete
-  Pipe Buried - 36% Complete
-  Pipe Welded - 100% Complete
-  Pipe Strung - 100% Complete
-  Pipe Bent - 100% Complete
-  Reclaimed - 0% Complete





**Legend**

-  Pipeline Mile Marker
-  ROW Construction - 100% Complete
-  Pipe Buried - 36% Complete
-  Pipe Welded - 100% Complete
-  Pipe Strung - 100% Complete
-  Pipe Bent - 100% Complete
-  Reclaimed - 0% Complete

August 14, 2009