



An Epic Resource

Client:	Whiting Petroleum Corp.
Project:	Nexen 8" pipeline
Location:	Stanley N.D
Job #:	40-0177
AFE / WO #	08-1057

Issue:	
Rev.:	1
By:	WEK
Approved:	
Commission case #	PU-08-844

Estimated Date Complete 9/12/09

Percent Complete to Date 77%

WEATHER 8AM		Sunny	Wednesday, August 19, 2009						WEATHER 4PM		Cloudy	
TEMPERATURE 8AM		53	Equipment		QTY	Hours	Companies On Work Site		TEMPERATURE 4PM		63	
							Supervisors		Operators / Welders		Laborers	
							# People	Hours	# People	Hours	# People	Hours
Mower		1	0	Pearl		2	11					
Blade		1	11	F & D Oil Field Maintenance		4	11	7	11	10	11	
Dozer		2	11									
Track Hoe		6	11									
Side Boom		4	11									
Skidsteer		1	11									
Daily Totals			154	Daily Totals		6	66	7	77	10	110	
Project Totals			2124	Project Totals		157	1731	278	2084	352	3471	

Operation	Date Started	Ft. Today	Ft. To Date	% Complete	Operation	Date Started	Ft. Today	Ft. To Date	% Complete
ROW Mowed	7/13/2009	0	94404	100%	Trenching	7/30/2009	5200	52462	56%
ROW Built	7/13/2009	0	94404	100%	Lower In	7/30/2009	5200	52462	56%
Stringing	7/15/2009	0	94404	100%	Backfill	7/30/2009	5200	52462	56%
Bending	7/19/2009	0	94404	100%	Clean Up	8/15/2009	4400	9900	16%
Welding	7/27/2009	0	94404	100%					

X - Ray	# Today	# To Date	Company	Daily Cost	Total Cost to Date
Line Welds	0	2080	N/A Per Client Request	\$0.00	\$0.00
Tie in's	5	70			
Repairs	0	96			
Cut outs	0	2			

RECORD OF DAYS EVENTS

Trenched, lowered in and backfilled 5200'. Had 5 tie in welds. Did 4400' of clean up.

NEXT DAYS WORK

Continue trenching, lowering in, backfilling and clean up.

SAFETY REVIEW

Moving equipment.

VISITORS

None

Bill Kovar
SITF MANAGER

PEARL

An Epic Resource

Client:	Whiting Petroleum Corp.
Project:	Nexen 8" pipeline
Location:	Stanley N.D
Job #:	40-0177
AFE / WO #	08-1057

Issue:	
Rev.:	1
By:	WEK
Approved:	
Commission case #	PU-08-844

Estimated Date Complete 9/12/09

Percent Complete to Date 78%

WEATHER 8AM	Sunny	Thursday, August 20, 2009						WEATHER 4PM	Cloudy
TEMPERATURE 8AM	56							TEMPERATURE 4PM	66
Equipment	QTY	Hours	Companies On Work Site	Supervisors		Operators / Welders		Laborers	
				# People	Hours	# People	Hours	# People	Hours
Mower	1	0	Pearl	2	11				
Blade	1	11	F & D Oil Field Maintenance	4	11	7	11	10	11
Dozer	2	11							
Track Hoe	6	11							
Side Boom	4	11							
Skidsteer	1	11							
Daily Totals		154	Daily Totals	6	66	7	77	10	110
Project Totals		2278	Project Totals	163	1797	285	2161	362	3581

Operation	Date Started	Ft. Today	Ft. To Date	% Complete	Operation	Date Started	Ft. Today	Ft. To Date	% Complete
ROW Mowed	7/13/2009	0	94404	100%	Trenching	7/30/2009	5500	57962	61%
ROW Built	7/13/2009	0	94404	100%	Lower In	7/30/2009	5500	57962	61%
Stringing	7/15/2009	0	94404	100%	Backfill	7/30/2009	5500	57962	61%
Bending	7/19/2009	0	94404	100%	Clean Up	8/15/2009	6000	15900	25%
Welding	7/27/2009	0	94404	100%					

X - Ray	# Today	# To Date	Company	Daily Cost	Total Cost to Date
Line Welds	0	2080	N/A Per Client Request	\$0.00	\$0.00
Tie in's	5	75			
Repairs	0	96			
Cut outs	0	2			

RECORD OF DAYS EVENTS

Trenched,lowered in and backfilled 5500'. Had 5 tie in welds. Did 6000' of clean up.

NEXT DAYS WORK

Continue trenching, lowering in, backfilling and clean up.


SAFETY REVIEW

AC Current in pipeline.





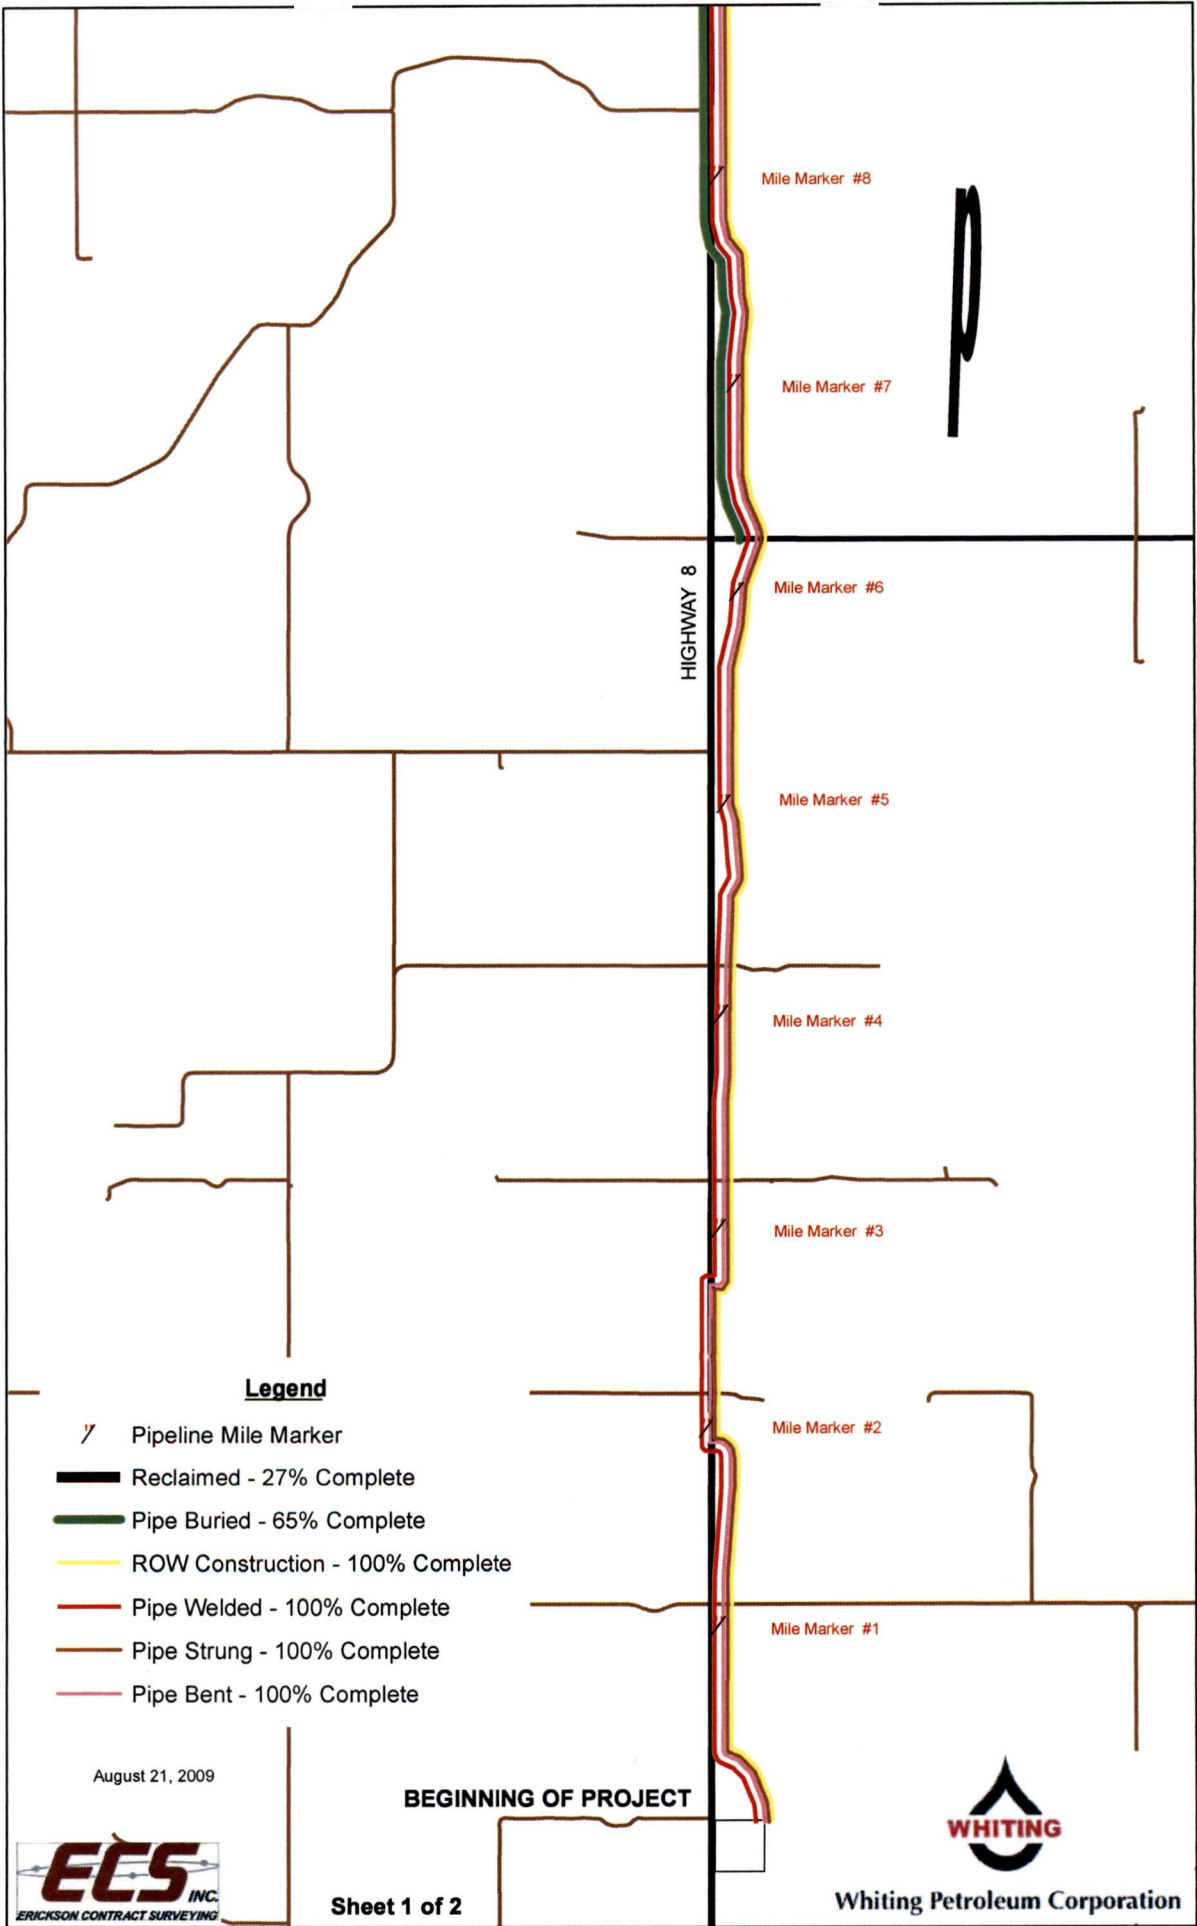


VISITORS

None

Bill Kovar
SITE MANAGER




Legend

-  Pipeline Mile Marker
-  Reclaimed - 27% Complete
-  Pipe Buried - 65% Complete
-  ROW Construction - 100% Complete
-  Pipe Welded - 100% Complete
-  Pipe Strung - 100% Complete
-  Pipe Bent - 100% Complete

August 21, 2009

BEGINNING OF PROJECT



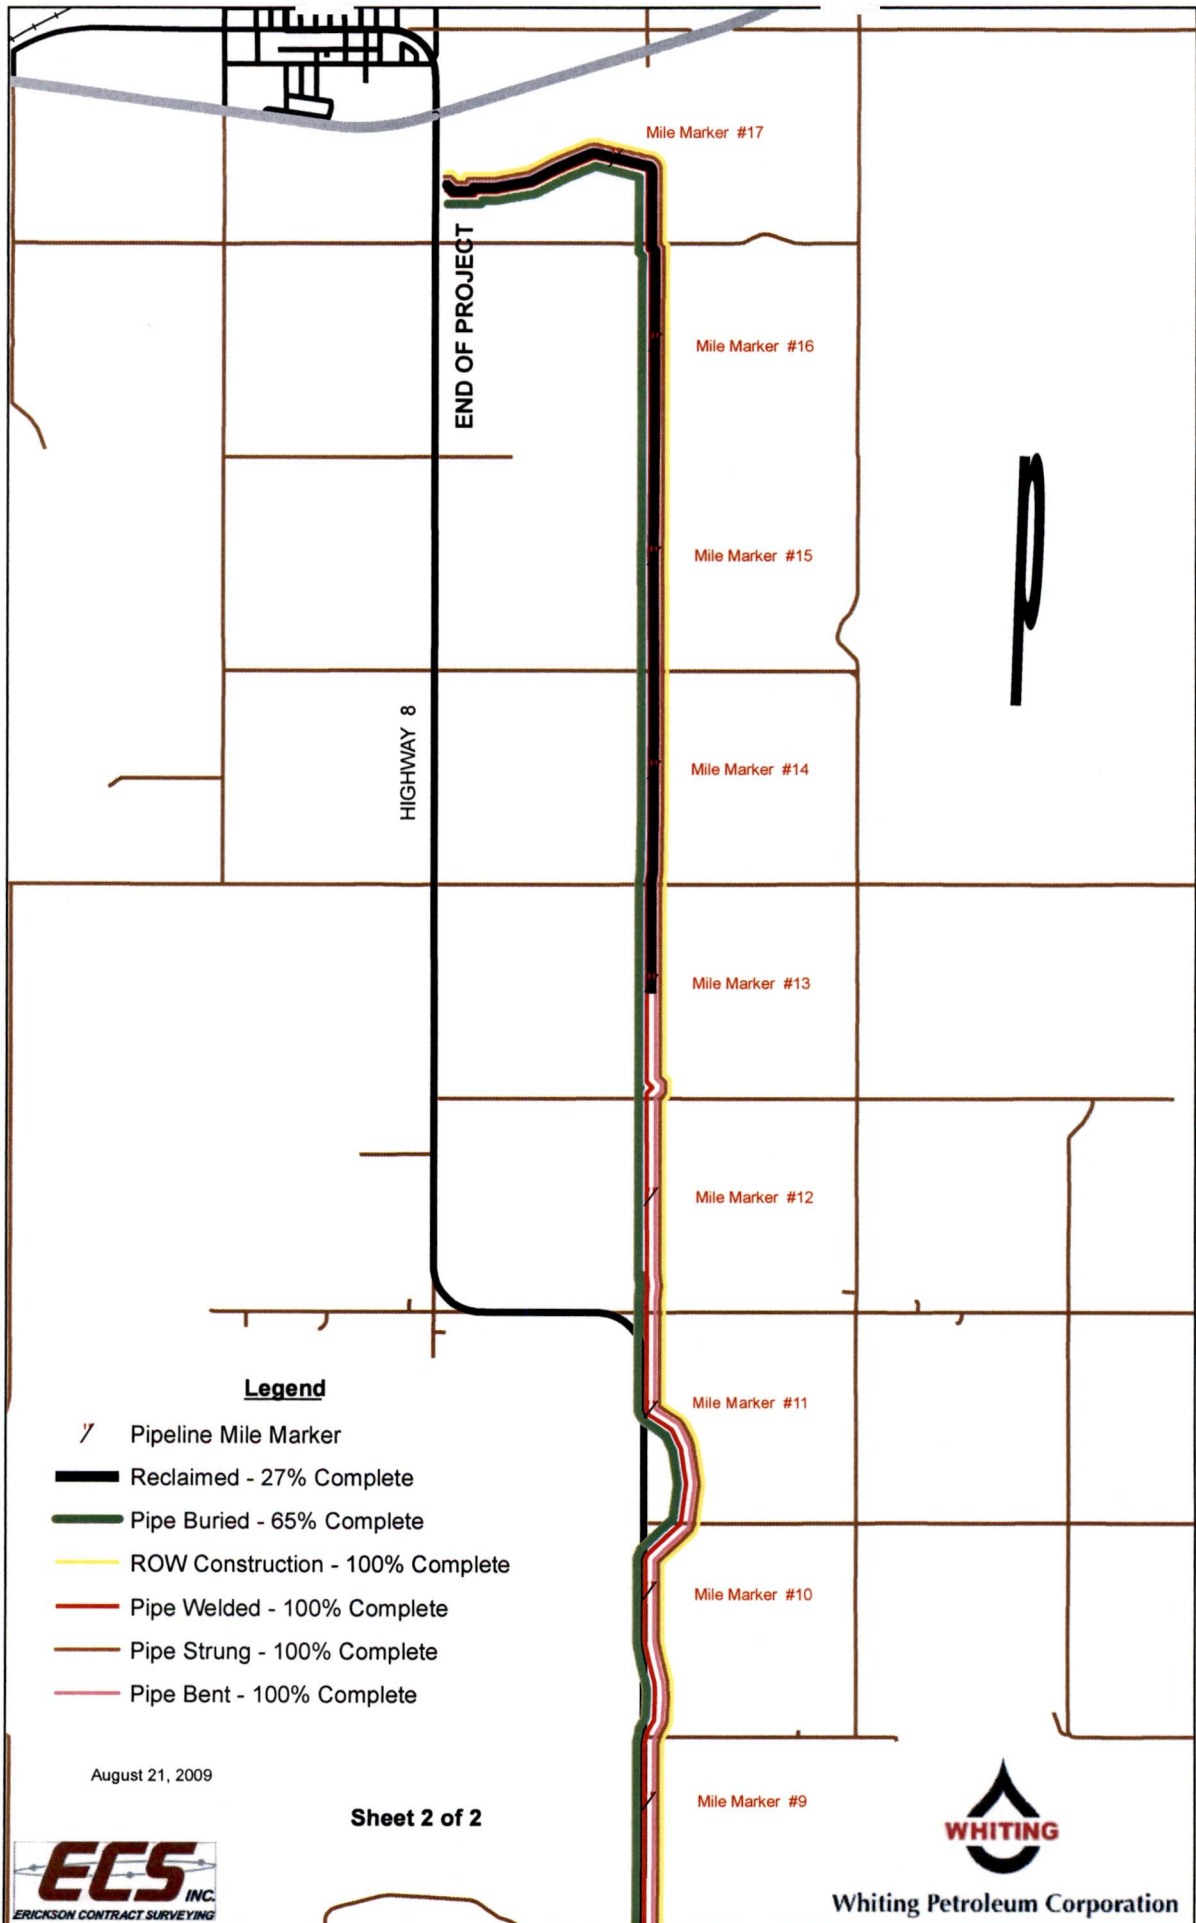

END OF PROJECT

HIGHWAY 8

Mile Marker #17

Mile Marker #16

Mile Marker #15

Mile Marker #14

Mile Marker #13








Mile Marker #12

Mile Marker #11

Mile Marker #10

Mile Marker #9

Legend

-  Pipeline Mile Marker
-  Reclaimed - 27% Complete
-  Pipe Buried - 65% Complete
-  ROW Construction - 100% Complete
-  Pipe Welded - 100% Complete
-  Pipe Strung - 100% Complete
-  Pipe Bent - 100% Complete

August 21, 2009

Sheet 2 of 2



Whiting Petroleum Corporation