

Hamre, John G.

From: Fahn, Patrick J.
Sent: Tuesday, September 01, 2009 9:24 AM
To: Hamre, John G.
Subject: FW: Emailing: Oil Discharge Line Weekly Status Map - 090831 (PU-08-844)
Attachments: Oil Discharge Line Weekly Status Map - 090831.pdf

John - please docket in 08-844 from Whiting and then forward to Commissioners, PUD, and Legal

Patrick Fahn
Director-Compliance and Competitive Markets
Email: pfahn@nd.gov
Phone: (701) 328-4077

North Dakota Public Service Commission
600 E Boulevard
Bismarck ND 58505-0480
Fax: (701) 328-2410

-----Original Message-----

From: Steve Meagher [mailto:Steve.Meagher@whiting.com]
Sent: Monday, August 31, 2009 12:39 PM
To: Brent Miller; Fahn, Patrick J.; William Herrmann; Rick Ross; bregan@merjent.com
Subject: FW: Emailing: Oil Discharge Line Weekly Status Map - 090831 (PU-08-844)


Things are going well we should have the bulk of the line in this week, just ends left,

From: Mike Madler [mailto:mike.madler@ecs-gps.com]
Sent: Mon 8/31/2009 10:47 AM
To: Steve Meagher
Subject: Emailing: Oil Discharge Line Weekly Status Map - 090831





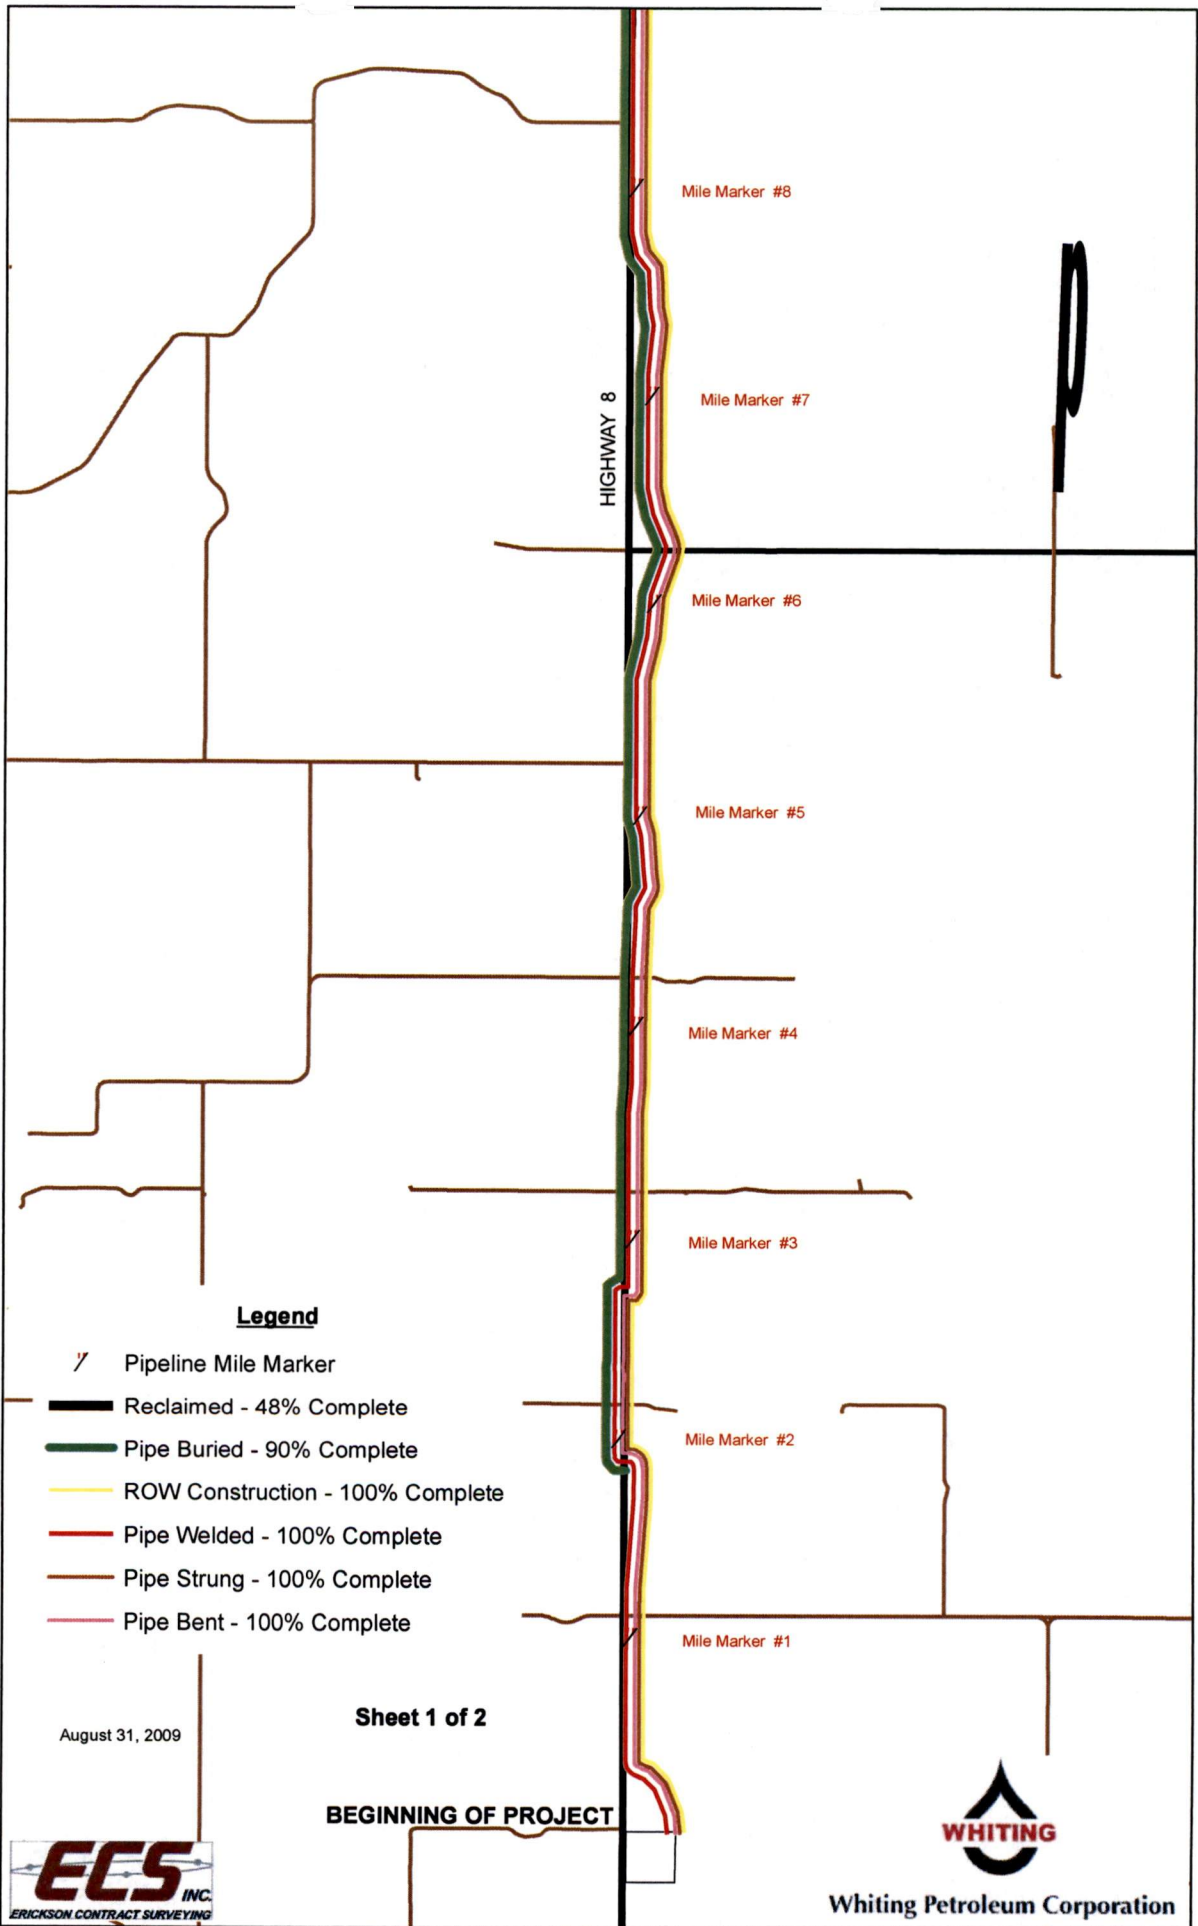


The message is ready to be sent with the following file or link attachments:

Oil Discharge Line Weekly Status Map - 090831

Note: To protect against computer viruses, e-mail programs may prevent sending or receiving certain types of file attachments. Check your e-mail security settings to determine how attachments are handled.



Legend

-  Pipeline Mile Marker
-  Reclaimed - 48% Complete
-  Pipe Buried - 90% Complete
-  ROW Construction - 100% Complete
-  Pipe Welded - 100% Complete
-  Pipe Strung - 100% Complete
-  Pipe Bent - 100% Complete


August 31, 2009

Sheet 1 of 2





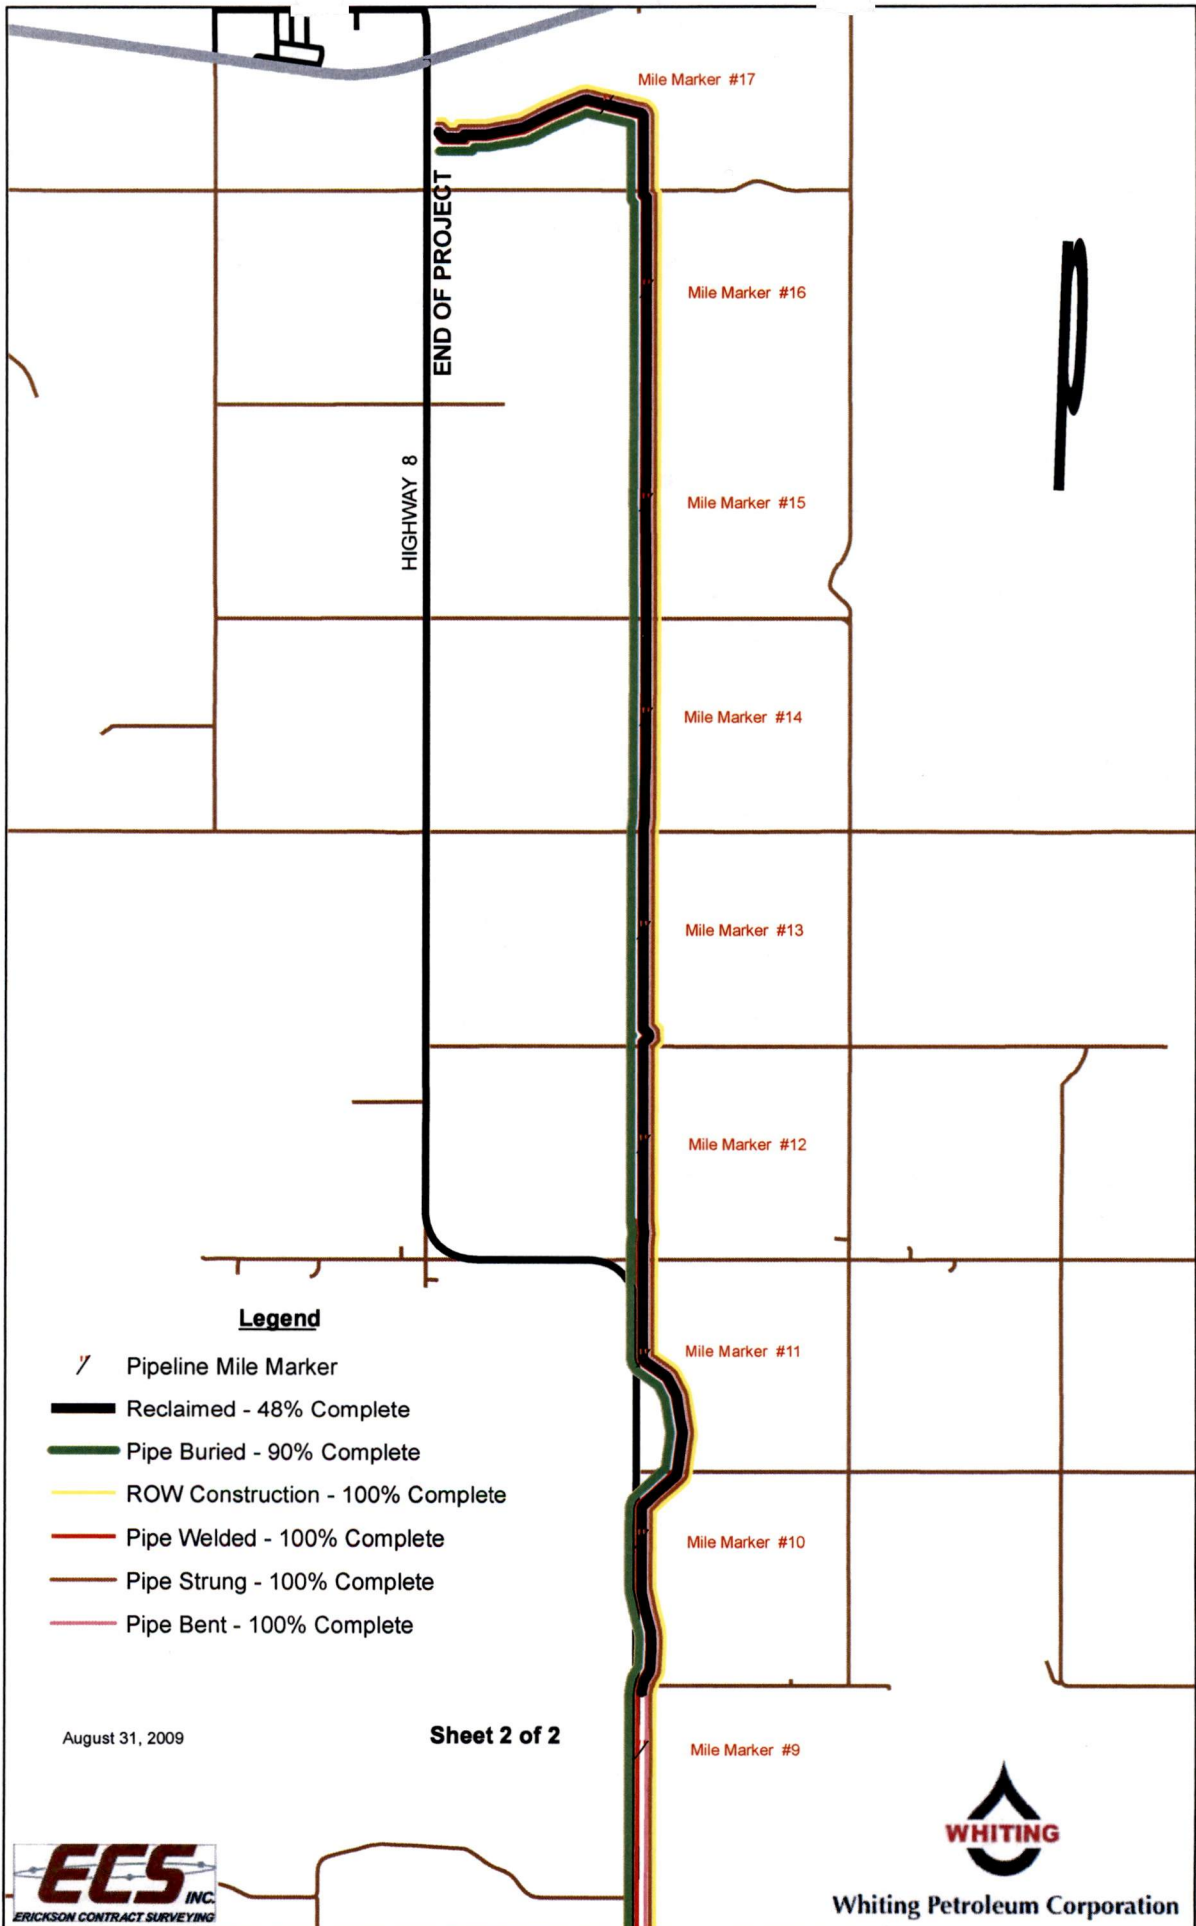


BEGINNING OF PROJECT



Whiting Petroleum Corporation



Legend

-  Pipeline Mile Marker
-  Reclaimed - 48% Complete
-  Pipe Buried - 90% Complete
-  ROW Construction - 100% Complete
-  Pipe Welded - 100% Complete
-  Pipe Strung - 100% Complete
-  Pipe Bent - 100% Complete

August 31, 2009

Sheet 2 of 2



Whiting Petroleum Corporation