


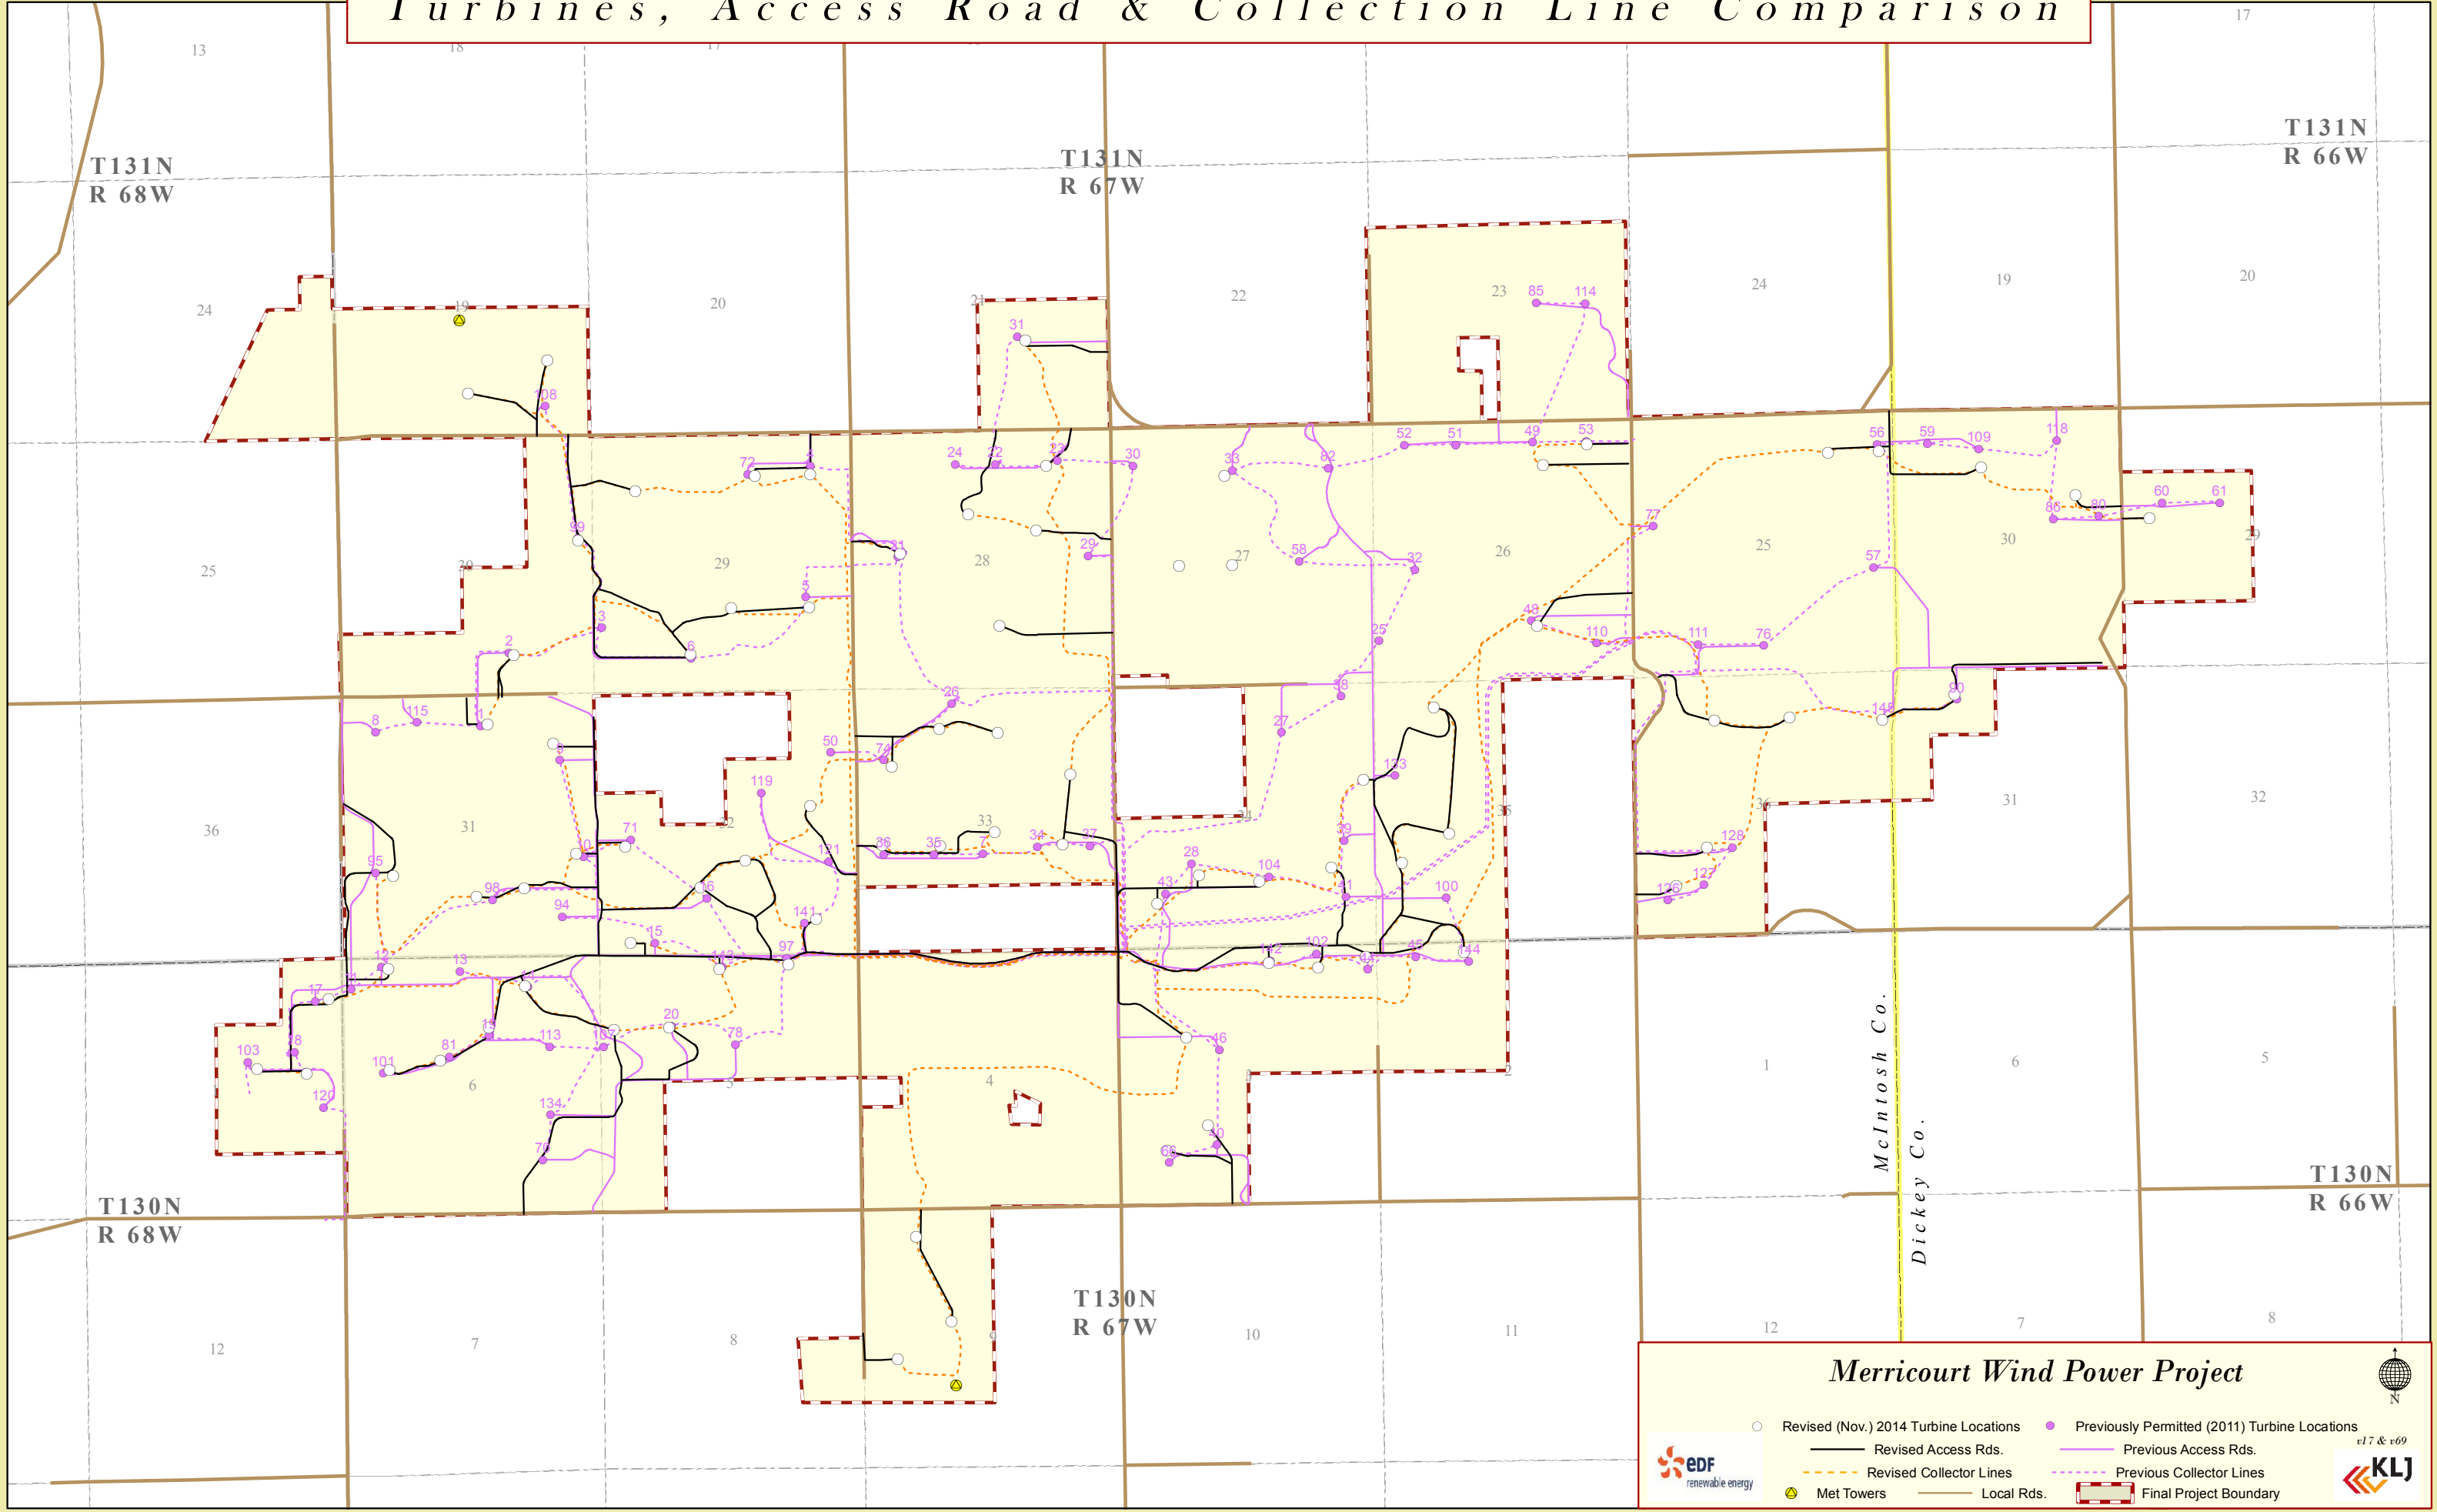

Turbines, Access Road & Collection Line Comparison



Merricourt Wind Power Project


 Revised (Nov.) 2014 Turbine Locations Previously Permitted (2011) Turbine Locations
 Revised Access Rds. Previous Access Rds.
 Revised Collector Lines Previous Collector Lines
 Met Towers Local Rds. Final Project Boundary

 N
 v17 & v69
