



 





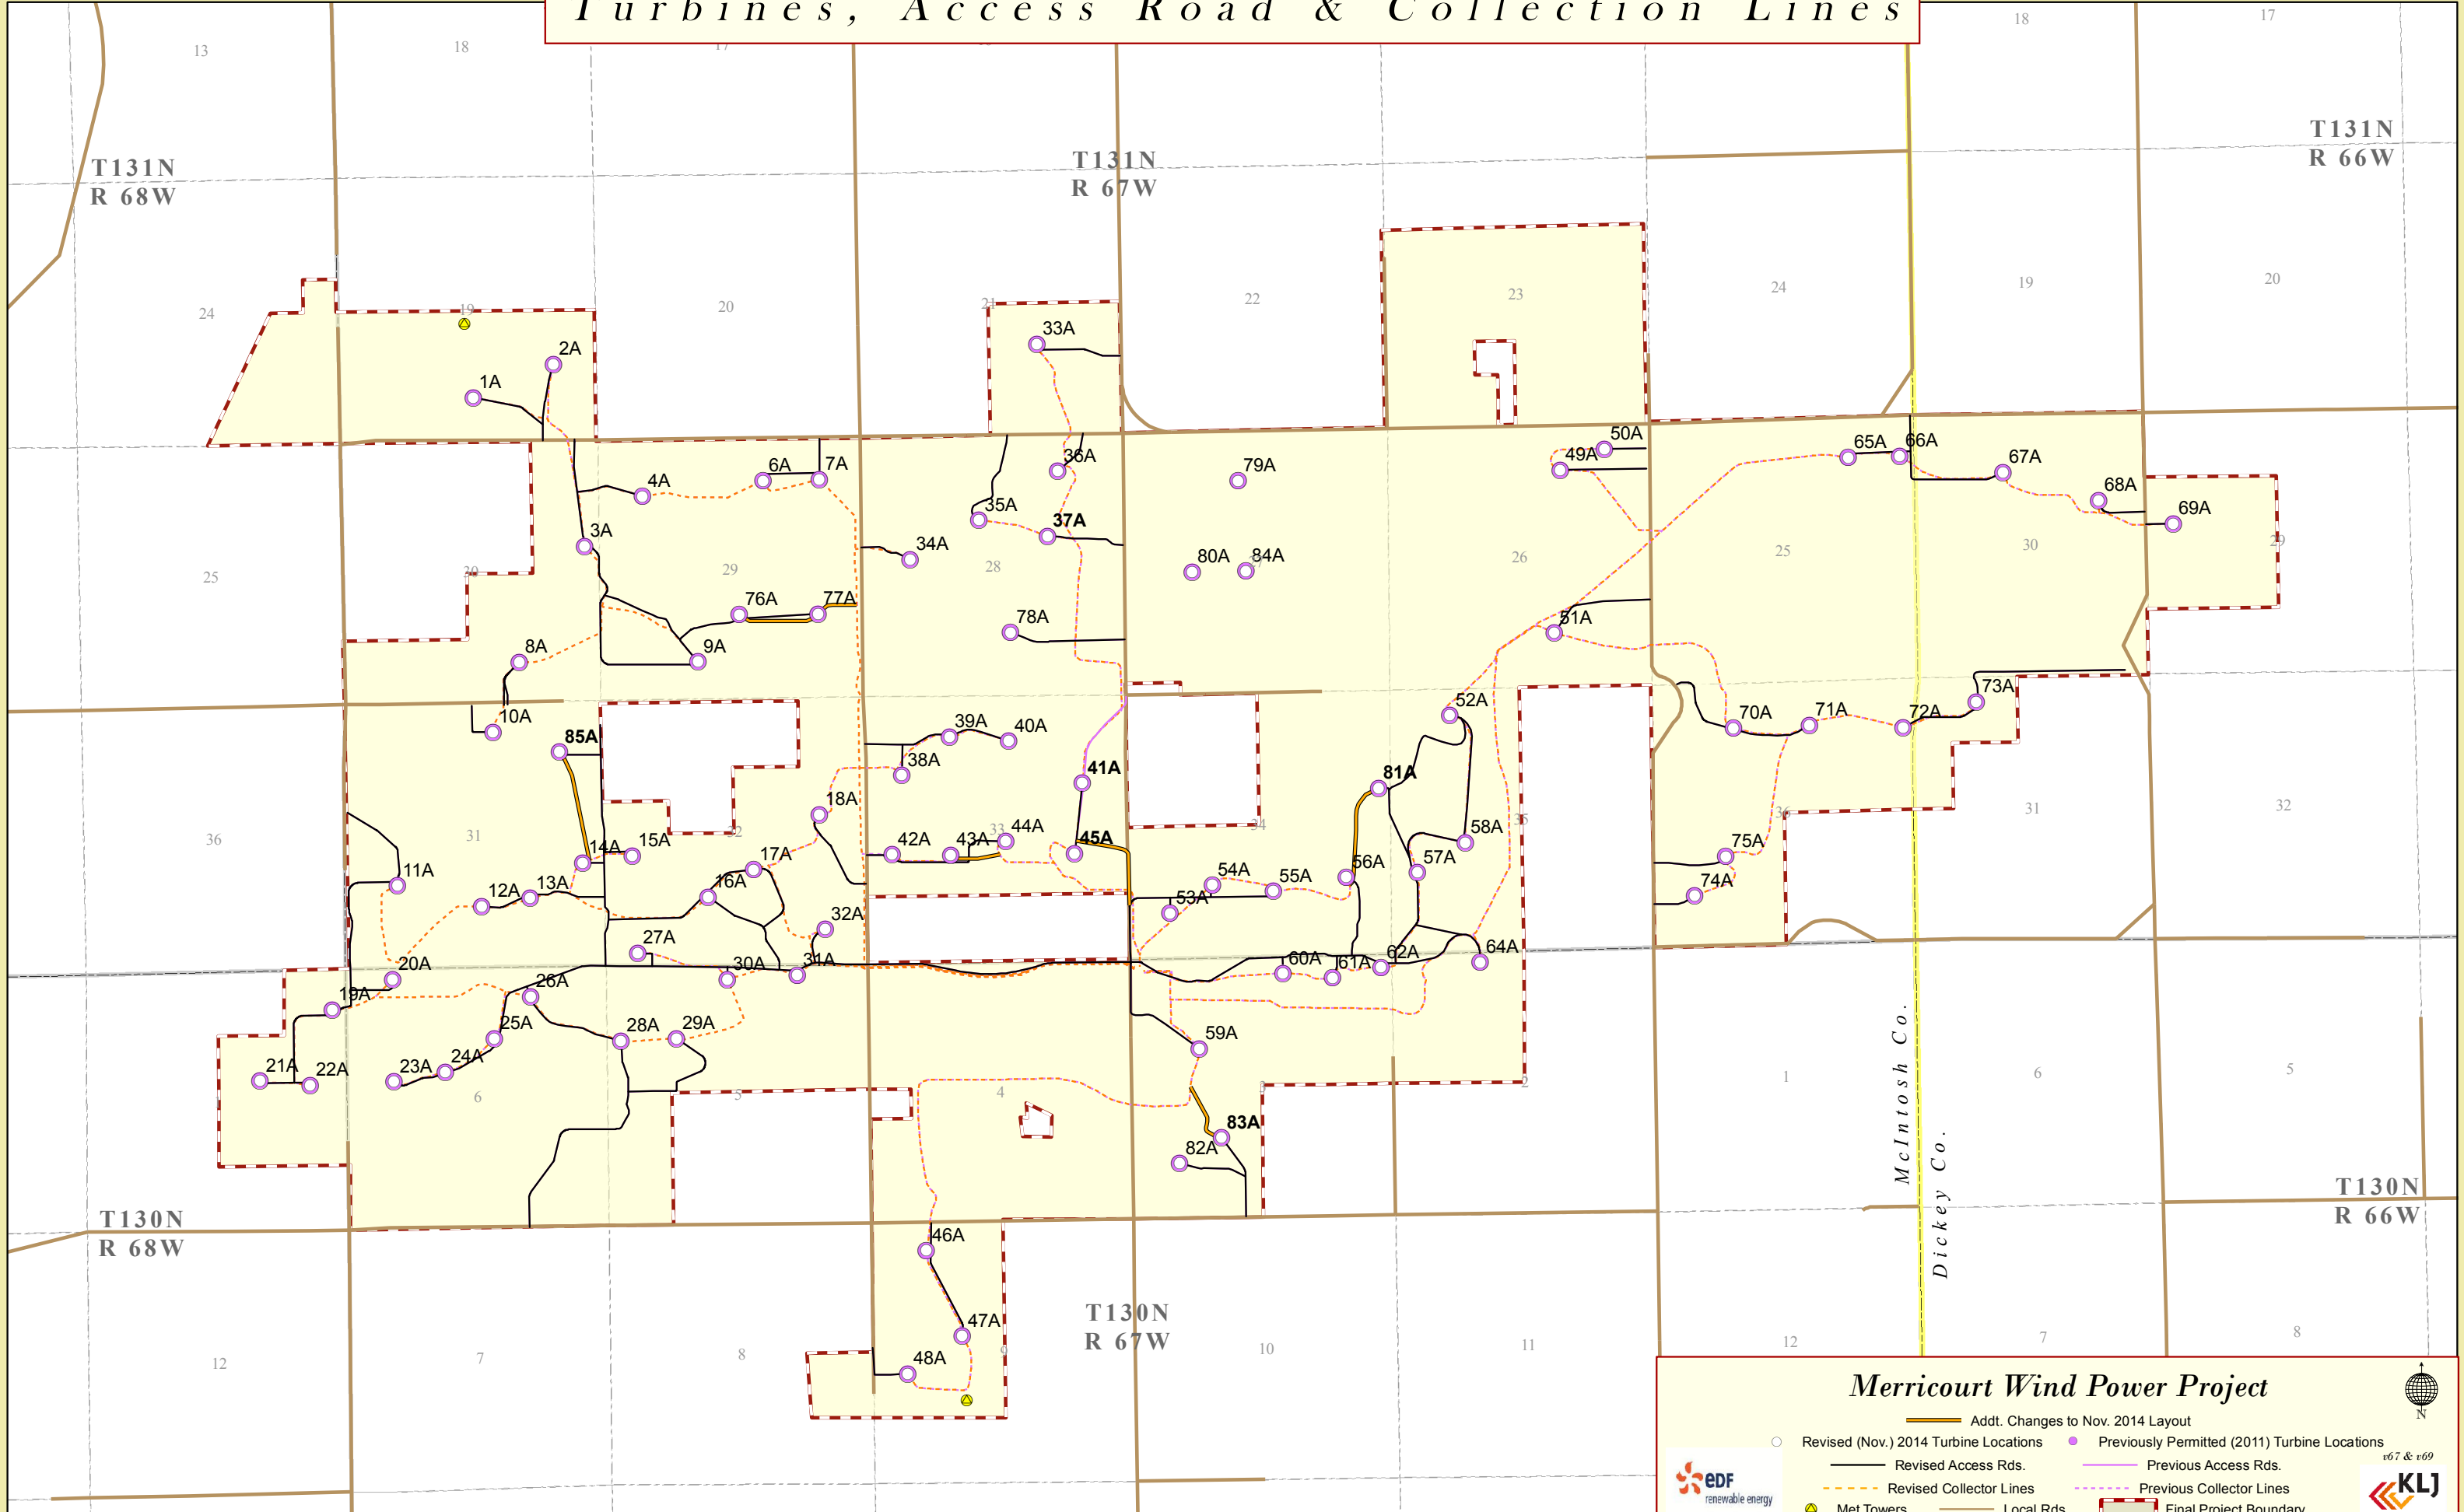


Turbines, Access Road & Collection Lines



Merricourt Wind Power Project

 -  Revised (Nov.) 2014 Turbine Locations
-  Previously Permitted (2011) Turbine Locations
-  Revised Access Rds.
-  Revised Collector Lines
-  Previous Collector Lines
-  Met Towers
-  Local Rds.
-  Final Project Boundary

