


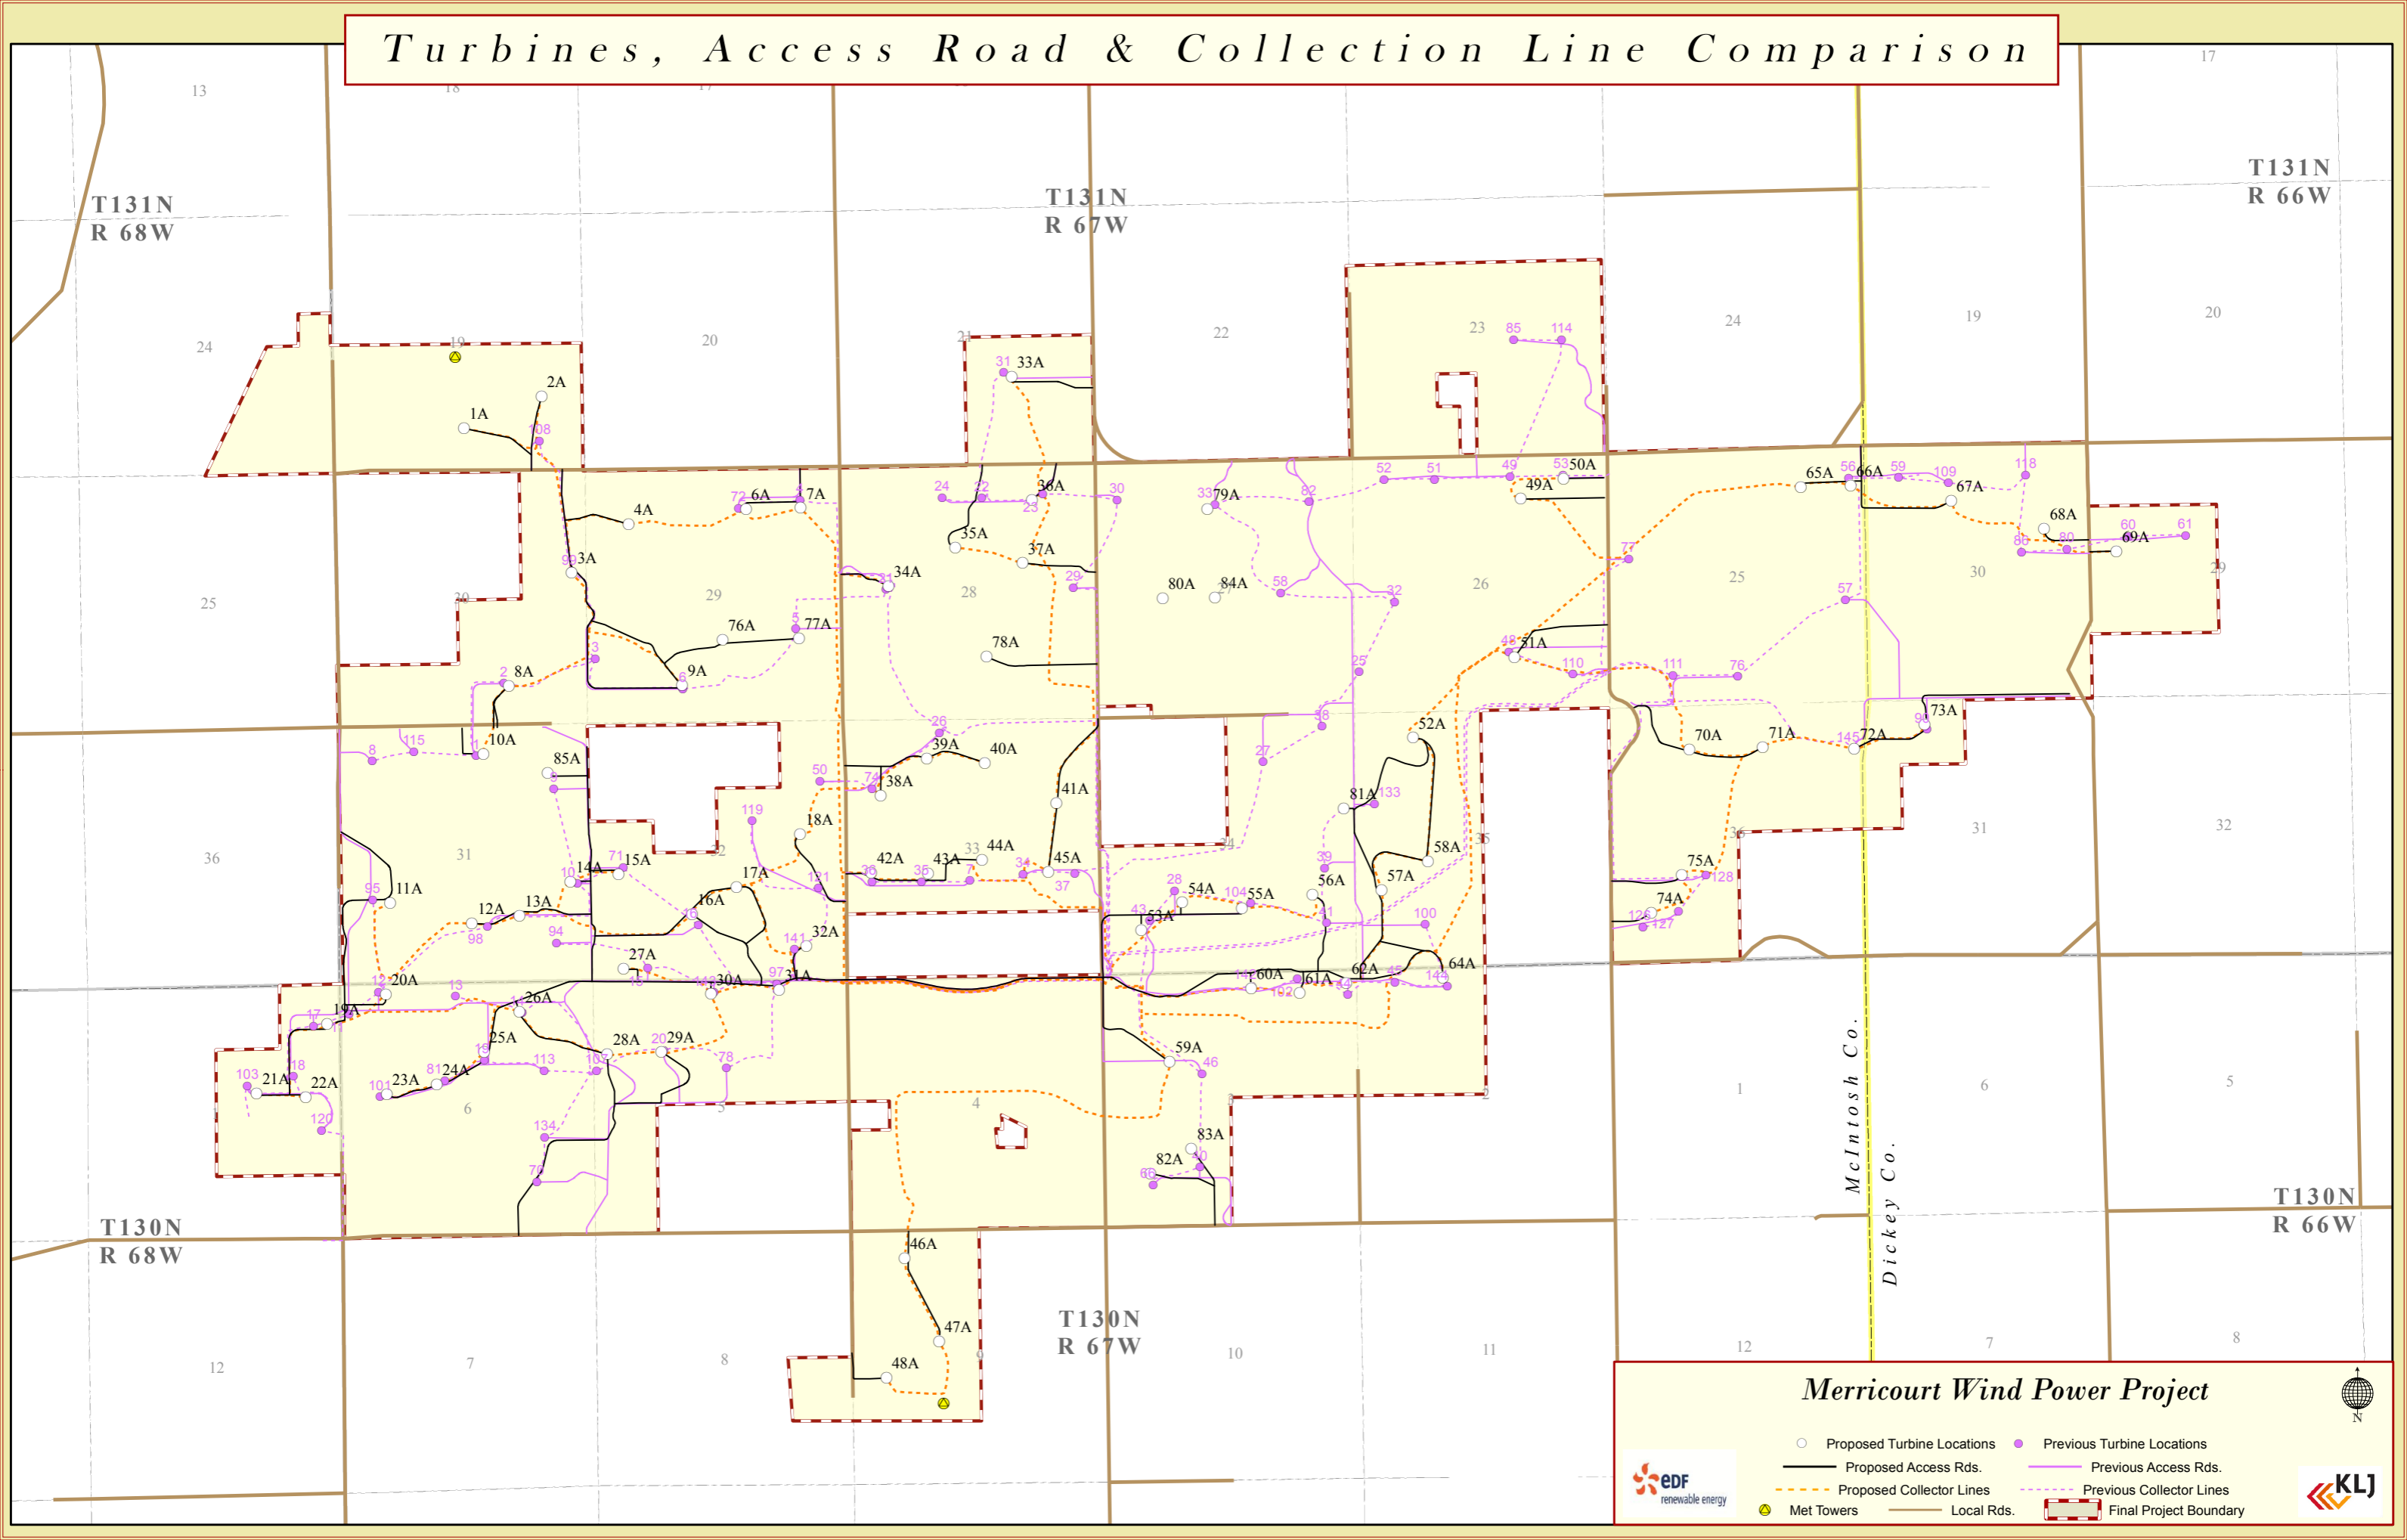


Turbines, Access Road & Collection Line Comparison



Merricourt Wind Power Project

- Proposed Turbine Locations
- Previous Turbine Locations
- Proposed Access Rds.
- Previous Access Rds.
- - - Proposed Collector Lines
- - - Previous Collector Lines
- Met Towers
- Local Rds.
- - - Final Project Boundary