


# Turbines, Access Road & Collection Lines Comparison

**EXHIBIT**  
 16

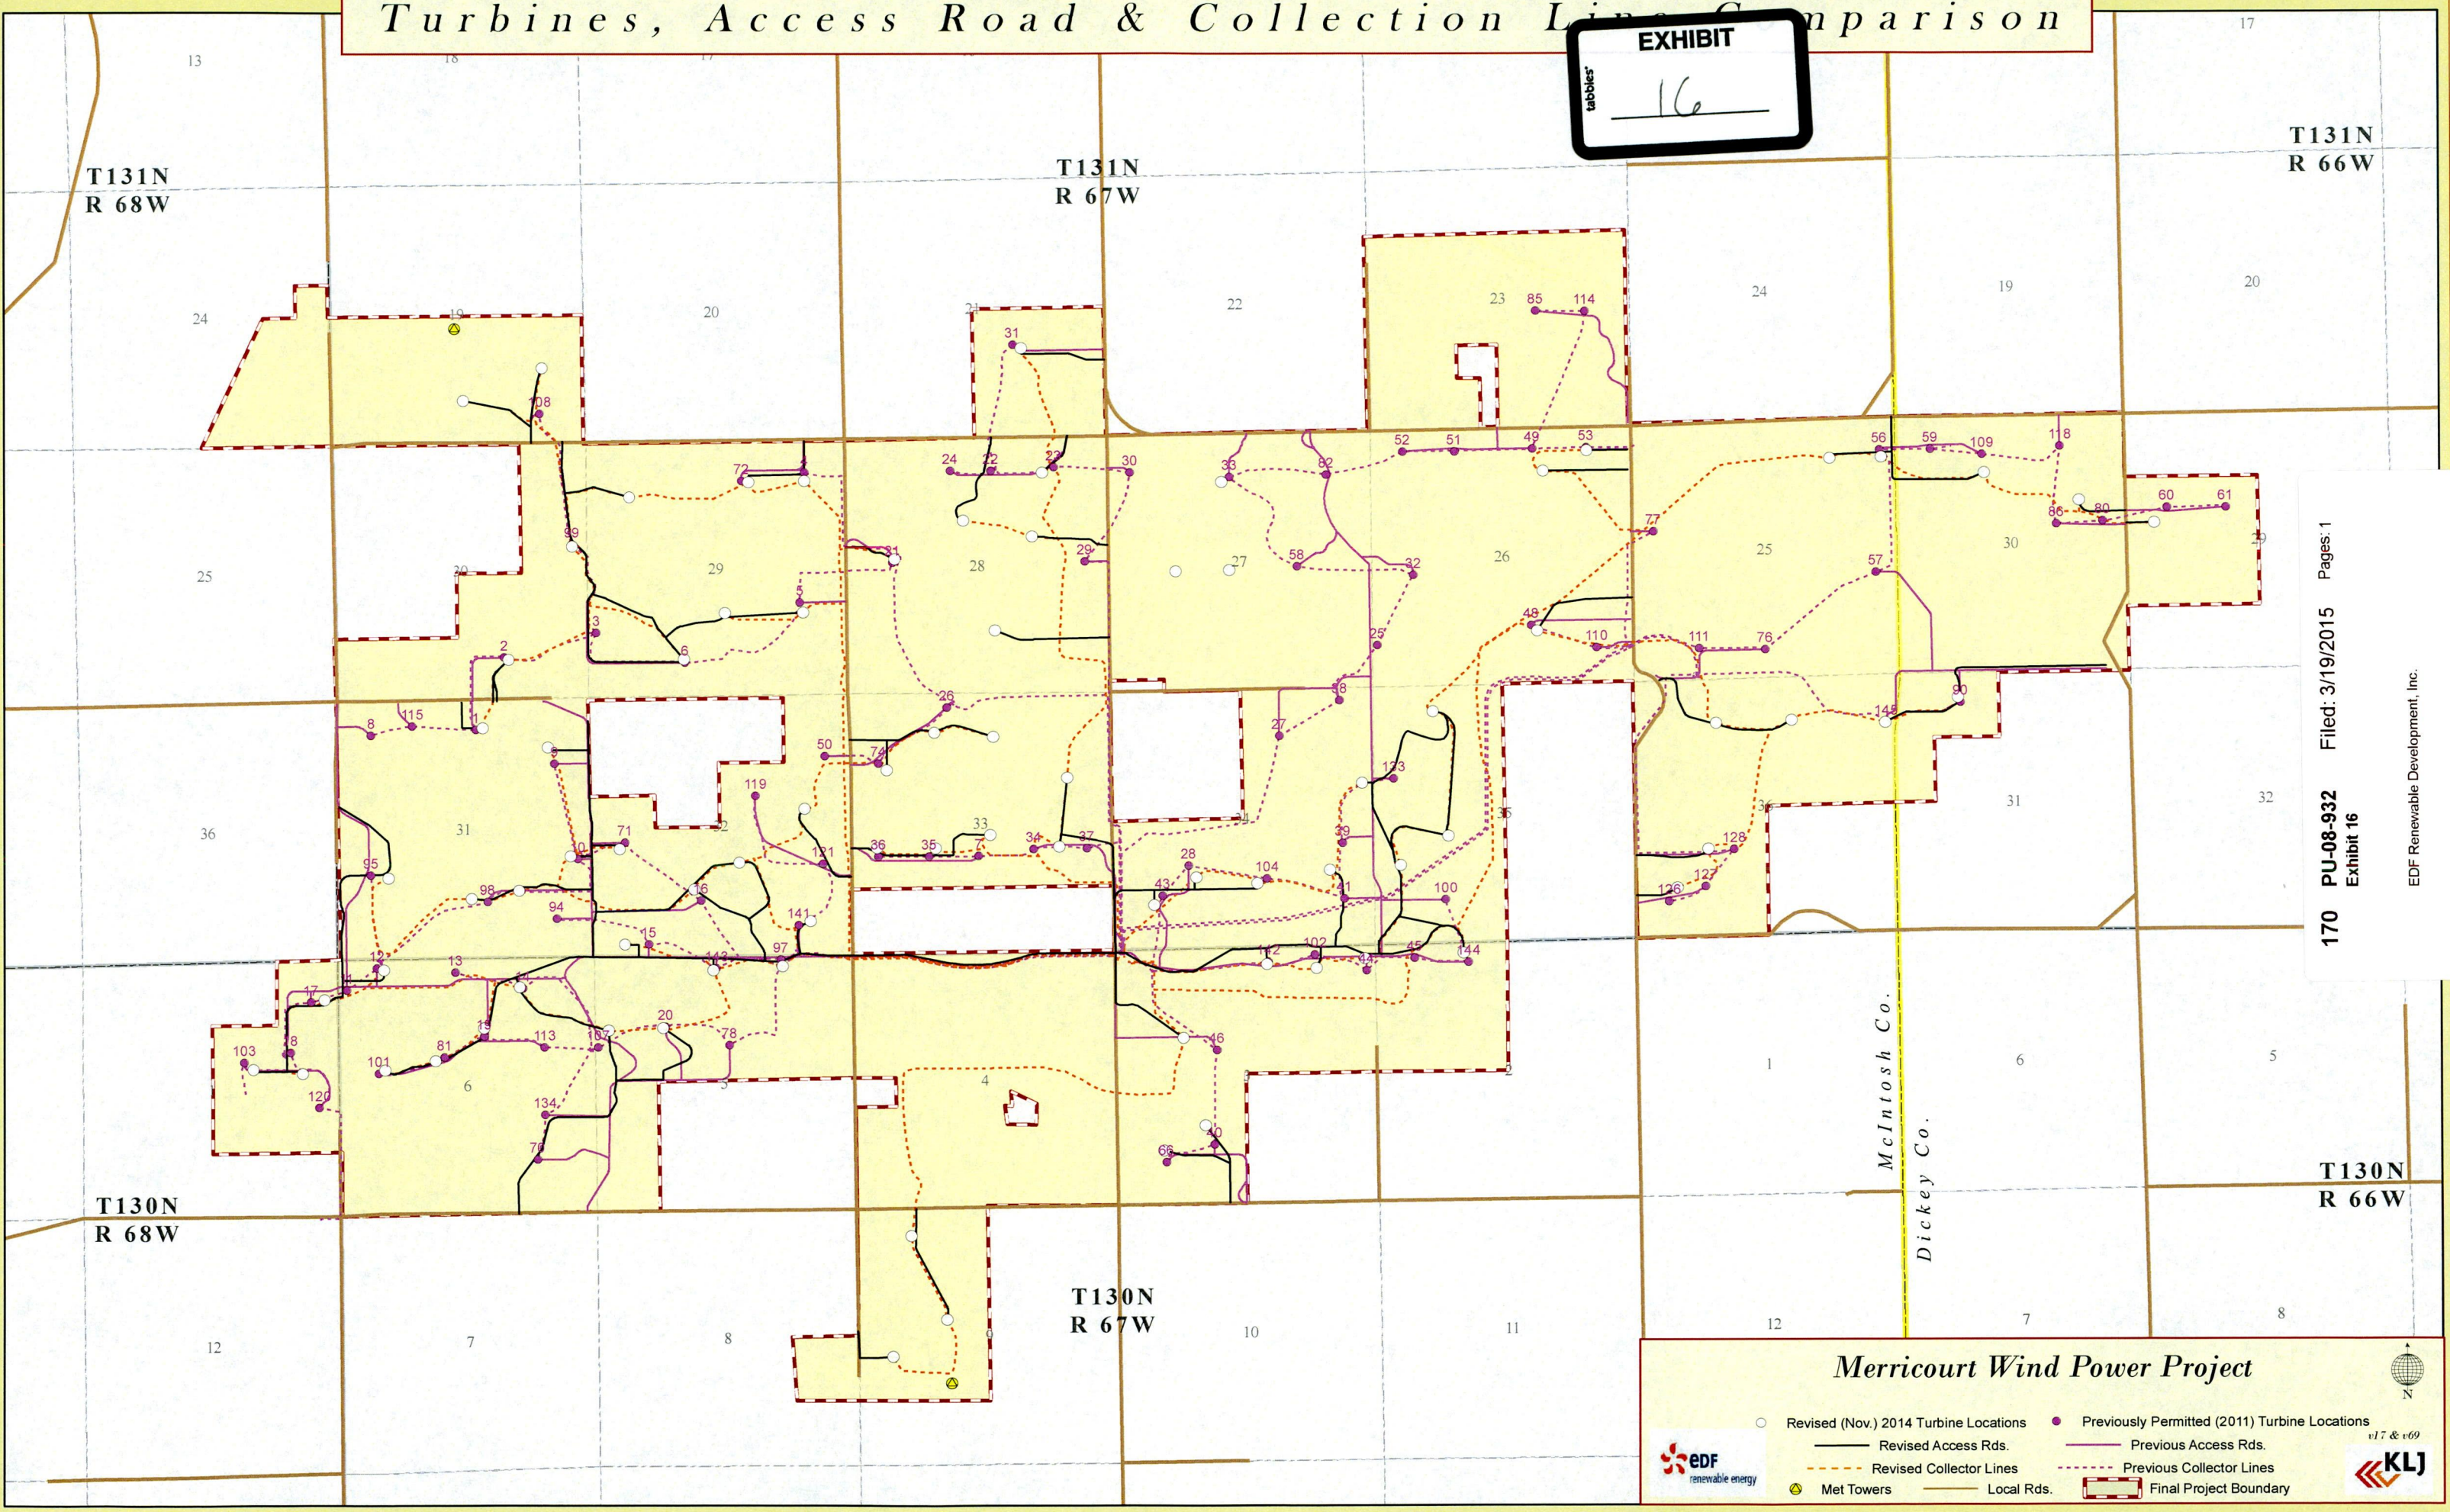

170 PU-08-932 Filed: 3/19/2015 Pages: 1  
 Exhibit 16

EDF Renewable Development, Inc.

**Merricourt Wind Power Project**

- Revised (Nov.) 2014 Turbine Locations
- Previously Permitted (2011) Turbine Locations
- Revised Access Rds.
- Previous Access Rds.
- - - Revised Collector Lines
- - - Previous Collector Lines
- ⊙ Met Towers
- Local Rds.
- - - Final Project Boundary

EDF renewable energy | KLJ | v17 & v69