

Exam Date:04/12/2010

Berthold Farmers Elevator LLC

Page: 1

Examiner: 2

#1 South Main St

Berthold , ND

County:

Phone: 701-453-3431

CCC Number:

Location/Container Numbers/Comments	Section	Capacity
PART A - ADDITIONAL SPACE TO BE INCLUDED UNDER LICENSE		
<NO BINS ADDED>		
		Total: 0

PART B - SPACE TO BE DELETED UNDER LICENSE

004 T	B	3,205
004 B	B	1,647
005 T	B	3,056
005 B	B	1,534
006 T	B	981
006 M	B	1,573
006B	B	1,647
007 T	B	3,157
007 B	B	1,534
008 T	B	3,453
008 B	B	1,806
009	B	3,310
00TB	B	710
010	B	3,691
011 T	B	344
011 B	B	2,998
013	B	2,698
014	B	2,828
015	B	2,698
016	B	2,828
017	B	3,056
018	B	1,546
019	B	3,163
020	B	2,336
021	B	3,738
022 A	B	2,342
022 B	B	1,378
101 T	B	6,340
101 B	B	3,028
102 T	B	6,411
102 B	B	3,101
103 T	B	6,340
103 B	B	3,150
104 T	B	6,411
104 B	B	3,226
105 T	B	5,141
105 B	B	913
106 T	B	3,832

Location/Container Numbers/Comments	Section	Capacity
106 M	B	855
106B	B	593
		Total: 112,598

PART C - ALL SPACE TO BE INCLUDED UNDER LICENSE

A	1,473,000
C	165,000
D	13,000
E	928,000
F	49,000
Total:	2,628,000

PART D - TOTAL CAPACITY BY FUNCTIONAL UNIT

Berthold 1096	A C D	1,651,000
Carpio 1100	E F	977,000
		Total: 2,628,000

Exam Date:04/12/2010
 Examiner: 2

Berthold Farmers Elevator LLC
 #1 South Main St
 Berthold , ND
 County:

Status	Section	Bin Number	Bin Type	Base Point	Diameter or Bu/Ft (Irreg):	Length	Width	Side wall	Add for Hopper	Det. for Obst.	Effective Depth	Add for Peak Capac.	Depth for	Bushels per Foot	Base Pack%	Bushel Capacity with Pack
--------	---------	------------	----------	------------	----------------------------	--------	-------	-----------	----------------	----------------	-----------------	---------------------	-----------	------------------	------------	---------------------------

Facility: Berthold

Section: A

A	001		Square	work floor	0.000	6.200	6.200	65.00	0.00	0.00	65.000	0.000	65.0	30.9	2.50	2,059
A	002		Square	work floor	0.000	12.50	6.000	63.00	0.00	0.00	63.000	0.000	63.0	60.3	4.80	3,981
A	003 T		Square	work floor	0.000	12.50	6.000	67.00	0.00	0.00	67.000	0.000	67.0	60.3	4.80	4,234
A	003 B		Square	work floor -top 67'	0.000	12.50	12.50	15.00	0.00	0.00	15.000	0.000	15.0	125.6	6.50	2,006
A	004		Square	work floor	0.000	12.50	3.500	65.00	0.00	0.00	65.000	0.000	65.0	35.2	3.00	2,357
A	005		Square	work floor	0.000	6.200	6.000	65.00	0.00	0.00	65.000	0.000	65.0	29.9	2.50	1,993
A	006		Square	work floor	0.000	13.00	6.000	65.00	0.00	0.00	65.000	0.000	65.0	62.7	5.00	4,280
A	008		Square	work floor	0.000	6.200	6.000	65.00	0.00	0.00	65.000	0.000	65.0	29.9	2.50	1,993
A	009		Square	work floor	0.000	12.50	12.50	82.00	0.00	0.00	82.000	0.000	82.0	125.6	6.50	10,968
A	010		Square	work floor	0.000	6.000	2.000	65.00	0.00	0.00	65.000	0.000	65.0	9.6	2.00	636
A	011		Square	work floor	0.000	6.000	4.000	65.00	0.00	0.00	65.000	0.000	65.0	19.3	2.00	1,280
A	012 T		Irregular	work floor 6x6.2 with	14.900	0.000	0.000	13.00	0.00	0.00	13.000	0.000	13.0	14.9	2.00	198
A	012 B		Square	work floor -top 13'	0.000	6.200	6.000	52.00	0.00	0.00	52.000	0.000	52.0	29.9	2.50	1,594
A	013		Square	work floor	0.000	6.200	6.200	65.00	0.00	0.00	65.000	0.000	65.0	30.9	2.50	2,059
A	016		Square	work floor	0.000	6.200	6.200	65.00	0.00	0.00	65.000	0.000	65.0	30.9	2.50	2,059
A	017 T		Irregular	work floor- 6x6.2 with	22.200	0.000	0.000	10.00	0.00	0.00	10.000	0.000	10.0	22.2	2.00	226
A	017 B		Square	work floor- top 10'	0.000	6.000	6.200	55.00	0.00	0.00	55.000	0.000	55.0	29.9	2.50	1,686
A	018		Square	work floor	0.000	6.000	6.200	65.00	0.00	0.00	65.000	0.000	65.0	29.9	2.50	1,993
A	019		Square	work floor	0.000	12.50	12.50	82.00	0.00	0.00	82.000	0.000	82.0	125.6	6.50	10,968
A	020		Square	work floor	0.000	6.200	6.000	65.00	0.00	0.00	65.000	0.000	65.0	29.9	2.50	1,993
A	022		Square	work floor	0.000	13.00	6.000	65.00	0.00	0.00	65.000	0.000	65.0	62.7	5.00	4,280

Exam Date:04/12/2010

Berthold Farmers Elevator LLC

Page: 2

Examiner: 2

#1 South Main St

Berthold , ND

County:

Status	Section	Bin Number	Bin Type	Base Point	Diameter or Bu/Ft (Irreg):	Length	Width	Side wall	Add for Hopper	Del. for Obst.	Effective Depth	Add for Peak Capac.	Depth for Foot	Bushels per Foot	Base Pack%	Bushel Capacity with Pack
--------	---------	------------	----------	------------	-------------------------------	--------	-------	--------------	----------------------	----------------------	--------------------	------------------------------	----------------------	------------------------	---------------	------------------------------

Facility: Berthold

Section: A

A		023	Square	work floor	0.000	6.200	6.000	65.00	0.00	0.00	65.000	0.000	65.0	29.9		2.50	1,993
A		024 U	Square	work floor	0.000	12.50	6.000	30.00	0.00	0.00	30.000	0.000	30.0	60.3		4.80	1,896
A		024 L	Square	work floor -blind bin under	0.000	12.50	6.000	33.00	0.00	0.00	33.000	0.000	33.0	60.3		4.80	2,086
A		025	Square	work floor	0.000	12.50	3.500	65.00	0.00	0.00	65.000	0.000	65.0	35.2		3.00	2,357
A		026 T	Square	work floor	0.000	12.50	6.000	67.00	0.00	0.00	67.000	0.000	67.0	60.3		4.80	4,234
A		026 B	Square	work floor-top 67'	0.000	12.50	12.50	15.00	0.00	0.00	15.000	0.000	15.0	125.6		6.50	2,006
A		028	Square	work floor	0.000	6.200	6.200	65.00	0.00	0.00	65.000	0.000	65.0	30.9		2.50	2,059
A		101	Round	work floor -round or	18.000	0.000	0.000	84.00	0.00	0.00	84.000	0.000	84.0	204.6		6.00	18,217
A		102	Round	work floor -round or	18.000	0.000	0.000	84.00	0.00	0.00	84.000	0.000	84.0	204.6		6.00	18,217
A		103	Irregular	work floor	78.000	0.000	0.000	84.00	0.00	0.00	84.000	0.000	84.0	78.0		5.50	6,912
A		104	Irregular	work floor	65.000	0.000	0.000	84.00	0.00	0.00	84.000	0.000	84.0	65.0		5.00	5,733
A		105	Irregular	work floor	78.000	0.000	0.000	86.00	0.00	0.00	86.000	0.000	86.0	78.0		5.50	7,077
A		106	Round	work floor	18.000	0.000	0.000	84.00	0.00	0.00	84.000	0.000	84.0	204.6		6.00	18,217
A		107	Round	work floor	18.000	0.000	0.000	84.00	0.00	0.00	84.000	0.000	84.0	204.6		6.00	18,217
A		108	Irregular	work floor	78.000	0.000	0.000	84.00	0.00	0.00	84.000	0.000	84.0	78.0		5.50	6,912
A		109	Irregular	work floor	65.000	0.000	0.000	84.00	0.00	0.00	84.000	0.000	84.0	65.0		5.00	5,733
A		110	Irregular	work floor	78.000	0.000	0.000	84.00	0.00	0.00	84.000	0.000	84.0	78.0		5.50	6,912
A		111	Round	work floor	18.000	0.000	0.000	84.00	0.00	0.00	84.000	0.000	84.0	204.6		6.00	18,217
A		112	Round	work floor	18.000	0.000	0.000	84.00	0.00	0.00	84.000	0.000	84.0	204.6		6.00	18,217
A		113	Peaked	top of sidewall - roof 12'	47.800	0.000	0.000	69.40	0.00	0.00	69.400	2.900	72.3	1442.5		10.0	114,722
A		114	Peaked	top of sidewall roof is 12'	47.800	0.000	0.000	69.40	0.00	0.00	69.400	2.900	72.3	1442.5		10.0	114,722

Exam Date:04/12/2010

Berthold Farmers Elevator LLC

Examiner: 2

#1 South Main St
Berthold, ND
County:

Status	Section	Bin Number	Bin Type	Base Point	Diameter or Bu/Ft (Irreg):	Length	Width	Side wall	Add for Hopper	Ded. for Obs.	Effective Depth	Add for Peak	Depth for Capac.	Bushels per Foot	Base Pack%	Bushel Capacity with Pack
--------	---------	------------	----------	------------	----------------------------	--------	-------	-----------	----------------	---------------	-----------------	--------------	------------------	------------------	------------	---------------------------

Facility: Berthold

Section: A

A		201	Round	top of slab	34.000	0.000	0.000	139.5	0.00	0.00	139.50	0.000	139.5	729.8	9.80	111,784
A		202	Round	top of slab	34.000	0.000	0.000	139.5	0.00	0.00	139.50	0.000	139.5	729.8	9.80	111,784
A		203	Round	top of slab	34.000	0.000	0.000	136.5	0.00	0.00	136.50	0.000	136.5	729.8	9.80	109,381
A		204	Round	top of slab	34.000	0.000	0.000	136.5	0.00	0.00	136.50	0.000	136.5	729.8	9.80	109,381
A		205	Irregular	top of slab	411.20	0.000	0.000	142.0	0.00	0.00	142.00	0.000	142.0	411.2	8.20	63,178
A		206	Irregular	top of slab	70.300	0.000	0.000	98.50	0.00	0.00	98.500	0.000	98.5	70.3	5.20	7,285
A		207	Irregular	top of slab	70.300	0.000	0.000	98.50	0.00	0.00	98.500	0.000	98.5	70.3	5.20	7,285
A		208	Irregular	top of slab	73.100	0.000	0.000	98.50	0.00	0.00	98.500	0.000	98.5	73.1	5.50	7,596
A		209	Irregular	top of slab	87.300	0.000	0.000	98.50	0.00	0.00	98.500	0.000	98.5	87.3	5.80	9,098
A		210	Irregular	top of slab	73.100	0.000	0.000	98.50	0.00	0.00	98.500	0.000	98.5	73.1	5.50	7,596
A		211	Irregular	top of slab	139.70	0.000	0.000	52.00	0.00	0.00	52.000	0.000	52.0	139.7	6.80	7,758
A		212	Peaked	top of sidewall at eave	49.100	0.000	0.000	88.70	0.00	0.00	88.700	3.400	92.1	1522.1	10.0	154,204
A		213	Peaked	top of sidewall at eave	49.100	0.000	0.000	88.70	0.00	0.00	88.700	3.400	92.1	1522.1	10.0	154,204
A		214	Peaked	top of sidewall at eave	49.100	0.000	0.000	88.70	0.00	0.00	88.700	3.400	92.1	1522.1	10.0	154,204

Bin count: 56

Facility: Berthold Section: A Total: **1,472,237**

To Even: **1,473,000**

Section: C

C		001	Peaked	top of sidewall	18.000	0.000	0.000	15.20	2.00	0.00	17.200	1.100	18.3	204.6	6.00	3,969
C		002	Peaked	top of sidewall	18.000	0.000	0.000	15.20	2.00	0.00	17.200	1.100	18.3	204.6	6.00	3,969

Exam Date:04/12/2010
 Examiner: 2

Berthold Farmers Elevator LLC
 #1 South Main St
 Berthold , ND
 County:

Status	Section	Bin Number	Bin Type	Base Point	Diameter or Bu/Ft (Irreg):	Length	Width	Side wall	Add for Hopper	Dec. for Obst.	Effective Depth	Add for Peak	Depth for Capac.	Bushels per Foot	Base Pack%	Bushel Capacity with Pack
--------	---------	------------	----------	------------	----------------------------	--------	-------	-----------	----------------	----------------	-----------------	--------------	------------------	------------------	------------	---------------------------

Facility: Berthold

Section: C

C	003	Peaked	top of sidewall	18,000	0.000	0.000	15.20	2.00	0.00	17.200	1.100	18.3	204.6	6.00	3,969
C	004	Peaked	top of sidewall	18,000	0.000	0.000	15.20	2.00	0.00	17.200	1.100	18.3	204.6	6.00	3,969
C	005	Peaked	top of sidewall	18,000	0.000	0.000	15.30	2.00	0.00	17.300	1.100	18.4	204.6	6.00	3,991
C	006	Peaked	top of sidewall	18,000	0.000	0.000	15.40	2.00	0.00	17.400	1.100	18.5	204.6	6.00	4,012
C	007	Peaked	top of sidewall	18,000	0.000	0.000	15.40	2.00	0.00	17.400	1.100	18.5	204.6	6.00	4,012
C	008	Peaked	top of sidewall	18,000	0.000	0.000	15.20	2.00	0.00	17.200	1.100	18.3	204.6	6.00	3,969
C	009	Peaked	top of sidewall	18,000	0.000	0.000	15.20	2.00	0.00	17.200	1.100	18.3	204.6	6.00	3,969
C	010	Peaked	top of sidewall	18,000	0.000	0.000	15.20	2.50	0.00	17.700	1.100	18.8	204.6	6.00	4,077
C	011	Peaked	top of sidewall	18,000	0.000	0.000	15.00	2.50	0.00	17.500	1.100	18.6	204.6	6.00	4,034
C	012	Peaked	top of sidewall	18,000	0.000	0.000	13.30	2.50	0.00	15.800	1.100	16.9	204.6	6.00	3,665
C	013	Peaked	top of sidewall	18,000	0.000	0.000	15.30	2.20	0.00	17.500	1.100	18.6	204.6	6.00	4,034
C	014	Peaked	top of sidewall	18,000	0.000	0.000	15.30	2.20	0.00	17.500	1.100	18.6	204.6	6.00	4,034
C	015	Peaked	top of sidewall	18,000	0.000	0.000	15.10	2.20	0.00	17.300	1.100	18.4	204.6	6.00	3,991
C	016	Peaked	top of sidewall	18,000	0.000	0.000	15.30	2.20	0.00	17.500	1.100	18.6	204.6	6.00	4,034
C	017	Peaked	top of sidewall	18,000	0.000	0.000	15.30	2.20	0.00	17.500	1.100	18.6	204.6	6.00	4,034
C	018	Peaked	top of sidewall	18,000	0.000	0.000	15.30	2.20	0.00	17.500	1.100	18.6	204.6	6.00	4,034
C	019	Peaked	top of sidewall	18,000	0.000	0.000	15.30	2.20	0.00	17.500	1.100	18.6	204.6	6.00	4,034
C	020	Peaked	top of sidewall	18,000	0.000	0.000	15.30	2.20	0.00	17.500	1.100	18.6	204.6	6.00	4,034
C	021	Peaked	top of sidewall	18,000	0.000	0.000	15.50	2.50	0.00	18.000	1.100	19.1	204.6	6.00	4,142
C	022	Peaked	top of sidewall	18,000	0.000	0.000	15.60	2.50	0.00	18.100	1.100	19.2	204.6	6.00	4,164
C	023	Peaked	top of sidewall	18,000	0.000	0.000	15.50	2.50	0.00	18.000	1.100	19.1	204.6	6.00	4,142

Exam Date:04/12/2010
 Examiner: 2

Berthold Farmers Elevator LLC
 #1 South Main St
 Berthold , ND
 County:

Status	Section	Bin Number	Bin Type	Base Point	Diameter or Bu/Ft (Irreg):	Length	Width	Side wall	Add for Hopper	Ded. for Obst.	Effective Depth	Add for Peak	Depth for Capac.	Bushels per Foot	Base Pack%	Bushel Capacity with Pack
--------	---------	------------	----------	------------	----------------------------	--------	-------	-----------	----------------	----------------	-----------------	--------------	------------------	------------------	------------	---------------------------

Facility: Berthold

Section: C

C	024	Peaked	top of sidewall	18,000	0.000	0.000	15.60	2.50	0.00	18.100	1.100	19.2	204.6	6.00	4,164
C	025	Peaked	top of sidewall	18,000	0.000	0.000	15.80	2.50	0.00	18.300	1.100	19.4	204.6	6.00	4,207
C	026	Peaked	top of sidewall	18,000	0.000	0.000	15.60	2.50	0.00	18.100	1.100	19.2	204.6	6.00	4,164
C	027	Peaked	top of sidewall	18,000	0.000	0.000	15.10	2.50	0.00	17.600	1.100	18.7	204.6	6.00	4,056
C	028	Peaked	top of sidewall	18,000	0.000	0.000	16.00	0.00	0.00	16.000	1.100	17.1	204.6	6.00	3,709
C	029	Peaked	top of sidewall	18,000	0.000	0.000	16.00	0.00	0.00	16.000	1.100	17.1	204.6	6.00	3,709
C	030	Peaked	top of sidewall	18,000	0.000	0.000	16.00	0.00	0.00	16.000	1.100	17.1	204.6	6.00	3,709
C	031	Peaked	top of sidewall	18,000	0.000	0.000	16.00	0.00	0.00	16.000	1.100	17.1	204.6	6.00	3,709
C	032	Peaked	top of sidewall	18,000	0.000	0.000	16.00	0.00	0.00	16.000	1.100	17.1	204.6	6.00	3,709
C	033	Peaked	top of sidewall	18,000	0.000	0.000	16.00	0.00	0.00	16.000	1.100	17.1	204.6	6.00	3,709
C	034	Peaked	top of sidewall	18,000	0.000	0.000	16.00	0.00	0.00	16.000	1.100	17.1	204.6	6.00	3,709
C	035	Peaked	top of sidewall	18,000	0.000	0.000	16.00	0.00	0.00	16.000	1.100	17.1	204.6	6.00	3,709
C	036	Peaked	top of sidewall	18,000	0.000	0.000	16.00	0.00	0.00	16.000	1.100	17.1	204.6	6.00	3,709
C	037	Peaked	top of sidewall	18,000	0.000	0.000	16.00	0.00	0.00	16.000	1.100	17.1	204.6	6.00	3,709
C	038	Peaked	top of sidewall	18,000	0.000	0.000	16.00	0.00	0.00	16.000	1.100	17.1	204.6	6.00	3,709
C	039	Peaked	top of sidewall	18,000	0.000	0.000	16.00	0.00	0.00	16.000	1.100	17.1	204.6	6.00	3,709
C	040	Peaked	top of sidewall	18,000	0.000	0.000	16.00	0.00	0.00	16.000	1.100	17.1	204.6	6.00	3,709
C	041	Peaked	top of sidewall	18,000	0.000	0.000	16.00	0.00	0.00	16.000	1.100	17.1	204.6	6.00	3,709
C	042	Peaked	top of sidewall	18,000	0.000	0.000	15.20	2.00	0.00	17.200	1.100	18.3	204.6	6.00	3,969

Exam Date:04/12/2010
 Examiner: 2

Berthold Farmers Elevator LLC
 #1 South Main St
 Berthold , ND
 County:

Status	Section	Bin Number	Bin Type	Base Point	Diameter or Bu/Ft (Irreg).	Length	Width	Side wall	Add for Hopper	Ded. for Obst.	Effective Depth	Add for Peak	Depth for Capac.	Bushels per Foot	Base Pack%	Bushel Capacity with Pack
--------	---------	------------	----------	------------	----------------------------	--------	-------	-----------	----------------	----------------	-----------------	--------------	------------------	------------------	------------	---------------------------

Bin count: 42

Facility: Berthold Section: C Total: 164,768

To Even: 165,000

Section: D

D	001	Peaked	top of sidewall	13.500	0.000	0.000	17.50	2.00	0.00	19.500	0.800	20.3	115.1	5.20	2,459
D	002	Peaked	top of sidewall	13.500	0.000	0.000	17.50	2.00	0.00	19.500	0.800	20.3	115.1	5.20	2,459
D	003	Peaked	top of sidewall	14.700	0.000	0.000	15.00	2.20	0.00	17.200	0.900	18.1	136.4	5.50	2,605
D	004	Peaked	top of sidewall	14.700	0.000	0.000	15.00	2.20	0.00	17.200	0.900	18.1	136.4	5.50	2,605
D	005	Peaked	top of sidewall	13.500	0.000	0.000	15.50	2.00	0.00	17.500	0.800	18.3	115.1	5.20	2,216

Bin count: 5

Facility: Berthold Section: D Total: 12,344

To Even: 13,000

Exam Date:04/12/2010
 Examiner: 2

Berthold Farmers Elevator LLC
 #1 South Main St
 Berthold , ND
 County:

Status	Section	Bin Number	Bin Type	Base Point	Diameter or Bu/Ft (Irreg):		Side Length	Add for Hopper	Ded. for Obst.	Effective Depth	Add for Peak	Depth for Capac.	Bushels per Foot	Base Pack%	Bushel Capacity with Pack
					Width	Depth									

Facility: Carpio

Section: E

E	001	Round	top of slab	25.000	0.000	0.000	128.0	0.00	0.00	128.00	0.000	128.0	394.6	8.00	54,550
E	002	Round	top of slab	25.000	0.000	0.000	140.9	0.00	0.00	140.90	0.000	140.9	394.6	8.00	60,047
E	003	Round	top of slab	25.000	0.000	0.000	138.5	0.00	0.00	138.50	0.000	138.5	394.6	8.00	59,024
E	004	Round	top of slab	25.000	0.000	0.000	138.5	0.00	0.00	138.50	0.000	138.5	394.6	8.00	59,024
E	005	Irregular	top of slab 14.6 x 12.1	140.40	13.22	13.22	73.00	0.00	0.00	73.000	0.000	73.0	140.4	6.80	10,946
E	006	Round	top of slab	25.000	0.000	0.000	138.2	0.00	0.00	138.20	0.000	138.2	394.6	8.00	58,897
E	007	Round	top of slab	25.000	0.000	0.000	138.6	0.00	0.00	138.60	0.000	138.6	394.6	8.00	59,067
E	008	Irregular	top of slab 10' x 7' with	54.700	0.000	0.000	118.0	0.00	0.00	118.00	0.000	118.0	54.7	4.50	6,745
E	009	Irregular	top of slab 10' x7' with	54.700	0.000	0.000	118.0	0.00	0.00	118.00	0.000	118.0	54.7	4.50	6,745
E	010	Irregular	top of slab 10' x 7' with	54.700	0.000	0.000	118.0	0.00	0.00	118.00	0.000	118.0	54.7	4.50	6,745
E	011	Irregular	top of slab 10' x 7' with	54.700	0.000	0.000	118.0	0.00	0.00	118.00	0.000	118.0	54.7	4.50	6,745
E	012	Irregular	top of slab- 8.1 x 7 with	44.000	0.000	0.000	129.0	0.00	0.00	129.00	0.000	129.0	44.0	3.50	5,875
E	013	Irregular	top of slab- 8.1 x 7 with	44.000	0.000	0.000	109.5	0.00	0.00	109.50	0.000	109.5	44.0	3.50	4,987
E	014	Irregular	top of slab	41.300	0.000	0.000	136.0	0.00	0.00	136.00	0.000	136.0	41.3	3.50	5,814
E	015	Irregular	top of slab	100.10	0.000	0.000	142.0	0.00	0.00	142.00	0.000	142.0	100.1	6.00	15,067
E	016	Irregular	top of slab 8.1'x7' inspctn	44.000	7.398	7.398	17.50	0.00	0.00	17.500	0.000	17.5	44.0	3.50	797
E	017	Peaked	top of sidewall	48.000	0.000	0.000	64.00	0.00	0.00	64.000	3.400	67.4	1454.6	10.0	107,844
E	018	Peaked	top of sidewall	54.000	0.000	0.000	64.00	0.00	0.00	64.000	3.800	67.8	1841.0	10.0	137,302
E	019	Peaked	top of sidewall	60.000	0.000	0.000	64.00	0.00	0.00	64.000	4.200	68.2	2272.9	10.0	170,513
E	020	Peaked	top of sidewall	30.000	0.000	0.000	64.30	0.00	0.00	64.300	1.800	66.1	568.2	9.00	40,938
E	021	Peaked	top of sidewall	33.000	0.000	0.000	64.30	0.00	0.00	64.300	2.000	66.3	687.5	9.50	49,911

Exam Date: 04/12/2010
 Examiner: 2

Berthold Farmers Elevator LLC
 #1 South Main St
 Berthold, ND
 County:

Status	Section	Bin Number	Bin Type	Base Point	Diameter or Bu/Ft (Irreg).	Length	Width	Side wall	Add for Hopper	Ded. for Obst.	Effective Depth	Add for Peak	Depth for Capac.	Bushels per Foot	Base Pack%	Bushel Capacity with Pack
--------	---------	------------	----------	------------	----------------------------	--------	-------	-----------	----------------	----------------	-----------------	--------------	------------------	------------------	------------	---------------------------

Bin count: 21

Facility: Carpio Section: E Total: 927,583

To Even: 928,000

Section: F

F	000EAST	Peaked	top of sidewall		27.000	0.000	0.000	24.20	0.00	0.00	24.200	1.600	25.8	460.3	8.50	12,885
F	000WEST	Peaked	top of sidewall		27.000	0.000	0.000	24.20	0.00	0.00	24.200	1.600	25.8	460.3	8.50	12,885
F	001	Irregular	work floor		19.800	4.963	4.963	21.00	0.00	0.00	21.000	0.000	21.0	19.8	2.00	424
F	002	Irregular	work floor		32.500	6.358	6.358	8.000	0.00	0.00	8.000	0.000	8.0	32.5	2.50	267
F	003 T	Irregular	work floor		31.800	6.290	6.290	11.00	0.00	0.00	11.000	0.000	11.0	31.8	2.50	359
F	003 B	Irregular	work floor- top 11'		66.500	9.095	9.095	32.50	0.00	0.00	32.500	0.000	32.5	66.5	5.00	2,269
F	004	Irregular	work floor		67.300	9.150	9.150	43.50	0.00	0.00	43.500	0.000	43.5	67.3	5.20	3,080
F	005	Irregular	work floor		38.600	6.930	6.930	27.00	0.00	0.00	27.000	0.000	27.0	38.6	3.00	1,073
F	006	Irregular	work floor		66.500	9.095	9.095	43.50	0.00	0.00	43.500	0.000	43.5	66.5	5.00	3,038
F	007 T	Irregular	work floor		26.900	5.785	5.785	11.00	0.00	0.00	11.000	0.000	11.0	26.9	2.50	303
F	007 B	Irregular	work floor		38.200	6.894	6.894	14.00	0.00	0.00	14.000	0.000	14.0	38.2	3.00	551
F	009 T	Irregular	work floor		19.100	4.874	4.874	11.00	0.00	0.00	11.000	0.000	11.0	19.1	2.00	214
F	009 B	Irregular	work floor		38.200	6.894	6.894	14.00	0.00	0.00	14.000	0.000	14.0	38.2	3.00	551
F	010	Irregular	work floor		66.500	9.095	9.095	43.50	0.00	0.00	43.500	0.000	43.5	66.5	5.00	3,038
F	011	Irregular	work floor		38.600	6.930	6.930	27.00	0.00	0.00	27.000	0.000	27.0	38.6	3.00	1,073
F	012	Irregular	work floor		67.300	9.150	9.150	43.50	0.00	0.00	43.500	0.000	43.5	67.3	5.20	3,080
F	013	Irregular	work floor		66.500	9.095	9.095	43.50	0.00	0.00	43.500	0.000	43.5	66.5	5.00	3,038

Bin count: 17

Facility: Carpio Section: F Total: 48,128

To Even: 49,000

Overall Licensed Bin Capacity for:

Berthold Farmers Elevator LLC

Bin count: 141

Licensed Capacity:
(includes pack)

2,625,060 Bu.

Licensed Capacity (to even):


(includes pack and section totals are rounded up to next highest 1000)

2,628,000 Bu.


BERTHOLD FARMERS ELEVATOR LLC
 BERTHOLD ND
 CARPIO LOCATION
 SECTION F

U. S. #52

Canadian Pacific

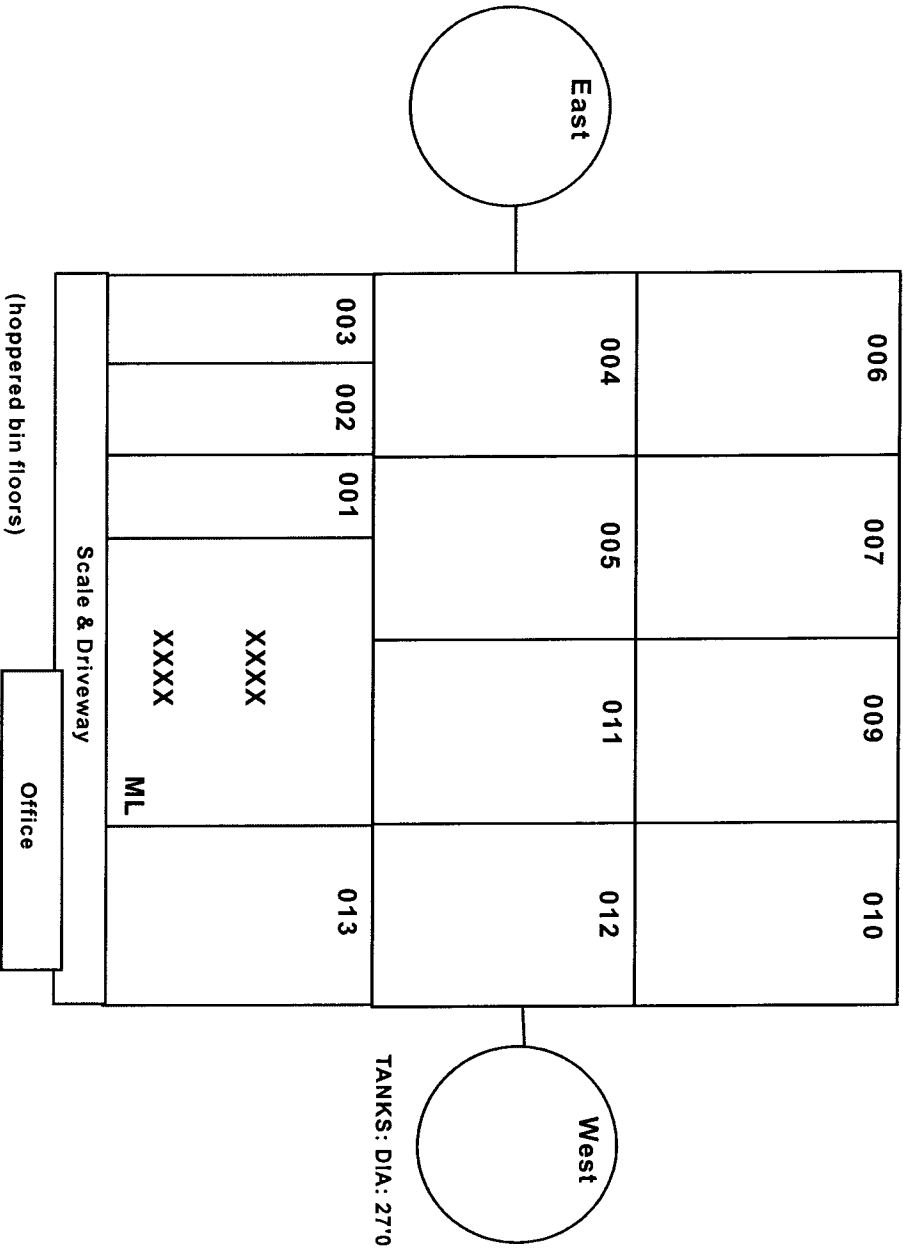

SECTION F

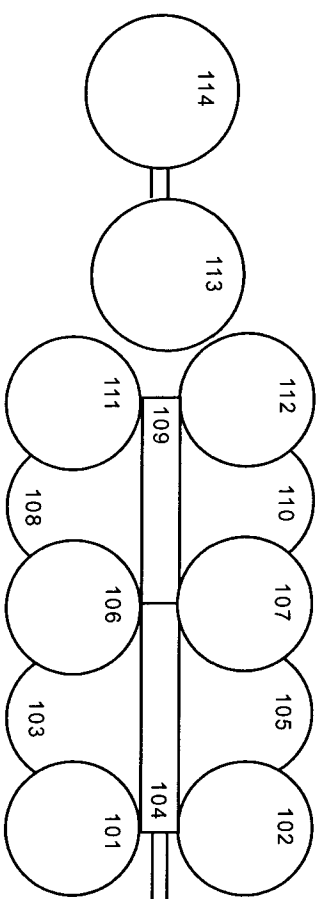

19	18	11	10	9	
22	17	13	12	8	6
	scale				
	20	16		5	
	23	28	1		
26	24	25	X X X X	4	2
					3


DRIVEWAY

WAREHOUSE	OFFICE
-----------	--------

SECTION A

BERTHOLD FARMERS ELEVATOR LLC
 BERTHOLD ND
 SECTION A -2


Burlington Northern Railroad

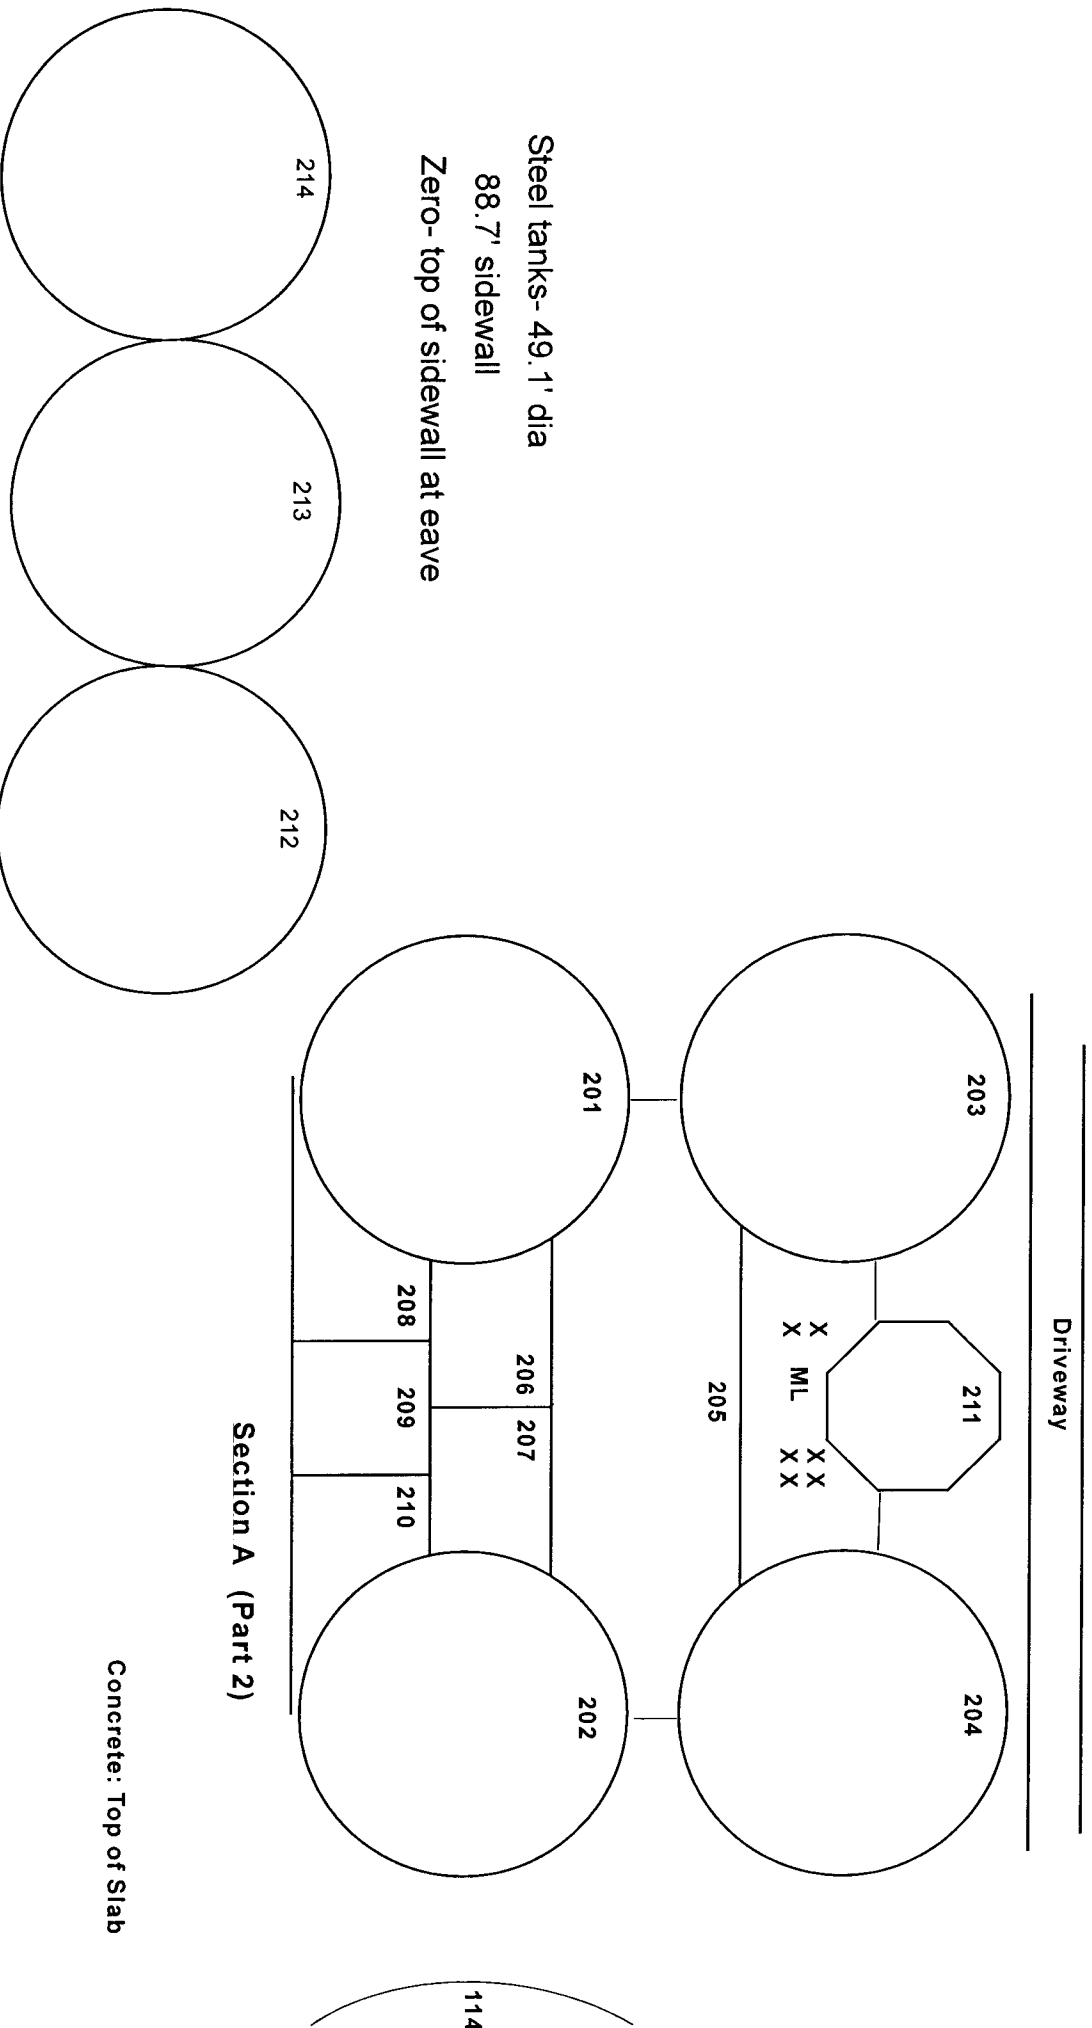


BERTHOLD FARMERS ELEVATOR LLC
BERTHOLD ND
SECTION C

WARD COUNTY HIGHWAY NUMBER 10

← 1/2 MILE TO SECTION A

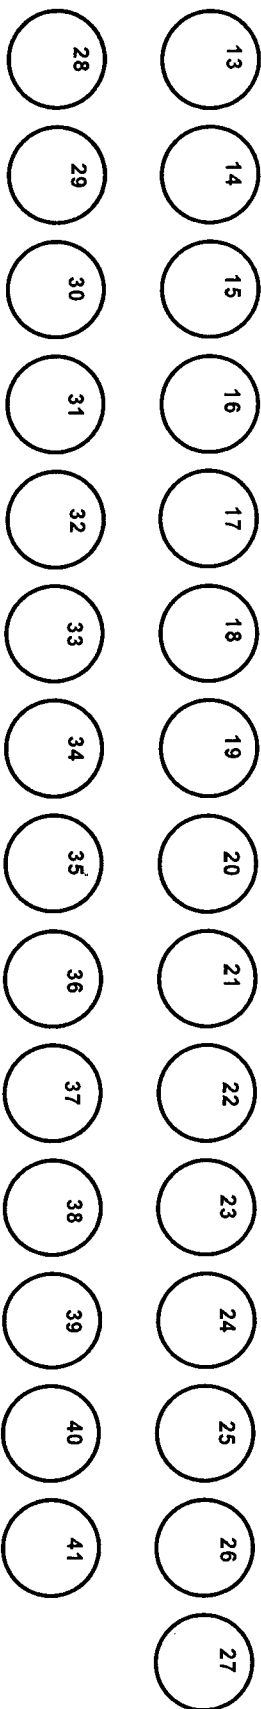

Note: Tanks 1 thru 27, and 42 are hoppers

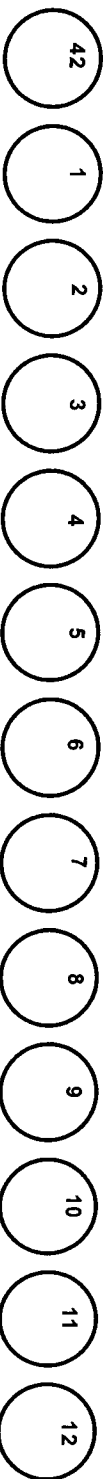


SECTION C

ZERO: TANKS - TOP OF SIDEWALL
TANKS = 18.0' DIAMETER

BERTHOLD FARMERS ELEVATOR LLC
 BERTHOLD ND
 SECTION D

Burlington Northern - Santa Fe Railroad

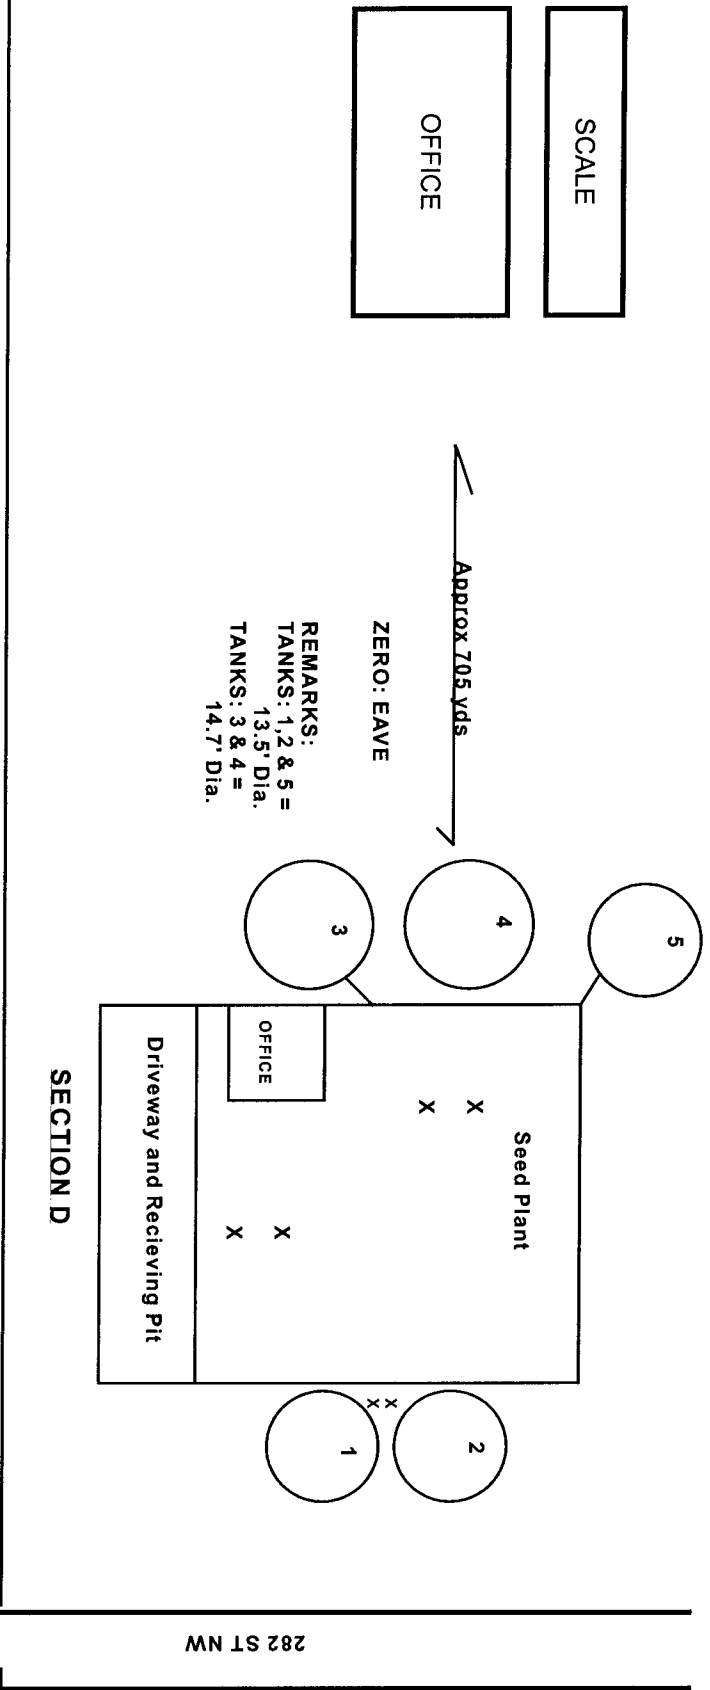

ZERO: EAVE
 REMARKS:
 TANKS: 1, 2 & 5 =
 13.5' Dia.
 TANKS: 3 & 4 =
 14.7' Dia.


WARD COUNTY HIGHWAY NUMBER 10

BERTHOLD FARMERS ELEVATOR LLC
BERTHOLD ND
CARPIO LOCATION
SECTION E-1

ND
HGY #
28

US HIGHWAY NUMBER 52

Canadian Pacific

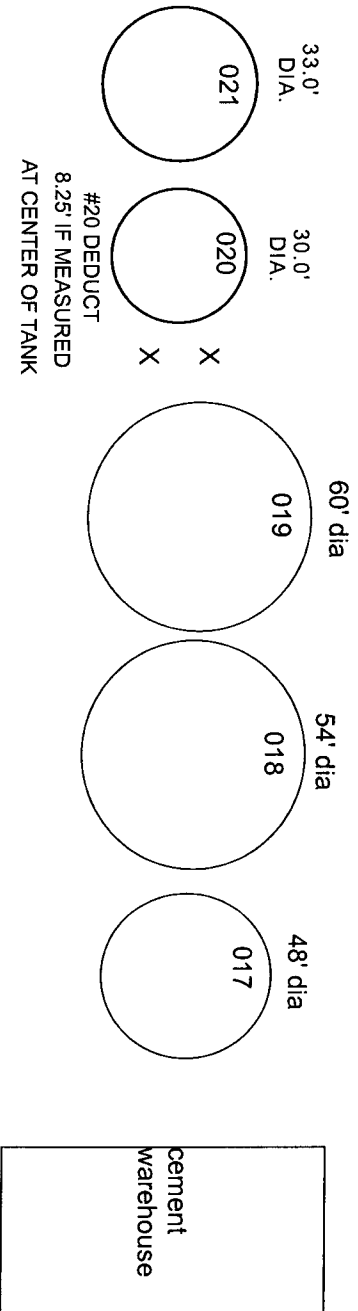


SECTION E


Zero: Top of sidewall

BERTHOLD FARMERS ELEVATOR LLC
 BERTHOLD ND
 CARPIO LOCATION
 SECTION E

C P R S RR

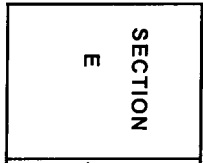


90'-0"

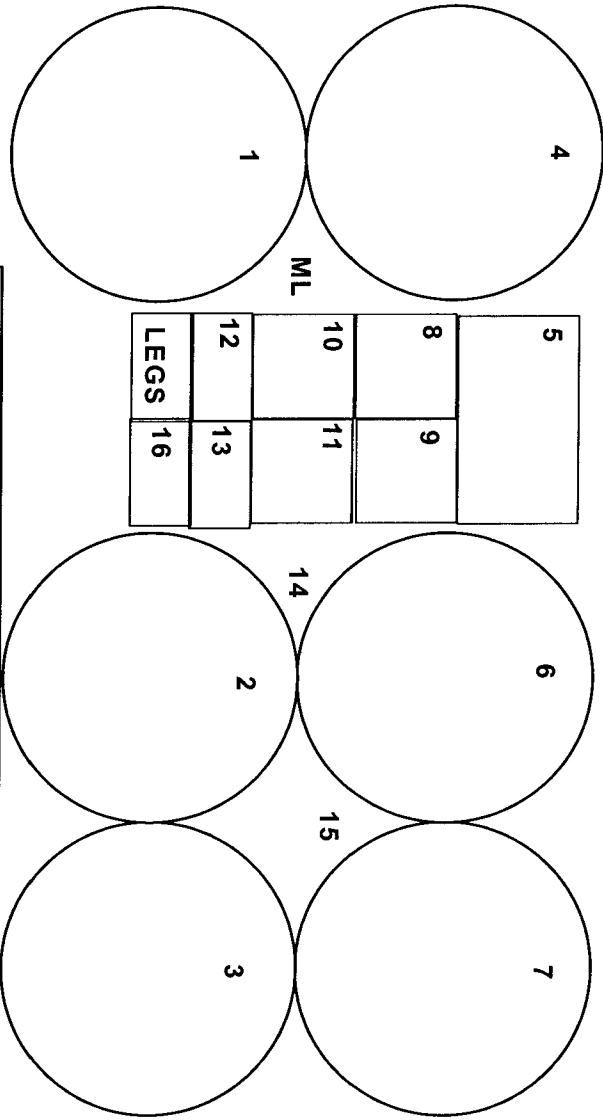

ZERO: CONCRETE - TOP OF CONCRETE SLAB

SILO: 1-2-3-4-6 & 7 - 25.0' DIA.

SECTION E

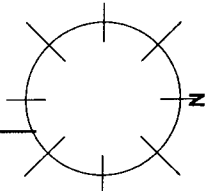

LICENSE NO.	NAME AND LOCATION OF WAREHOUSE	CODE NO.
	BERTHOLD FARMERS ELEVATOR LLC, BERTHOLD, ND	2-42226

TO BE DESTROYED IN 2010

BURLINGTON NORTHERN RAILROAD

SECTION
A

S T R E E T

ZERO: ELEVATOR & ANNEX
FLOOR OVER BINS

WAREHOUSE	103	104	7	15	11	9	13	5
	DELETED 04/13/10							
105	106	10	19	22A	22B	21	17	8
DELETED 04/13/10								
101	102	6	14	18	X	20	16	4
DELETED 04/13/10 TB								

DRIER

DRIVEWAY

WAREHOUSE	Scale Room
RECEIVING SCALE	

SECTION B

DELETED 04/13/10