

Exam Date:02/25/2010

Equity Elevator &amp; Trading Co.

Page: 1

Examiner: 1

PO Box 340

Turtle Lake , ND

County:

Phone: 701-448-2461

CCC Number:

Location/Container Numbers/Comments	Section	Capacity
<b>PART A - ADDITIONAL SPACE TO BE INCLUDED UNDER LICENSE</b>		
104	A	56,322
105	A	56,322
003	B	56,322
		<b>Total:</b> 168,966

**PART B - SPACE TO BE DELETED UNDER LICENSE**

302	A	3,062
303	A	1,285
304	A	3,201
305	A	2,925
306	A	1,335
307	A	1,041
308	A	1,082
309	A	2,925
310	A	3,201
312	A	3,062
313	A	1,258
		<b>Total:</b> 24,377

**PART C - ALL SPACE TO BE INCLUDED UNDER LICENSE**

A	433,000
B	102,000
<b>Total:</b> 535,000	

**PART D - TOTAL CAPACITY BY FUNCTIONAL UNIT**

Turtle Lake	111	A B	535,000
			<b>Total:</b> 535,000

Exam Date:02/25/2010  
 Examiner: 1

Equity Elevator & Trading Co.  
 PO Box 340  
 Turtle Lake , ND  
 County:

Status	Section	Bin Number	Bin Type	Base Point	Diameter or Bu/Ft (Ireg).	Length	Width	Side wall	Add for Hopper	Ded. for Obsl.	Effective Depth	Add for Peak	Depth for Capac.	Bushels per Foot	Base Pack%	Bushel Capacity with Pack
--------	---------	------------	----------	------------	---------------------------	--------	-------	-----------	----------------	----------------	-----------------	--------------	------------------	------------------	------------	---------------------------

## Facility: Turtle Lake

### Section: A

A		001 T	Square	work floor	0.000	5.200	13.50	48.00	0.00	0.00	48.000	0.000	48.0	56.4		4.80	2,837
A		001B	Square	work floor T48'	0.000	11.10	13.50	20.50	0.00	0.00	20.500	0.000	20.5	120.5		6.50	2,631
A		003 T	Irregular	work floor (scale in bin)	6.500	0.000	0.000	14.00	0.00	0.00	14.000	0.000	14.0	6.5		2.00	93
A		003B	Square	work floor (scale in bin)	0.000	5.400	6.800	34.00	0.00	0.00	34.000	0.000	34.0	29.5		2.50	1,028
A		004 T	Square	work floor	0.000	5.400	3.400	30.00	0.00	0.00	30.000	0.000	30.0	14.8		2.00	453
A		004B	Square	work floor T30'	0.000	5.400	6.700	18.00	0.00	0.00	18.000	0.000	18.0	29.1		2.50	537
A		005	Square	work floor	0.000	12.50	7.000	48.00	0.00	0.00	48.000	0.000	48.0	70.3		5.20	3,549
A		006	Square	work floor	0.000	5.400	3.000	30.00	0.00	0.00	30.000	0.000	30.0	13.0		2.00	398
A		007	Square	work floor	0.000	5.800	13.50	48.00	0.00	0.00	48.000	0.000	48.0	62.9		5.00	3,170
A		008	Square	work floor	0.000	5.900	13.50	48.00	0.00	0.00	48.000	0.000	48.0	64.0		5.00	3,226
A		009	Square	work floor	0.000	11.10	13.50	68.00	0.00	0.00	68.000	0.000	68.0	120.5		6.50	8,727
A		010 T	Irregular	work floor (scale in bin)	49.000	0.000	0.000	15.00	0.00	0.00	15.000	0.000	15.0	49.0		4.20	766
A		010B	Square	work floor (scale in bin) T15'	0.000	11.10	7.000	33.00	0.00	0.00	33.000	0.000	33.0	62.5		5.00	2,166
A		014 T	Irregular	work floor (scale in bin)	30.700	0.000	0.000	15.00	0.00	0.00	15.000	0.000	15.0	30.7		2.50	473
A		014B	Square	work floor (scale in bin) T15'	0.000	11.10	6.700	33.00	0.00	0.00	33.000	0.000	33.0	59.8		4.80	2,068
A		015	Square	work floor	0.000	12.50	6.700	48.00	0.00	0.00	48.000	0.000	48.0	67.3		5.20	3,398
A		016	Square	work floor	0.000	11.10	13.50	68.00	0.00	0.00	68.000	0.000	68.0	120.5		6.50	8,727
A		017	Square	work floor	0.000	5.900	13.50	48.00	0.00	0.00	48.000	0.000	48.0	64.0		5.00	3,226
A		019	Square	work floor	0.000	5.800	13.50	48.00	0.00	0.00	48.000	0.000	48.0	62.9		5.00	3,170
A		020 T	Square	work floor	0.000	5.200	13.50	48.00	0.00	0.00	48.000	0.000	48.0	56.4		4.80	2,837
A		020B	Square	work floor T48'	0.000	11.10	13.50	20.50	0.00	0.00	20.500	0.000	20.5	120.5		6.50	2,631

Client ID: 292

### NDPSC Bin Capacity Chart

02/25/2010 11:31:06 AM

Exam Date:02/25/2010  
Examiner: 1

Equity Elevator & Trading Co.  
PO Box 340  
Turtle Lake, ND  
County:

Page: 2

Status	Section	Bin Number	Bin Type	Base Point	Diameter or Bu/Ft (Ireg):	Length	Width	Side wall	Add for Hopper	Dec. for Obst.	Effective Depth	Add for Peak	Depth for Capac.	Bushels per Foot	Base Pack%	Bushel Capacity with Pack
--------	---------	------------	----------	------------	---------------------------	--------	-------	-----------	----------------	----------------	-----------------	--------------	------------------	------------------	------------	---------------------------

## Facility: Turtle Lake

### Section: A

A	021	Square	workfloor		0.000	5.500	6.200	48.00	0.00	0.00	48.000	0.000	48.0	27.4	2.50	1,348
A	022	Square	workfloor		0.000	5.500	6.800	48.00	0.00	0.00	48.000	0.000	48.0	30.1	2.50	1,481
A	023	Square	workfloor		0.000	11.10	3.600	47.00	0.00	0.00	47.000	0.000	47.0	32.1	2.50	1,547
A	101	Peaked	eave		29.900	0.000	0.000	53.50	0.00	0.00	53.500	1.800	55.3	564.4	9.00	34,020
A	102	Peaked	eave		29.900	0.000	0.000	53.50	0.00	0.00	53.500	1.800	55.3	564.4	9.00	34,020
A	103	Peaked	eave		60.000	0.000	0.000	42.00	0.00	0.00	42.000	4.200	46.2	2272.9	10.0	115,509
Added	A 104	Peaked	eave		48.000	0.000	0.000	31.80	0.00	0.00	31.800	3.400	35.2	1454.6	10.0	56,322
Added	A 105	Peaked	eave		48.000	0.000	0.000	31.80	0.00	0.00	31.800	3.400	35.2	1454.6	10.0	56,322
A	200 east	Square	workfloor		0.000	11.70	9.000	23.00	0.00	0.00	23.000	0.000	23.0	84.6	5.80	2,059
A	200 west	Square	workfloor		0.000	11.70	9.800	23.00	0.00	0.00	23.000	0.000	23.0	92.2	5.80	2,244
A	203	Square	workfloor		0.000	10.20	3.400	44.00	0.00	0.00	44.000	0.000	44.0	27.9	2.50	1,259
A	205	Square	workfloor		0.000	10.00	5.900	44.00	0.00	0.00	44.000	0.000	44.0	47.4	4.00	2,169
A	206	Square	workfloor		0.000	10.20	3.600	44.00	0.00	0.00	44.000	0.000	44.0	29.5	2.50	1,330
A	207 T	Square	workfloor		0.000	10.00	5.100	44.00	0.00	0.00	44.000	0.000	44.0	41.0	3.00	1,858
A	207B	Square	workfloor T44'		0.000	10.00	11.20	11.00	0.00	0.00	11.000	0.000	11.0	90.0	5.80	1,047
A	208	Square	workfloor		0.000	10.00	5.400	44.00	0.00	0.00	44.000	0.000	44.0	43.4	3.50	1,977
A	209 T	Iregular	workfloor ( scale in bin)		47.900	0.000	0.000	8.500	0.00	0.00	8.500	0.000	8.5	47.9	4.00	423
A	209B	Square	workfloor ( scale in bin)		0.000	10.40	6.100	36.50	0.00	0.00	36.500	0.000	36.5	51.0	4.50	1,946
A	210 T	Square	workfloor		0.000	10.00	5.600	44.00	0.00	0.00	44.000	0.000	44.0	45.0	3.50	2,049
A	210B	Square	workfloor T44'		0.000	10.00	11.20	11.00	0.00	0.00	11.000	0.000	11.0	90.0	5.80	1,047
A	211 T	Square	workfloor		0.000	10.30	5.100	44.00	0.00	0.00	44.000	0.000	44.0	42.2	3.50	1,922

Client ID: 292

### NDPSC Bin Capacity Chart

02/25/2010 11:31:07 AM

Exam Date:02/25/2010  
Examiner: 1

Equity Elevator & Trading Co.  
PO Box 340  
Turtle Lake, ND  
County:

Page: 3

Status	Section	Bin Number	Bin Type	Base Point	Diameter or Bu/Ft (Ireg):	Length	Width	Side wall	Add for Hopper	Ded. for Obs.	Effective Depth	Add for Peak	Depth for Capac.	Bushels per Foot	Base Pack%	Bushel Capacity with Pack
--------	---------	------------	----------	------------	---------------------------	--------	-------	-----------	----------------	---------------	-----------------	--------------	------------------	------------------	------------	---------------------------

## Facility: Turtle Lake

### Section: A

A	211B	Square	workfloor T44'		0.000	10.30	11.20	11.00	0.00	0.00	11.000	0.000	11.0	92.7	5.80	1,079
A	212	Square	workfloor		0.000	10.30	5.400	44.00	0.00	0.00	44.000	0.000	44.0	44.7	3.50	2,036
A	213	Square	workfloor		0.000	10.30	5.900	44.00	0.00	0.00	44.000	0.000	44.0	48.9	4.20	2,242
A	214 T	Square	workfloor		0.000	10.30	5.600	44.00	0.00	0.00	44.000	0.000	44.0	46.4	4.00	2,124
A	214B	Square	workfloor T44'		0.000	10.30	11.20	11.00	0.00	0.00	11.000	0.000	11.0	92.7	5.80	1,079
A	215 T	Irregular	workfloor (scale in bin)		50.400	0.000	0.000	8.500	0.00	0.00	8.500	0.000	8.5	50.4	4.50	447
A	215B	Square	workfloor (scale in bin)		0.000	10.40	6.300	36.50	0.00	0.00	36.500	0.000	36.5	52.7	4.50	2,011
A	216	Square	workfloor		0.000	10.10	11.20	55.00	0.00	0.00	55.000	0.000	55.0	90.9	5.80	5,290
A	217	Square	workfloor		0.000	10.10	11.20	55.00	0.00	0.00	55.000	0.000	55.0	90.9	5.80	5,290
A	218 T	Irregular	workfloor		47.700	0.000	0.000	8.500	0.00	0.00	8.500	0.000	8.5	47.7	4.00	421
A	218B	Square	workfloor T8.5'		0.000	10.10	6.300	33.50	0.00	0.00	33.500	0.000	33.5	51.1	4.50	1,789
A	221 T	Irregular	workfloor (scale in bin)		43.600	0.000	0.000	8.500	0.00	0.00	8.500	0.000	8.5	43.6	3.50	384
A	221B	Square	workfloor (scale in bin)		0.000	10.10	6.100	33.50	0.00	0.00	33.500	0.000	33.5	49.5	4.20	1,728
A	401	Square	workfloor		0.000	10.10	6.100	20.00	0.00	0.00	20.000	0.000	20.0	49.5	4.20	1,032
A	402	Square	workfloor		0.000	10.10	6.100	20.00	0.00	0.00	20.000	0.000	20.0	49.5	4.20	1,032
A	403	Square	workfloor		0.000	5.100	6.100	21.00	0.00	0.00	21.000	0.000	21.0	25.0	2.50	538
A	404	Square	workfloor		0.000	10.10	6.100	20.00	0.00	0.00	20.000	0.000	20.0	49.5	4.20	1,032
A	405	Square	workfloor		0.000	4.500	6.100	21.00	0.00	0.00	21.000	0.000	21.0	22.1	2.00	473
A	406	Square	workfloor		0.000	4.500	6.100	21.00	0.00	0.00	21.000	0.000	21.0	22.1	2.00	473
A	407	Square	workfloor		0.000	5.100	4.000	21.00	0.00	0.00	21.000	0.000	21.0	16.4	2.00	351
A	408	Square	workfloor		0.000	5.100	4.000	18.00	0.00	0.00	18.000	0.000	18.0	16.4	2.00	301

Client ID: 292

### NDPSC Bin Capacity Chart

02/25/2010 11:31:10 AM

Exam Date: 02/25/2010  
Examiner: 1

Equity Elevator & Trading Co.  
PO Box 340  
Turtle Lake, ND  
County:

Page: 4

Status	Section	Bin Number	Bin Type	Base Point	Diameter or Bu/Ft (irreg).	Length	Width	Side wall	Add for Hopper	Det. for Obst.	Effective Depth	Add for Peak	Depth for Capac.	Bushels per Foot	Base Pack%	Bushel Capacity with Pack
--------	---------	------------	----------	------------	----------------------------	--------	-------	-----------	----------------	----------------	-----------------	--------------	------------------	------------------	------------	---------------------------

## Facility: Turtle Lake

### Section: A

A		409	Square	workfloor	0.000	5.100	4.000	18.00	0.00	0.00	18.000	0.000	18.0	16.4	2.00	301	
A		501	Peaked	eave	15.500	0.000	0.000	30.00	2.20	0.00	32.200	0.900	33.1	151.7	5.50	5,297	
A		502	Peaked	eave	15.500	0.000	0.000	30.00	2.20	0.00	32.200	0.900	33.1	151.7	5.50	5,297	
A		503	Peaked	eave	15.500	0.000	0.000	30.00	2.20	0.00	32.200	0.900	33.1	151.7	5.50	5,297	
A		504	Peaked	eave	15.500	0.000	0.000	30.00	2.20	0.00	32.200	0.900	33.1	151.7	5.50	5,297	
A		505	Peaked	eave	12.500	0.000	0.000	11.90	2.00	0.00	13.900	0.800	14.7	98.6	5.00	1,521	
		<b>Bin count:</b>															<b>432,172</b>

Facility: Turtle Lake Section: A Total:

To Even: 433,000

### Section: B

B		001	Peaked	eave	26.900	0.000	0.000	40.00	0.00	0.00	40.000	1.600	41.6	456.9	8.50	20,623	
B		002	Peaked	eave	26.900	0.000	0.000	48.00	0.00	0.00	48.000	1.600	49.6	456.9	8.50	24,588	
Added	B	003	Peaked	eave	48.000	0.000	0.000	31.80	0.00	0.00	31.800	3.400	35.2	1454.6	10.0	56,322	
		<b>Bin count:</b>															<b>101,533</b>

Facility: Turtle Lake Section: B Total:

To Even: 102,000

**Overall Licensed Bin Capacity for:**

**Equity Elevator & Trading Co.**

**Bin count: 72**

**Licensed Capacity:**  
(includes pack)

**533,705 Bu.**


**Licensed Capacity (to even):**  
(includes pack and section totals are rounded up to next highest 1000)

**535,000 Bu.**

# EQUITY ELEVATOR & TRADING CO

## TURTLE LAKE, NORTH DAKOTA

SECTION B

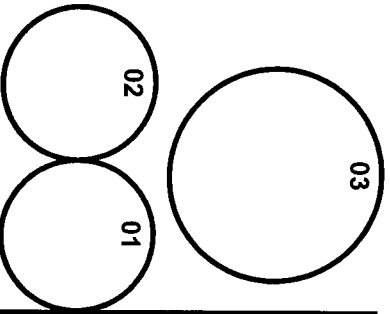

SECTION B

SECTION A

401	402
403	404
XXXX	406
XXXXXXXX	
405	
407	408
	409

ELEVATOR # 2

SECTION A

216	218	221	217
214	212	215	209
			213
			211
210	208	206	203
		XXXX	205
		XX	207
		XXXX	



NOT USEABLE  
DELETED 02/25/10

<del>305</del>	307	308	309
304	DELETED	DELETED	
DELETED	303	306	310
302	DELETED	DELETED	
	DELETED	313	
	X	DELETED	312


DRIVEWAY




EQUITY ELEVATOR & TRADING  
TURTLE LAKE ND.

SECTION A


SECTION A

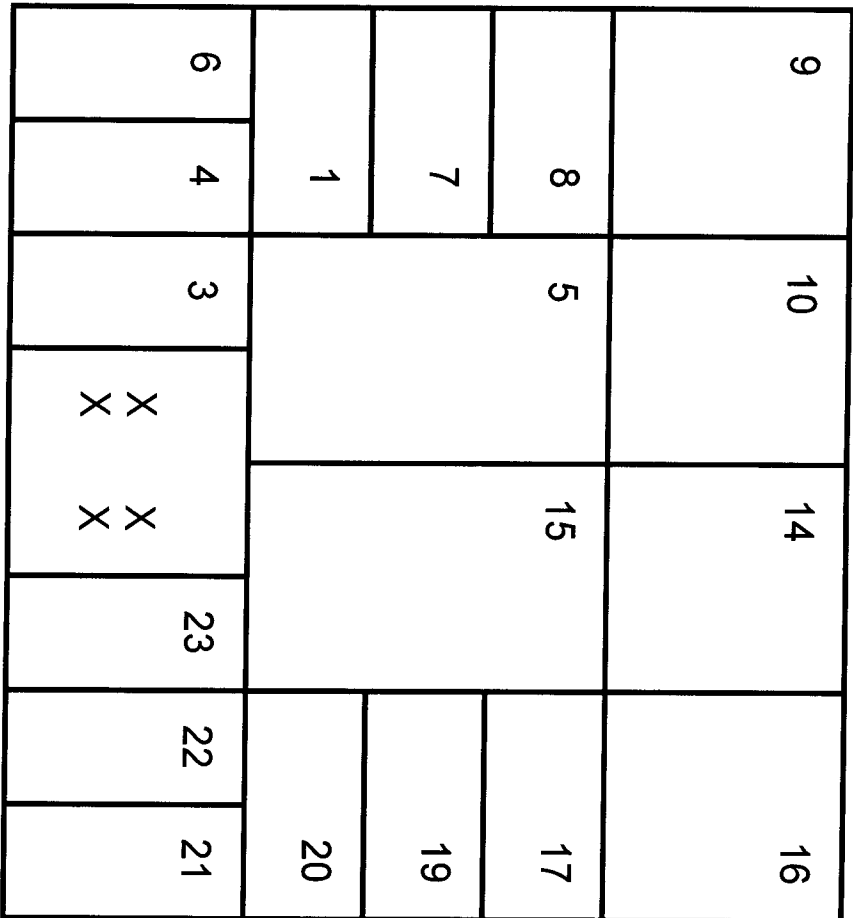

SECTION A

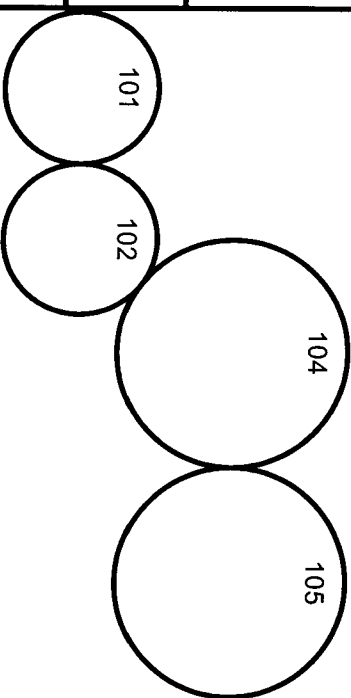

hopper tanks  
SECTION A

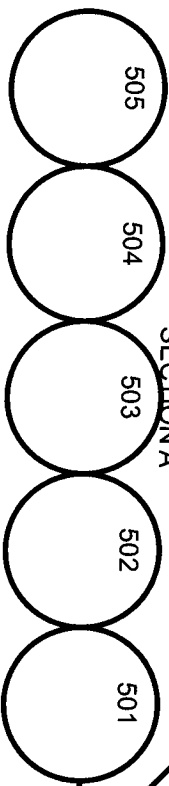

OFFICE

103

**Richter, Susan K.**

---

**From:** Erdmann, Tim A.  
**Sent:** Thursday, February 25, 2010 11:36 AM  
**To:** Richter, Susan K.  
**Subject:** Turtle Lake Equity

Hi, Mike & I are at Equity Elevator in Turtle Lake. I have sent statement of capacity, bin charts, & diagrams to the office canon printer. New construction and deletion of wood house 300 series Section A . Sufficient bond on file. Tim