

**Baldwin Wind LLC.
Substation
911 Address
27838 52nd St. NE
Wilton,N.D.
58579**

Attn. Corrine
+
Mike

BURLEIGH COUNTY HIGHWAY DEPARTMENT

Application for access driveway permit

(Updated 4/21/09)

Permit #: 10095

Date Requested: 7/26/10

Name of Applicant: Next Era Energy (Ted Harris 817 559-4673)
(Please print)

Home Phone #: _____ Work Phone #: 701 734-6801

Subdivision or Township Name: Ecklund

Lot/Sec.: NE 1/4 20 Block or Twp: 142 Range: 79

Address of the access: Existing Approach onto 52nd St
needs an address (Corner of 279 Ave & 52 St)

* New




27 838 52nd ST. NE

PROPOSED DRIVEWAY LOCATION MUST BE MARKED IN FIELD BY APPLICANT

Construction Standards:

- 1) 20' Minimum Top width and 32' Maximum width
- 2) 4:1 in-slope Slope Rate (6" and smaller decorative stones are allowed on in-slopes as long as a 4:1 slope is maintained)
- 3) 25' Turning Radius, Both Corners
- 4) 4" Gravel Surfacing (3" Gravel with 4" Hot Bituminous Pavement or 3" Gravel with 4" Portland Concrete Cement are also acceptable surface treatments)
- 5) Flared End Sections are required on all culvert installations
- 6) No decorative vertical end treatments allowed ie. Retaining walls
- 7) Place pipe to match existing ditch grade

25' S.
OF 279th Ave

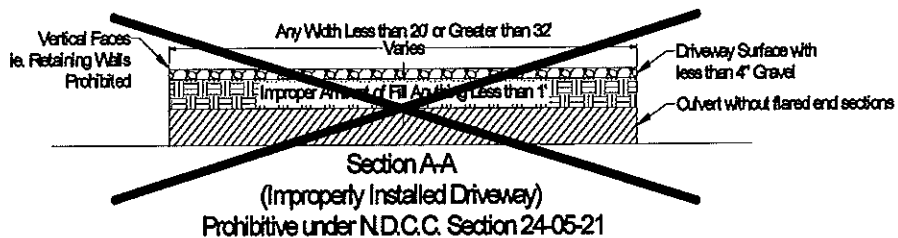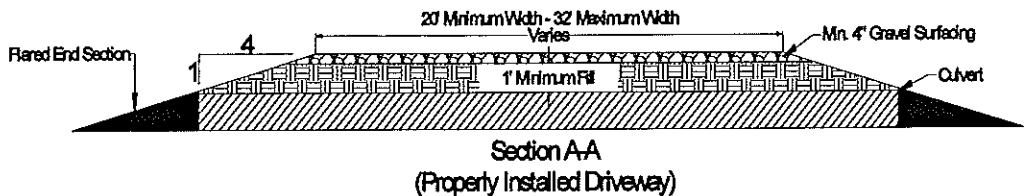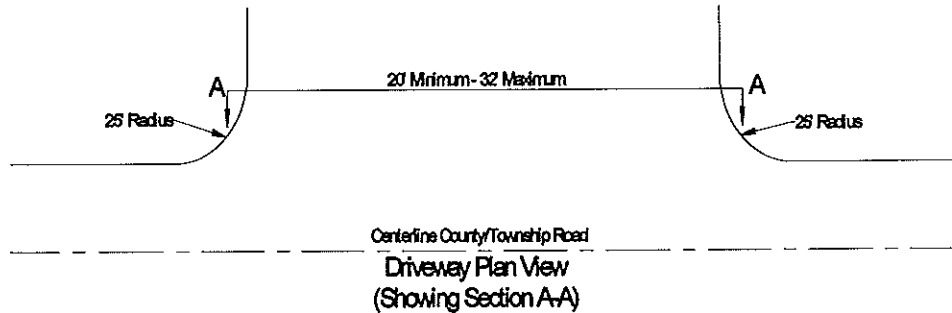

PROPER INITIAL INSTALLATION AND ALL FUTURE MAINTENANCE TO ASSURE PROPER FUNCTION IS THE RESPONSIBILITY OF THE LANDOWNERS