



**"ALTA/ACSM LAND TITLE SURVEY"  
BALDWIN WIND-OVERALL EXHIBIT  
BURLEIGH COUNTY, NORTH DAKOTA**

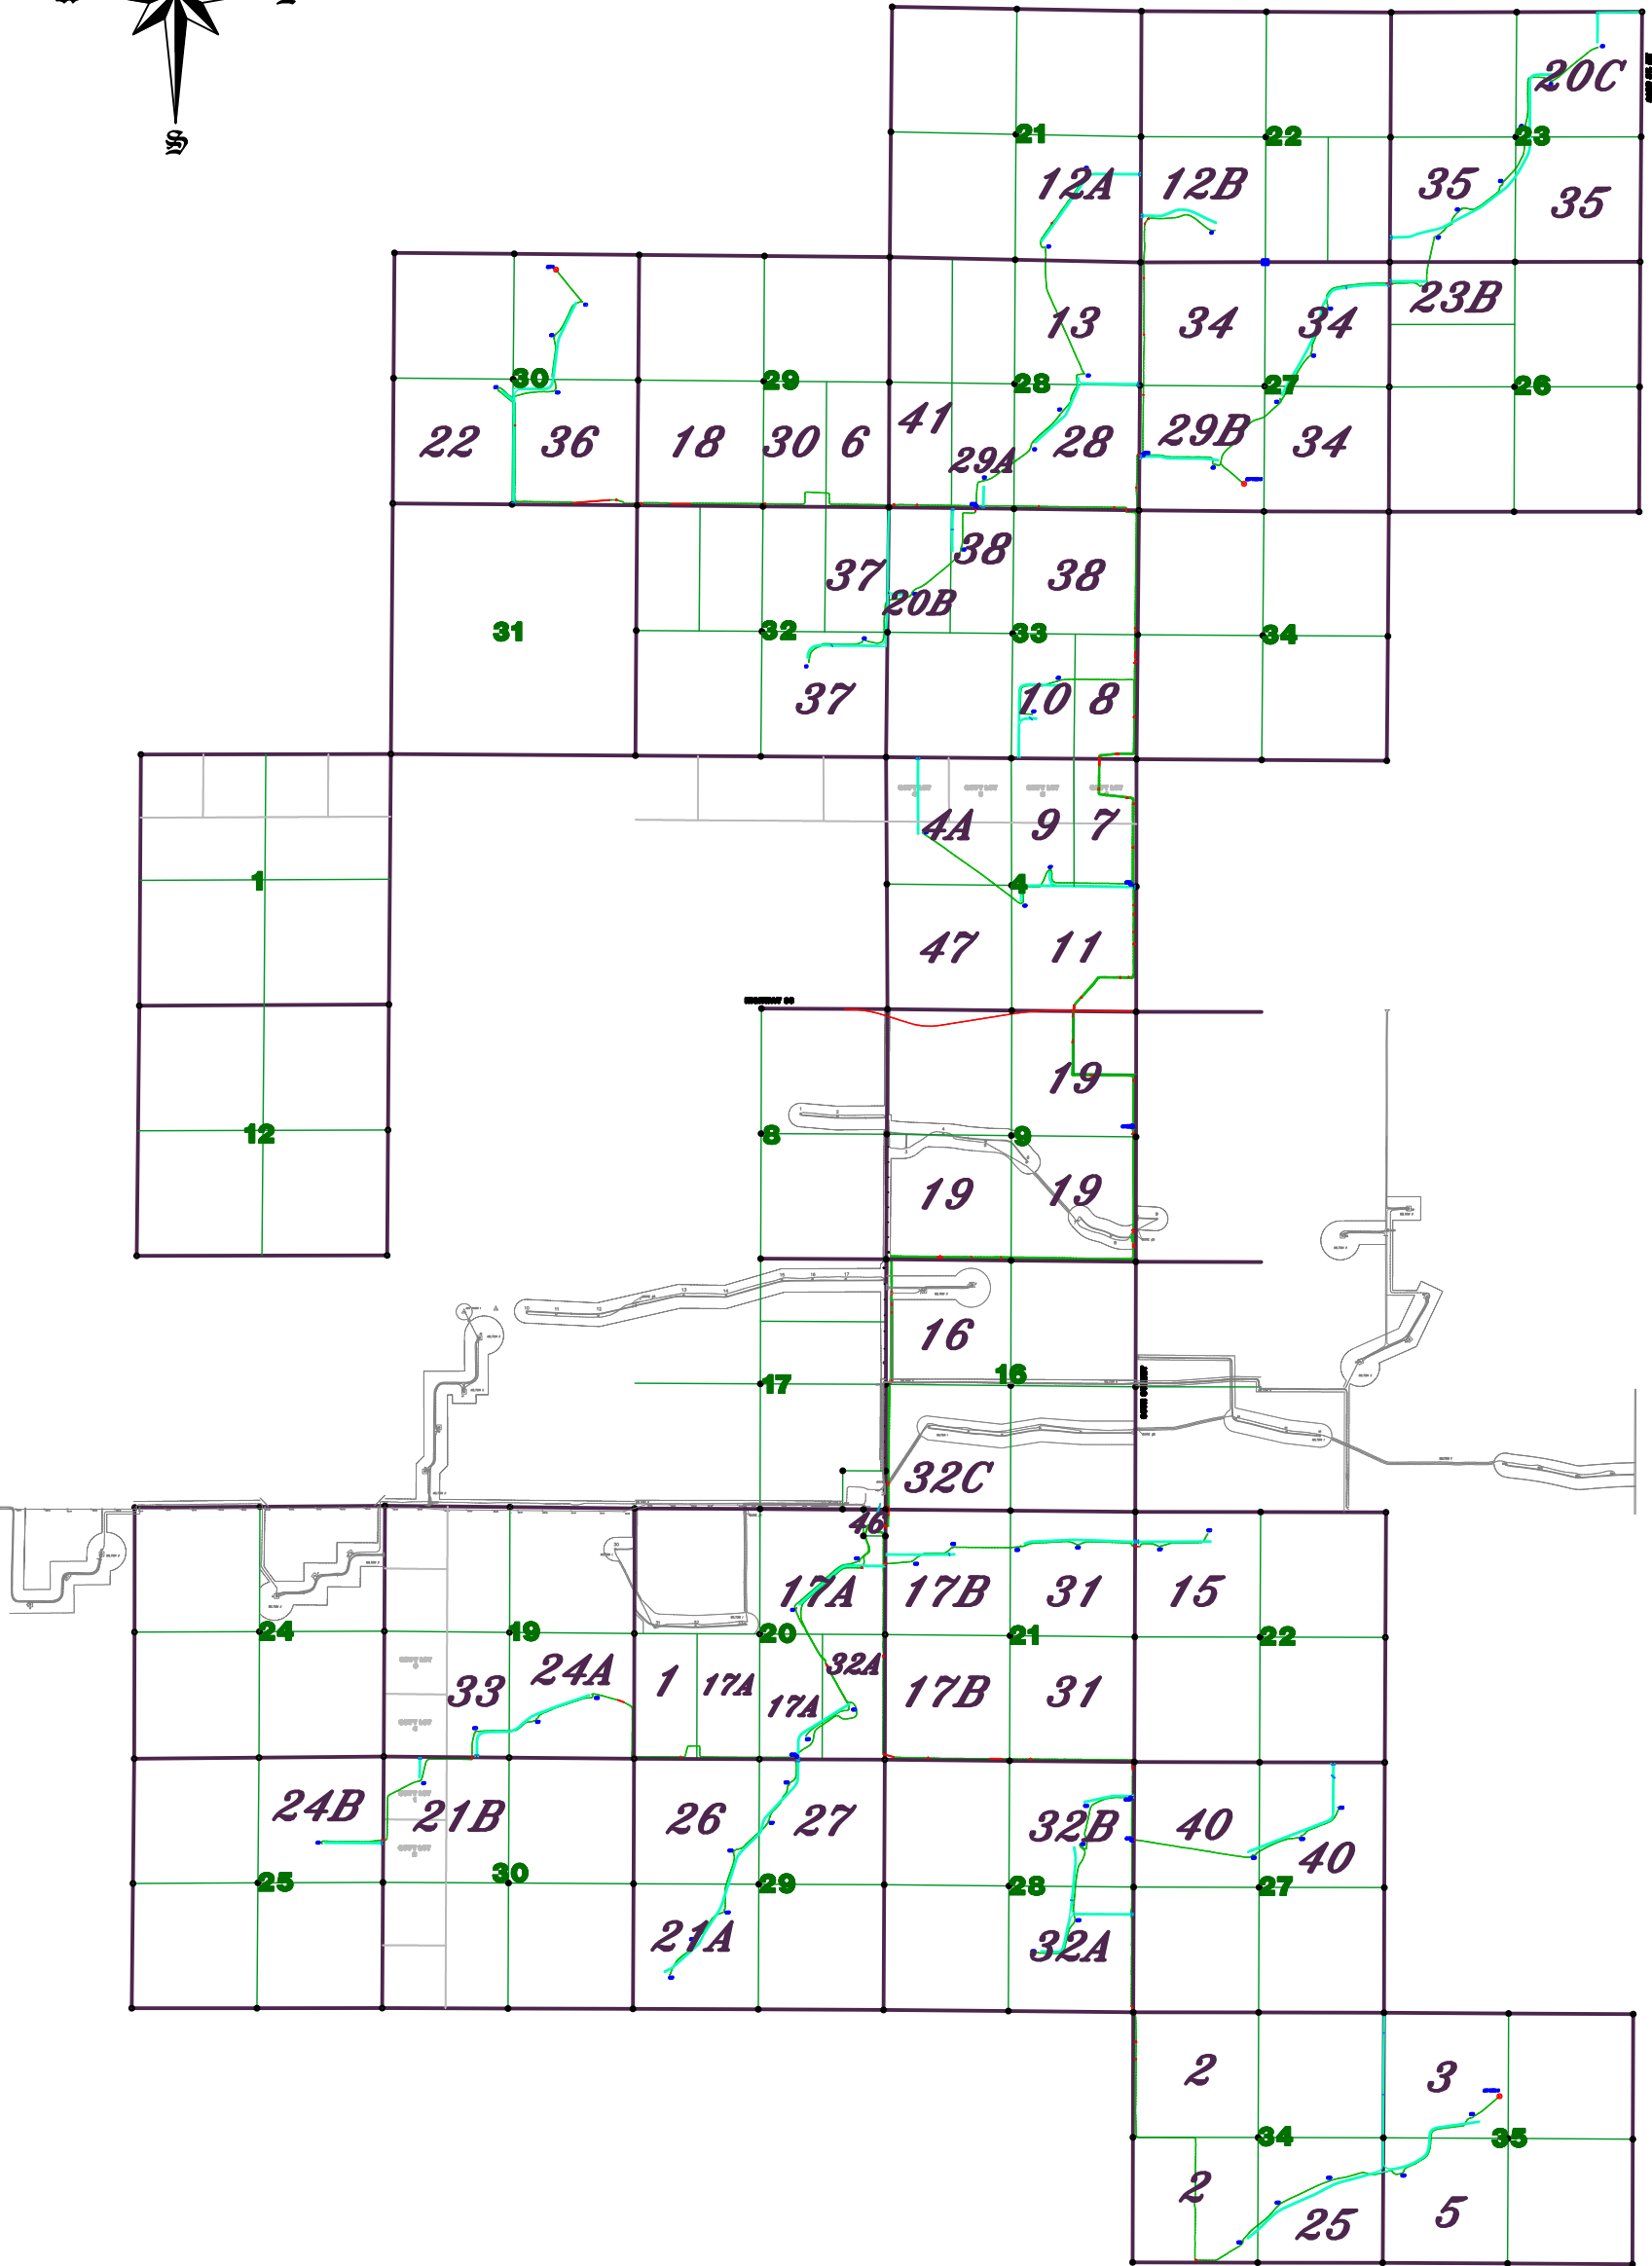

Copyright © 2011 by Swenson, Hagen & Co.

All rights reserved. No part of this drawing may be used or reproduced in any form or by any means without the express written permission of Swenson Hagen & Co.

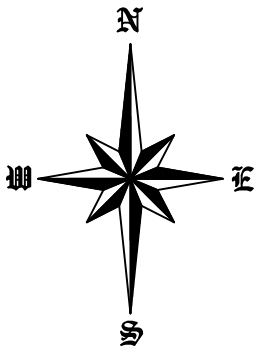

**SWENSON, HAGEN & COMPANY P.C.**

Surveying  
Hydrology  
Land Planning  
Civil Engineering  
Landscape & Site Design  
Construction Management

909 Basin Avenue  
Bismarck, North Dakota 58504  
sheng@swensonhagen.com  
Phone (701) 223-2600  
Fax (701) 223-2606