


Map Document: (\\mapserver\gis\proj\minnkota\110900\map\_docs\FSC\Corridor\Map\Change\Map\CGF\_CCC\_11x17L\_Supplemental\ReferenceMap2.mxd) 7/7/2011 - 10:20 PM

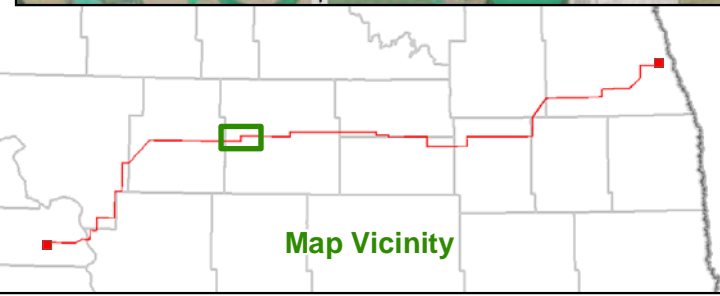

- |   |                             |                    |                                    |                             |
|---|-----------------------------|--------------------|------------------------------------|-----------------------------|
| Project Corridor (filed Feb 18, 2011)   | Existing Transmission Lines | Substation         | Wind Turbine                       | Irrigated Land              |
| Project Corridor (updated June 9, 2011) | 400-kV DC                   | Home               | State Park, Recreation Area or WMA | Incorporated Area           |
| Laydown Area                            | 345-kV AC                   | School             | USFWS WPA or WDA                   | Public Airport              |
|   | 250-kV DC                   | Business           | USFWS NWR                          | Private Airport             |
|   | 230-kV AC                   | Recreation         | USBOR Land                         | USGS River, Stream or Canal |
|   | 115-kV or less AC           | Gravel Pit or Mine | TNC Preserve                       | NWI Wetland                 |
|   | Gas or Oil Pipeline         | Dump or Landfill   |                                    |                             |

**Modified Project Corridor in Wells County  
Center to Grand Forks Project  
Minnkota Power Cooperative, Inc.**

0 0.5 1 Miles  
Scale 1:50,000

Aerial photography published by National Agriculture Imagery Program (NAIP), 2009.