


Exhibit C Proposed Route

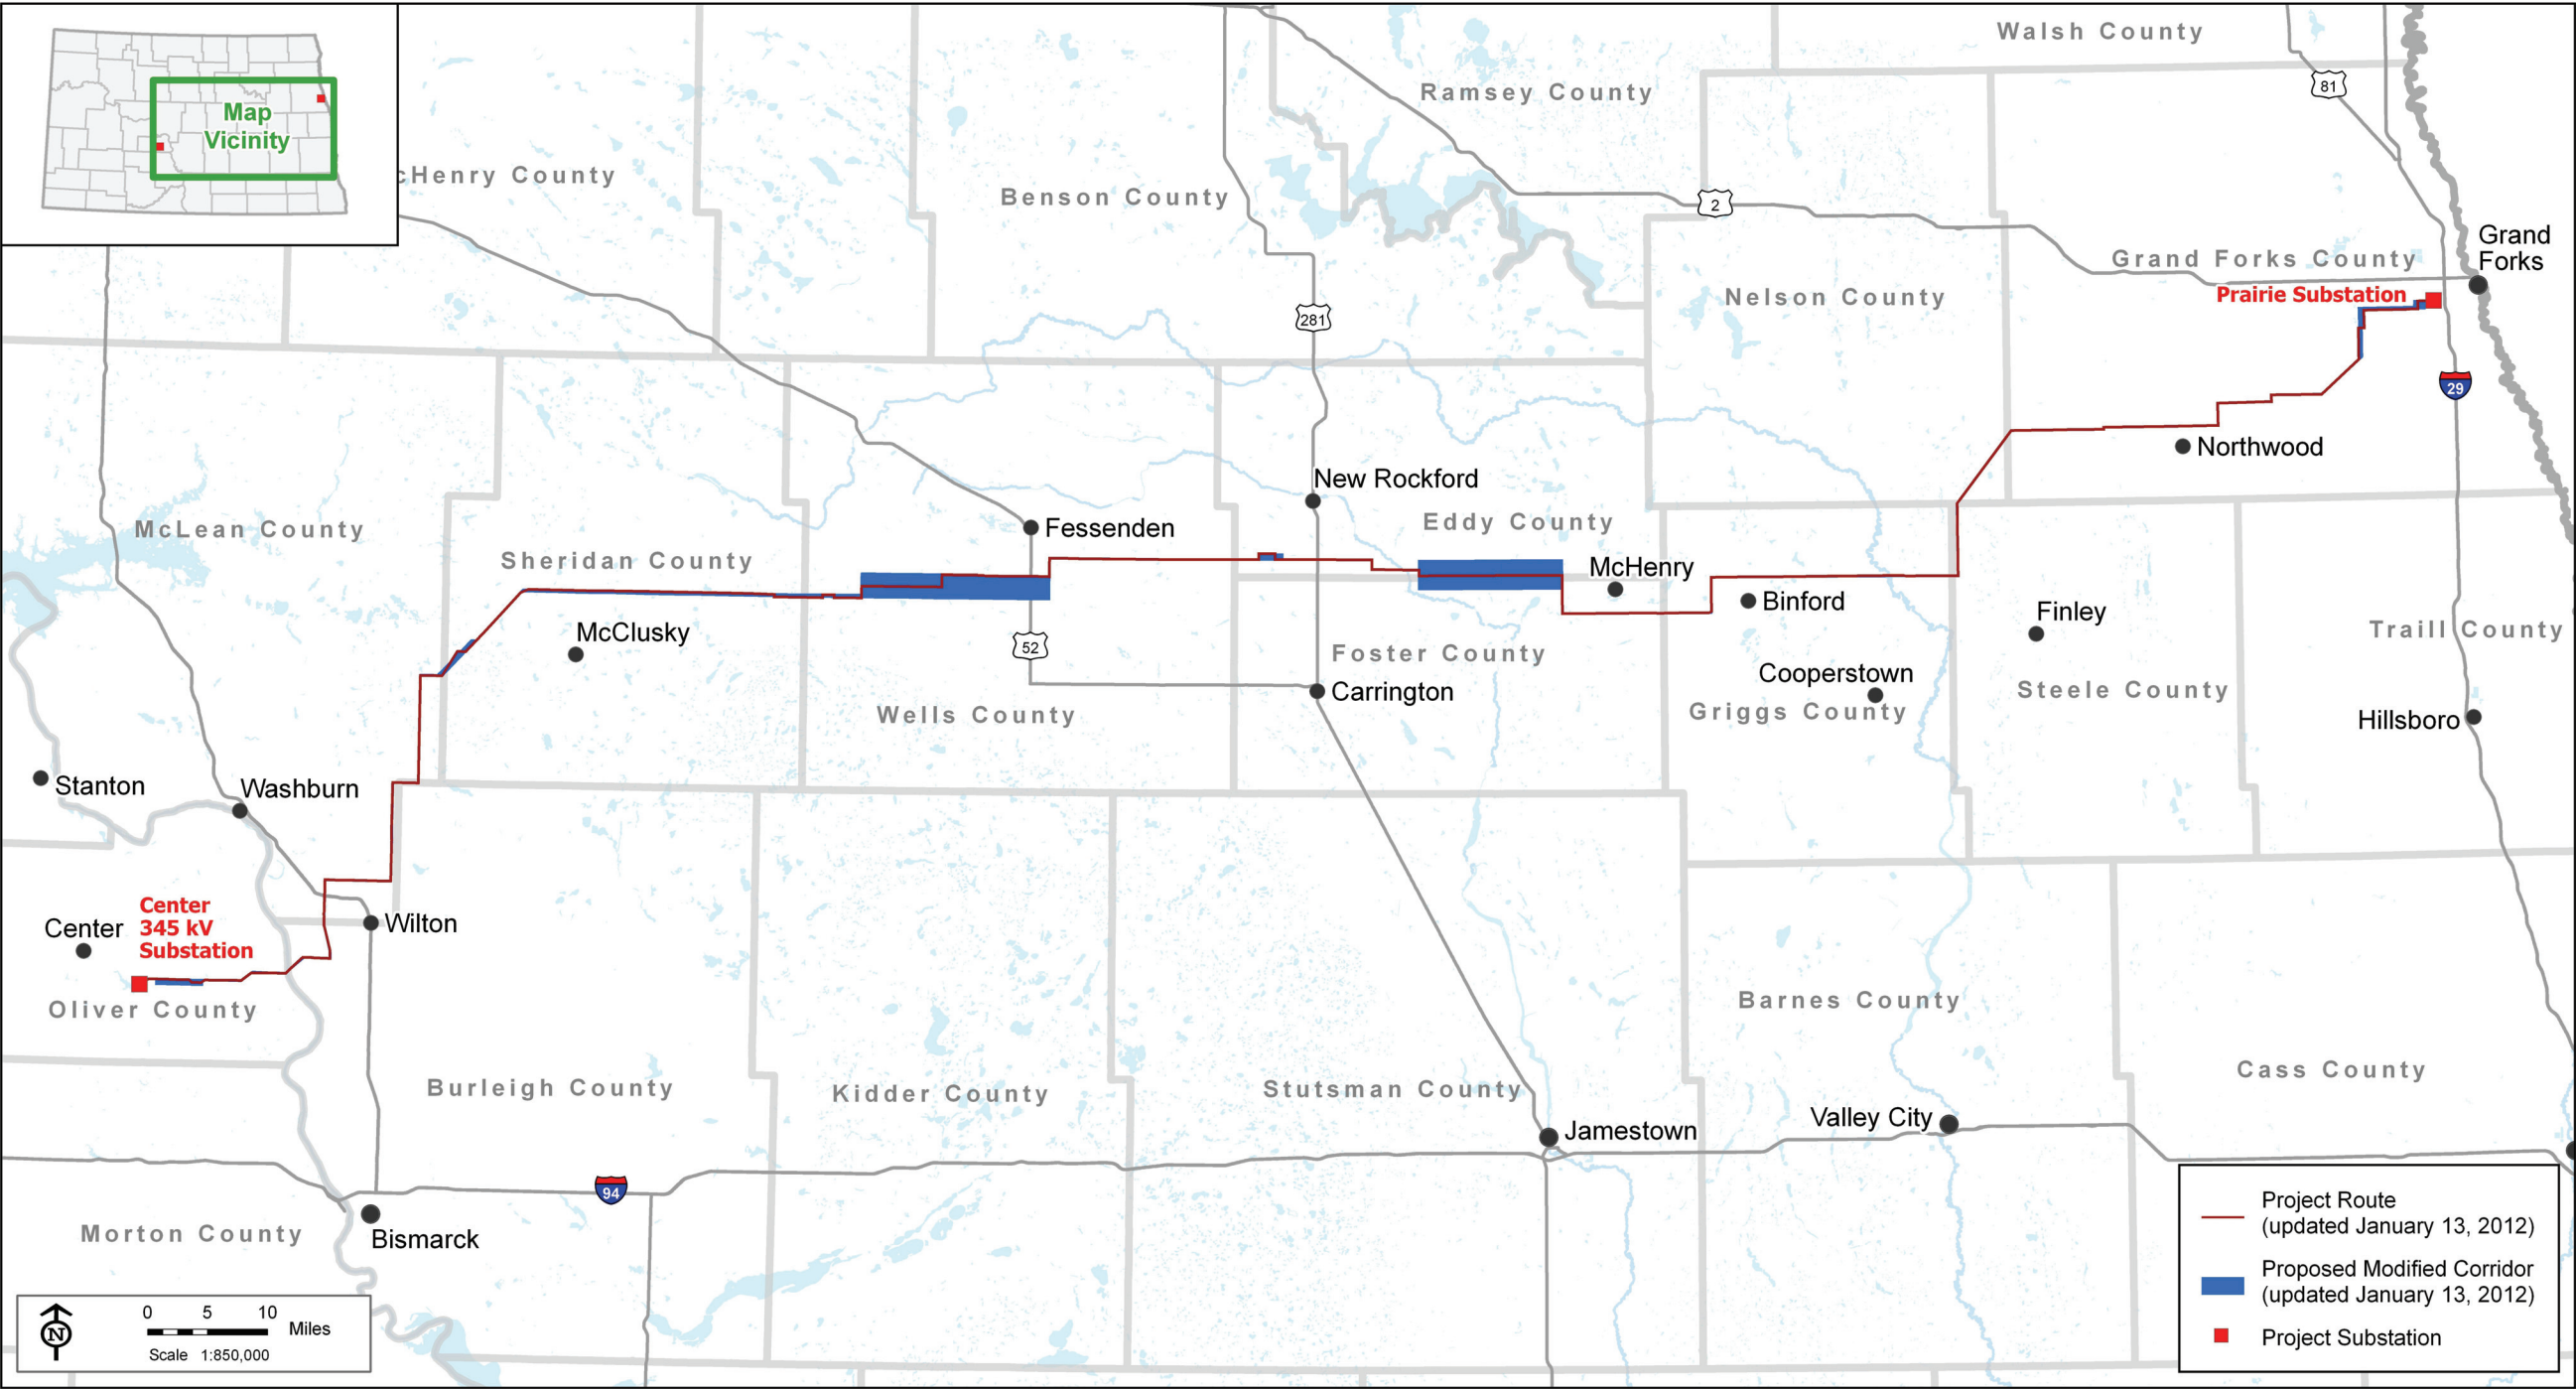

Center to Grand Forks Project