

Exhibit E1

Route Maps with Modified Corridor


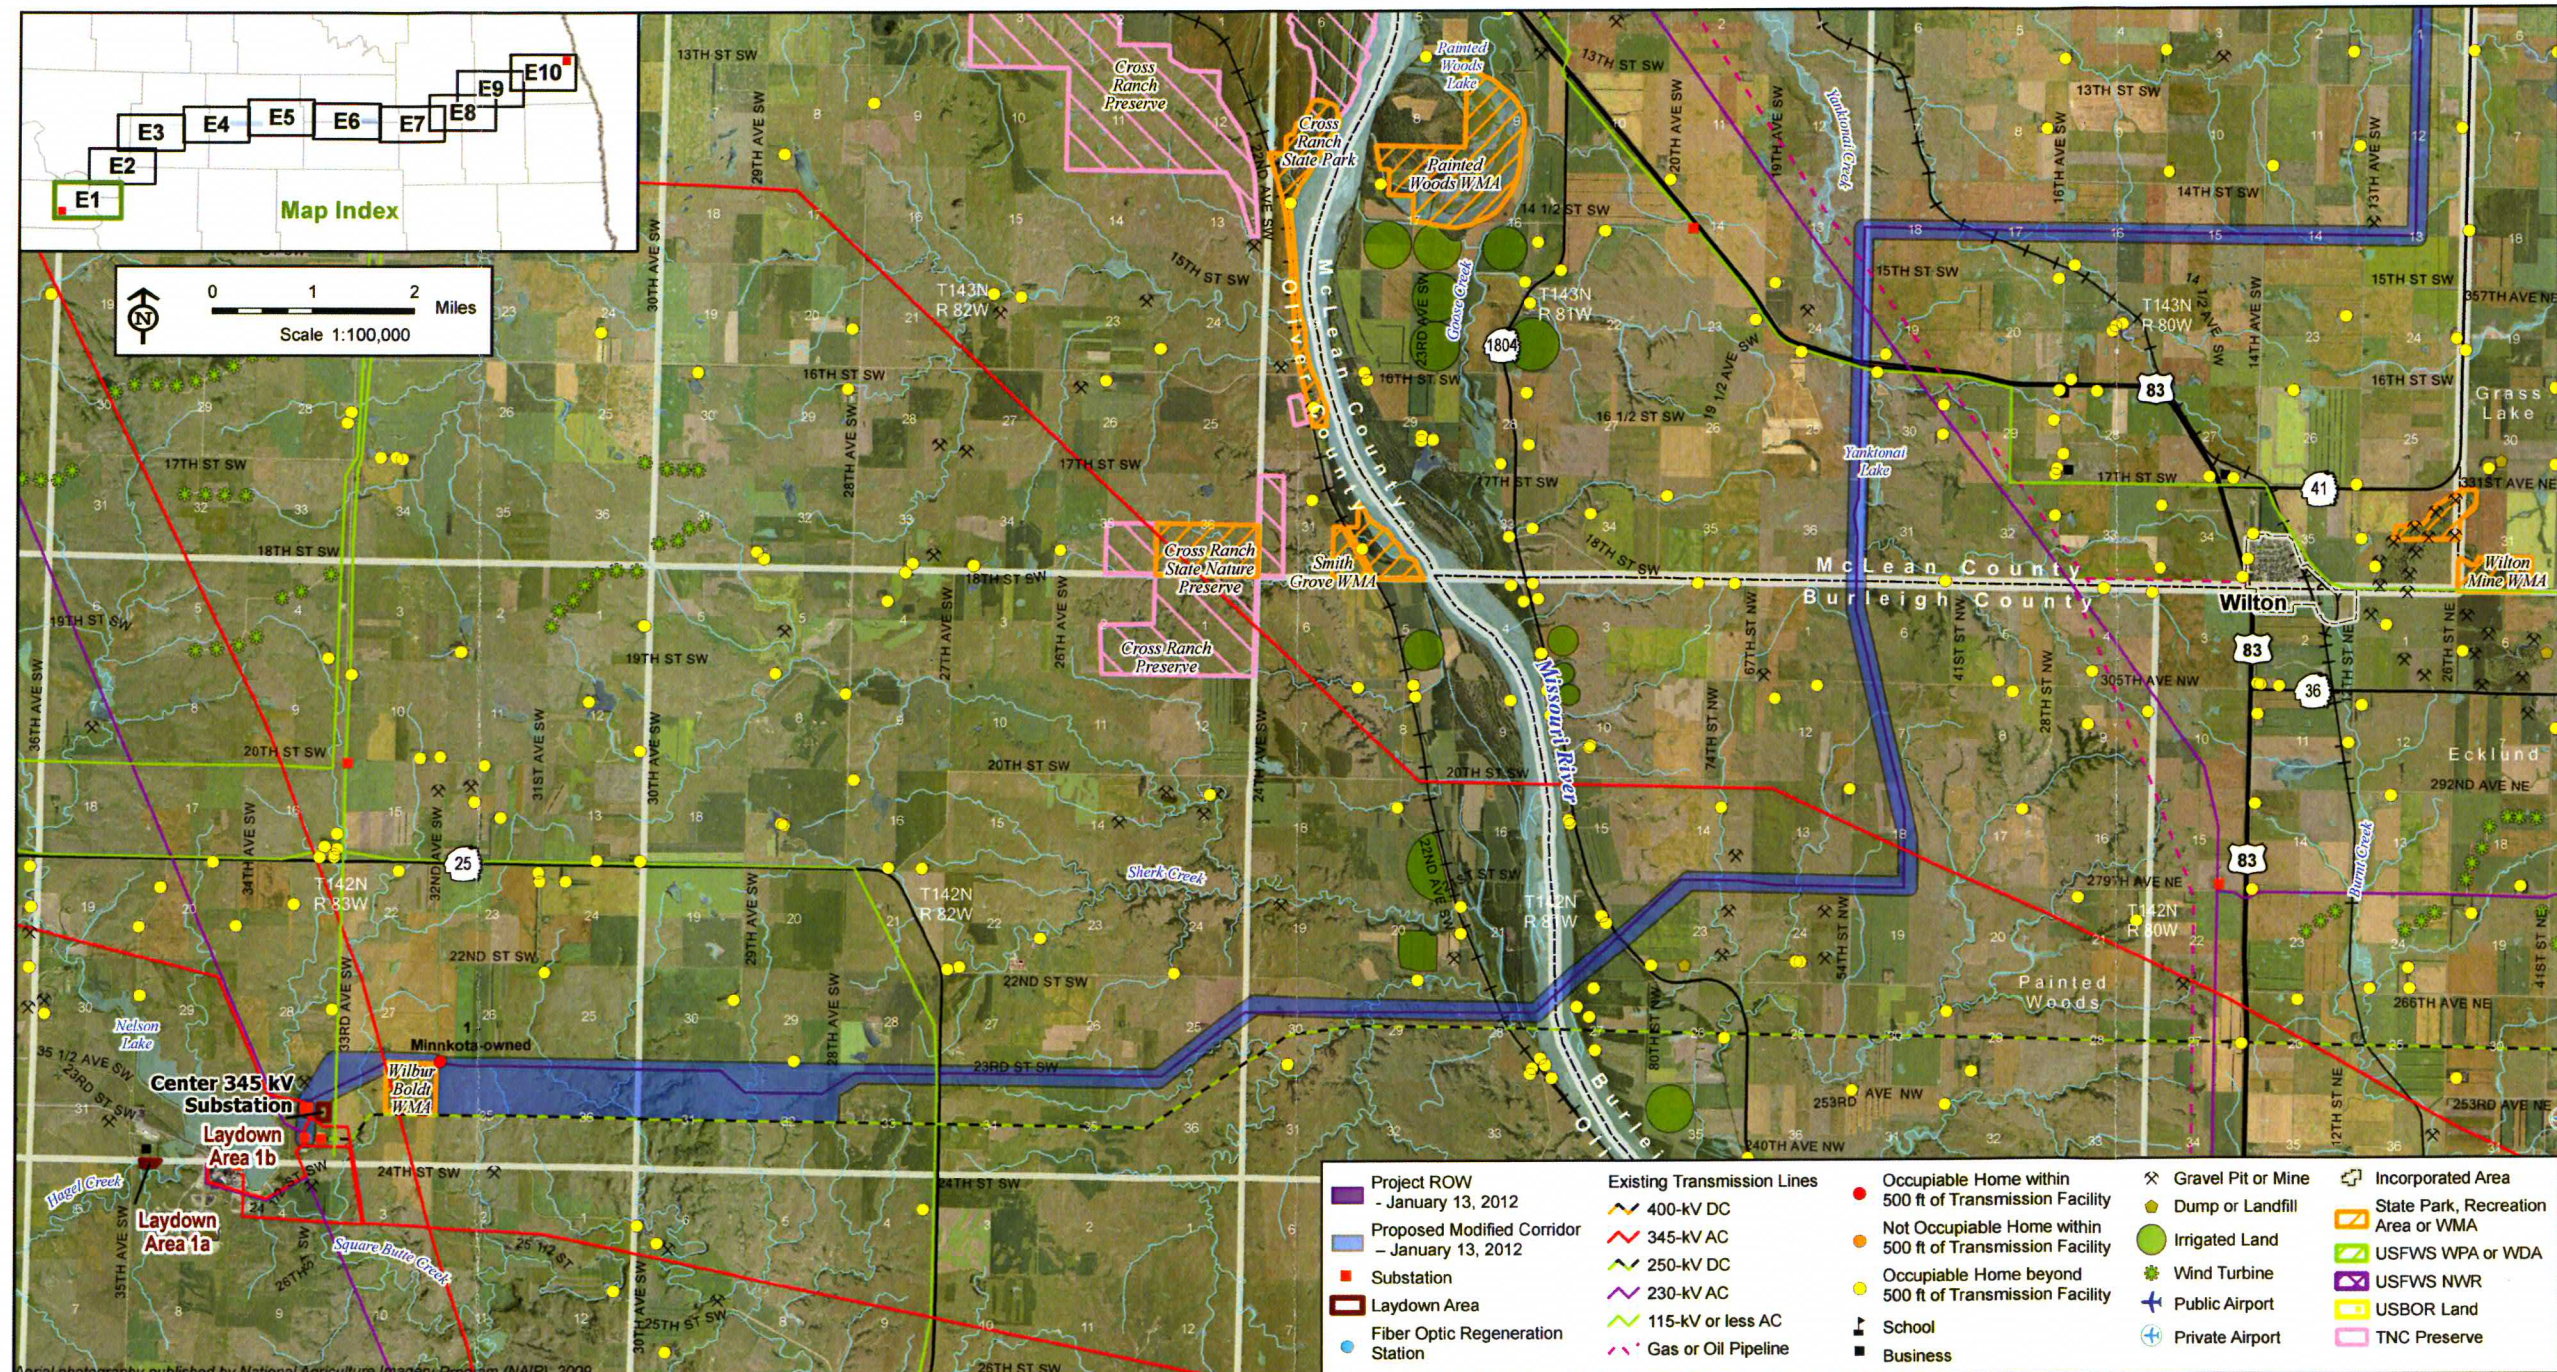


Exhibit E2

Route Maps with Modified Corridor

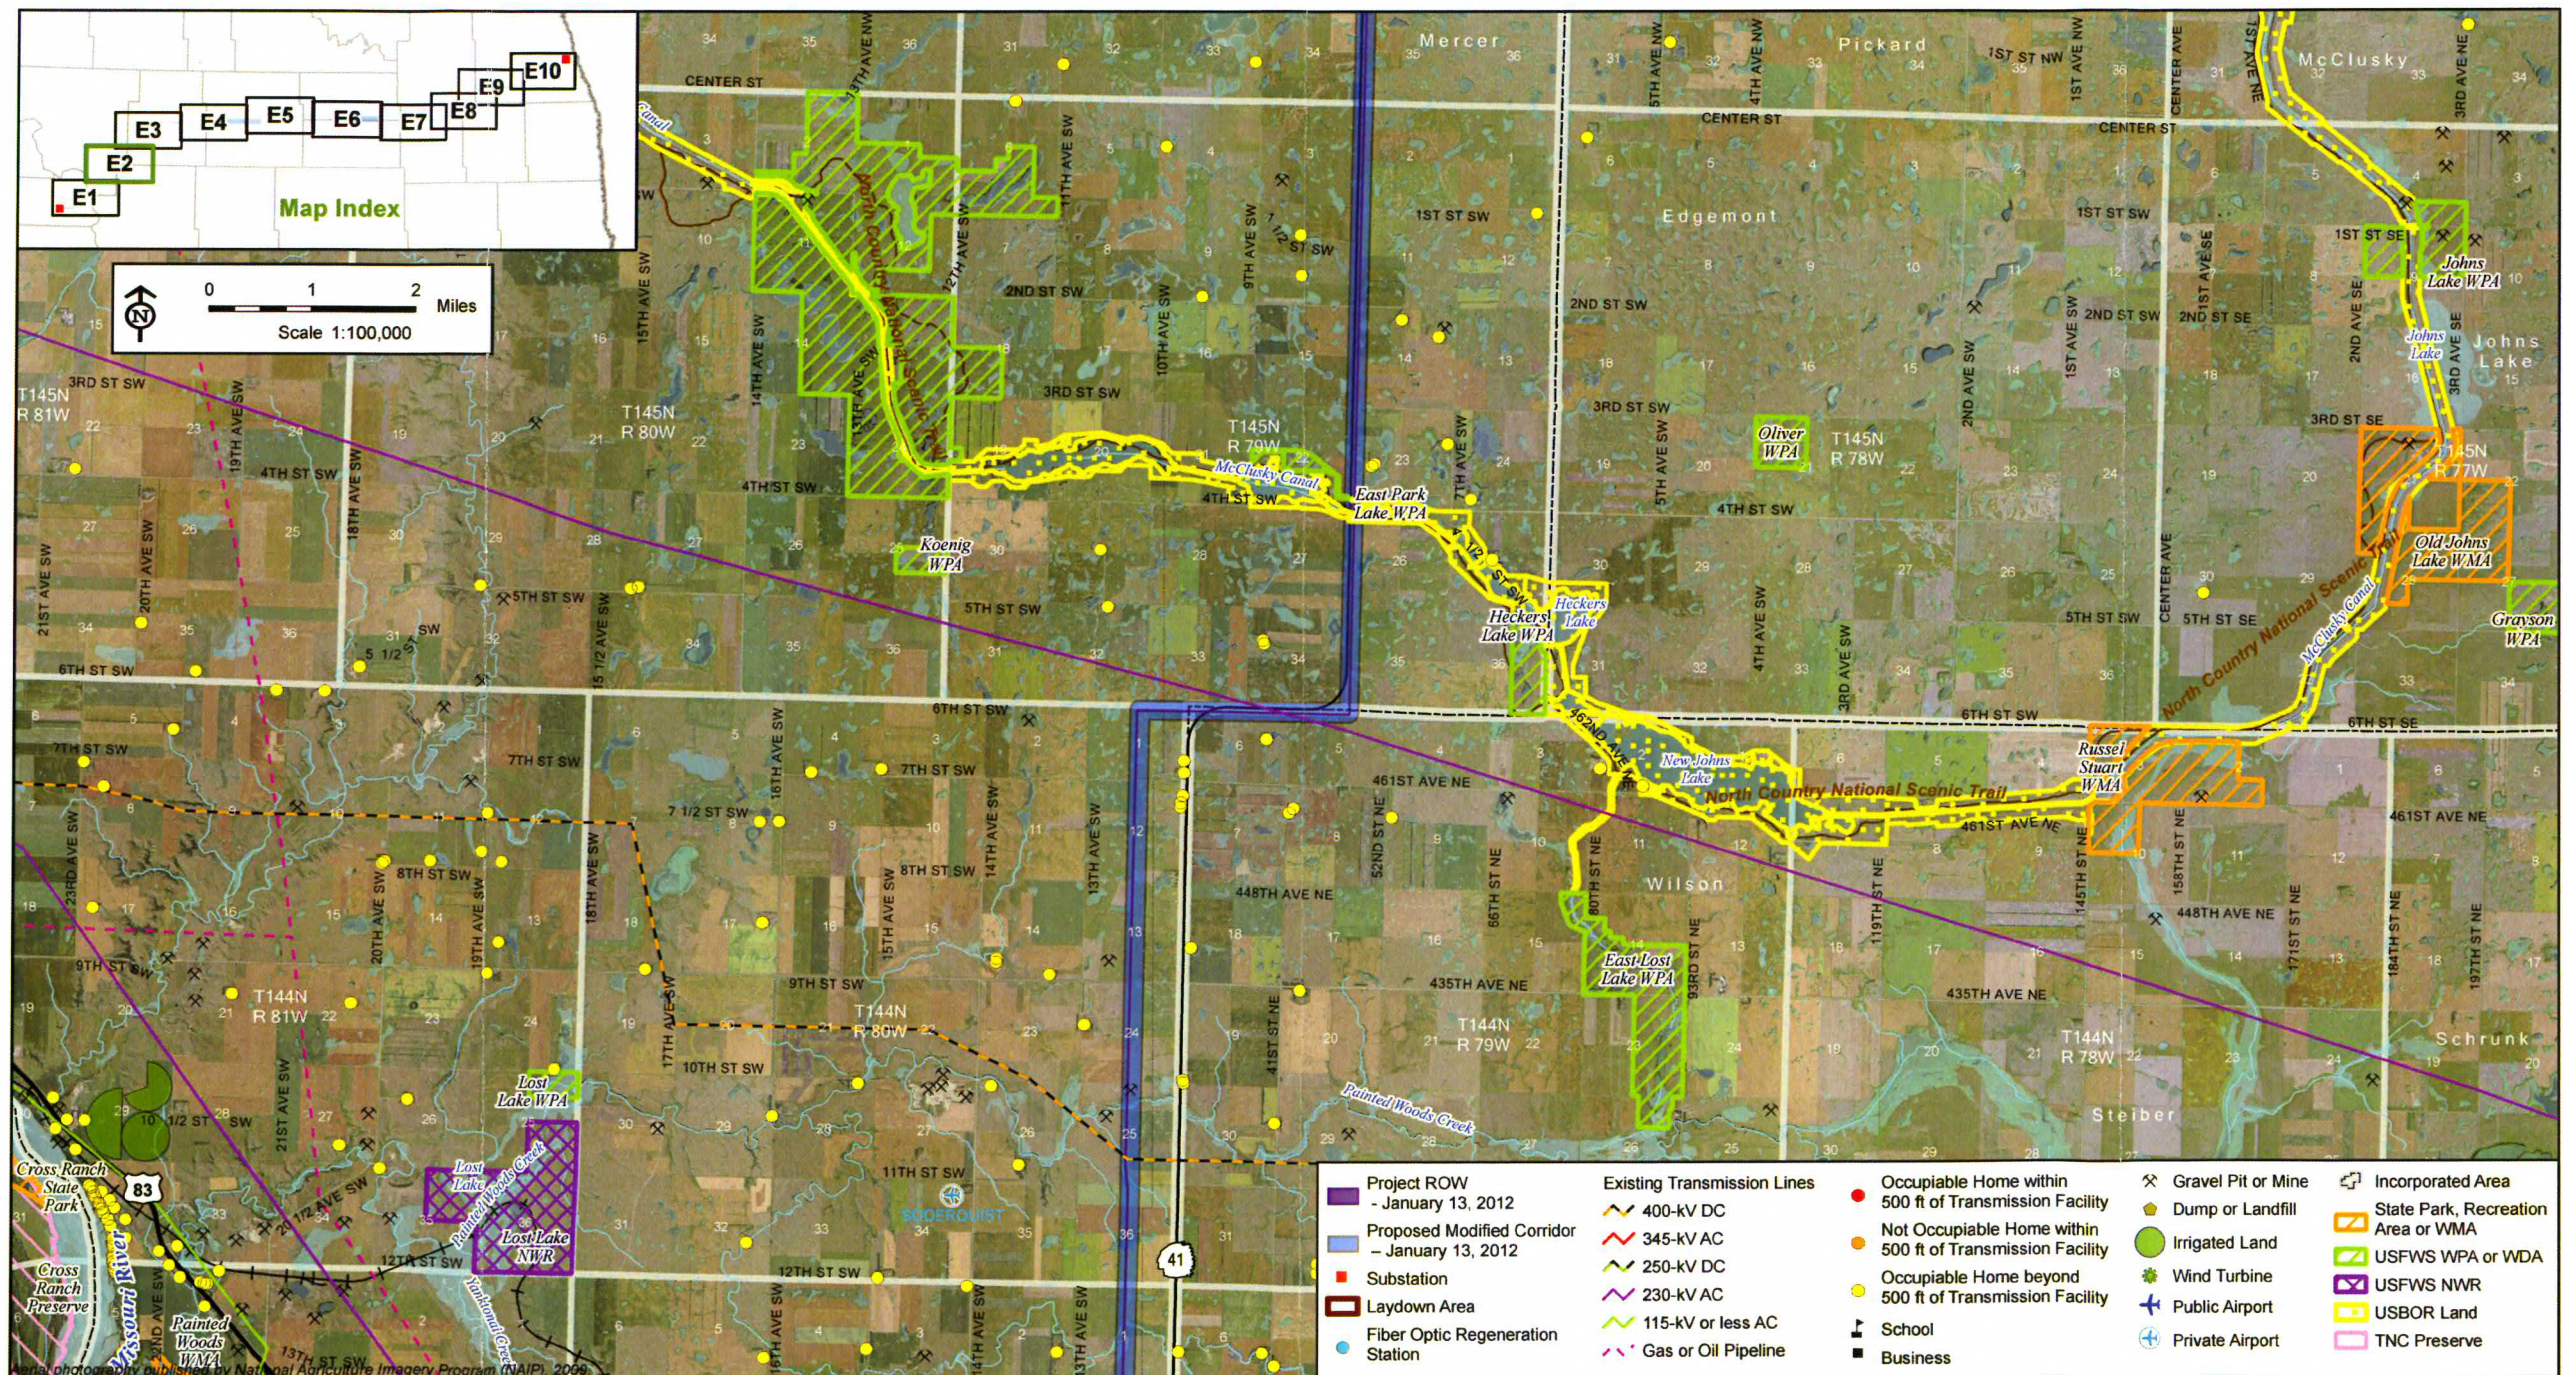


Center to Grand Forks Project

Minnkota Power
COOPERATIVE, INC.

Exhibit E3


Route Maps with Modified Corridor

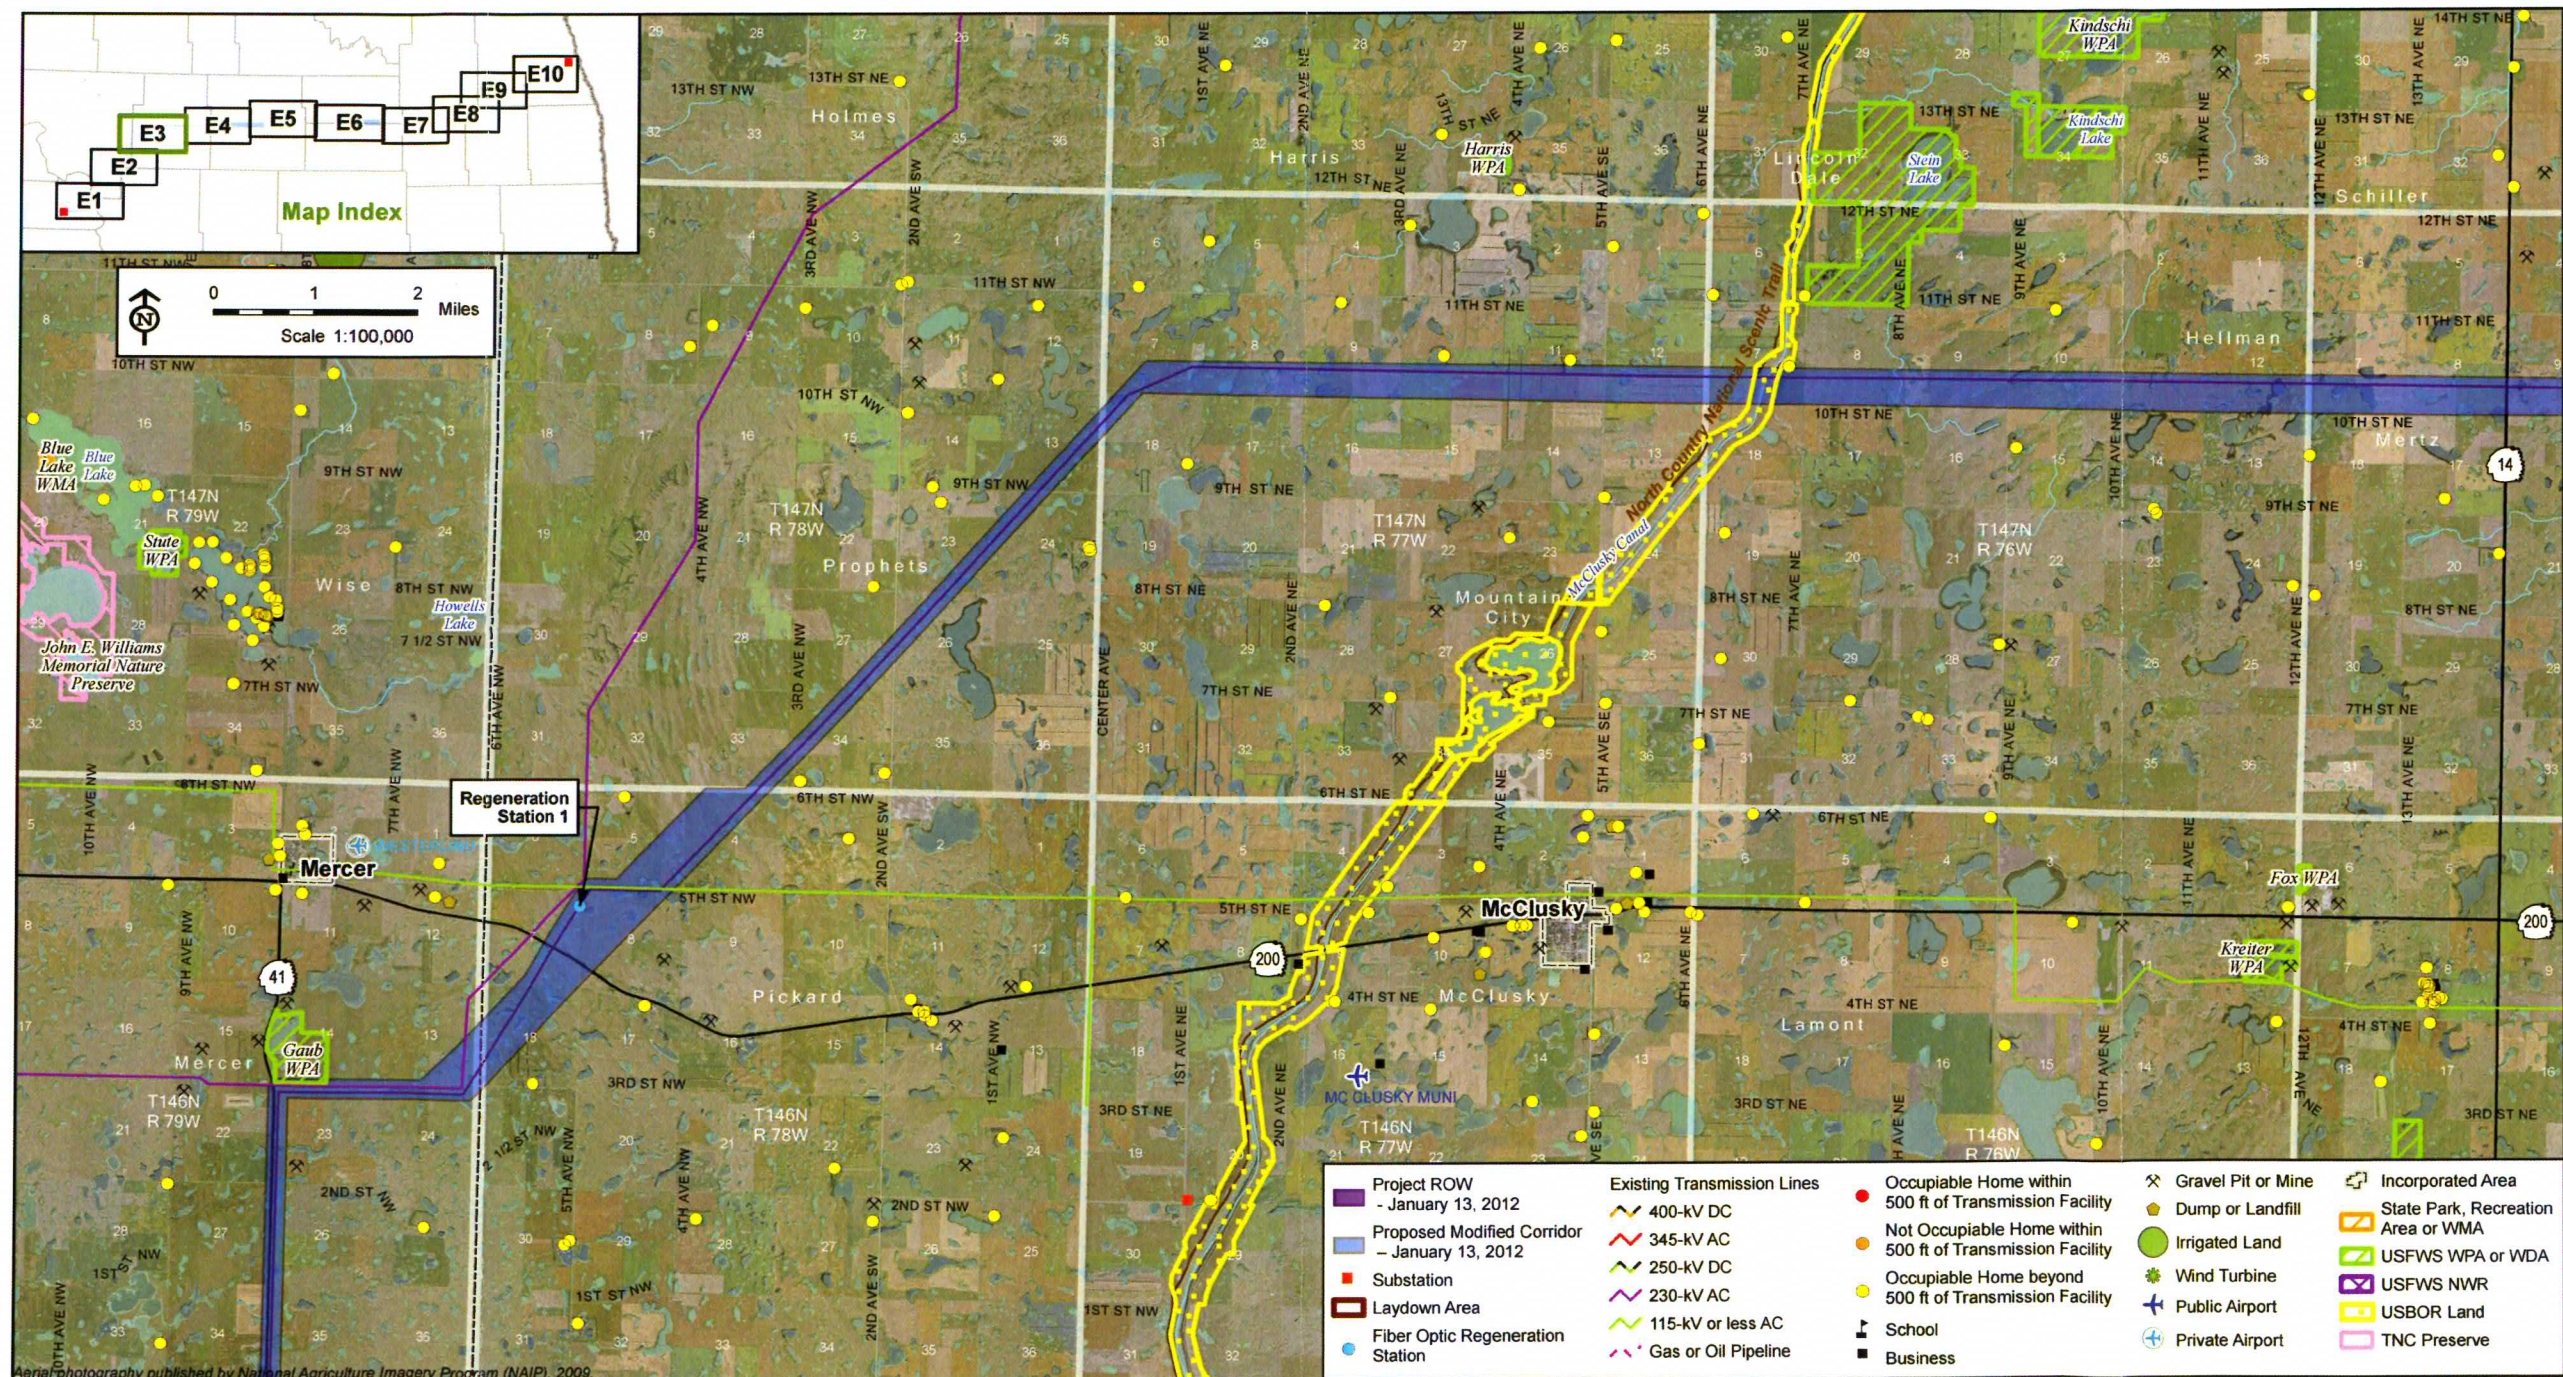

Center to Grand Forks Project

Exhibit E4

Route Maps with Modified Corridor

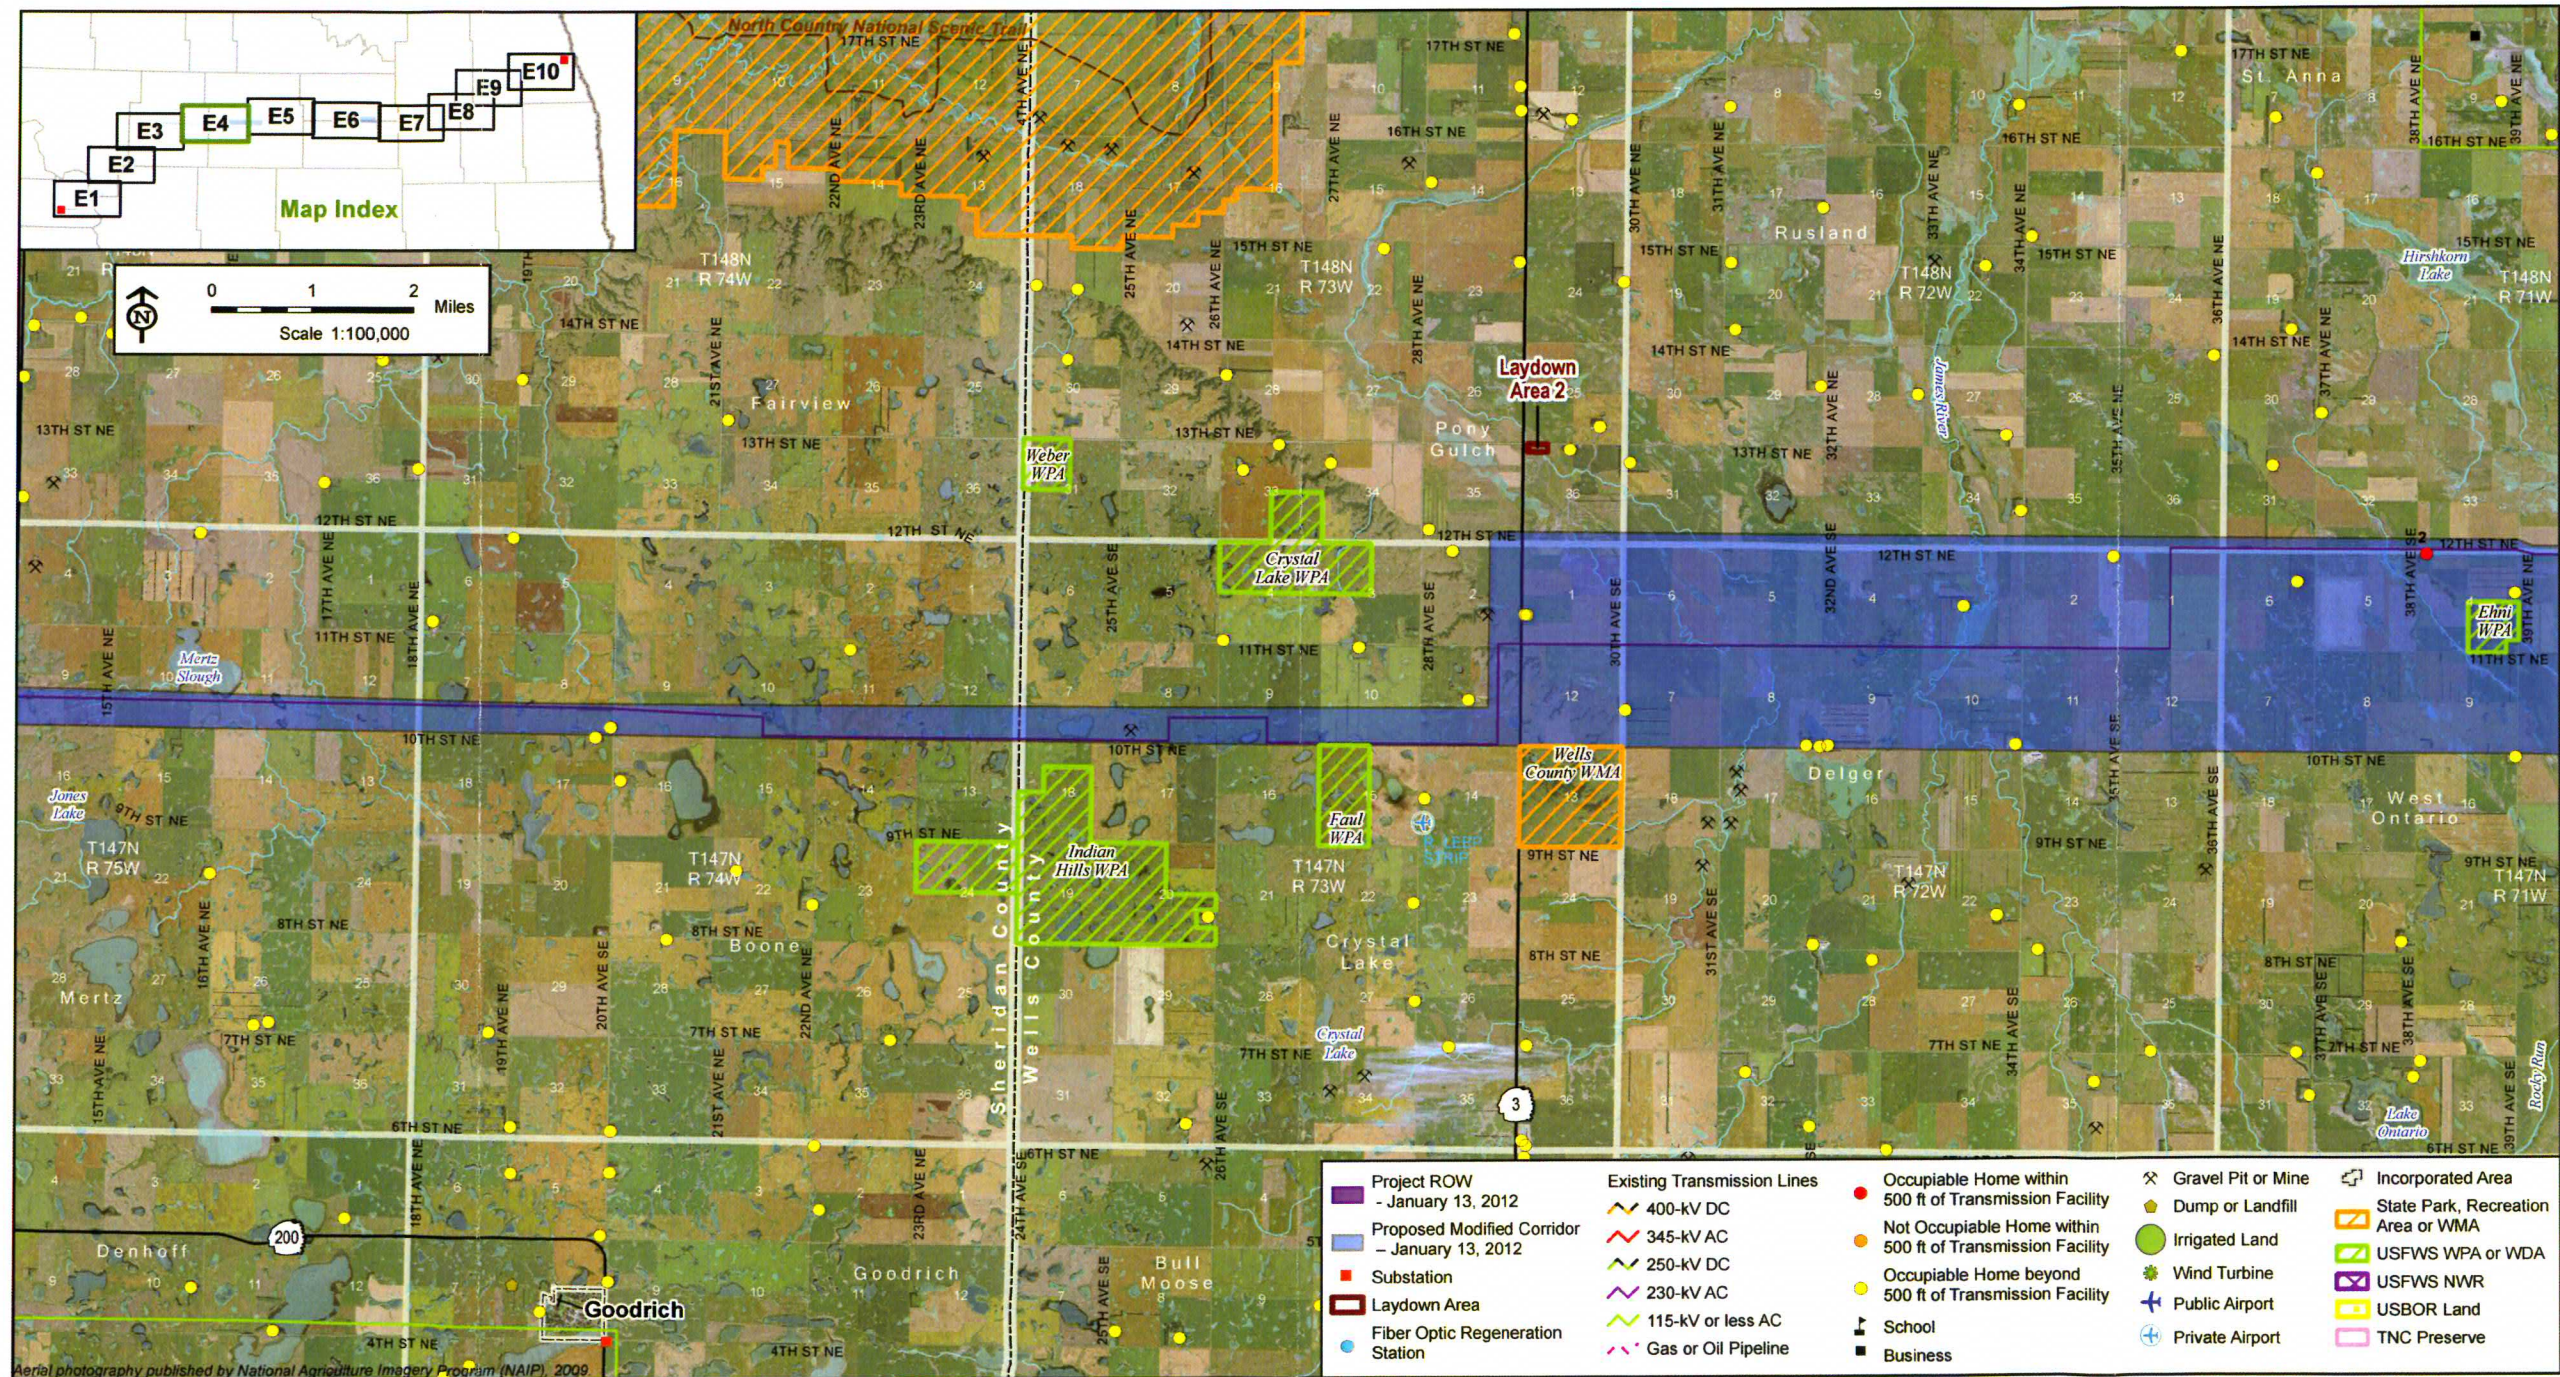


Center to Grand Forks Project

Minnkota Power
MPC COOPERATIVE, INC.

Exhibit E5


Route Maps with Modified Corridor

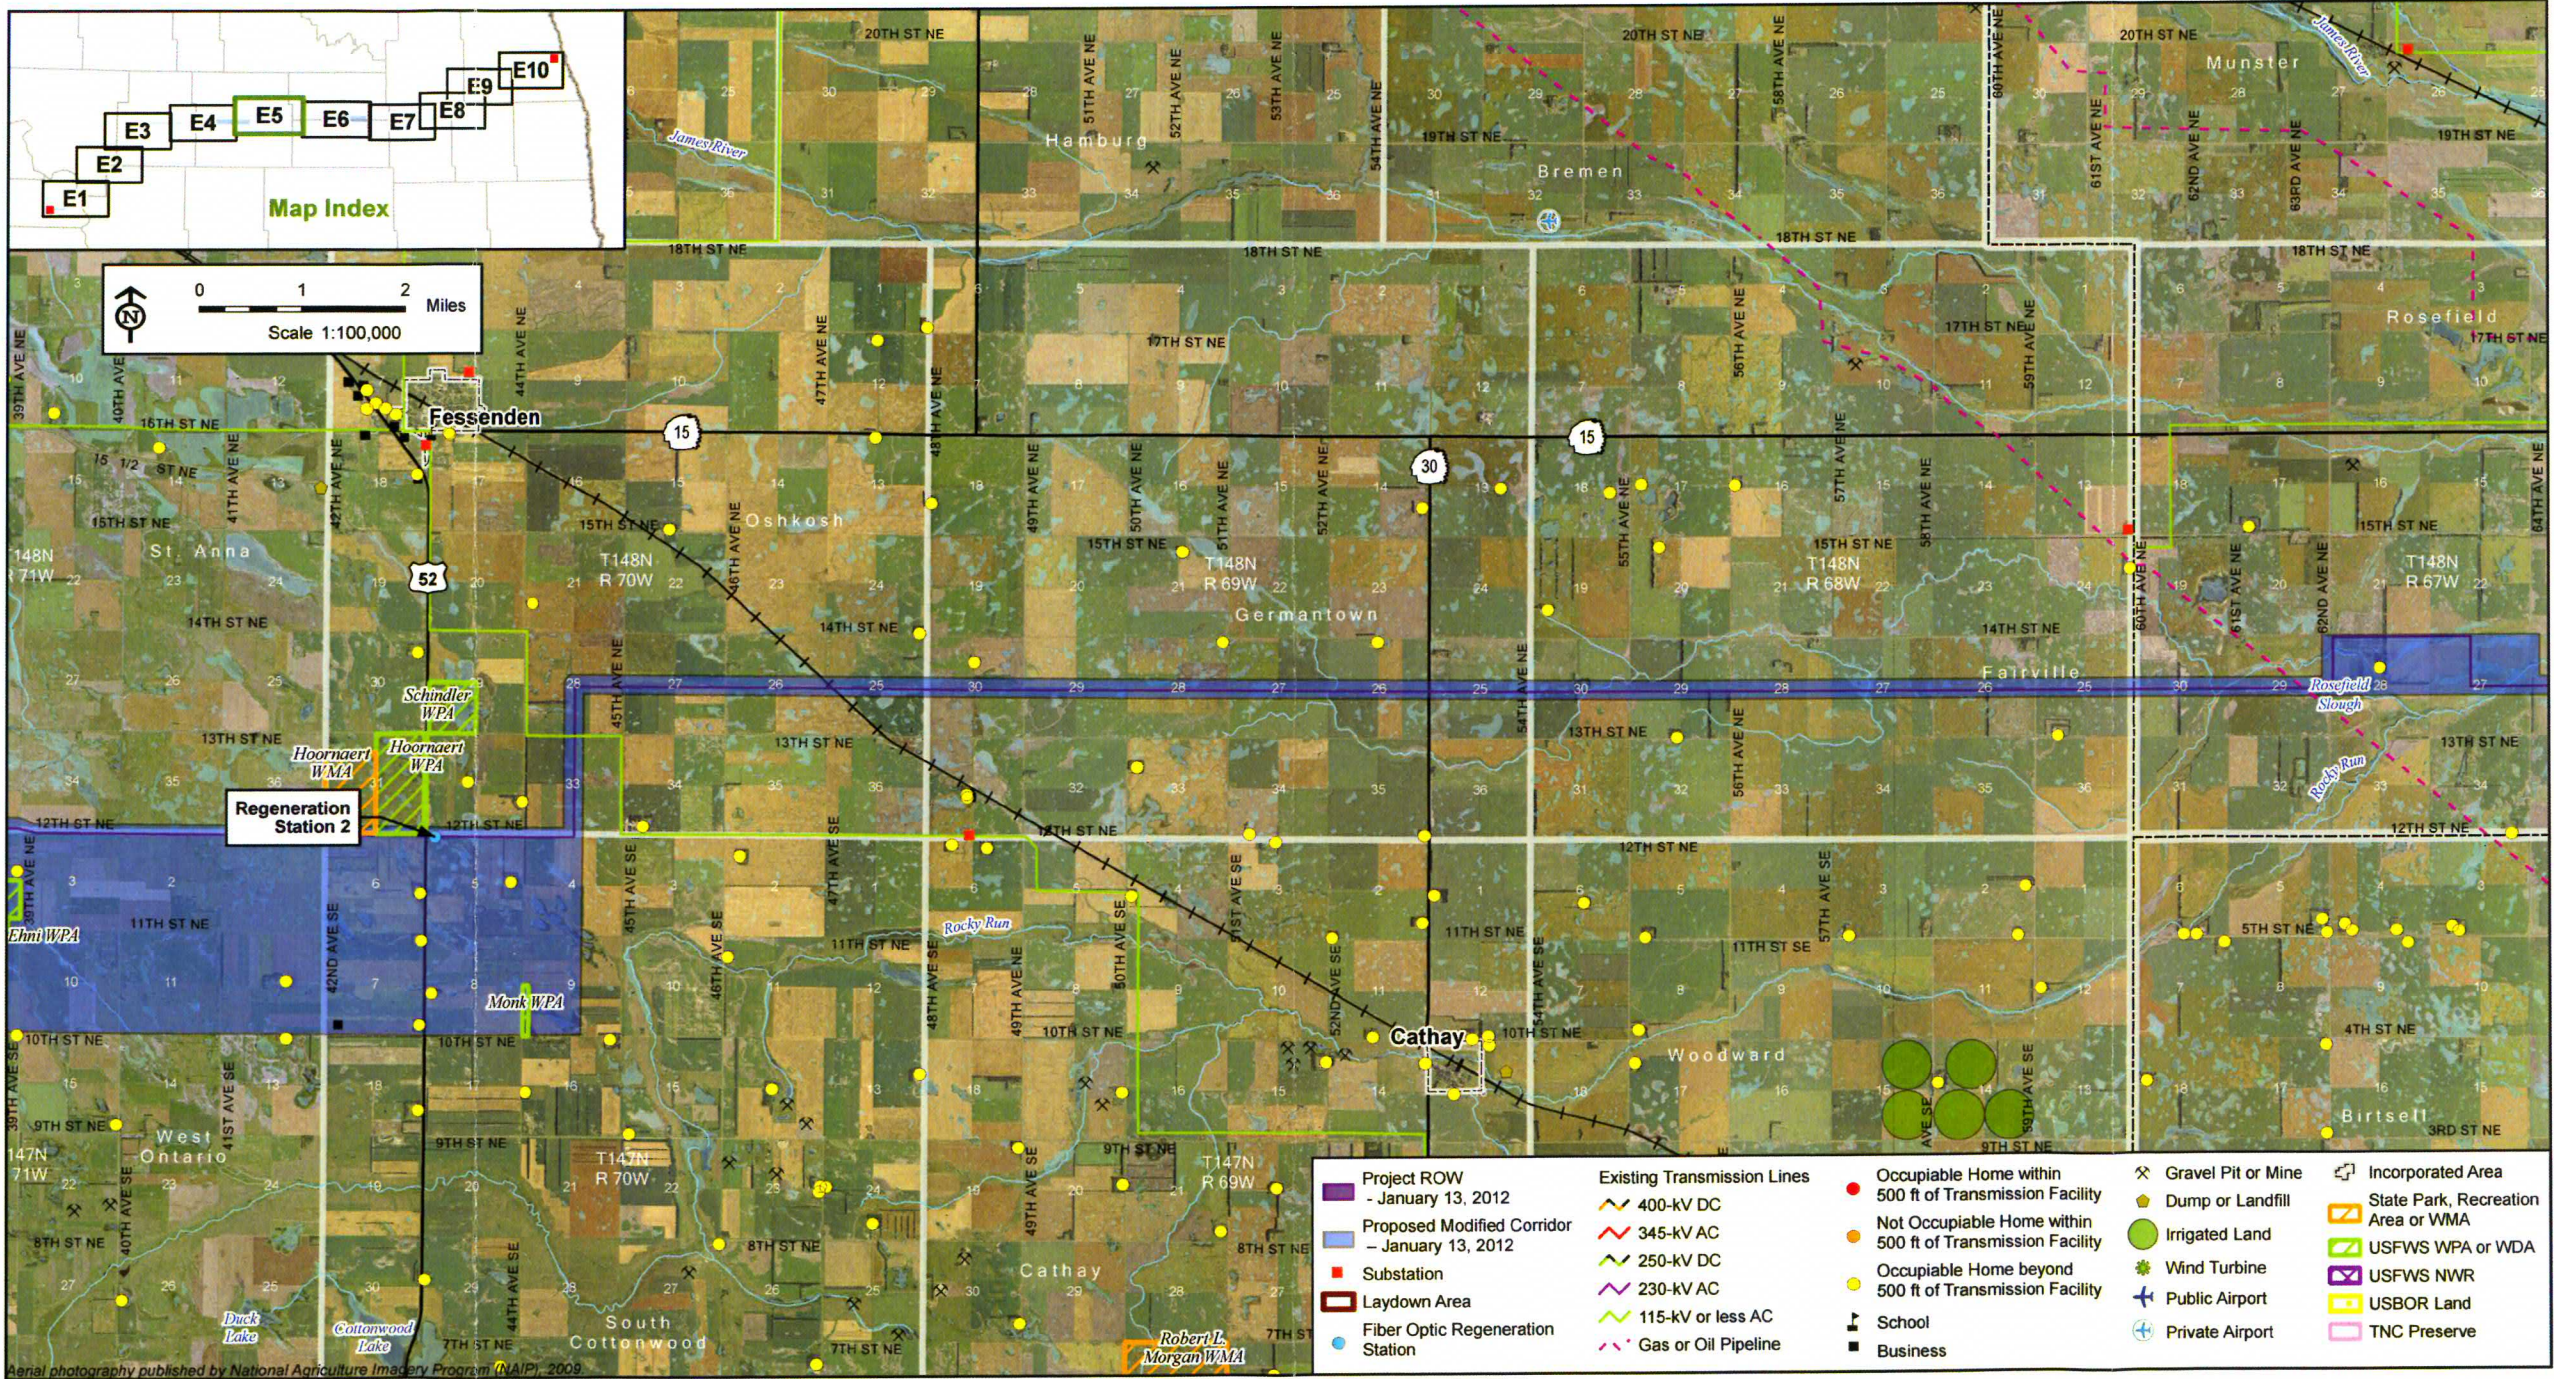

Center to Grand Forks Project

Exhibit E6

Route Maps with Modified Corridor

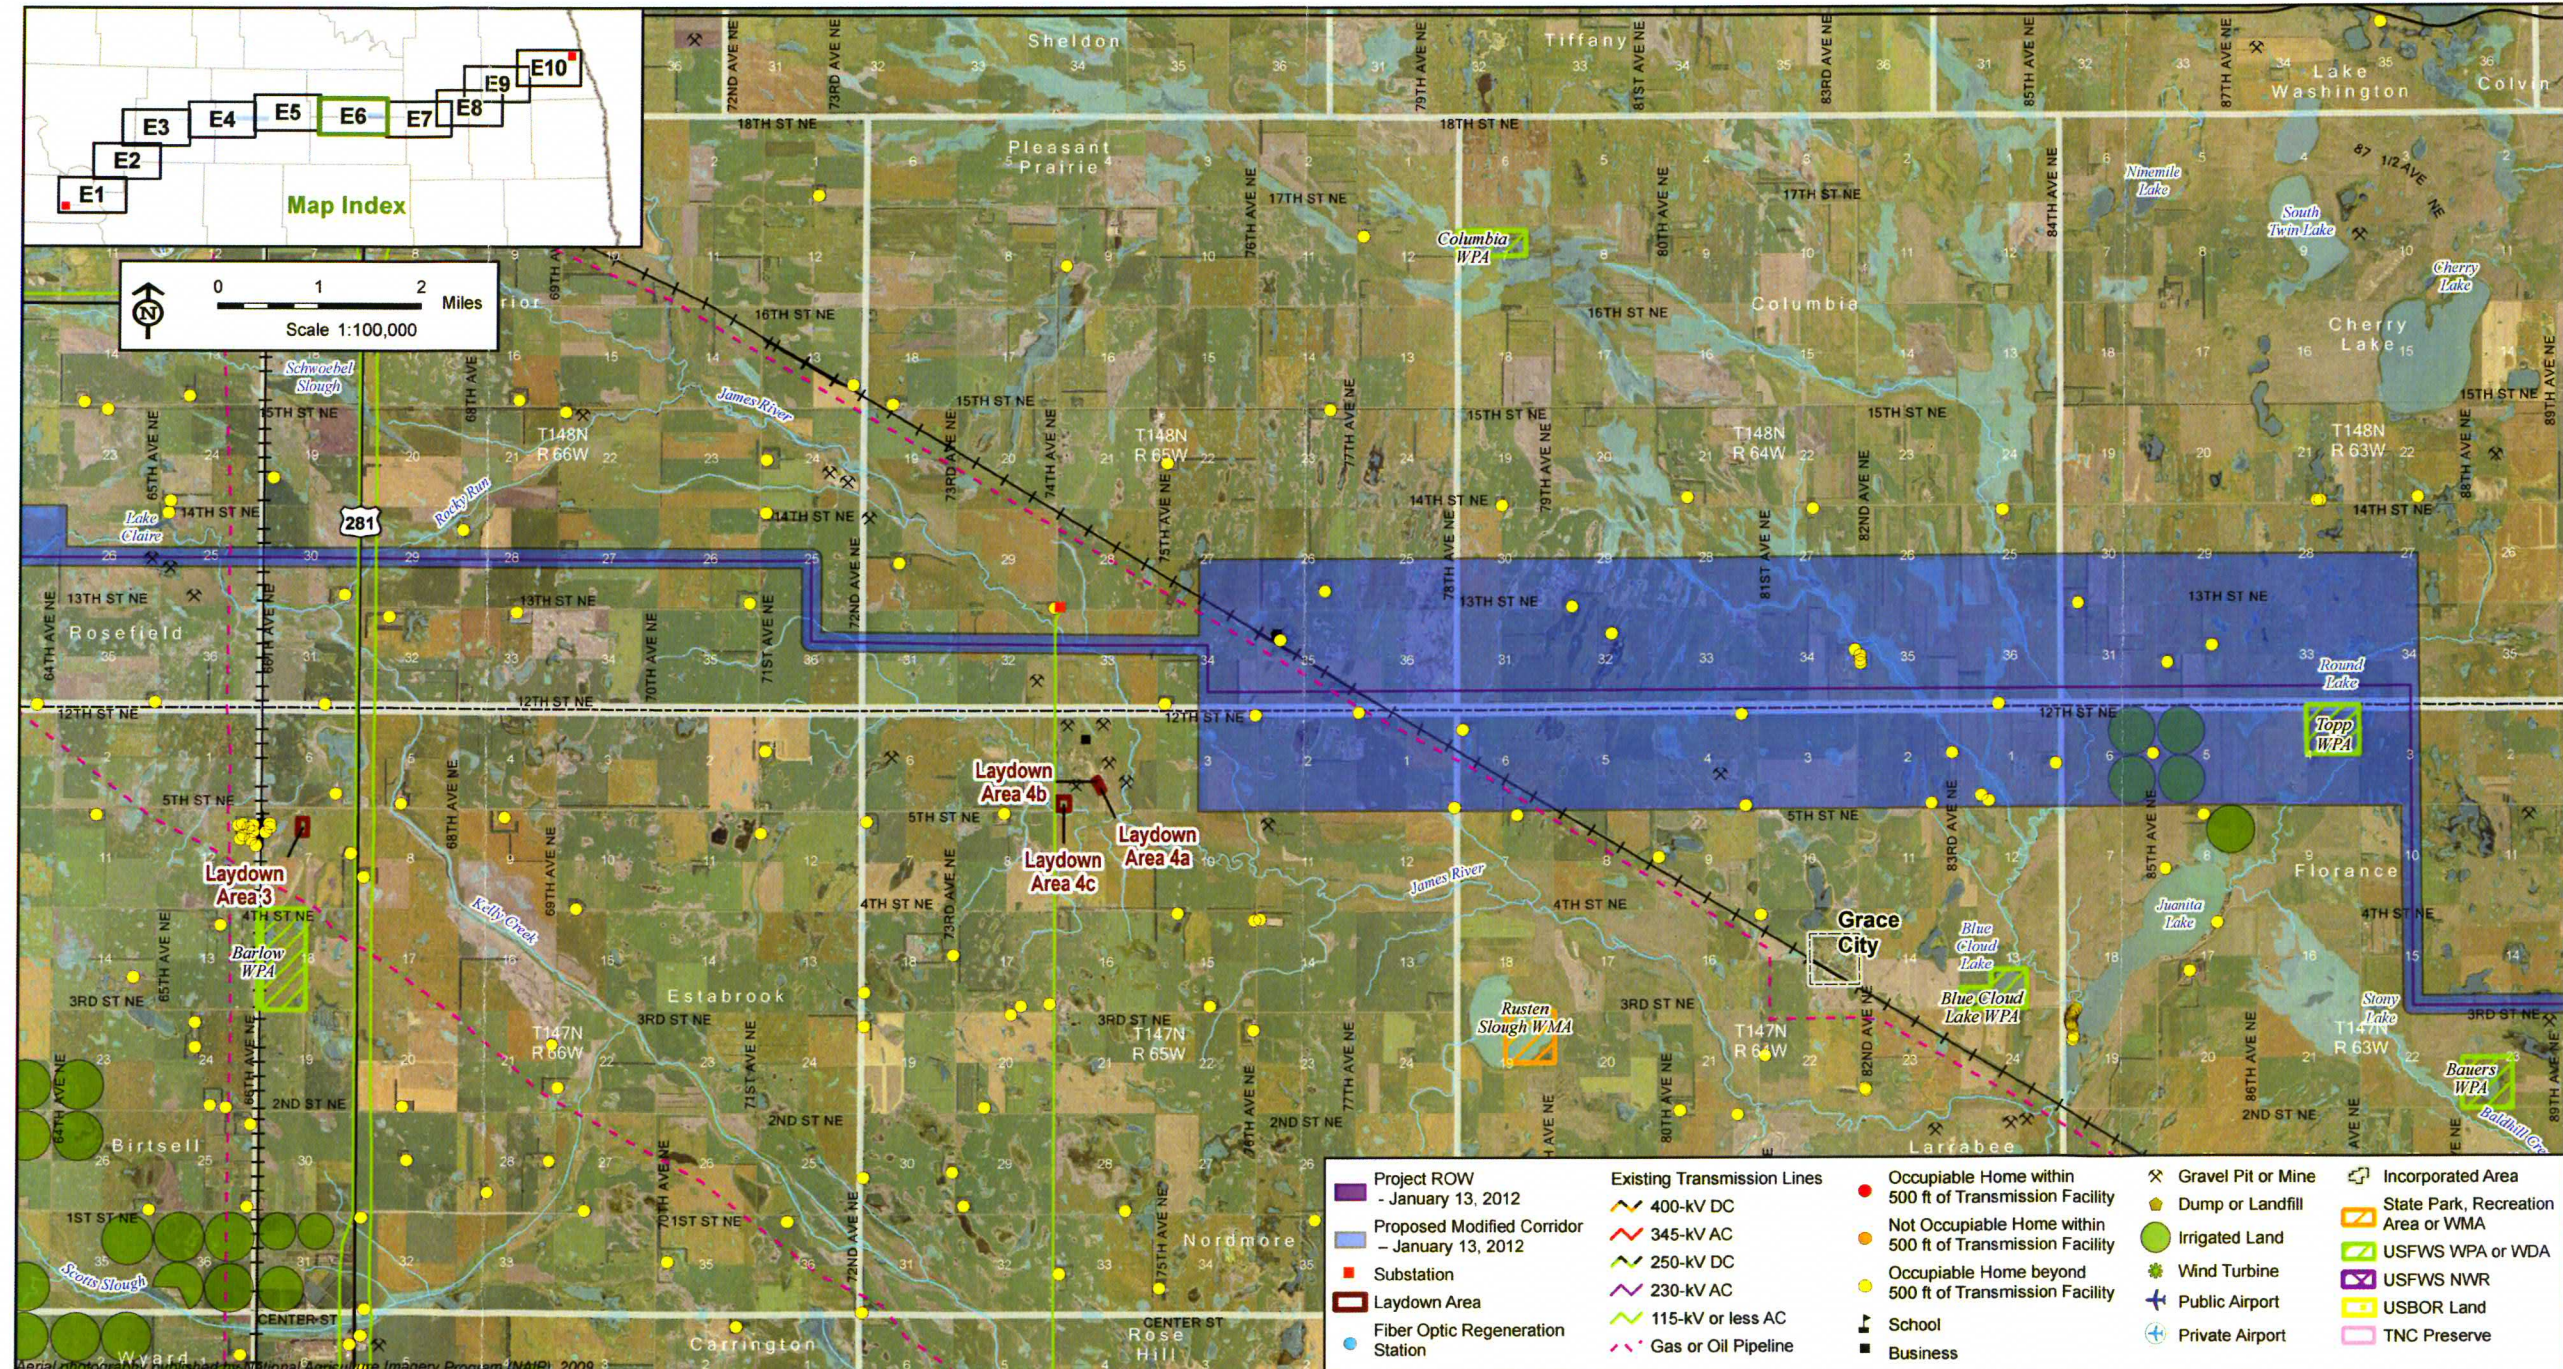


Center to Grand Forks Project

Minnkota Power
MPC COOPERATIVE, INC.

Exhibit E7


Route Maps with Modified Corridor

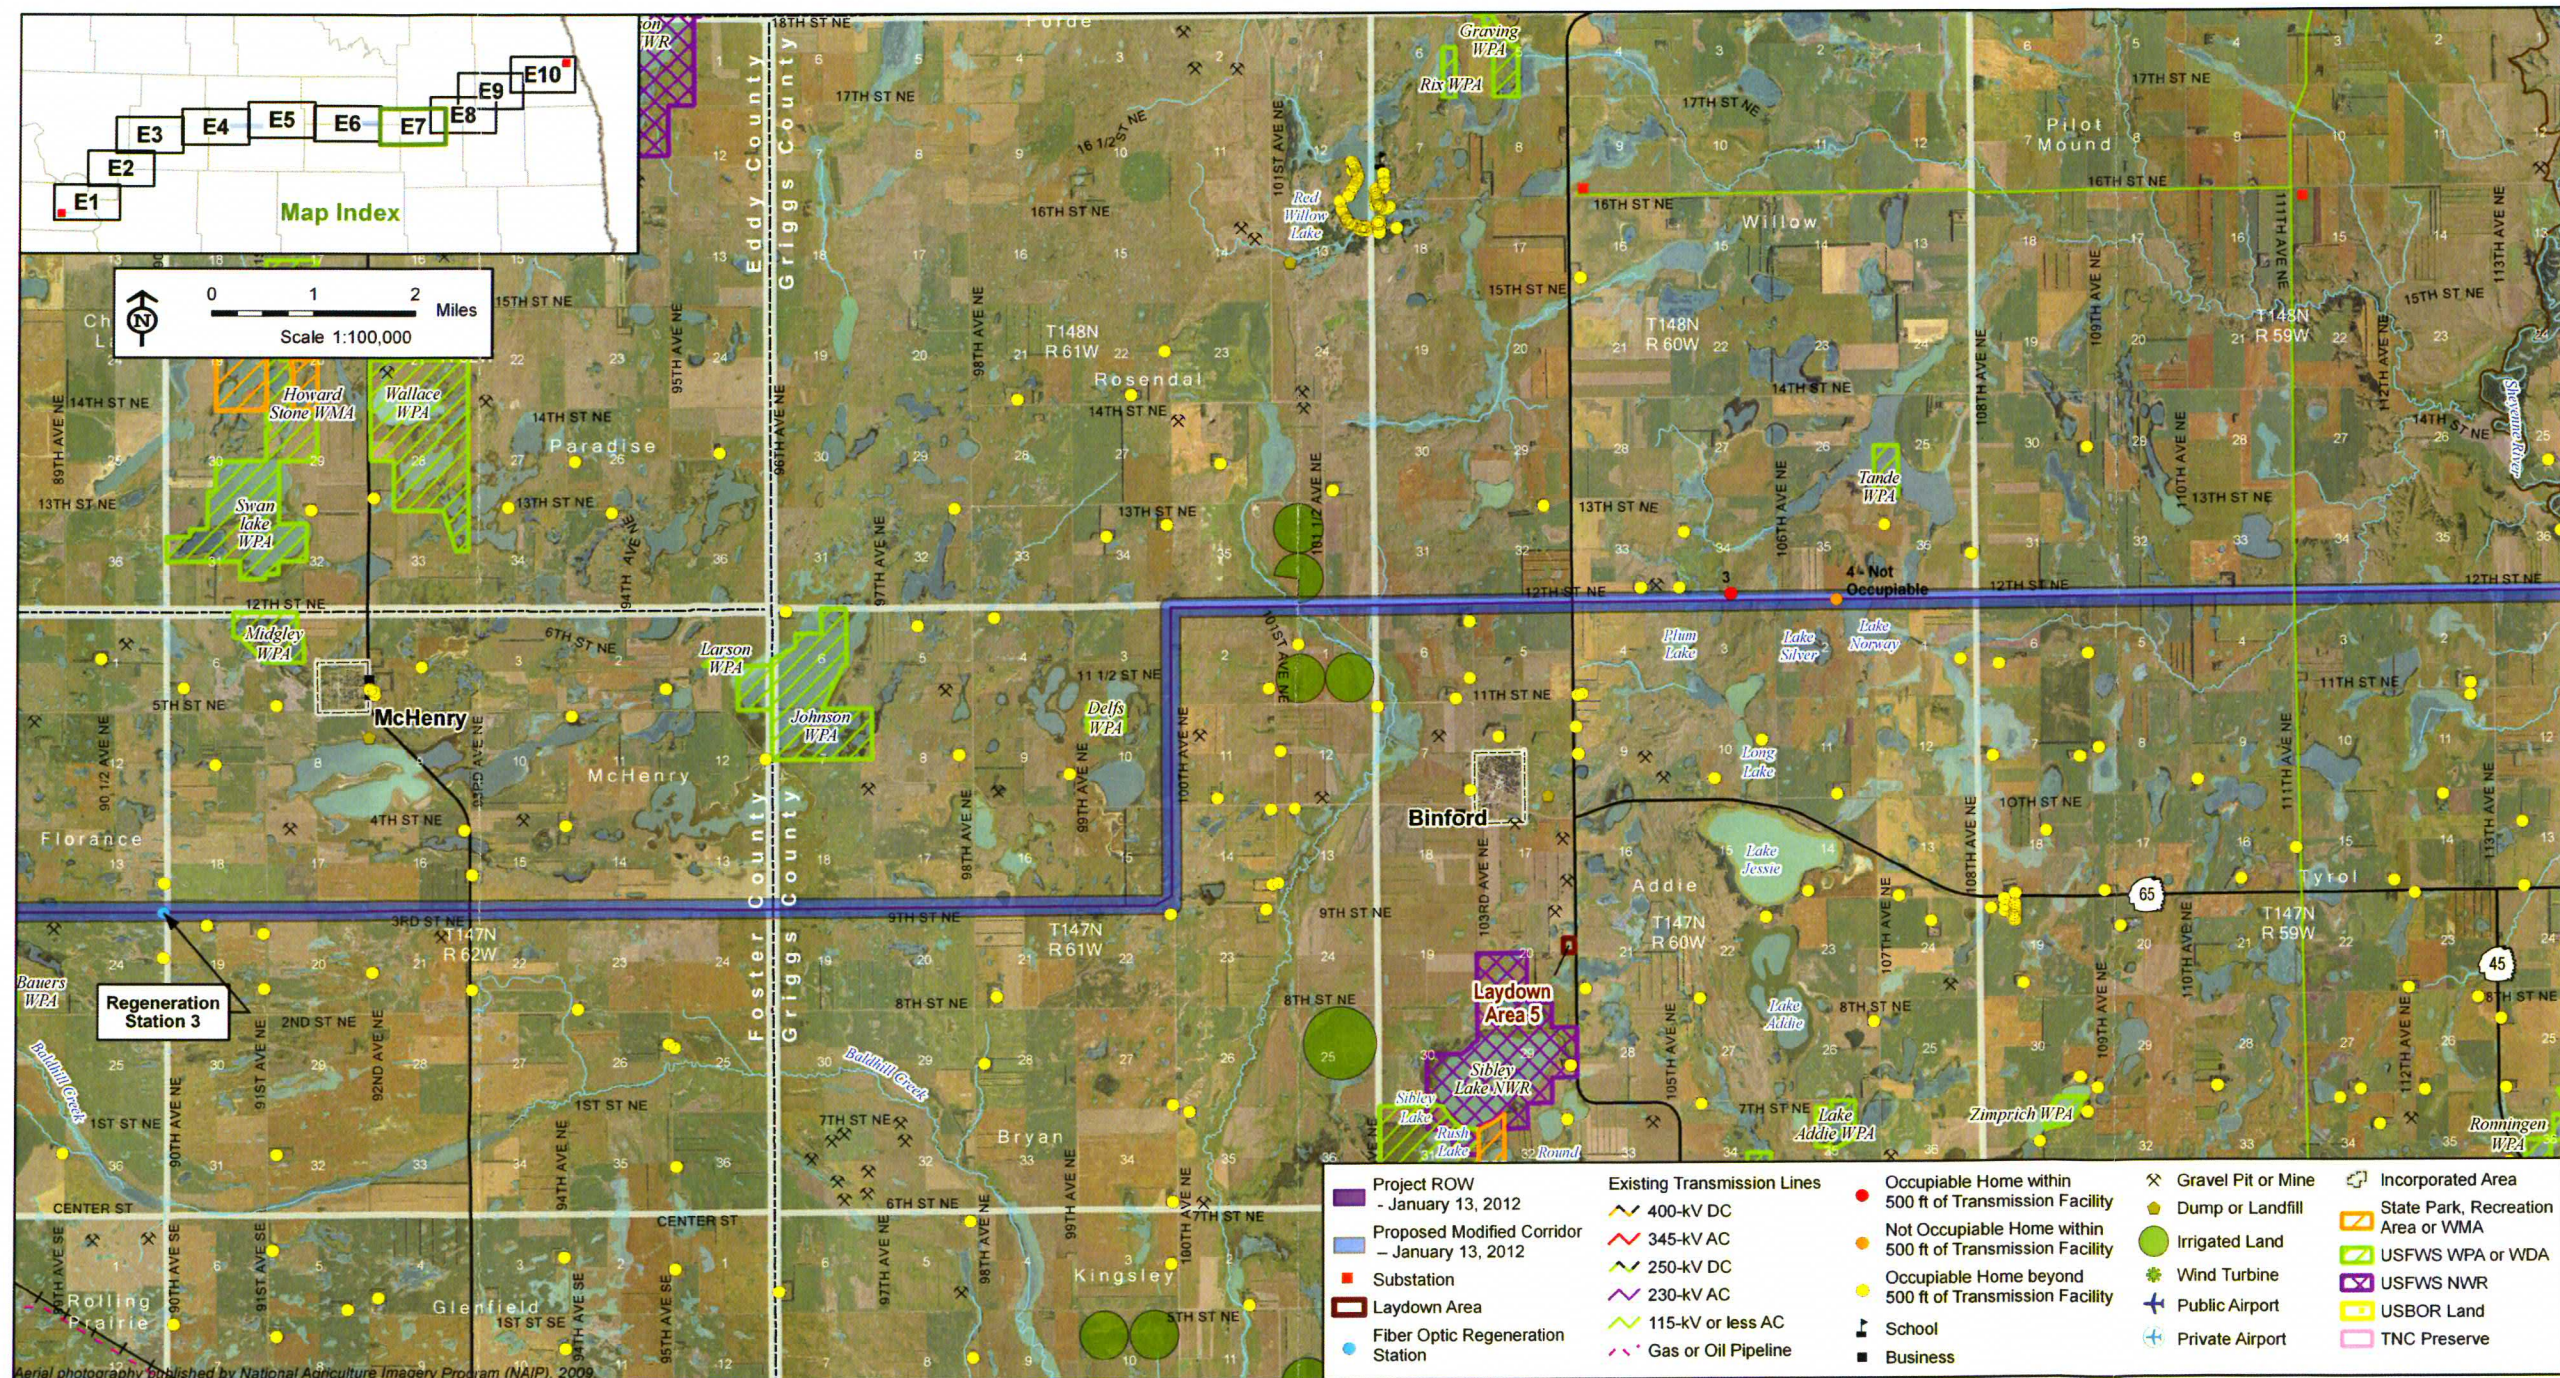

Center to Grand Forks Project

Exhibit E8


Route Maps with Modified Corridor

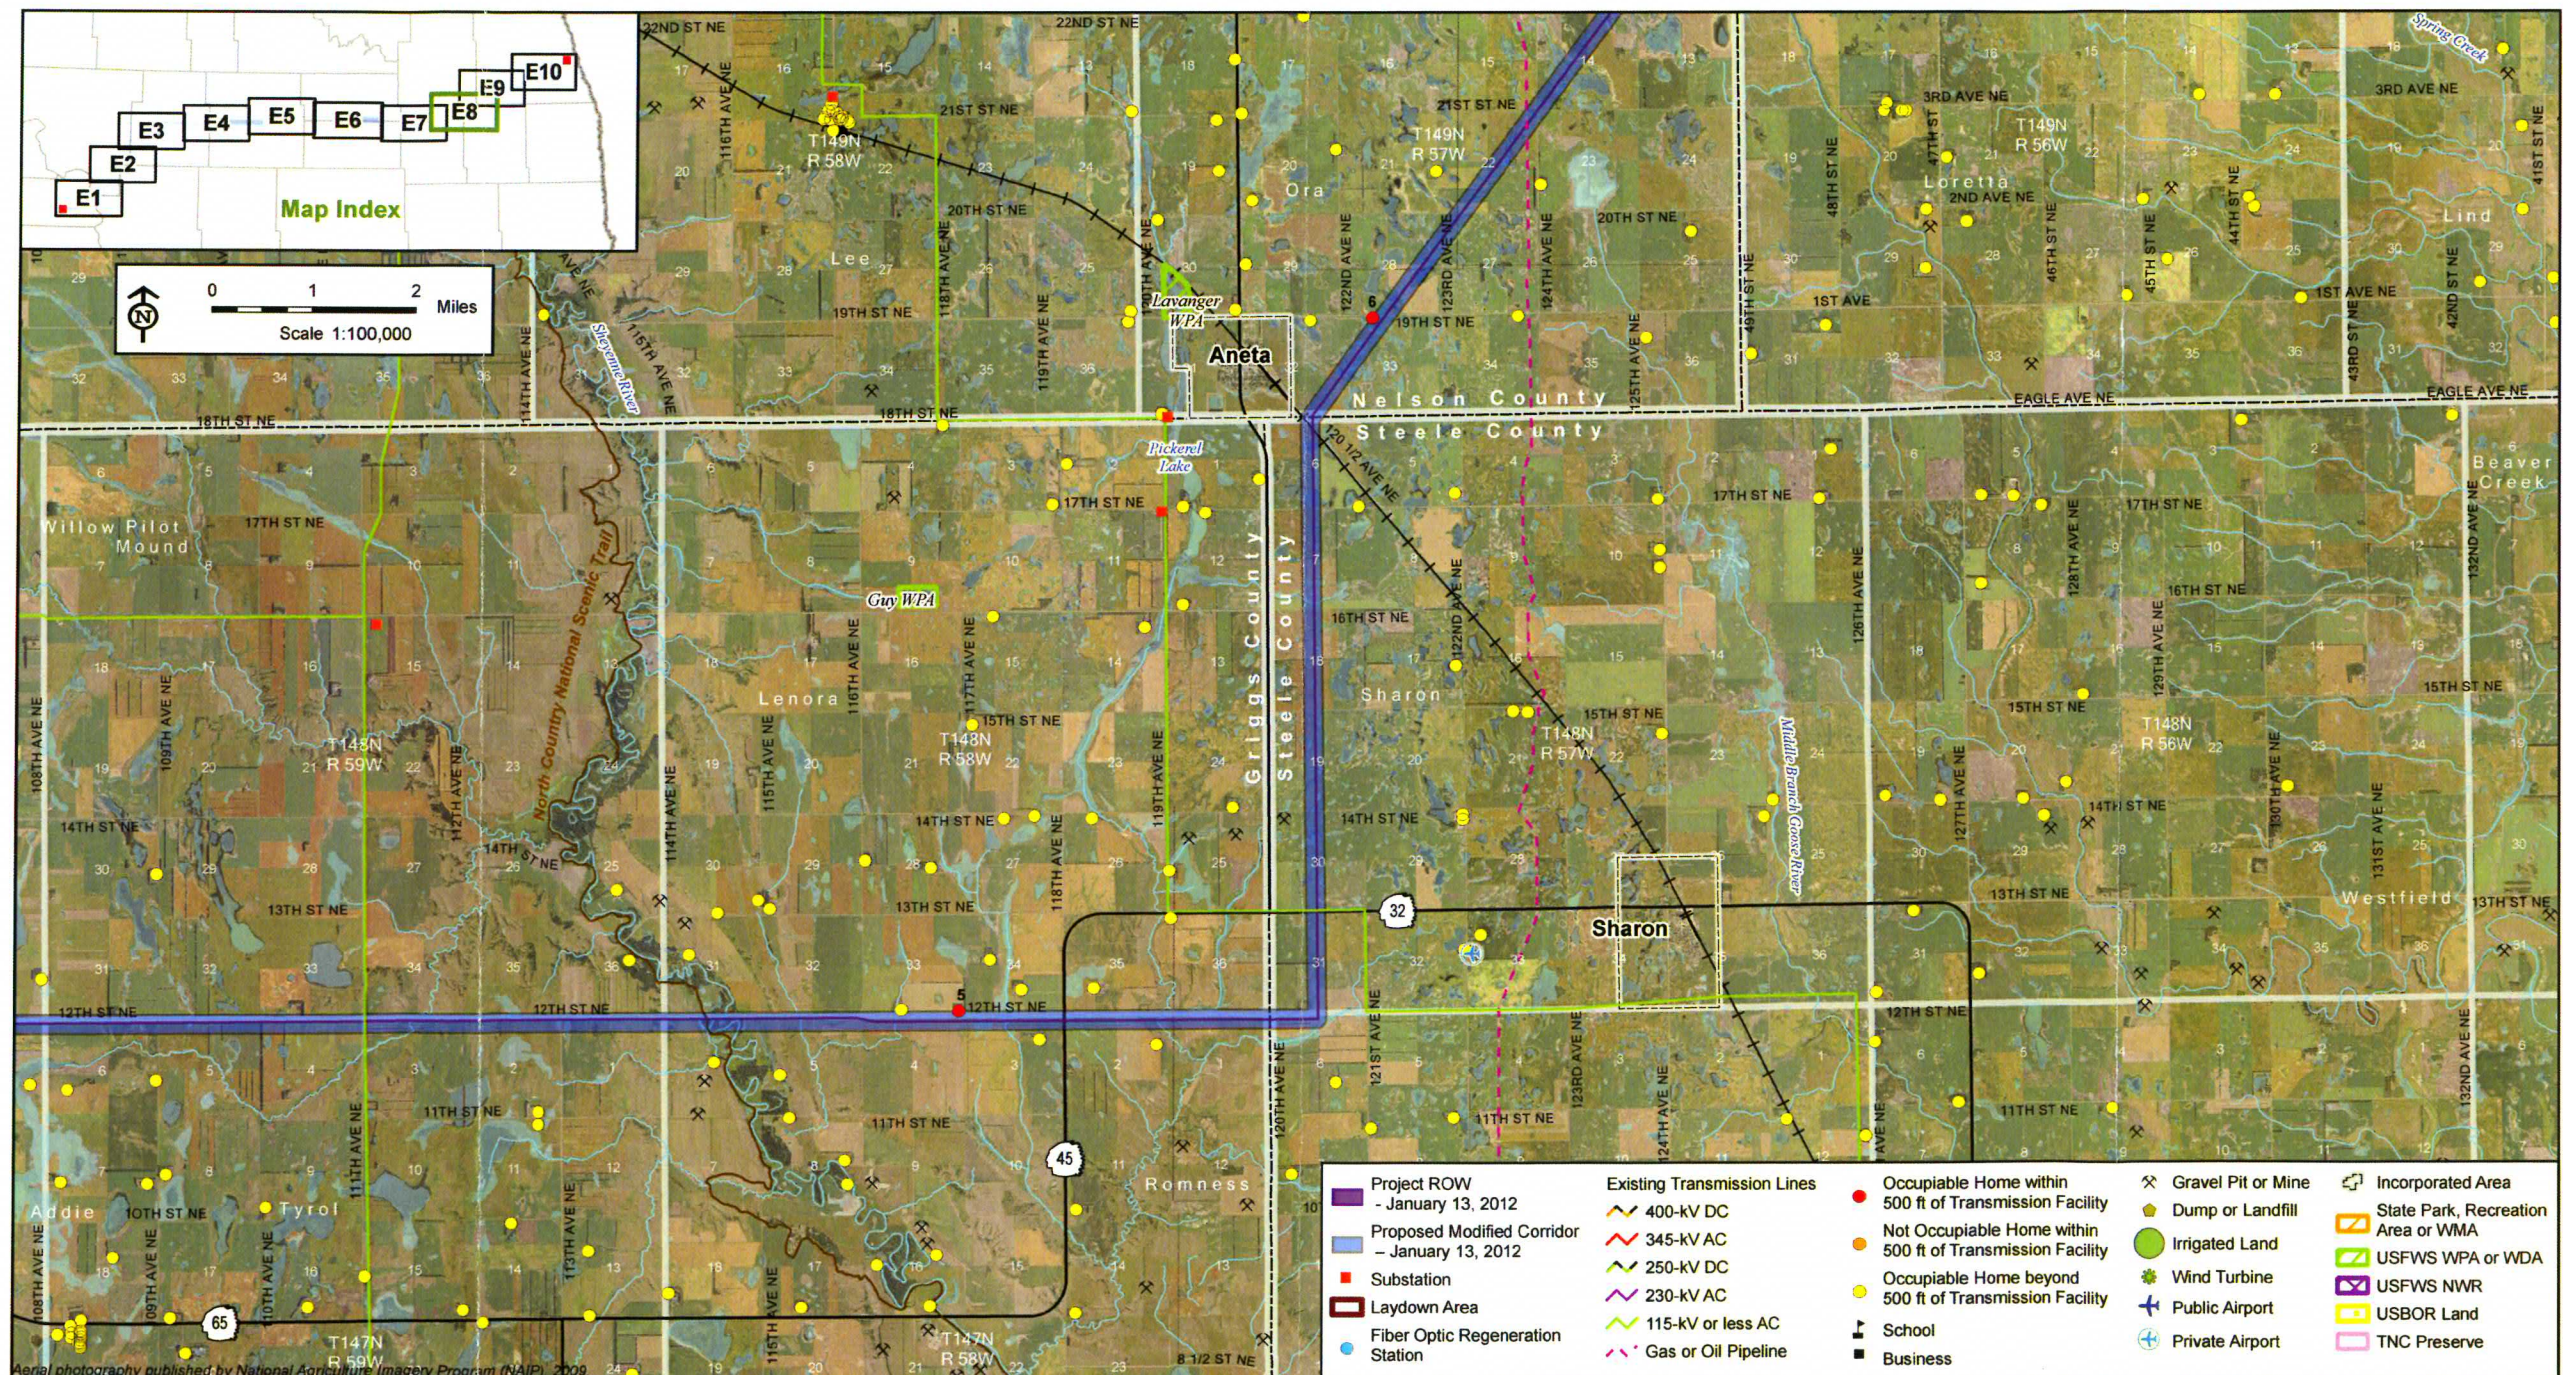

Center to Grand Forks Project

Exhibit E9


Route Maps with Modified Corridor

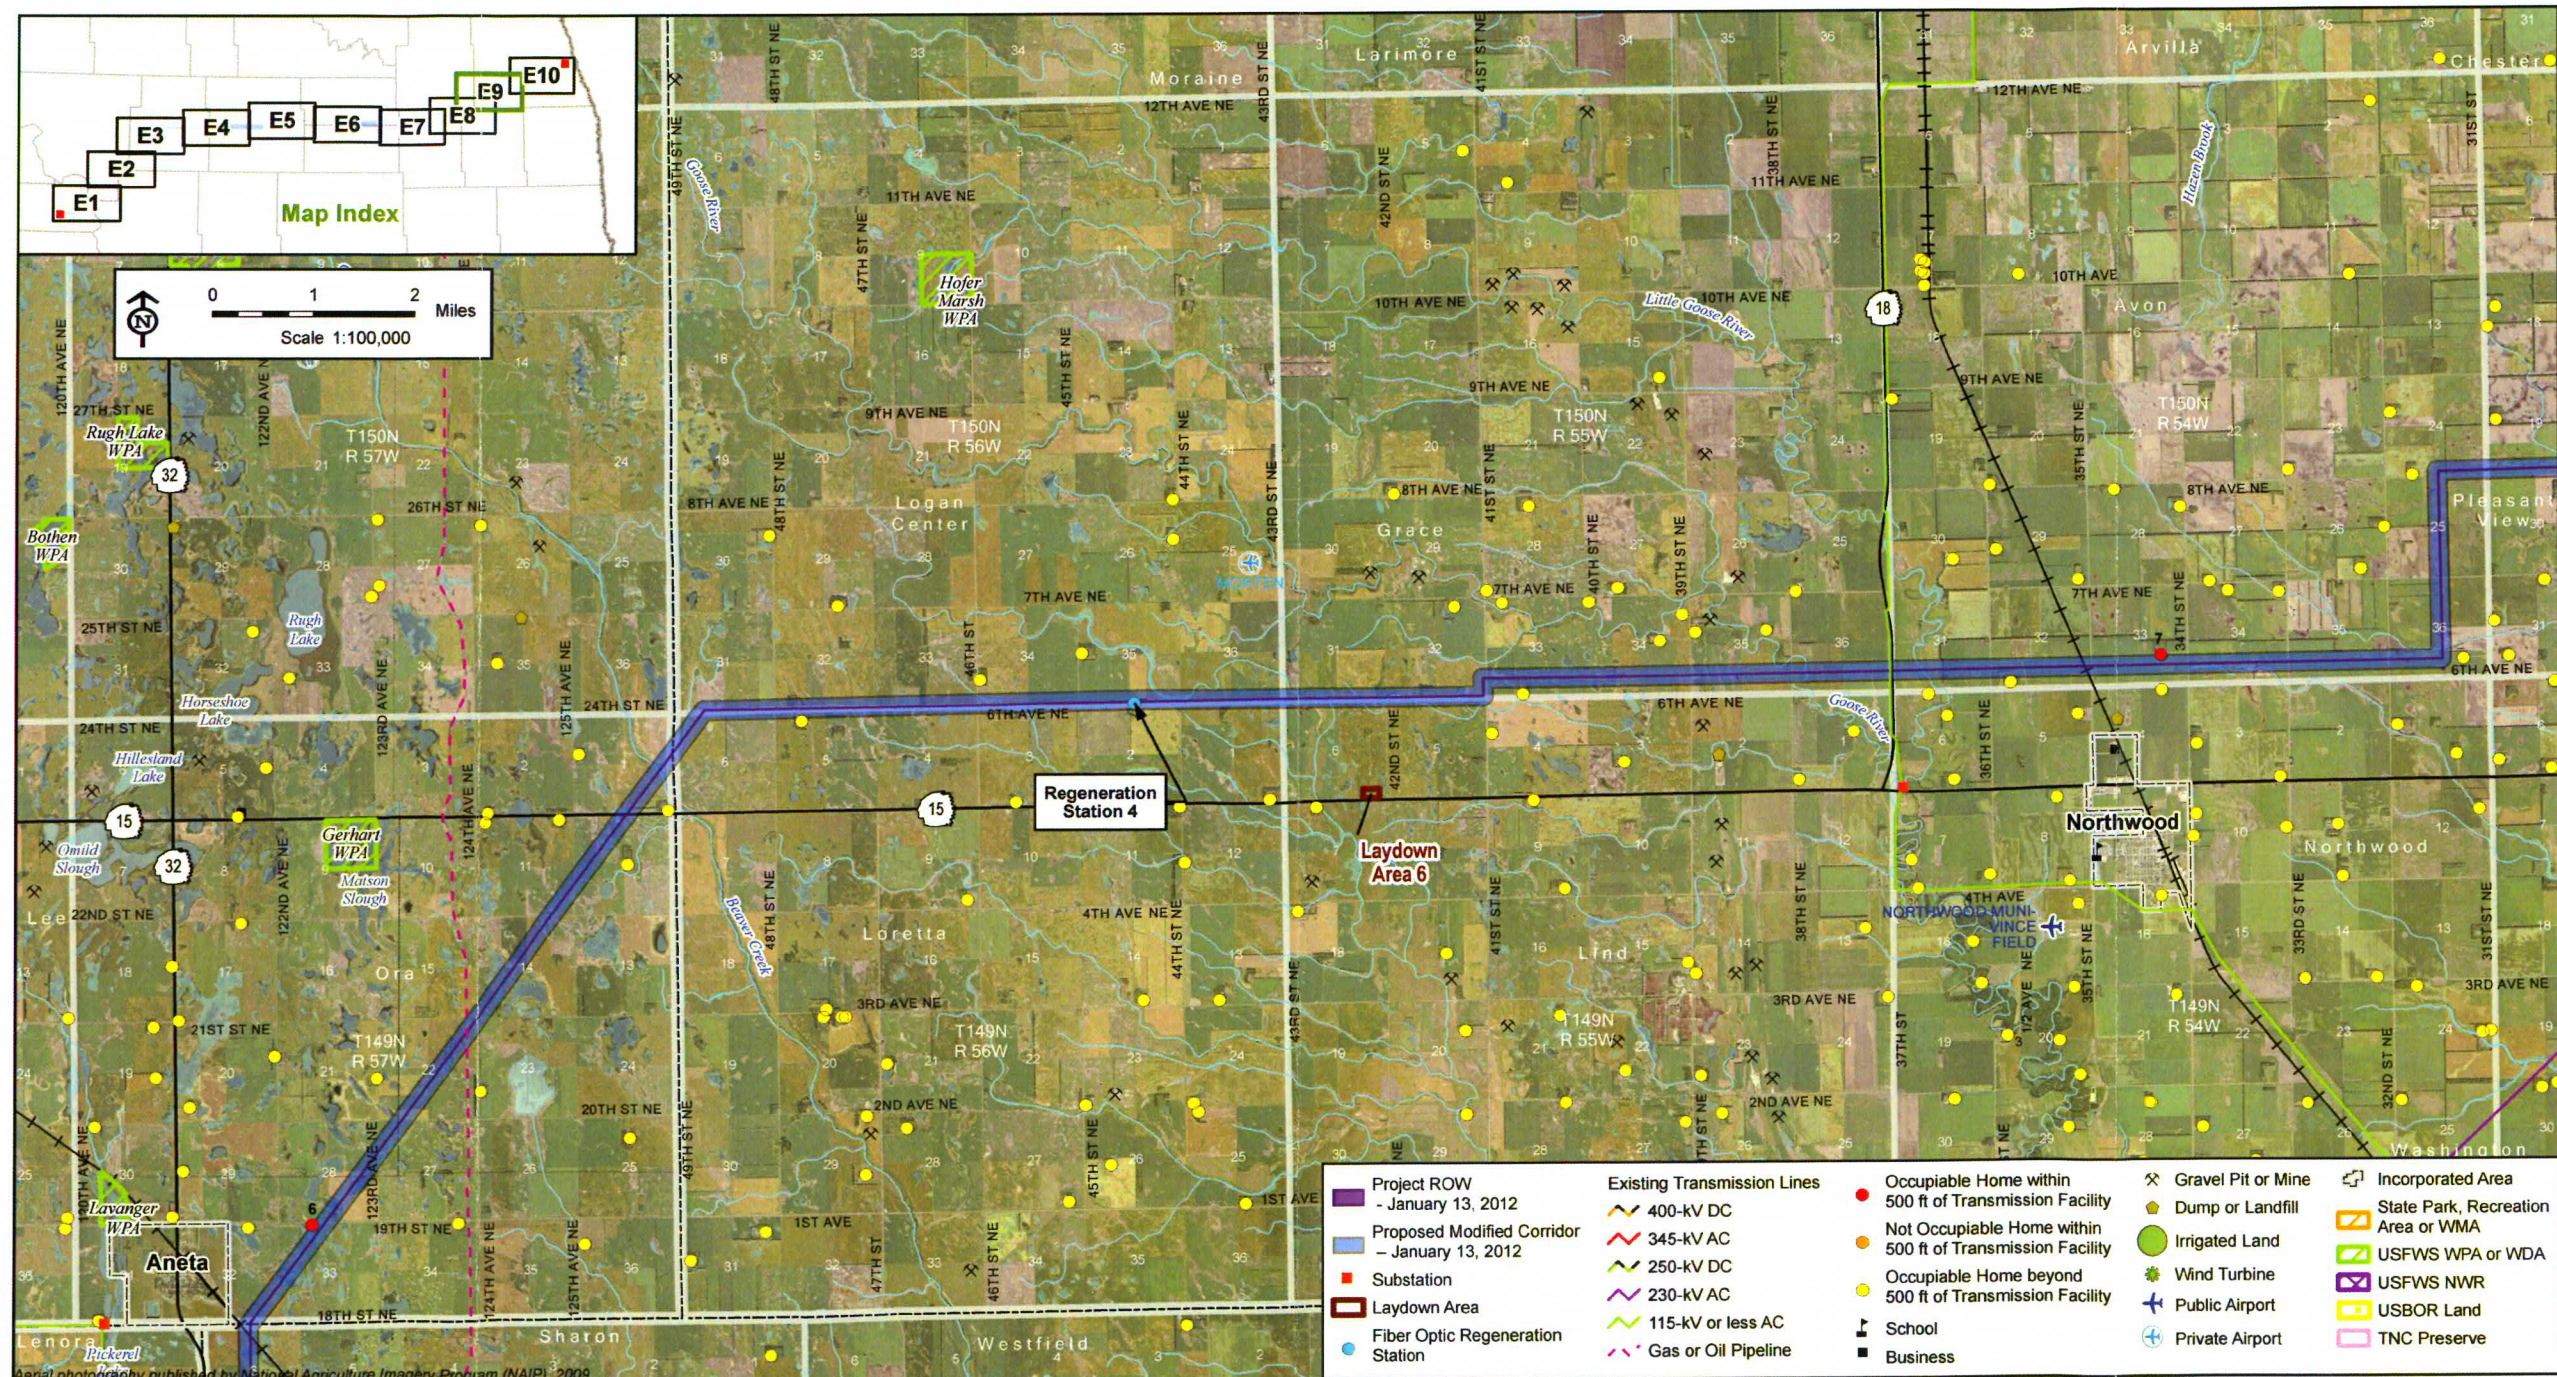

Center to Grand Forks Project

Exhibit E10

Route Maps with Modified Corridor

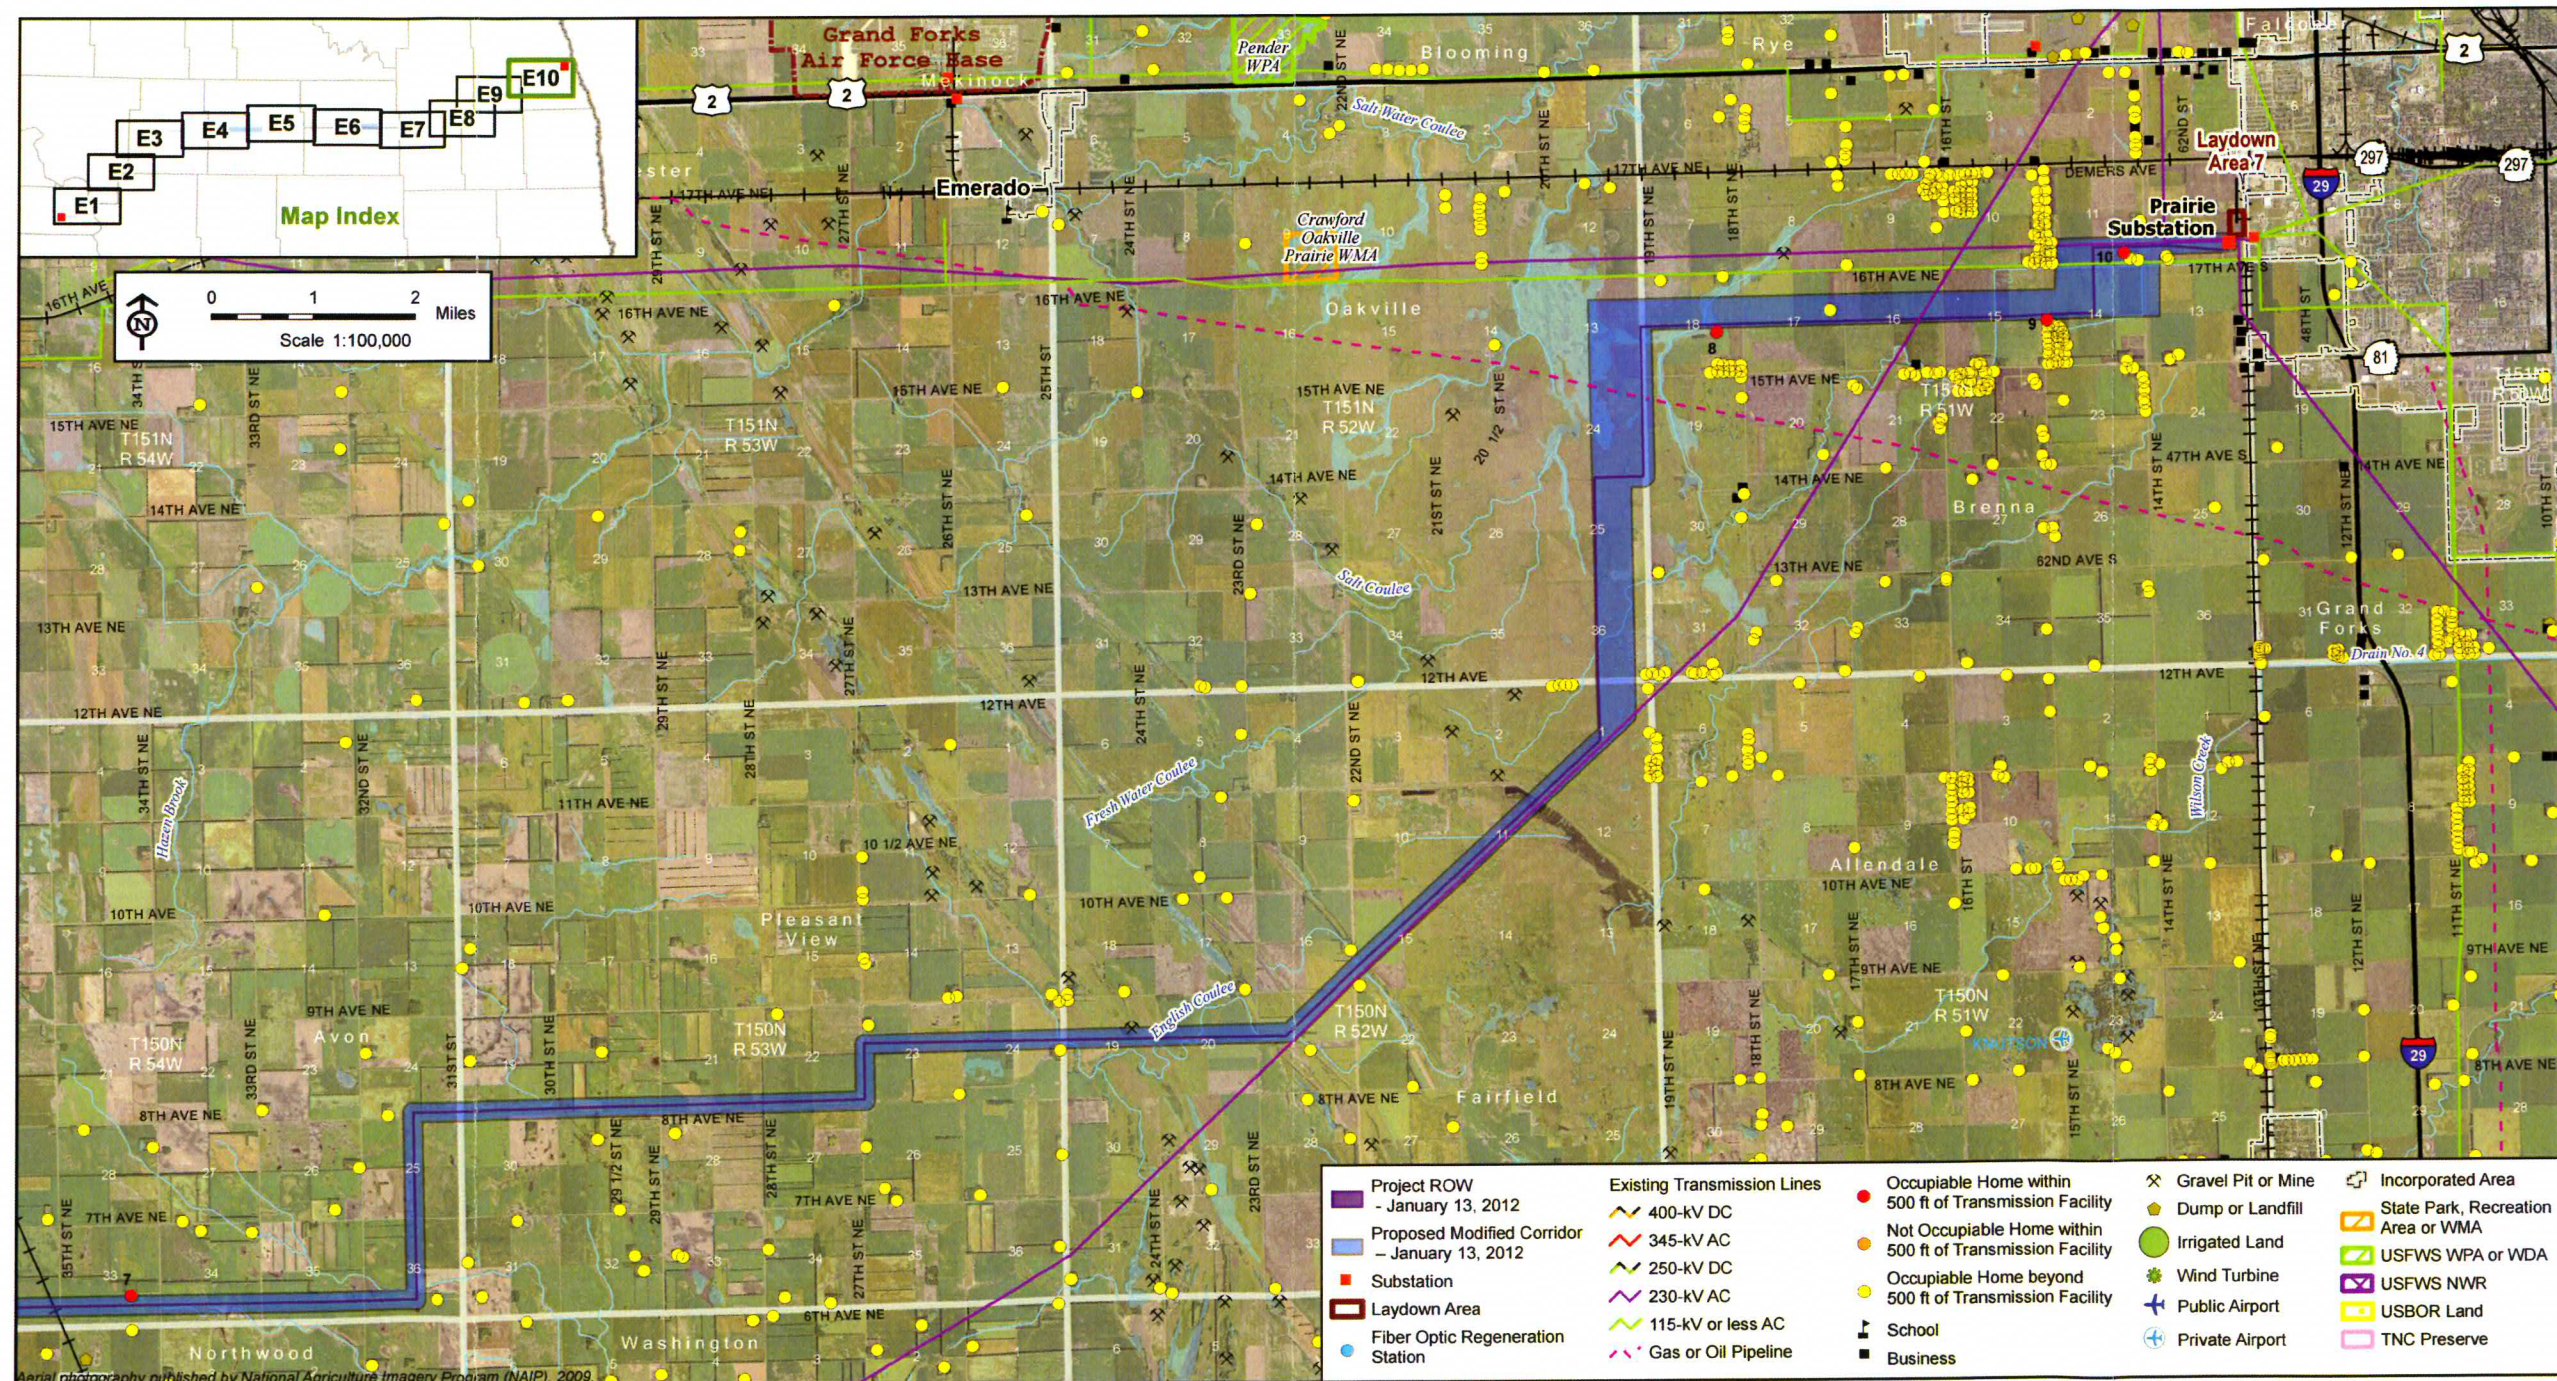


Center to Grand Forks Project

Minnkota Power
MPC COOPERATIVE, INC.

Exhibit 01

Parcels Remaining for Archaeological Survey

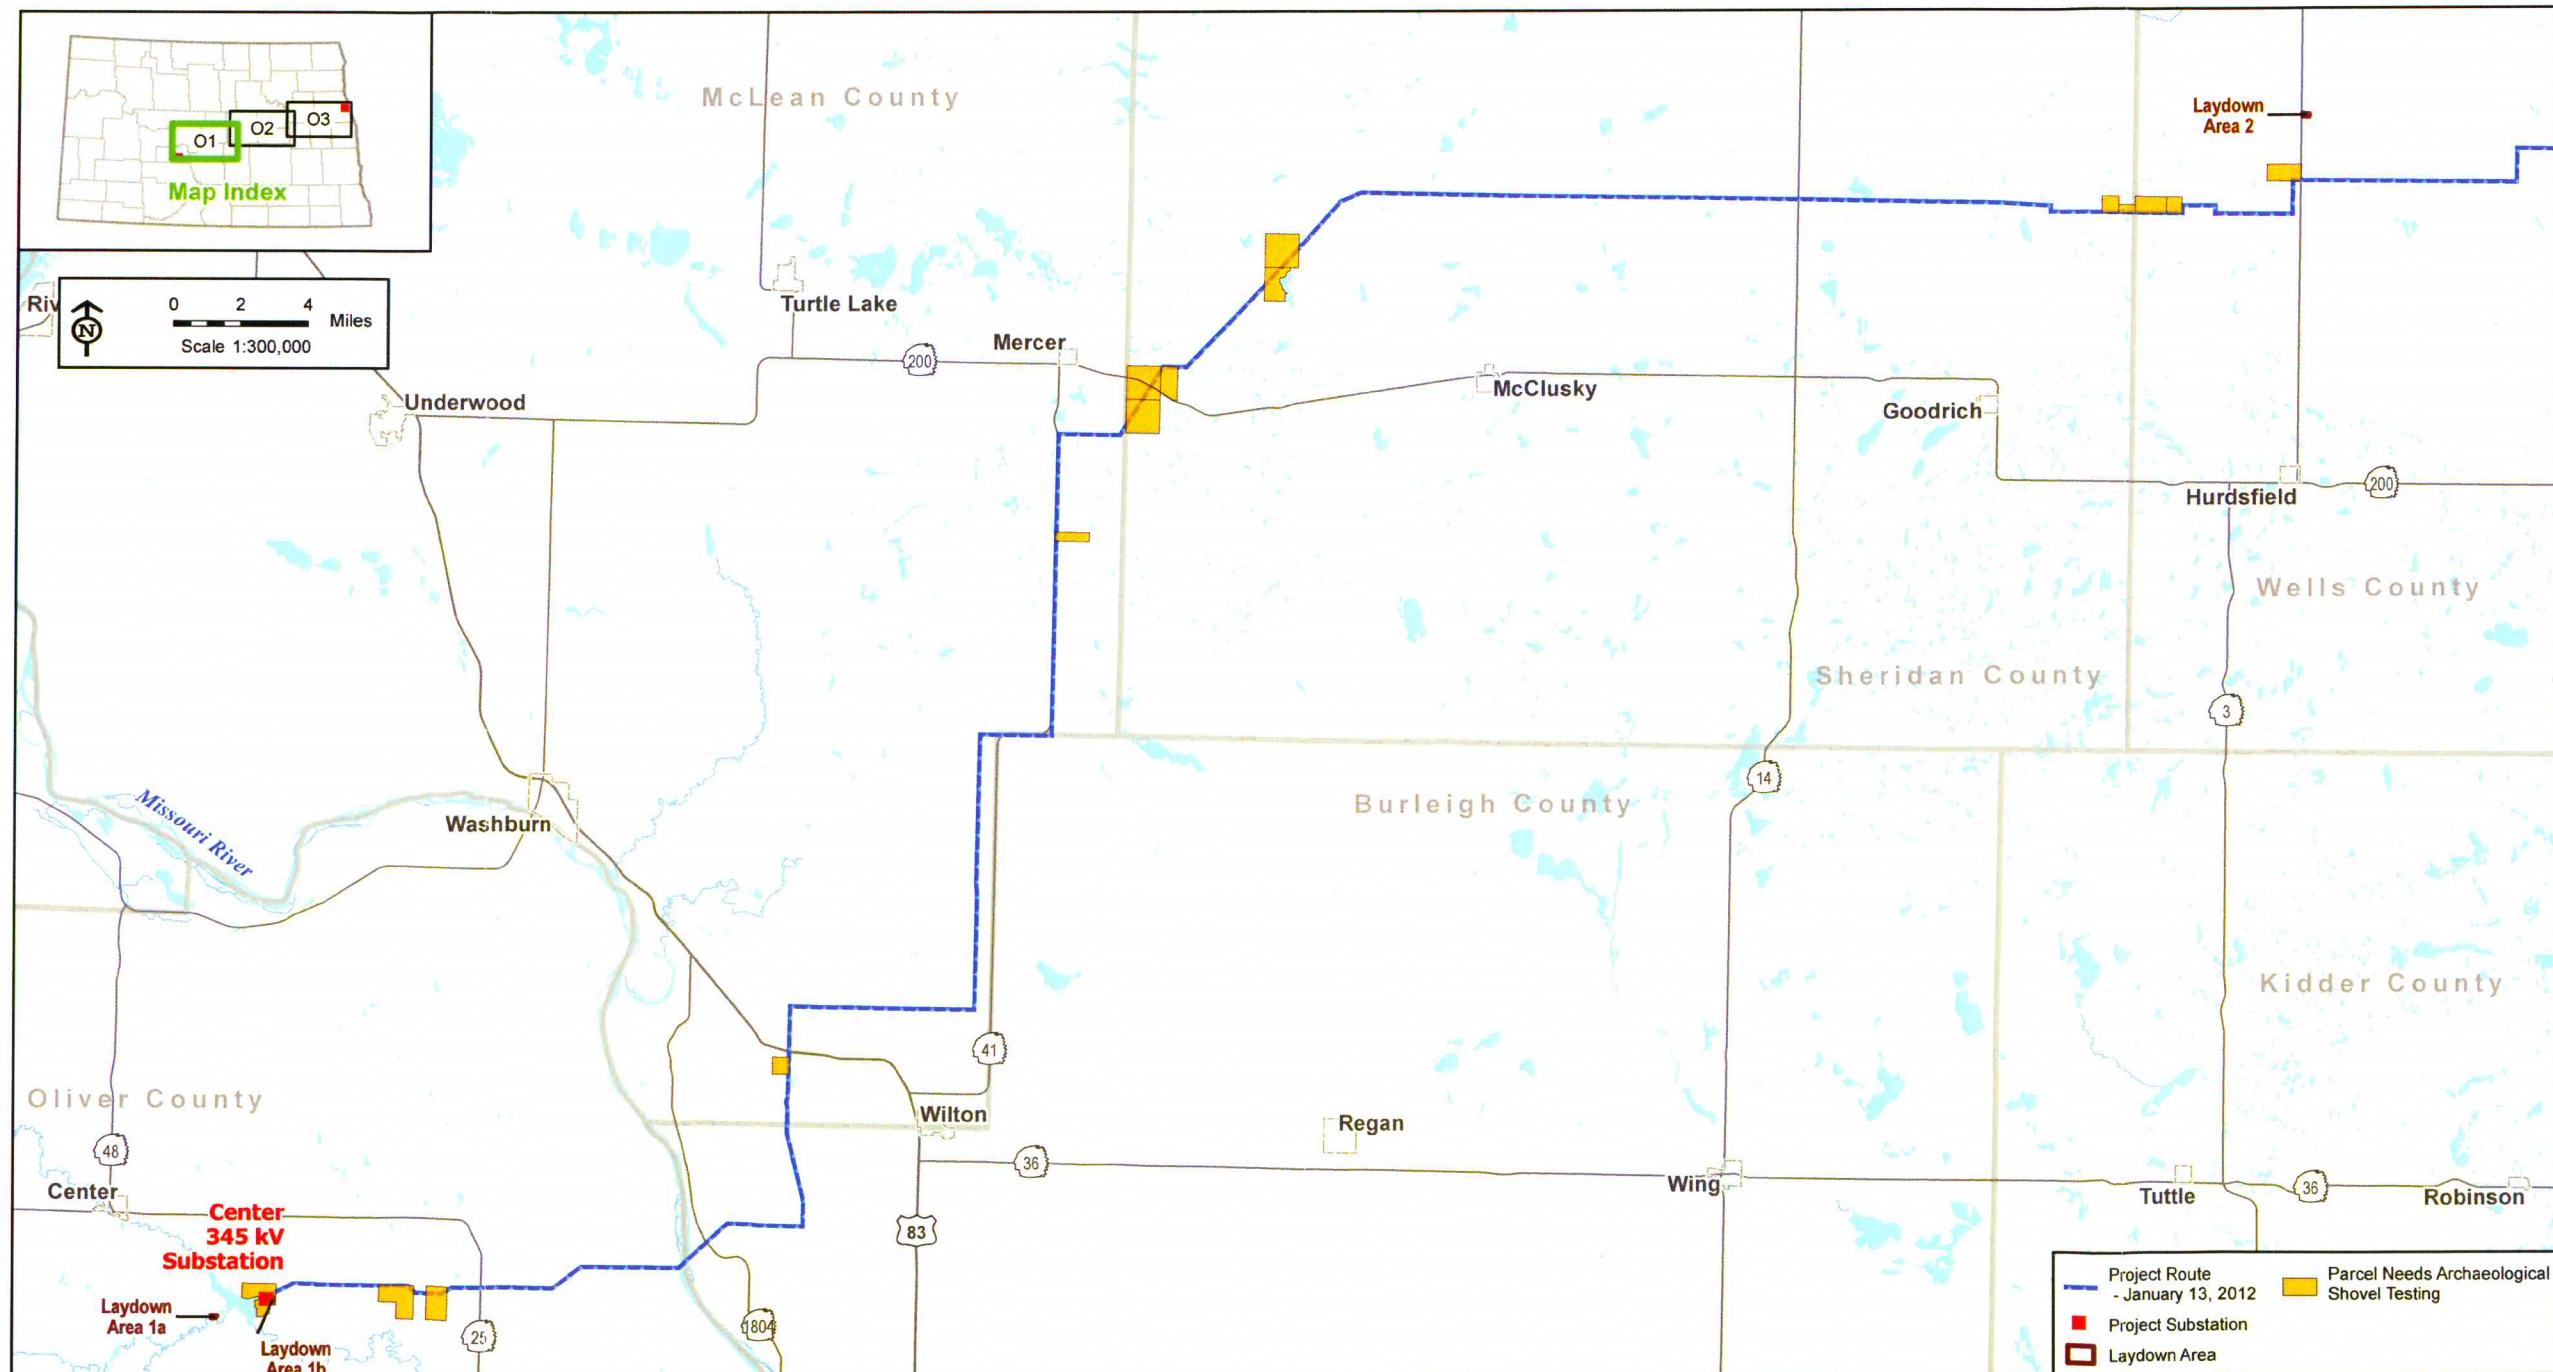

Center to Grand Forks Project