

Exhibit G1: Oliver County Proposed Project Corridor Modifications



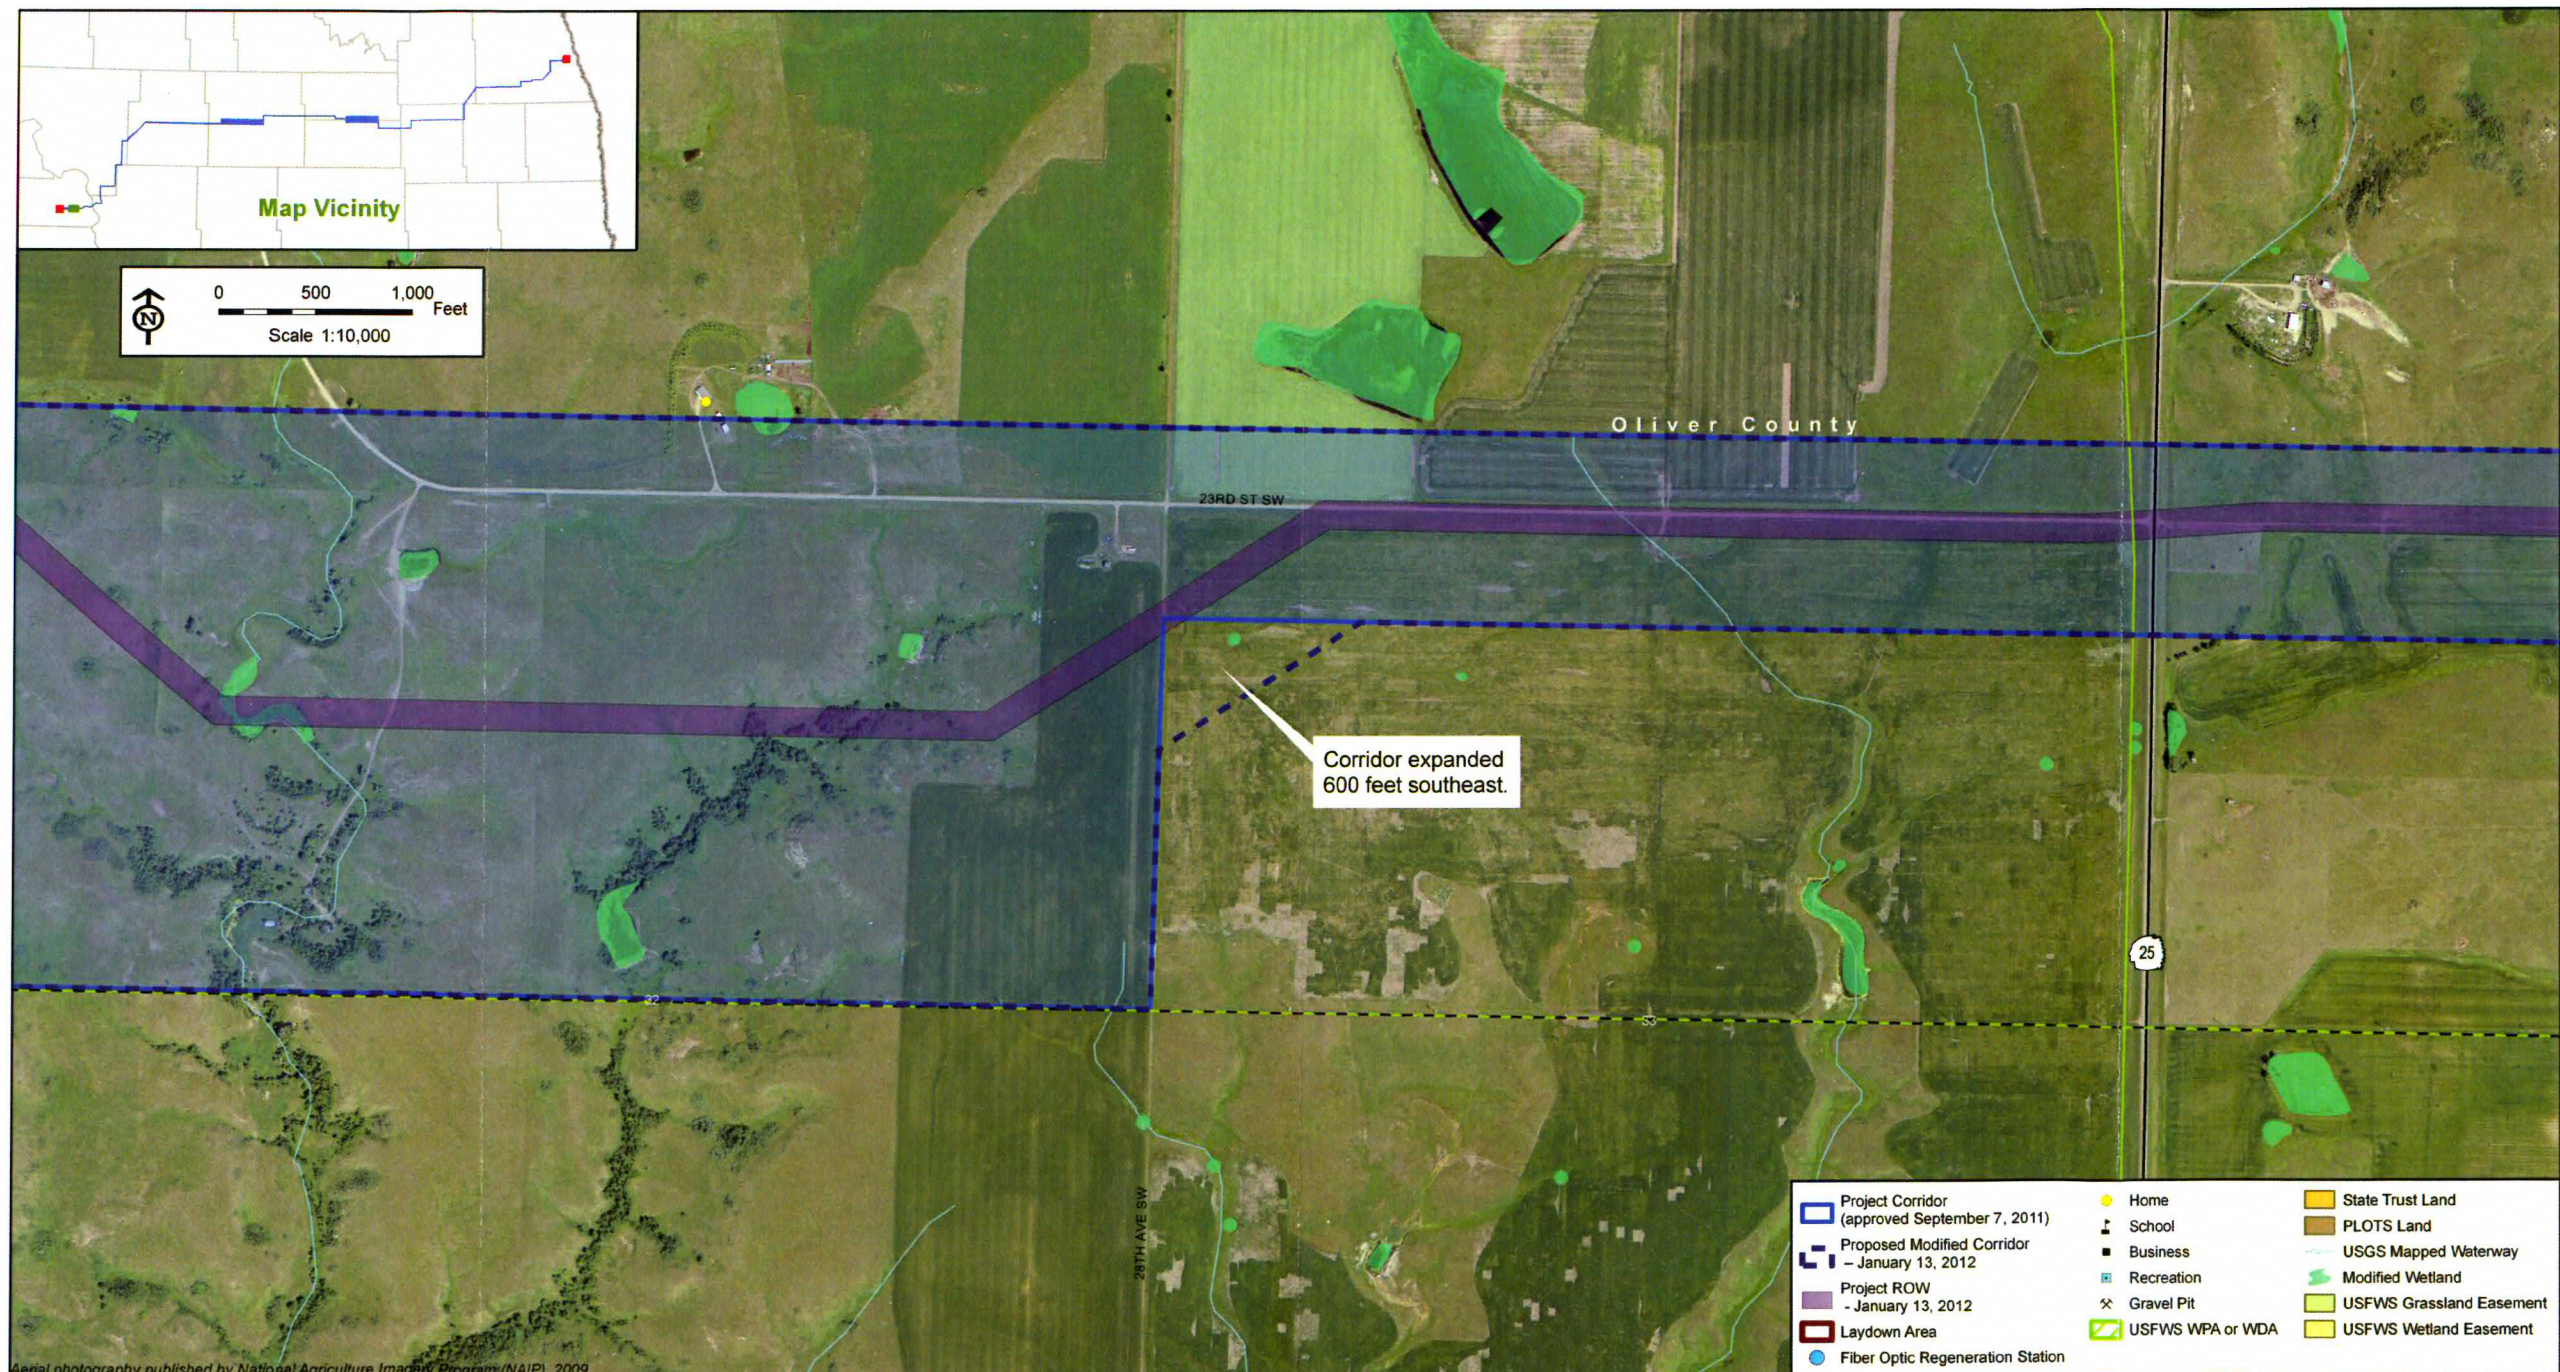


Exhibit G2: Sheridan County - NDDTL Proposed Project Corridor Modifications

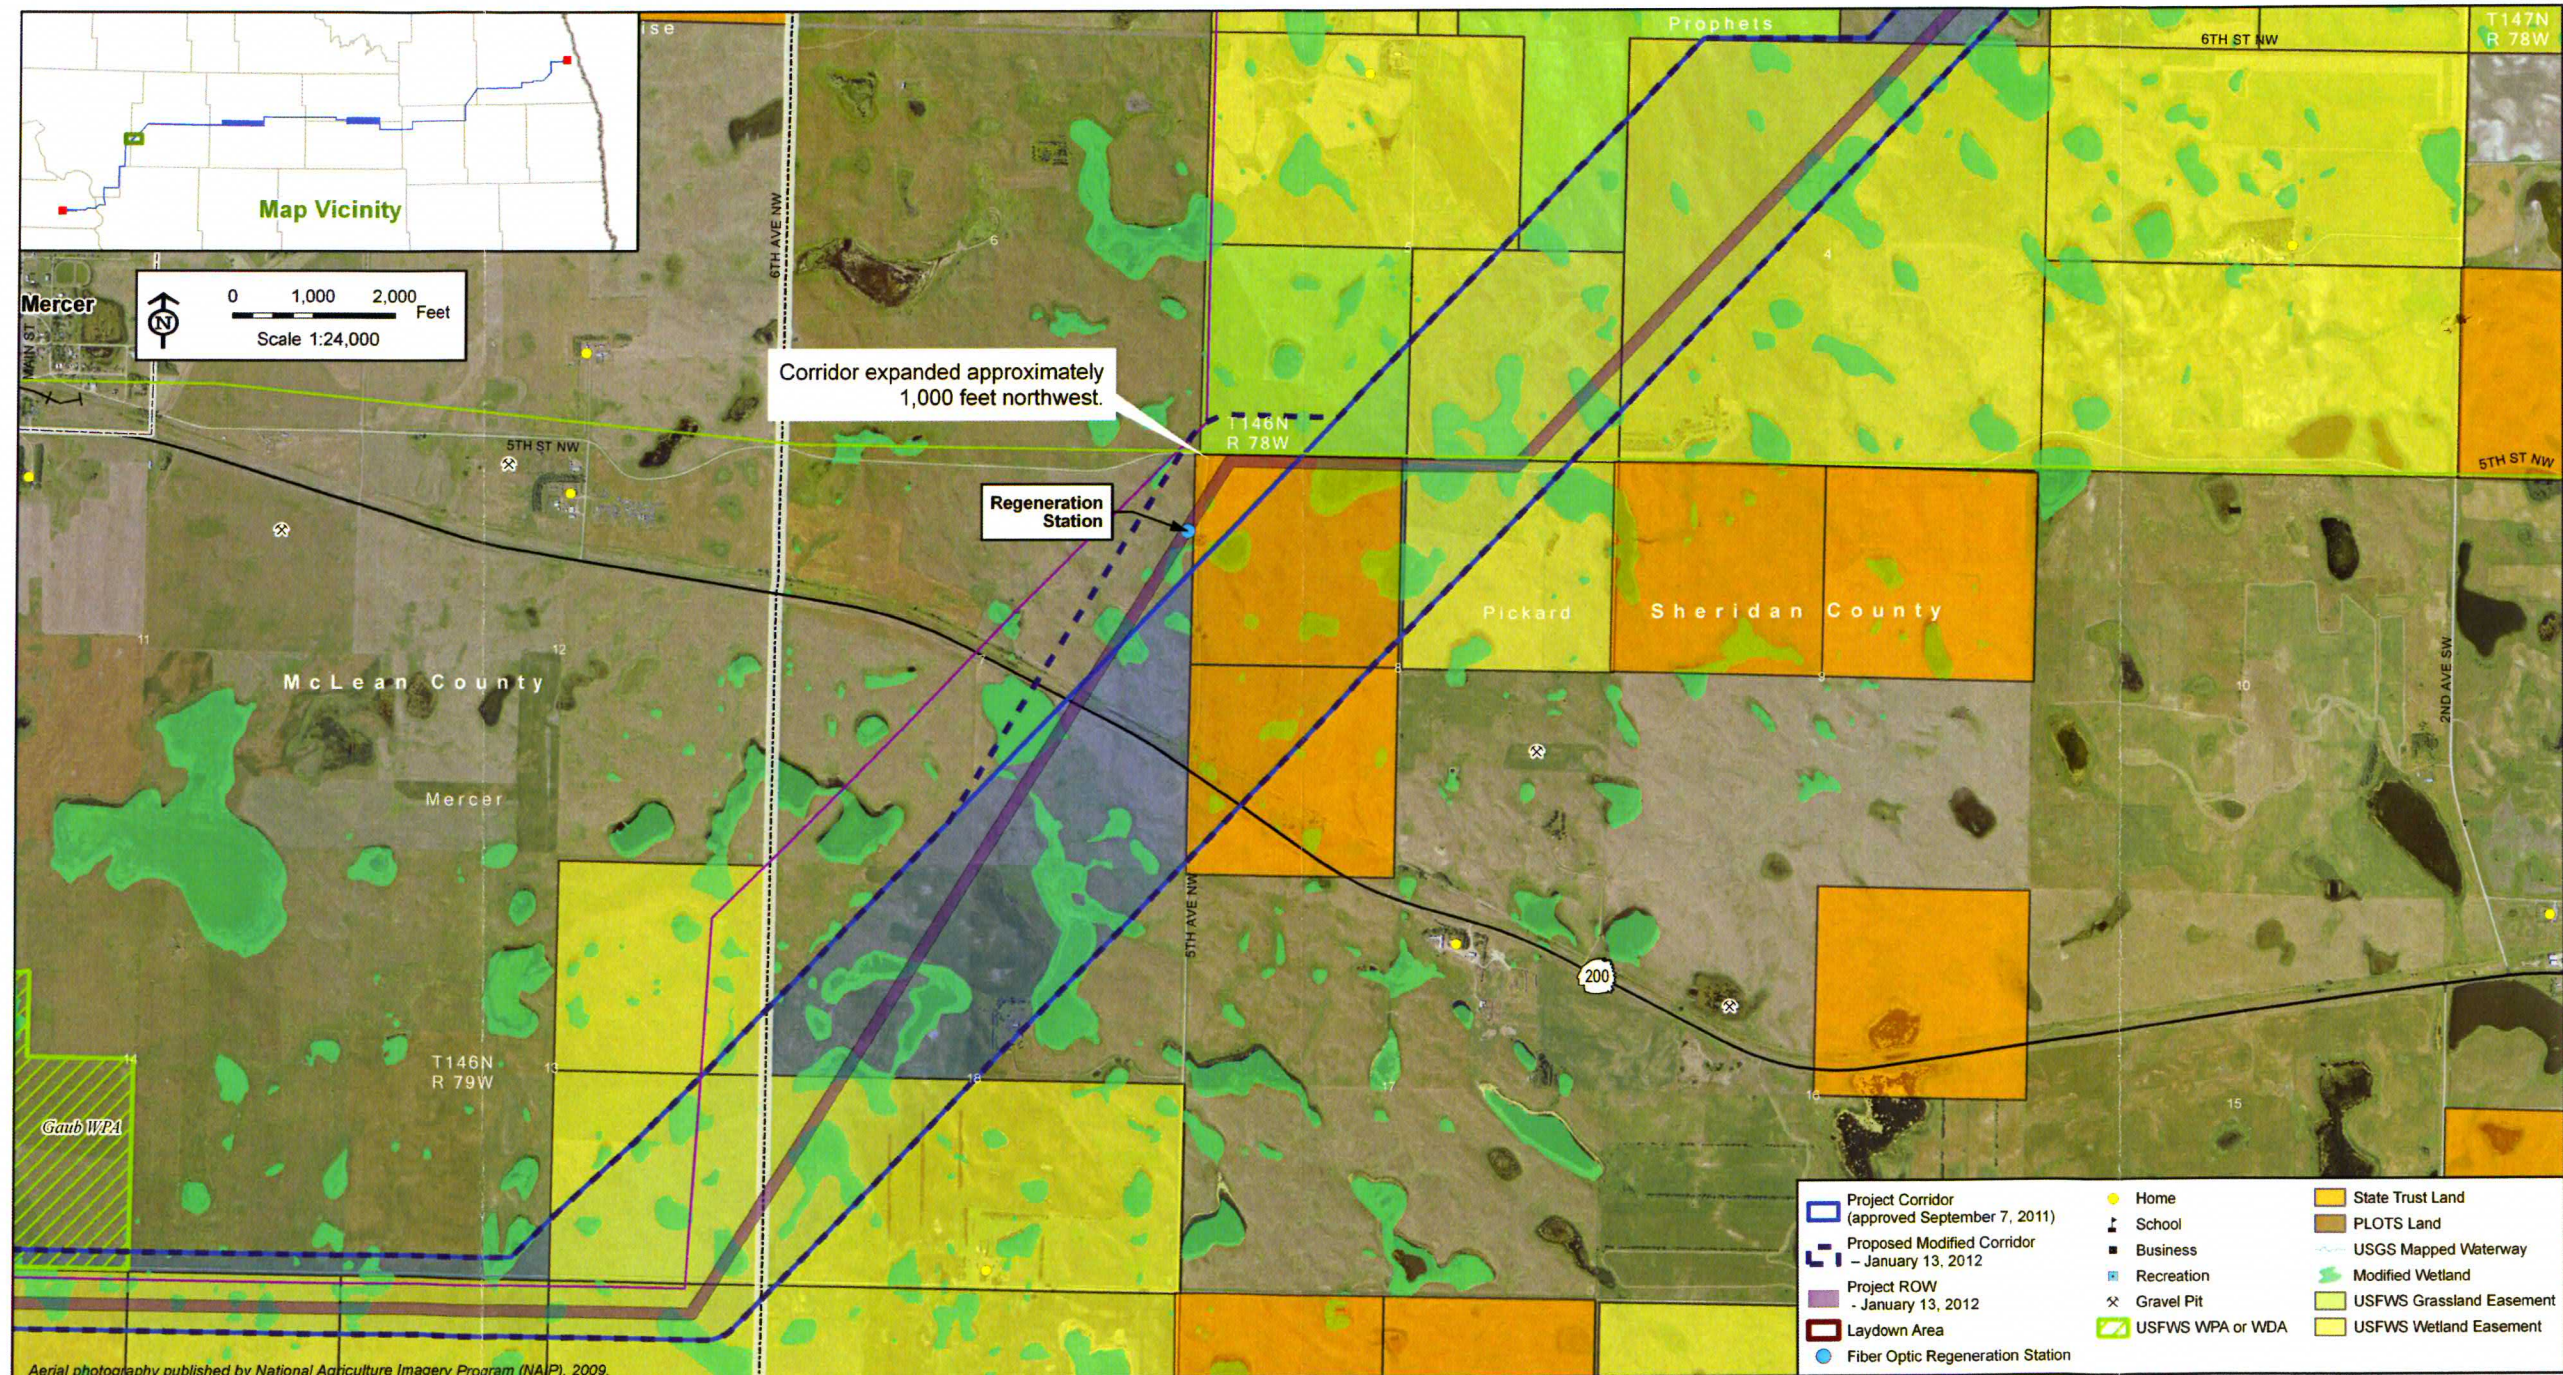


Center to Grand Forks Project

Exhibit G3: Eddy County Proposed Project Corridor Modifications

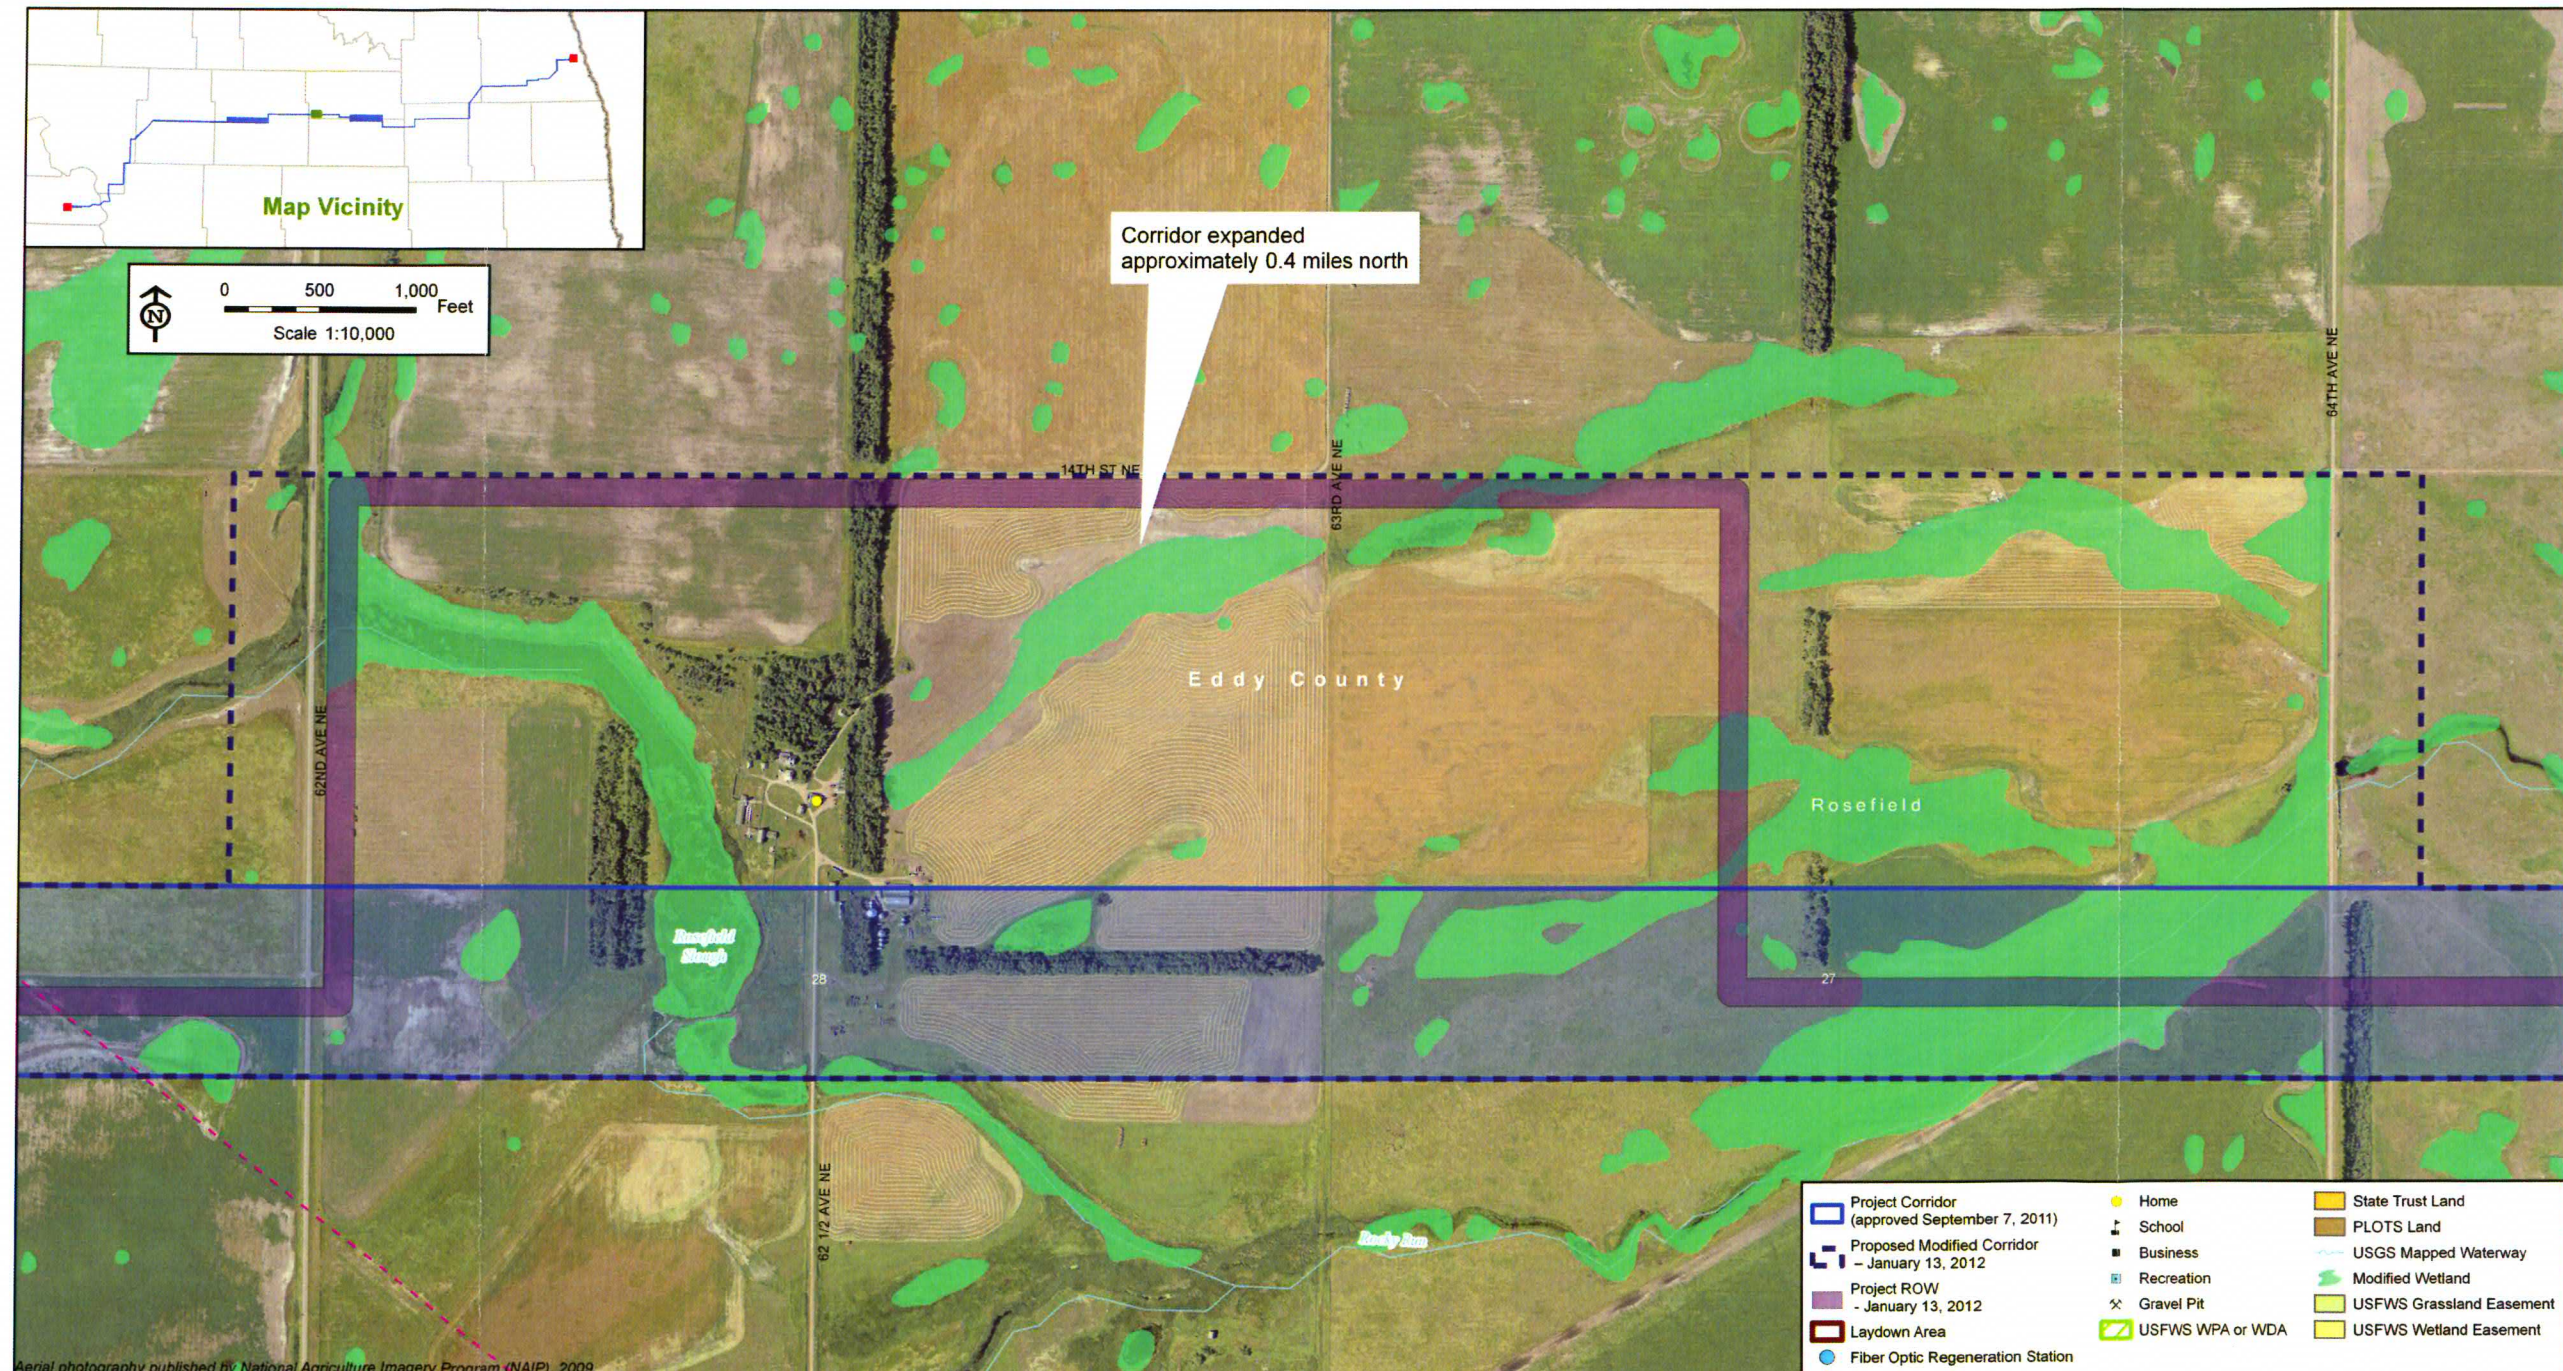


Center to Grand Forks Project

Exhibit G4: Grand Forks County - NDDTL Proposed Project Corridor Modifications

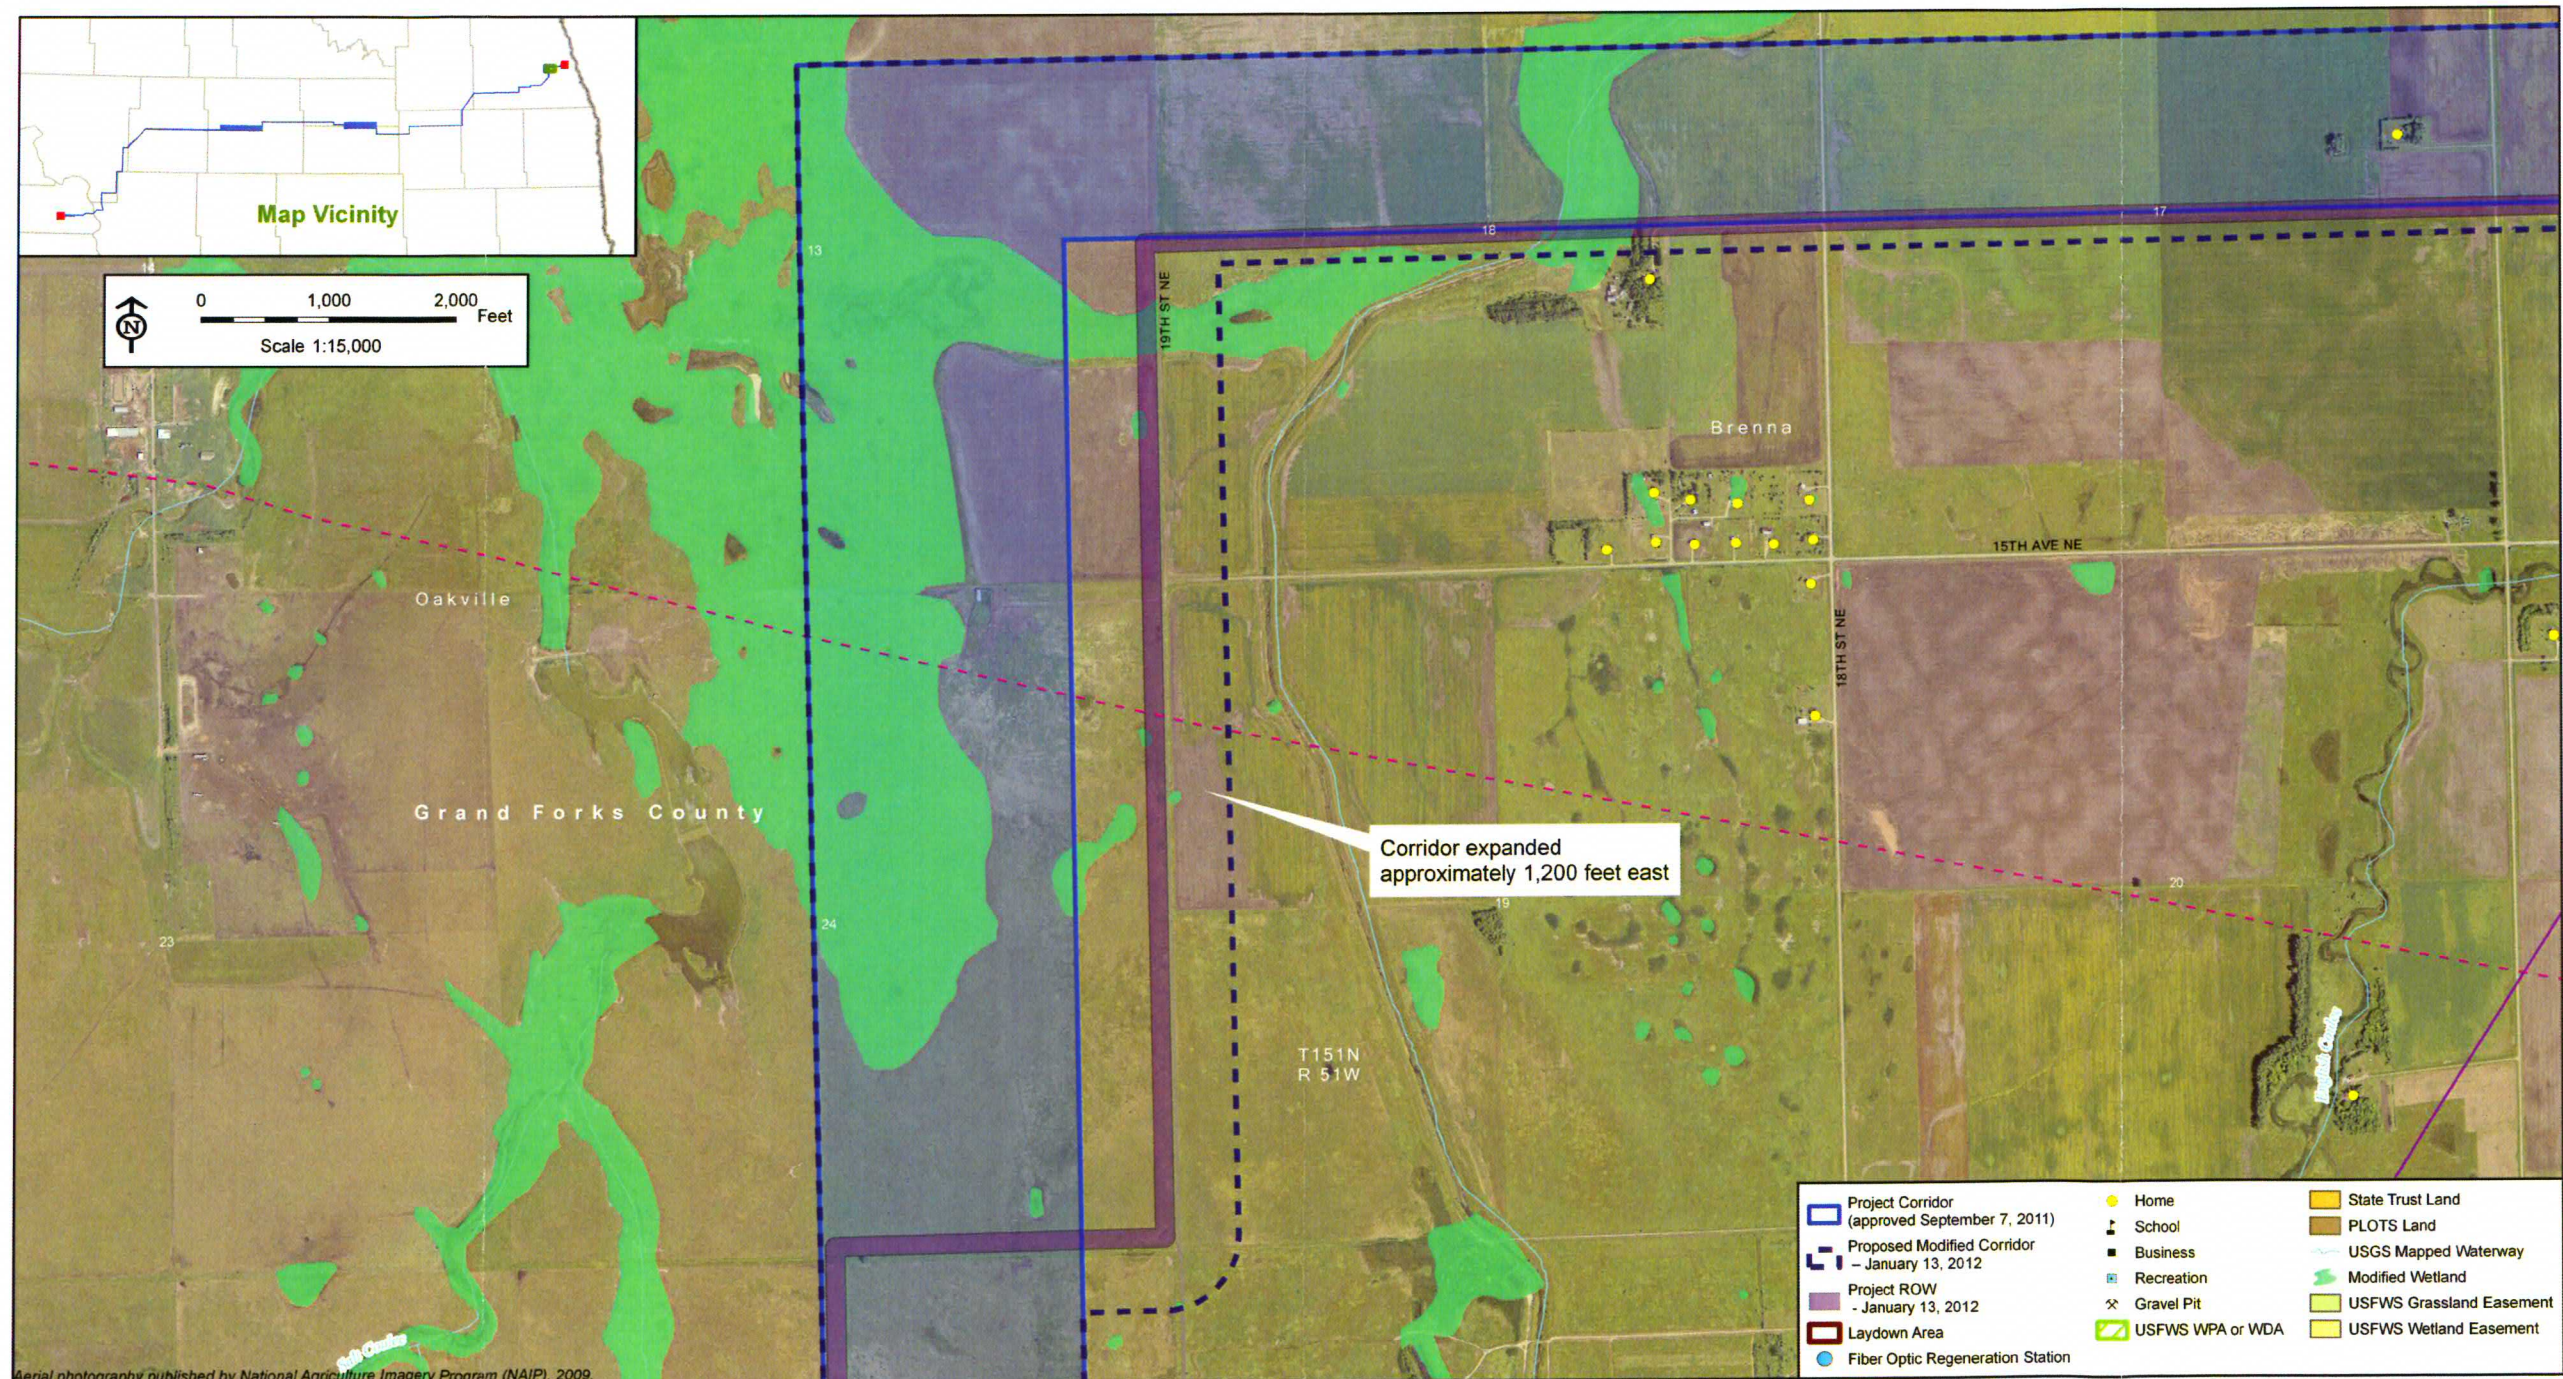

Center to Grand Forks Project

Exhibit G5: Grand Forks County - Brenna Township Proposed Project Corridor Modifications

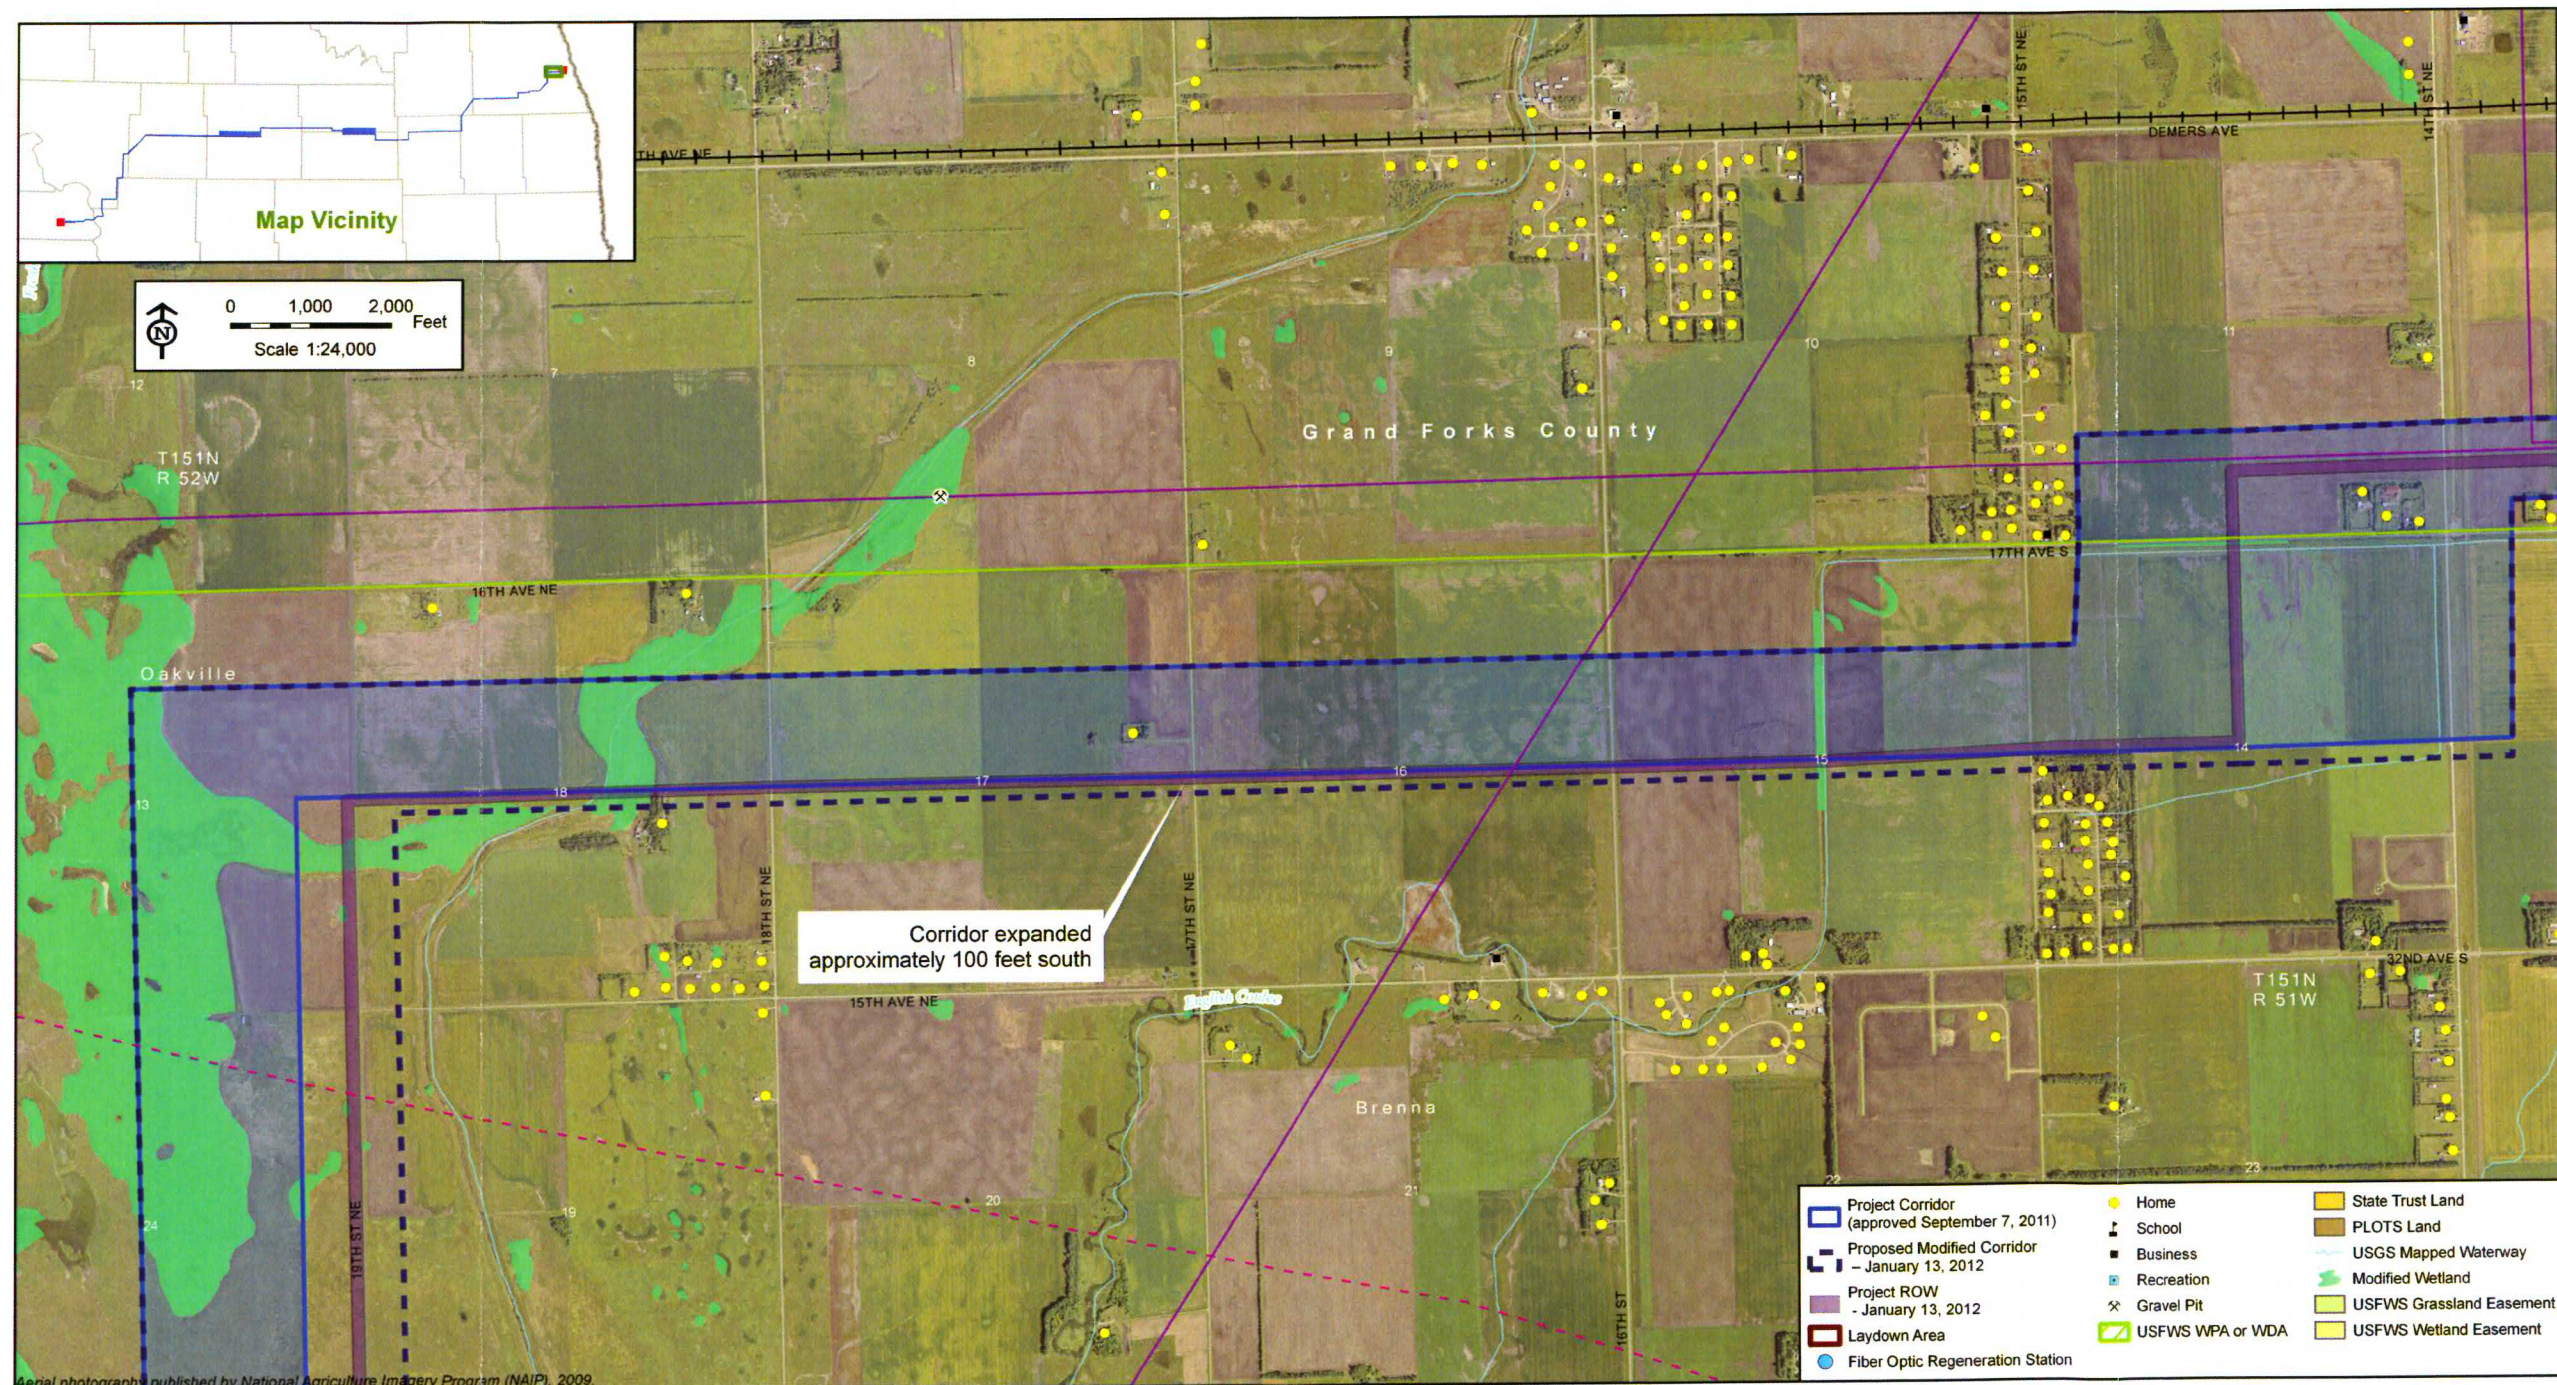

Center to Grand Forks Project