

Hamre, John G.

From: Lein, Jerry R.
Sent: Wednesday, October 31, 2012 10:03 AM
To: Mike Hennes (mhennes@minnkota.com); Smith, Mollie (msmith@fredlaw.com)
Cc: -Info-Public Service Commission; -Grp-PSC Commissioners; -Grp-PSC Public Utilities; -Grp-PSC Legal
Subject: Corridor and Route Change Approval, Case No. PU-09-670
Attachments: CGF_11x17L_Waiver_1_McLeanCo_detail_20121011-c-c.pdf.pdf


Please consider this e-mail as approval of the October 4, 2012 request for corridor expansion and route change shown on the attached map in Case No. PU-09-670, Minnkota Power Cooperative, Inc. 345 kV Transmission Line – Center to Grand Forks Siting Application.

Please contact me if you have any questions. Thank you.

Jerry Lein
701 328-1035

This transmission, email and any files transmitted with it, may be: (1) subject to the Attorney-Client Privilege, (2) an attorney work product, or (3) strictly confidential under federal or state law. If you are not the intended recipient of this message, you may not use, disclose, print, copy or disseminate this information. If you have received this transmission in error, notify the sender (only) and delete the message. This message may also be subject to disclosure under the North Dakota Open Records Laws.

222 PU-09-670 Filed: 10/31/2012 Pages: 2
Email staff approval of request route and corridor amendment

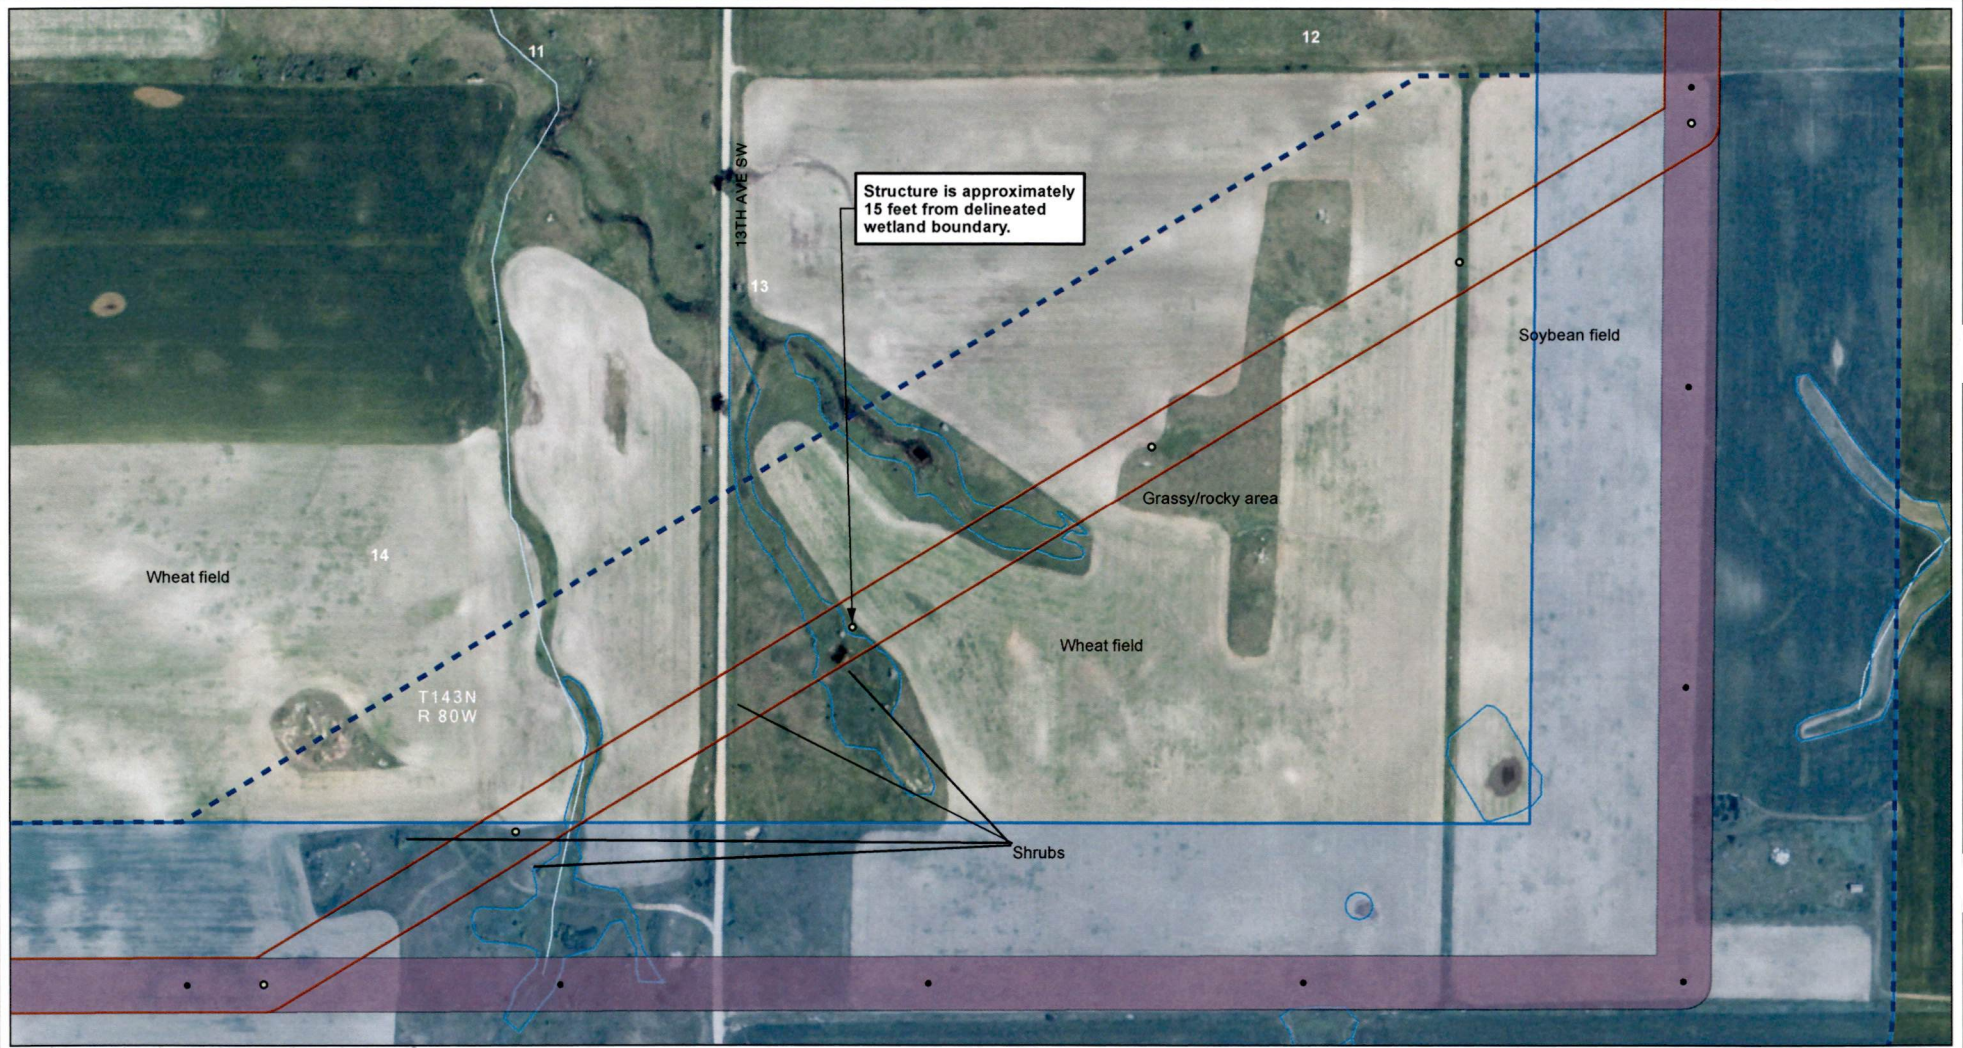

Sensitive location information has been redacted from this Figure.



- Approved Corridor
- Proposed Corridor
- Approved Project ROW
- Proposed Project ROW
- Approved Project Structure Location
- Proposed Project Structure Location
- USGS Mapped Waterway
- Modified Wetland
- USFWS Grassland Easement
- USFWS Wetland Easement

Exhibit 1 Detail
 Proposed Project Corridor and Route Modifications
 McLean County, North Dakota
 Center to Grand Forks Project
 Minnkota Power Cooperative, Inc.

0 200 400 Feet
 Scale 1:4,000

Aerial photography published by National Agriculture Imagery Program (NAIP), 2010.