

**Hamre, John G.**

---

**From:** Lein, Jerry R.  
**Sent:** Wednesday, February 05, 2014 1:53 PM  
**To:** Mike Hennes (mhennes@minnkota.com)  
**Cc:** Hamre, John G.; -Info-Public Service Commission  
**Subject:** Re: Case No. PU-09-670 Structure Relocation Request  
**Attachments:** SR-CGF-OL-003.pdf; Mail Filing 1.29.14.docx

Dear Mr. Hennes:

Please consider this email to be staff approval of the structure relocation requests as described below and in the attachments. Thanks.

Jerry Lein  
701 328-1035

---

**From:** Mike Hennes [<mailto:mhennes@minnkota.com>]  
**Sent:** Wednesday, January 29, 2014 8:54 PM  
**To:** -Info-Public Service Commission; Lein, Jerry R.  
**Cc:** 'Duane Phillips ([phillipsduane@stanleygroup.com](mailto:phillipsduane@stanleygroup.com))'  
**Subject:** Case No. PU-09-670 Structure Relocation Request

Case No. PU-09-670

Please accept the attached Structure Relocation requests for the CGF Project in:

Oliver County (SR-CGF-OL-003)

Please note that these filings are also being mailed by regular mail as well.

Michael Hennes  
Senior Manager Transmission Operations  
Minnkota Power Cooperative, Inc.

Mail Filing 1.29.14  
SR-CGF-OL-003

---

This email has been scanned for email related threats and delivered safely by Mimecast.  
For more information please visit <http://www.mimecast.com>

---

This transmission, email and any files transmitted with it, may be: (1) subject to the Attorney-Client Privilege, (2) an attorney work product, or (3) strictly confidential under federal or state law. If you are not the intended recipient of this message, you may not use, disclose, print, copy or disseminate this information. If you have received this transmission in error, notify the sender (only) and delete the message. This is in accordance with Minnesota's  
Records Laws.

**308 PU-09-670** Filed: 2/5/2014 Pages: 4  
**E-mail staff approval of structure relocation changes  
- Oliver County**

January 29, 2014

**VIA POSTAL SERVICE**

Mr. Darrell Nitschke  
Executive Secretary  
North Dakota Public Service Commission  
600 E. Boulevard, Dept. 408  
Bismarck, ND 58505-0480

**RE: Minnkota power Cooperative, Inc.  
345 kV Transmission Line – Center  
to Grand Forks Project  
Case No. PU-09-670**

Dear Mr. Nitschke:

Please accept the attached Structure Relocation requests for the CGF Project in:

Oliver County (SR-CGF-OL-003)

Sincerely,

Mike Hennes  
Senior Manager Transmission Operations  
Minnkota Power Cooperative  
(701) 795-4352

Encl. Structure Relocation Requests including:

cc: Mr. Jerry Lein (*w/ encl. – via e-mail*)

# Center to Grand Forks Project



▶ CGF Project – Structure Relocation Approval Request

Case No. PU-09-670

SR-CGF-OL-003

Michael Hennes ▶ Minnkota Power Cooperative, Inc. ▶ 1/29/2014

<u>Relocation Request:</u>	<p>Minnkota requests approval of a shift in the location of Structure 3 in Oliver County (<i>see</i> attached map showing original and new structure locations).</p> <p>Minnkota requests approval of relocations as soon as possible in order enable it to proceed with installation of foundations for structures.</p>
<u>Location:</u>	<p>NW/4 of Sections 34, Township 142 North, Range 83 West, Oliver County, North Dakota.</p> <p>Relocated structures will remain within the approved Route, and on the same landowners' property.</p>
<u>Reason for Relocation:</u>	<p>Structure relocated to avoid underground utilities.</p>
<u>Environmental Review/Compliance with Siting Criteria:</u>	<p>New structure locations were included in prior surveys for cultural resources and wetlands, and no cultural resources or wetlands will be impacted by structure relocations (<i>see</i> reports submitted as public hearing Exhibits K and M).</p> <p>No exclusion or avoidance areas will be impacted by structure relocations.</p>


SCALE:

1" = 200'



SR-CGF-OL-003

N

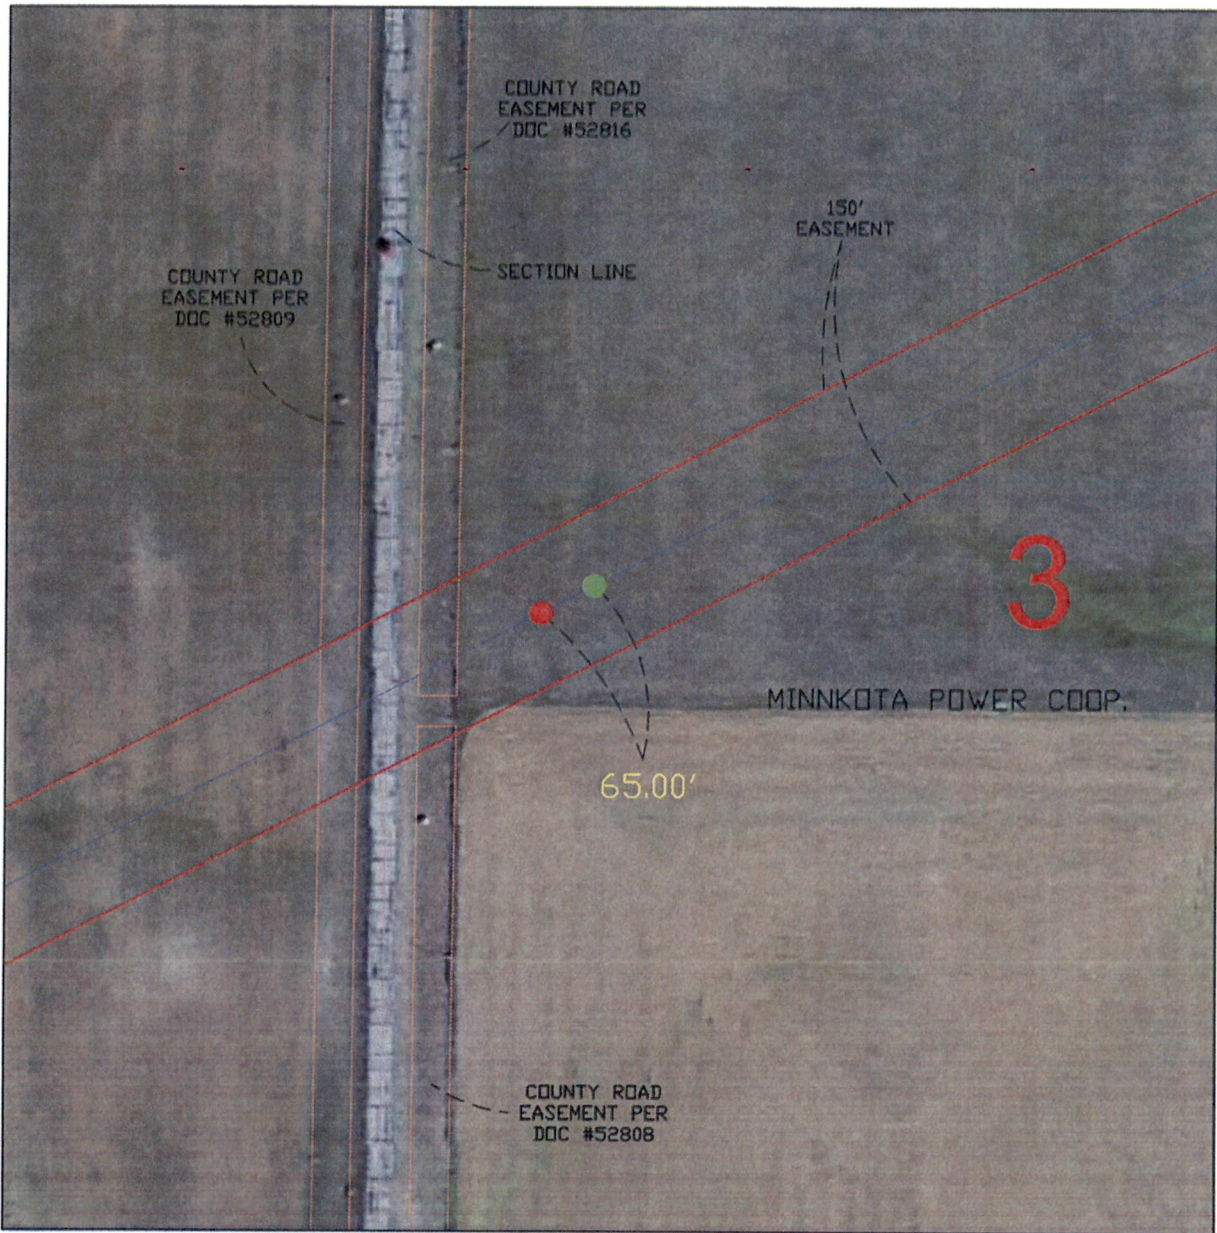

W

E

S

DESCRIPTION NW1/4 SEC. 34 TWP. 142N R. 83W  
 COUNTY OLIVER STATE NORTH DAKOTA  
 OWNER MINNKOTA POWER COOP. ADDRESS PO BOX 13200 GRAND FORKS, ND 58208  
 TRANSMISSION FACILITY: CENTER-GRAND FORKS 345 KV

POLE MOVEMENT: 65.00' DIFFERENCE  
 LENGTH

● = NEW POLE LOCATION

POLE # 3

DATE: 1/28/2014

● = PSC APPROVED POLE LOCATION

PROJECT: CENTER TO GRAND FORKS