



USDA-FSA 2009 Aerial Images

Match Line

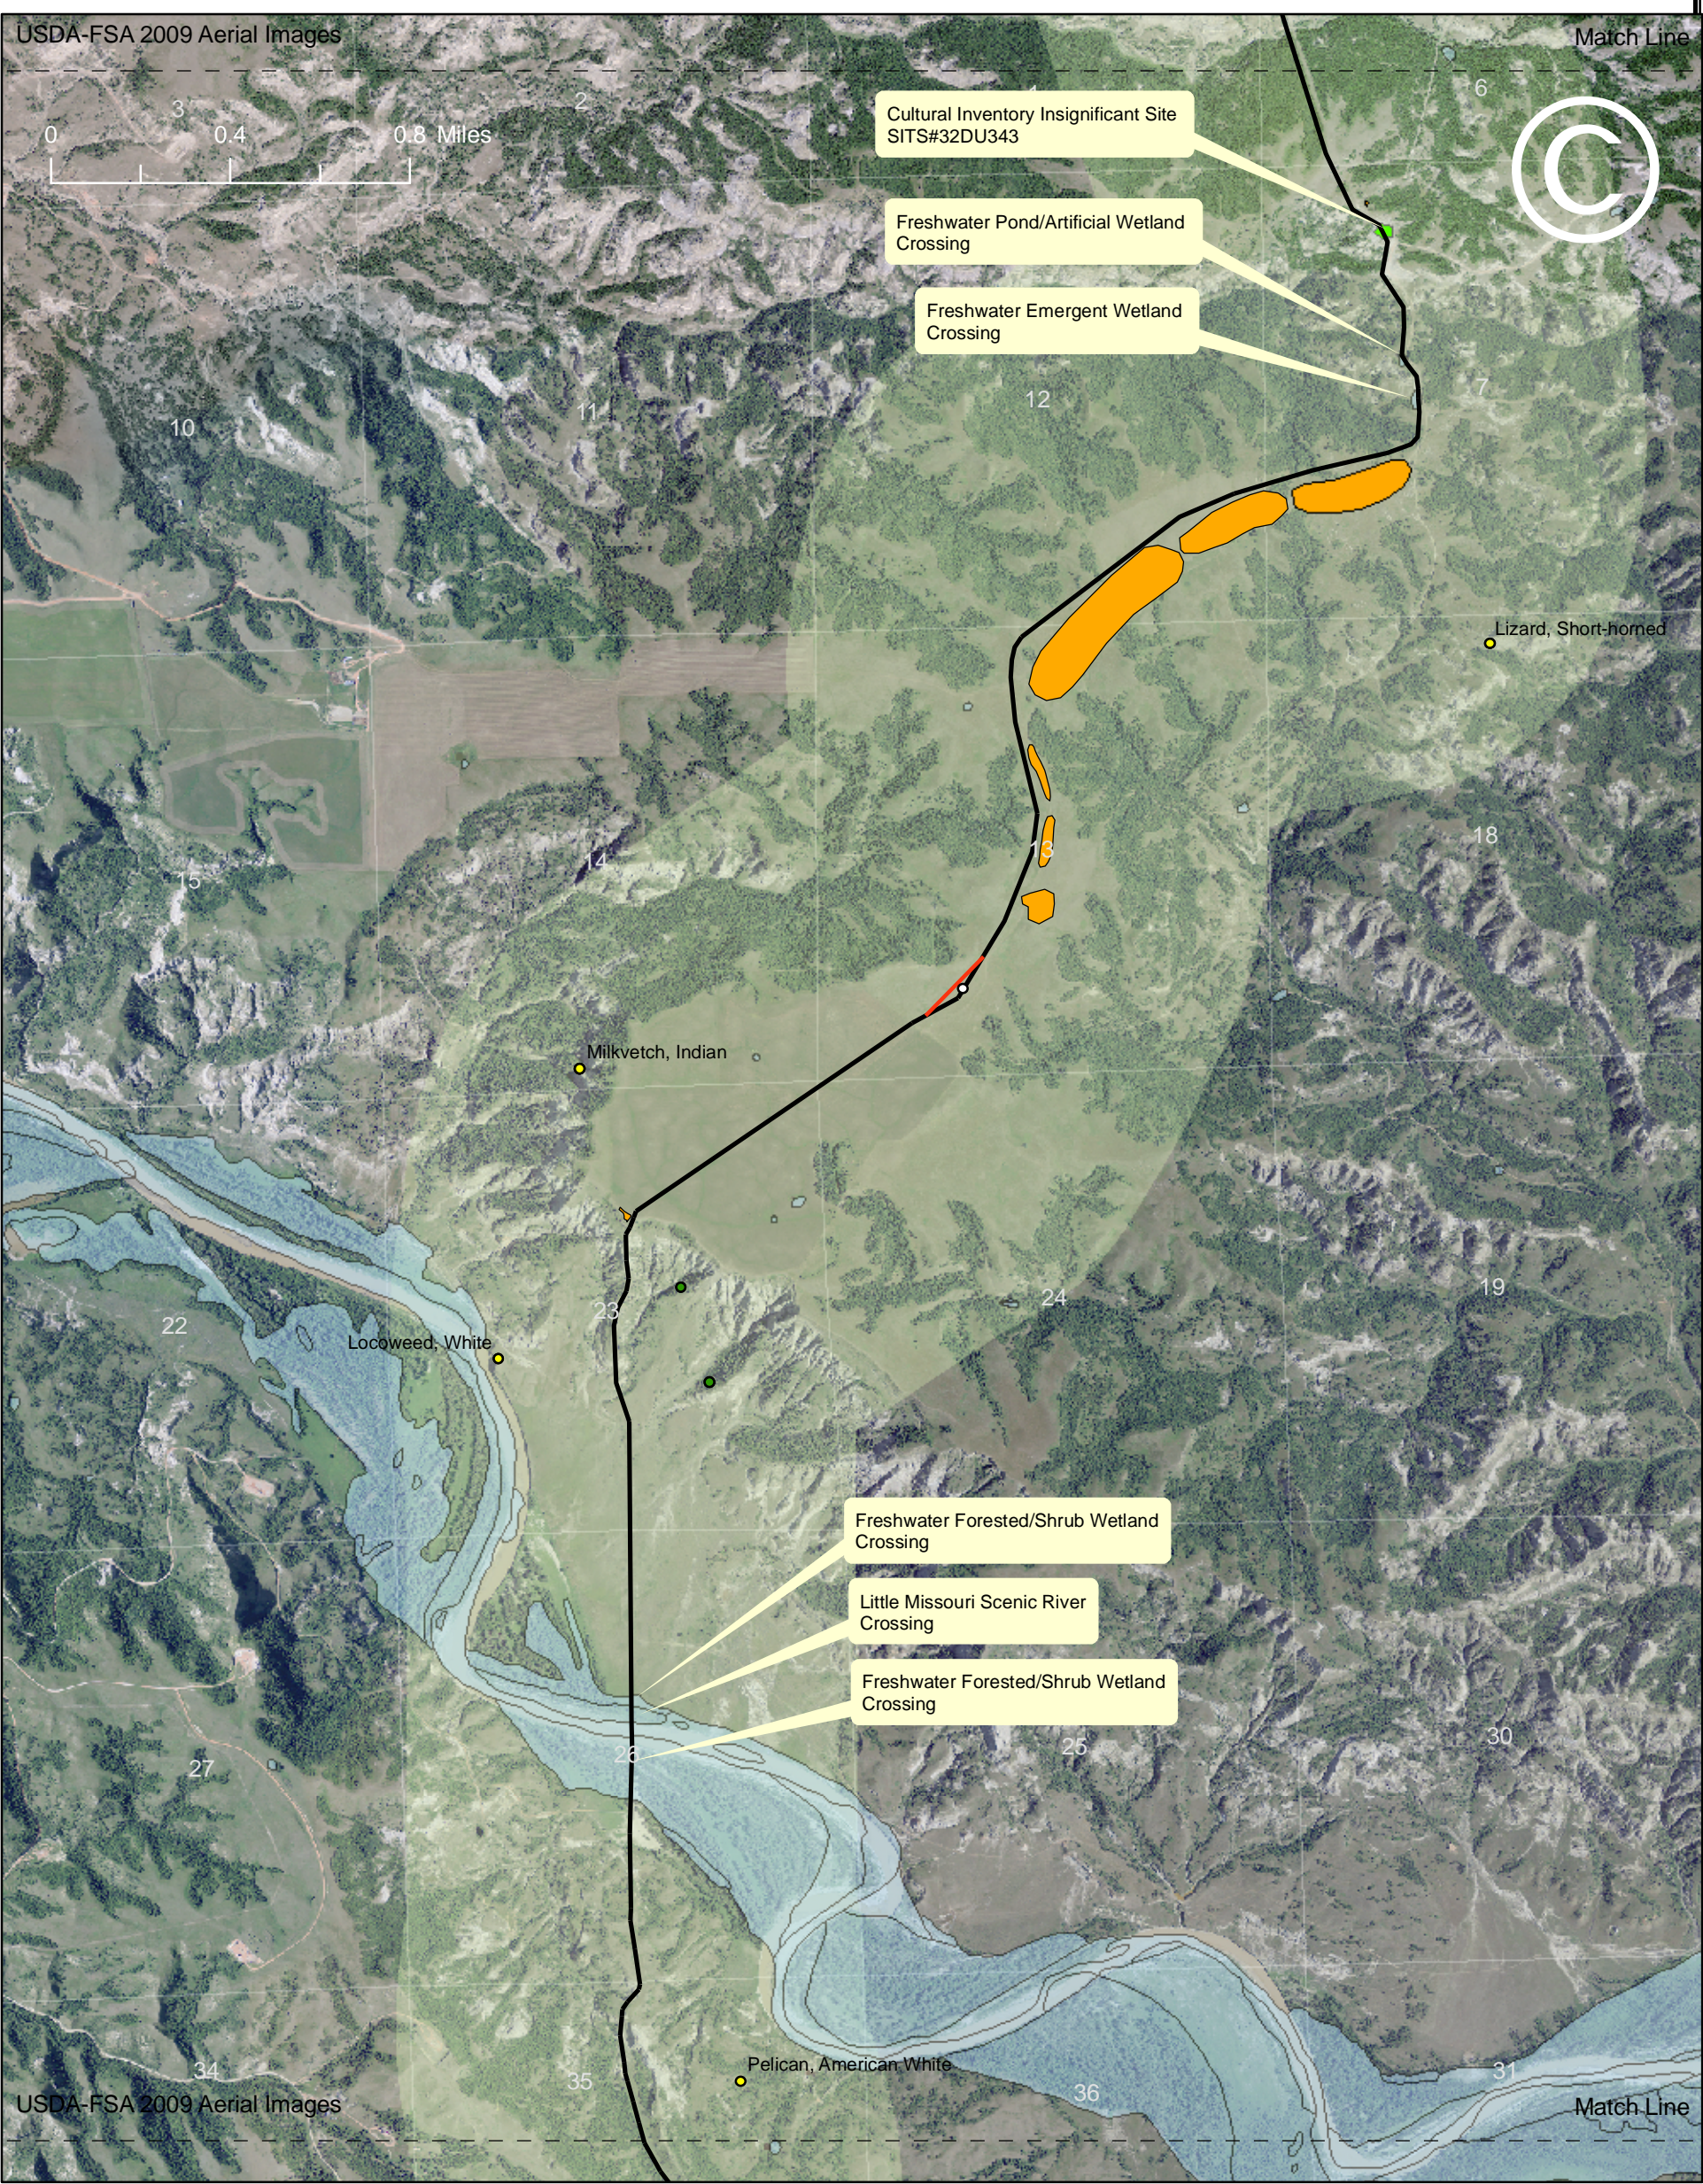

Legend

- Construction ROW
- November Reroute
- Cultural Inventory Sites
- Study Corridor
- Proposed Tower Anchor Location
- Sensitive Species Sites
- Insignificant Cultural Inventory Sites
- USFWS Wetland Inventory Site(s)

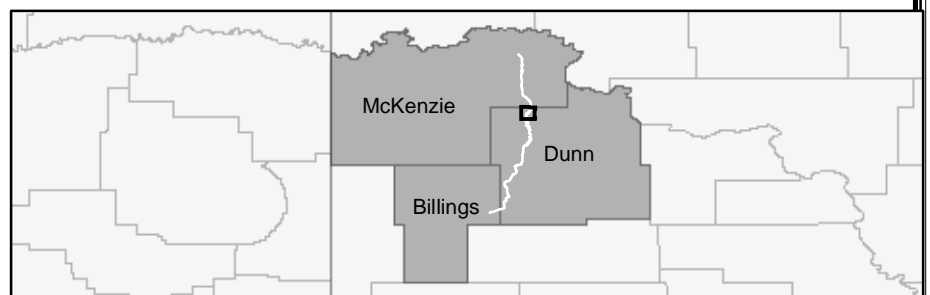

Bridger Pipeline LLC
 455 North Poplar Street
 Casper, Wyoming 82602
 307-237-9301

Figure 4.B.6a - Route Map
 12-Inch Crude Oil Pipeline
 Township 148 Range 96
 November 2010