

Exam Date: 11/22/2010

Equity Cooperative Elevator Company of S

Page: 1

Examiner: 1

PO Box 218

Sheyenne, ND

County:

Phone: 701-996-2231

CCC Number:

Location/Container Numbers/Comments	Section	Capacity
PART A - ADDITIONAL SPACE TO BE INCLUDED UNDER LICENSE		
301	C	142,800
		Total: 142,800
PART B - SPACE TO BE DELETED UNDER LICENSE		
006	D	3,933
001	E	74,586
007	D	3,933
002	D	2,864
003	D	2,864
004	D	2,864
		Total: 91,044
PART C - ALL SPACE TO BE INCLUDED UNDER LICENSE		
	A	467,000
	B	122,000
	C	397,000
	D	16,000
		Total: 1,002,000
PART D - TOTAL CAPACITY BY FUNCTIONAL UNIT		
Oberon 281	C D	413,000
Sheyenne 282	A B	589,000
		Total: 1,002,000

Exam Date: 11/22/2010

Equity Cooperative Elevator Company of S
PO Box 218
Sheyenne, ND
County:

Page: 1

Status	Section	Bin Number	Bin Type	Base Point	Diameter or Bu/Ft (Irreg.)	Length	Width	Side wall	Add for Hopper	Ded. for Obst.	Effective Depth	Add for Peak	Depth for Capac.	Bushels per Foot	Base Pack%	Bushel Capacity with Pack
--------	---------	------------	----------	------------	-------------------------------	--------	-------	--------------	----------------------	----------------------	--------------------	--------------------	------------------------	------------------------	---------------	------------------------------

Facility: Oberon

Section: C

C	001	Square	work floor		0.000	10.60	6.100	39.00	0.00	0.00	39.000	0.000	39.0	52.0	4.50	2,119
C	002	Square	work floor		0.000	5.000	3.800	39.00	0.00	0.00	39.000	0.000	39.0	15.3	2.00	609
C	003	Square	work floor		0.000	5.000	3.800	39.00	0.00	0.00	39.000	0.000	39.0	15.3	2.00	609
C	004	Square	work floor		0.000	5.000	5.400	40.00	0.00	0.00	40.000	0.000	40.0	21.7	2.00	885
C	006	Square	work floor		0.000	5.000	4.900	40.00	0.00	0.00	40.000	0.000	40.0	19.7	2.00	804
C	007 T	Square	work floor		0.000	11.00	5.000	40.00	0.00	0.00	40.000	0.000	40.0	44.2	3.50	1,830
C	007 B	Square	work floor - top 40		0.000	11.20	10.10	14.00	0.00	0.00	14.000	0.000	14.0	90.9	5.80	1,347
C	009	Square	work floor		0.000	10.60	5.400	42.00	0.00	0.00	42.000	0.000	42.0	46.0	4.00	2,009
C	010 T	Square	work floor		0.000	10.60	4.900	42.00	0.00	0.00	42.000	0.000	42.0	41.8	3.50	1,817
C	010 B	Square	work floor -top 42'		0.000	11.20	10.40	12.00	0.00	0.00	12.000	0.000	12.0	93.6	5.80	1,188
C	011 T	Square	work floor		0.000	10.10	4.900	42.00	0.00	0.00	42.000	0.000	42.0	39.8	3.00	1,722
C	011 B	Square	work floor - top 42'		0.000	11.20	10.10	12.00	0.00	0.00	12.000	0.000	12.0	90.9	5.80	1,154
C	012	Square	work floor		0.000	10.10	5.400	37.00	0.00	0.00	37.000	0.000	37.0	43.8	3.50	1,678
C	013	Square	work floor		0.000	10.10	6.100	38.00	0.00	0.00	38.000	0.000	38.0	49.5	4.20	1,960
C	015 T	Irregular	work floor - 10.1 X 6.5 less		33.000	0.000	0.000	9.500	0.00	0.00	9.500	0.000	9.5	33.0	2.50	322
C	015 B	Square	work floor - top 9.5'		0.000	10.10	6.500	28.50	0.00	0.00	28.500	0.000	28.5	52.8	4.50	1,573
C	016	Square	work floor		0.000	10.10	5.400	42.00	0.00	0.00	42.000	0.000	42.0	43.8	3.50	1,904
C	017 T	Square	work floor		0.000	10.10	4.900	42.00	0.00	0.00	42.000	0.000	42.0	39.8	3.00	1,722
C	017 B	Square	work floor - top 42'		0.000	11.20	10.10	12.00	0.00	0.00	12.000	0.000	12.0	90.9	5.80	1,154
C	018	Square	work floor		0.000	10.60	5.400	42.00	0.00	0.00	42.000	0.000	42.0	46.0	4.00	2,009
C	019	Square	work floor		0.000	10.60	4.900	29.00	0.00	0.00	29.000	0.000	29.0	41.8	3.50	1,254

Exam Date:11/22/2010

Equity Cooperative Elevator Company of S
PO Box 218
Sheyenne , ND
County:

Page: 2

Status	Section	Bin Number	Bin Type	Base Point	Diameter or Bu/Ft (Irreg.)		Side wall	Add for Hopper	Ded. for Obst.	Effective Depth	Add for Peak	Depth for Capac.	Bushels per Foot	Base Pack%	Bushel Capacity with Pack
					Length	Width									

Facility: Oberon

Section: C

C	022 T	Square	work floor		0.000	10.10	4.900	42.00	0.00	0.00	42.000	0.000	42.0	39.8	3.00	1,722
C	022 B	Square	work floor - top 42'		0.000	11.20	10.10	12.00	0.00	0.00	12.000	0.000	12.0	90.9	5.80	1,154
C	023	Square	work floor		0.000	10.10	5.400	42.00	0.00	0.00	42.000	0.000	42.0	43.8	3.50	1,904
C	024	Square	work floor		0.000	10.10	3.500	39.00	0.00	0.00	39.000	0.000	39.0	28.4	2.50	1,136
C	026	Square	work floor		0.000	10.60	6.500	39.00	0.00	0.00	39.000	0.000	39.0	55.4	4.80	2,265
C	101 T	Square	work floor		0.000	10.30	9.700	43.00	0.00	0.00	43.000	0.000	43.0	80.3	5.50	3,643
C	101 B	Square	work floor - top 43'		0.000	14.30	9.400	8.000	0.00	0.00	8.000	0.000	8.0	108.1	6.20	919
C	102 T	Square	work floor		0.000	10.30	9.800	43.00	0.00	0.00	43.000	0.000	43.0	81.1	5.50	3,679
C	102 B	Square	work floor - top 43'		0.000	14.30	9.600	8.000	0.00	0.00	8.000	0.000	8.0	110.4	6.20	938
C	103 T	Square	work floor		0.000	10.30	9.700	43.00	0.00	0.00	43.000	0.000	43.0	80.3	5.50	3,643
C	103 B	Square	work floor - top 43'		0.000	14.30	9.700	8.000	0.00	0.00	8.000	0.000	8.0	111.5	6.20	947
C	104	Square	work floor		0.000	11.00	9.700	43.00	0.00	0.00	43.000	0.000	43.0	85.8	5.80	3,903
C	105 T	Square	work floor		0.000	10.30	9.700	43.00	0.00	0.00	43.000	0.000	43.0	80.3	5.50	3,643
C	105 B	Square	work floor - top 43'		0.000	14.30	9.500	8.000	0.00	0.00	8.000	0.000	8.0	109.2	6.20	928
C	107	Square	work floor		0.000	11.00	9.700	43.00	0.00	0.00	43.000	0.000	43.0	85.8	5.80	3,903
C	108 T	Square	work floor		0.000	10.00	9.700	43.00	0.00	0.00	43.000	0.000	43.0	78.0	5.50	3,538
C	108 B	Square	work floor - top 43'		0.000	12.20	9.500	8.000	0.00	0.00	8.000	0.000	8.0	93.2	5.80	789
C	109 T	Square	work floor		0.000	10.00	9.700	43.00	0.00	0.00	43.000	0.000	43.0	78.0	5.50	3,538
C	109 B	Square	work floor - top 43'		0.000	12.20	9.700	8.000	0.00	0.00	8.000	0.000	8.0	95.1	6.00	807
C	110 T	Square	work floor		0.000	10.00	9.800	43.00	0.00	0.00	43.000	0.000	43.0	78.8	5.50	3,574
C	110 B	Square	work floor - top 43'		0.000	12.20	9.600	8.000	0.00	0.00	8.000	0.000	8.0	94.1	6.00	798

Exam Date:11/22/2010

Equity Cooperative Elevator Company of S
PO Box 218
Sheyenne , ND
County:

Page: 3

Examiner: 1

Status	Section	Bin Number	Bin Type	Base Point	Diameter or Bu/Ft (Irreg.)	Length	Width	Side wall	Add for Hopper	Ded. for Obst.	Effective Depth	Add for Peak	Depth for Capac.	Bushels per Foot	Base Pack%	Bushel Capacity with Pack
--------	---------	------------	----------	------------	-------------------------------	--------	-------	--------------	----------------------	----------------------	--------------------	--------------------	------------------------	------------------------	---------------	------------------------------

Facility: Oberon

Section: C

C	111 T	Square	work floor		0.000	10.00	9.700	43.00	0.00	0.00	43.000	0.000	43.0	78.0	5.50	3,538
C	111 B	Square	work floor - top 43'		0.000	12.20	9.400	8.000	0.00	0.00	8.000	0.000	8.0	92.2	5.80	781
C	112	Square	work floor		0.000	11.00	9.700	44.00	0.00	0.00	44.000	0.000	44.0	85.8	5.80	3,994
C	113	Square	work floor		0.000	11.00	9.800	43.00	0.00	0.00	43.000	0.000	43.0	86.7	5.80	3,944
C	201	Peaked	top of sidewall		24.000	0.000	0.000	37.30	0.00	0.00	37.300	1.400	38.7	363.7	7.80	15,173
C	202	Peaked	top of sidewall		24.000	0.000	0.000	37.30	0.00	0.00	37.300	1.400	38.7	363.7	7.80	15,173
C	203	Peaked	top of sidewall		24.000	0.000	0.000	37.30	0.00	0.00	37.300	1.400	38.7	363.7	7.80	15,173
C	204	Peaked	top of sidewall		48.000	0.000	0.000	64.50	0.00	0.00	64.500	3.400	67.9	1454.6	10.0	108,644
C	205	Peaked	top of sidewall		18.000	0.000	0.000	48.00	0.00	0.00	48.000	1.100	49.1	204.6	6.00	10,649
Added	C	301	Peaked	top of sidewall	59.800	0.000	0.000	53.30	0.00	0.00	53.300	4.200	57.5	2257.7	10.0	142,800

Bin count: 52

Facility: Oberon Section: C Total: 396,909To Even: 397,000

Section: D

D	001	Peaked	top of sidewall		16.000	0.000	0.000	20.00	2.00	0.00	22.000	1.000	23.0	161.6	5.80	3,933
D	005	Peaked	top of sidewall		18.000	0.000	0.000	16.00	2.00	0.00	18.000	1.100	19.1	204.6	6.00	4,142
D	008	Peaked	top of sidewall		17.600	0.000	0.000	16.00	0.00	0.00	16.000	1.100	17.1	195.6	6.00	3,546
D	009	Peaked	top of sidewall		17.600	0.000	0.000	16.00	0.00	0.00	16.000	1.100	17.1	195.6	6.00	3,546

Bin count: 4

Facility: Oberon Section: D Total: 15,167To Even: 16,000

Exam Date: 11/22/2010

Equity Cooperative Elevator Company of S
 PO Box 218
 Sheyenne, ND
 County:

Page: 4

Status	Section	Bin Number	Bin Type	Base Point	Diameter or Bu/Ft (Irreg).	Length	Width	Side wall	Add for Hopper	Ded. for Obst.	Effective Depth	Add for Peak	Depth for Capac.	Bushels per Foot	Base Pack%	Bushel Capacity with Pack
--------	---------	------------	----------	------------	-------------------------------	--------	-------	--------------	----------------------	----------------------	--------------------	--------------------	------------------------	------------------------	---------------	------------------------------

Facility: Sheyenne

Section: A

A	001	Square	work floor		0.000	6.800	5.200	54.00	0.00	0.00	54.000	0.000	54.0	28.4	2.50	1,572
A	002	Square	work floor		0.000	8.300	5.900	50.00	0.00	0.00	50.000	0.000	50.0	39.4	3.00	2,029
A	003	Square	work floor		0.000	6.900	5.200	54.00	0.00	0.00	54.000	0.000	54.0	28.8	2.50	1,594
A	004 T	Square	work floor		0.000	6.800	5.100	15.00	0.00	0.00	15.000	0.000	15.0	27.9	2.50	429
A	004 M	Square	work floor -top 15'		0.000	14.00	5.100	38.00	0.00	0.00	38.000	0.000	38.0	57.4	4.80	2,286
A	004B	Square	work floor -top & middle 53'		0.000	14.00	10.30	14.00	0.00	0.00	14.000	0.000	14.0	115.9	6.20	1,724
A	005	Square	work floor		0.000	6.800	6.300	50.00	0.00	0.00	50.000	0.000	50.0	34.4	3.00	1,772
A	006	Square	work floor		0.000	6.900	5.900	48.00	0.00	0.00	48.000	0.000	48.0	32.7	2.50	1,609
A	007	Square	work floor		0.000	6.800	5.900	50.00	0.00	0.00	50.000	0.000	50.0	32.3	2.50	1,655
A	009	Square	work floor		0.000	6.900	6.300	48.00	0.00	0.00	48.000	0.000	48.0	34.9	3.00	1,725
A	010	Square	work floor		0.000	8.300	6.300	50.00	0.00	0.00	50.000	0.000	50.0	42.0	3.50	2,174
A	011 T	Square	work floor		0.000	10.50	6.900	46.00	0.00	0.00	46.000	0.000	46.0	58.2	4.80	2,805
A	011 B	Square	work floor - top 46'		0.000	14.00	10.50	21.00	0.00	0.00	21.000	0.000	21.0	118.2	6.20	2,636
A	012	Square	work floor		0.000	10.50	6.800	49.50	0.00	0.00	49.500	0.000	49.5	57.4	4.80	2,977
A	015 T	Irregular	work floor - 10.5 x 8.3 with		47.000	0.000	0.000	12.00	0.00	0.00	12.000	0.000	12.0	47.0	4.00	587
A	015 B	Square	work floor - top 12'		0.000	10.50	8.300	36.00	0.00	0.00	36.000	0.000	36.0	70.1	5.20	2,655
A	016	Square	work floor		0.000	10.50	8.000	50.00	0.00	0.00	50.000	0.000	50.0	67.5	5.20	3,551
A	017	Square	work floor		0.000	10.50	6.800	46.00	0.00	0.00	46.000	0.000	46.0	57.4	4.80	2,767
A	018	Square	work floor		0.000	8.000	6.300	49.00	0.00	0.00	49.000	0.000	49.0	40.5	3.00	2,045
A	019	Square	work floor		0.000	13.10	6.800	49.00	0.00	0.00	49.000	0.000	49.0	71.6	5.20	3,690
A	020 T	Square	work floor		0.000	10.50	6.800	46.00	0.00	0.00	46.000	0.000	46.0	57.4	4.80	2,767

Exam Date: 11/22/2010

Equity Cooperative Elevator Company of S
PO Box 218
Sheyenne, ND
County:

Page: 5

Status	Section	Bin Number	Bin Type	Base Point	Diameter or Bu/Ft (Irreg).		Side wall	Add for Hopper	Ded. for Obst.	Effective Depth	Add for Peak	Depth for Capac.	Bushels per Foot	Base Pack%	Bushel Capacity with Pack
					Length	Width									

Facility: Sheyenne

Section: A

A	020 B	Square	work floor - top 46'	0.000	14.00	10.50	21.00	0.00	0.00	21.000	0.000	21.0	118.2	6.20	2,636
A	022	Square	work floor	0.000	13.10	6.800	48.50	0.00	0.00	48.500	0.000	48.5	71.6	5.20	3,654
A	023	Square	work floor	0.000	8.000	5.900	50.00	0.00	0.00	50.000	0.000	50.0	37.9	3.00	1,952
A	024 T	Square	work floor	0.000	14.00	5.100	53.00	0.00	0.00	53.000	0.000	53.0	57.4	4.80	3,188
A	024 B	Square	work floor - top 53'	0.000	14.00	10.30	14.00	0.00	0.00	14.000	0.000	14.0	115.9	6.20	1,724
A	025	Square	work floor	0.000	6.800	5.200	53.00	0.00	0.00	53.000	0.000	53.0	28.4	2.50	1,543
A	026	Square	work floor	0.000	6.800	5.200	53.00	0.00	0.00	53.000	0.000	53.0	28.4	2.50	1,543
A	029	Square	work floor	0.000	5.000	4.400	49.00	0.00	0.00	49.000	0.000	49.0	17.7	2.00	884
A	030	Square	work floor	0.000	10.30	4.100	49.50	0.00	0.00	49.500	0.000	49.5	33.9	2.50	1,720
A	101 T	Square	work floor	0.000	11.50	10.30	58.00	0.00	0.00	58.000	0.000	58.0	95.2	6.00	5,853
A	101 B	Square	work floor - top 58'	0.000	15.20	10.30	9.000	0.00	0.00	9.000	0.000	9.0	125.9	6.50	1,207
A	102 T	Square	work floor	0.000	11.50	10.50	58.00	0.00	0.00	58.000	0.000	58.0	97.1	6.00	5,970
A	102 B	Square	work floor - top 58'	0.000	15.20	10.50	9.000	0.00	0.00	9.000	0.000	9.0	128.3	6.50	1,230
A	103	Square	work floor	0.000	12.00	10.50	58.00	0.00	0.00	58.000	0.000	58.0	101.3	6.00	6,228
A	104 T	Square	work floor	0.000	11.50	10.50	58.00	0.00	0.00	58.000	0.000	58.0	97.1	6.00	5,970
A	104 B	Square	work floor - top 58'	0.000	15.20	10.50	9.000	0.00	0.00	9.000	0.000	9.0	128.3	6.50	1,230
A	105	Square	work floor	0.000	12.00	10.50	58.00	0.00	0.00	58.000	0.000	58.0	101.3	6.00	6,228
A	106 T	Square	work floor	0.000	11.50	10.50	58.00	0.00	0.00	58.000	0.000	58.0	97.1	6.00	5,970
A	106 B	Square	work floor - top 58'	0.000	15.20	10.50	9.000	0.00	0.00	9.000	0.000	9.0	128.3	6.50	1,230
A	107 T	Square	work floor	0.000	11.50	10.50	58.00	0.00	0.00	58.000	0.000	58.0	97.1	6.00	5,970
A	107 B	Square	work floor - top 58'	0.000	15.20	10.50	9.000	0.00	0.00	9.000	0.000	9.0	128.3	6.50	1,230

Exam Date: 11/22/2010

Equity Cooperative Elevator Company of S
PO Box 218
Sheyenne, ND
County:

Page: 6

Status	Section	Bin Number	Bin Type	Base Point	Diameter or Bu/Ft (Irreg).		Side wall	Add for Hopper	Ded. for Obst.	Effective Depth	Add for Peak	Depth for Capac.	Bushels per Foot	Base Pack%	Bushel Capacity with Pack
					Length	Width									

Facility: Sheyenne

Section: A

A	108 T	Square	work floor		0.000	11.50	10.30	58.00	0.00	0.00	58.000	0.000	58.0	95.2	6.00	5,853
A	108 B	Square	work floor -top 58'		0.000	15.20	10.30	9.000	0.00	0.00	9.000	0.000	9.0	125.9	6.50	1,207
A	109	Square	work floor		0.000	12.00	10.30	58.00	0.00	0.00	58.000	0.000	58.0	99.4	6.00	6,111
A	110 T	Square	work floor		0.000	11.50	10.60	58.00	0.00	0.00	58.000	0.000	58.0	98.0	6.00	6,025
A	110 B	Square	work floor - top 58'		0.000	15.20	10.60	9.000	0.00	0.00	9.000	0.000	9.0	129.5	6.50	1,242
A	111	Square	work floor		0.000	12.00	10.50	58.00	0.00	0.00	58.000	0.000	58.0	101.3	6.00	6,228
A	112 T	Square	work floor		0.000	11.50	10.50	58.00	0.00	0.00	58.000	0.000	58.0	97.1	6.00	5,970
A	112 B	Square	work floor - top 58'		0.000	15.20	10.50	9.000	0.00	0.00	9.000	0.000	9.0	128.3	6.50	1,230
A	113 T	Square	work floor		0.000	11.50	10.30	58.00	0.00	0.00	58.000	0.000	58.0	95.2	6.00	5,853
A	113 B	Square	work floor - top 58'		0.000	15.20	10.30	9.000	0.00	0.00	9.000	0.000	9.0	125.9	6.50	1,207
A	115	Square	work floor		0.000	12.00	10.30	58.00	0.00	0.00	58.000	0.000	58.0	99.4	6.00	6,111
A	116 T	Square	work floor		0.000	11.50	10.30	58.00	0.00	0.00	58.000	0.000	58.0	95.2	6.00	5,853
A	116 B	Square	work floor - top 58'		0.000	15.20	10.30	9.000	0.00	0.00	9.000	0.000	9.0	125.9	6.50	1,207
A	117 T	Square	work floor		0.000	11.50	10.50	58.00	0.00	0.00	58.000	0.000	58.0	97.1	6.00	5,970
A	117 B	Square	work floor - top 58'		0.000	15.20	10.50	9.000	0.00	0.00	9.000	0.000	9.0	128.3	6.50	1,230
A	118 T	Square	work floor		0.000	11.50	10.60	58.00	0.00	0.00	58.000	0.000	58.0	98.0	6.00	6,025
A	118 B	Square	work floor -top 58'		0.000	15.20	10.60	9.000	0.00	0.00	9.000	0.000	9.0	129.5	6.50	1,242
A	119	Square	work floor		0.000	12.00	10.60	58.00	0.00	0.00	58.000	0.000	58.0	102.3	6.00	6,289
A	201	Peaked	top of sidewall at eave		32.700	0.000	0.000	62.80	0.00	0.00	62.800	2.000	64.8	675.1	9.50	47,902
A	202	Peaked	top of sidewall at eave		35.700	0.000	0.000	65.50	0.00	0.00	65.500	2.100	67.6	804.6	10.0	59,830
A	203	Peaked	top of sidewall at eave		41.800	0.000	0.000	69.40	0.00	0.00	69.400	2.500	71.9	1103.1	10.0	87,244

Exam Date:11/22/2010

Equity Cooperative Elevator Company of S

Page: 7

Examiner: 1

PO Box 218

Sheyenne , ND

County:

Status	Section	Bin Number	Bin Type	Base Point	Diameter or Bu/Ft (Irreg.)	Length	Width	Side wall	Add for Hopper	Ded. for Obst.	Effective Depth	Add for Peak	Depth for Capac.	Bushels per Foot	Base Pack%	Bushel Capacity with Pack
--------	---------	------------	----------	------------	-------------------------------	--------	-------	--------------	----------------------	----------------------	--------------------	--------------------	------------------------	------------------------	---------------	------------------------------

Facility: Sheyenne

Section: A

A	204	Peaked	top of sidewall - hopper bin		24.000	0.000	0.000	22.00	3.00	0.00	25.000	1.400	26.4	363.7	7.80	10,351
A	205	Peaked	top of sidewall- hopper bin		24.000	0.000	0.000	22.00	3.00	0.00	25.000	1.400	26.4	363.7	7.80	10,351
A	206	Peaked	top of sidewall- hopper bin		15.500	0.000	0.000	15.00	2.00	0.00	17.000	0.900	17.9	151.7	5.50	2,864
A	207	Peaked	top of sidewall- hopper bin		15.500	0.000	0.000	15.00	2.00	0.00	17.000	0.900	17.9	151.7	5.50	2,864
A	208	Peaked	top of sidewall- hopper bin		16.000	0.000	0.000	20.00	2.00	0.00	22.000	1.000	23.0	161.6	5.80	3,933
A	301	Peaked	top of sidewall		35.800	0.000	0.000	58.75	0.00	0.00	58.750	2.100	60.9	809.2	10.0	54,208

Bin count: 69

Facility: Sheyenne Section: A Total: **466,609**To Even: **467,000**

Section: B

B	001	Square	work floor		0.000	5.700	3.500	52.50	0.00	0.00	52.500	0.000	52.5	16.0	2.00	857
B	003	Square	work floor		0.000	5.000	4.100	52.00	0.00	0.00	52.000	0.000	52.0	16.5	2.00	875
B	004 T	Square	work floor		0.000	11.20	6.000	21.00	0.00	0.00	21.000	0.000	21.0	54.0	4.50	1,185
B	004 B	Square	work floor - top 21'		0.000	11.20	10.60	49.50	0.00	0.00	49.500	0.000	49.5	95.4	6.00	5,005
B	005	Square	work floor		0.000	11.20	4.600	20.00	0.00	0.00	20.000	0.000	20.0	41.4	3.50	857
B	006	Square	work floor		0.000	5.700	3.500	52.50	0.00	0.00	52.500	0.000	52.5	16.0	2.00	857
B	007	Square	work floor		0.000	10.60	5.700	51.00	0.00	0.00	51.000	0.000	51.0	48.6	4.20	2,583
B	008	Square	work floor		0.000	10.60	5.800	51.00	0.00	0.00	51.000	0.000	51.0	49.4	4.20	2,625
B	009	Square	work floor		0.000	11.20	10.60	70.00	0.00	0.00	70.000	0.000	70.0	95.4	6.00	7,079
B	010	Square	work floor		0.000	7.300	5.800	52.00	0.00	0.00	52.000	0.000	52.0	34.0	2.50	1,812

Exam Date:11/22/2010

Equity Cooperative Elevator Company of S
PO Box 218
Sheyenne , ND
County:

Page: 8

Status	Section	Bin Number	Bin Type	Base Point	Diameter or Bu/Ft (Irreg.)	Length	Width	Side wall	Add for Hopper	Ded. for Obst.	Effective Depth	Add for Peak	Depth for Capac.	Bushels per Foot	Base Pack%	Bushel Capacity with Pack
--------	---------	------------	----------	------------	-------------------------------	--------	-------	--------------	----------------------	----------------------	--------------------	--------------------	------------------------	------------------------	---------------	------------------------------

Facility: Sheyenne

Section: B

B	012 T	Square	work floor		0.000	7.600	7.300	15.00	0.00	0.00	15.000	0.000	15.0	44.6	3.50	692
B	012 B	Square	work floor - top 15'		0.000	11.20	7.300	37.00	0.00	0.00	37.000	0.000	37.0	65.7	5.00	2,553
B	015	Square	work floor		0.000	11.20	7.400	51.50	0.00	0.00	51.500	0.000	51.5	66.6	5.00	3,602
B	016	Square	work floor		0.000	11.20	10.60	70.00	0.00	0.00	70.000	0.000	70.0	95.4	6.00	7,079
B	017	Square	work floor		0.000	7.400	5.800	52.00	0.00	0.00	52.000	0.000	52.0	34.5	3.00	1,848
B	018	Square	work floor		0.000	10.60	5.800	51.00	0.00	0.00	51.000	0.000	51.0	49.4	4.20	2,625
B	020	Square	work floor		0.000	10.60	5.700	51.00	0.00	0.00	51.000	0.000	51.0	48.6	4.20	2,583
B	021 T	Square	work floor		0.000	11.00	7.000	53.00	0.00	0.00	53.000	0.000	53.0	61.9	4.80	3,438
B	021 B	Square	work floor- top 53'		0.000	11.00	10.60	17.00	0.00	0.00	17.000	0.000	17.0	93.7	5.80	1,685
B	022	Square	work floor		0.000	11.00	4.100	51.00	0.00	0.00	51.000	0.000	51.0	36.3	3.00	1,907
B	023	Square	work floor		0.000	7.400	5.700	52.00	0.00	0.00	52.000	0.000	52.0	33.9	2.50	1,807
B	024	Square	work floor		0.000	5.400	4.100	52.00	0.00	0.00	52.000	0.000	52.0	17.8	2.00	945
B	101	Peaked	top of sidewall		32.900	0.000	0.000	42.70	0.00	0.00	42.700	2.000	44.7	683.4	9.50	33,450
B	102	Peaked	top of sidewall		32.900	0.000	0.000	42.70	0.00	0.00	42.700	2.000	44.7	683.4	9.50	33,450

Bin count: 24

Facility: Sheyenne Section: B Total: 121,399

To Even: 122,000

Overall Licensed Bin Capacity for:

Equity Cooperative Elevator Company of S

Bin count: 149

Licensed Capacity:
(includes pack)

1,000,084 Bu.

Licensed Capacity (to even):
(includes pack and section totals are
rounded up to next highest 1000)


1,002,000 Bu.

EQUITY CO-OP ELEVATOR OF SHEYENNE
SHEYENNE ND
SECTION E
flat storage building
located 3 blocks south of Section B

Base dimensions


120.5' Length x 50.0' Width
sidewall ht. 14.0'
crossbars 13.8' ht.

Deleted- N/L 11-22-10

 


RRV&W RAIL


SECTION B

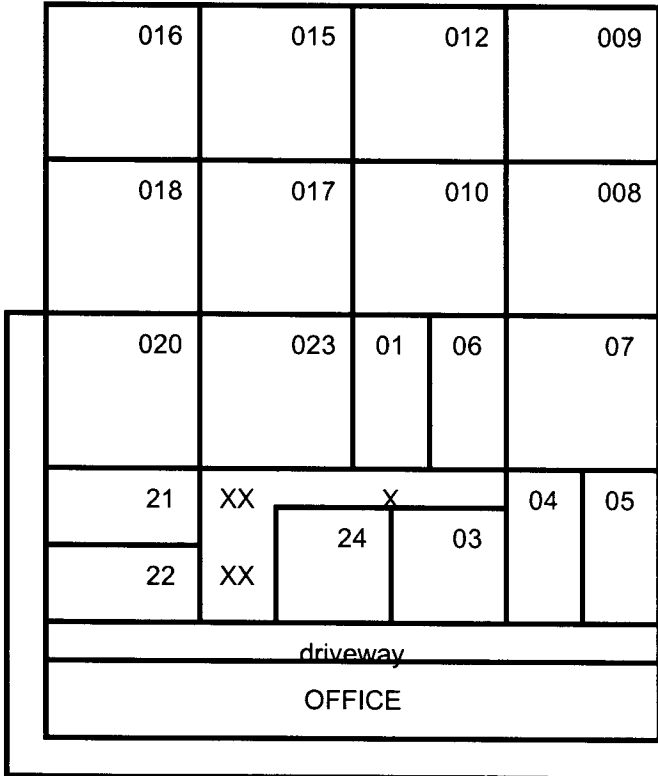



Section B is 275' S of Sec A

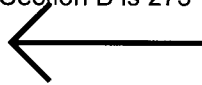

SECTION A
 hopper tanks

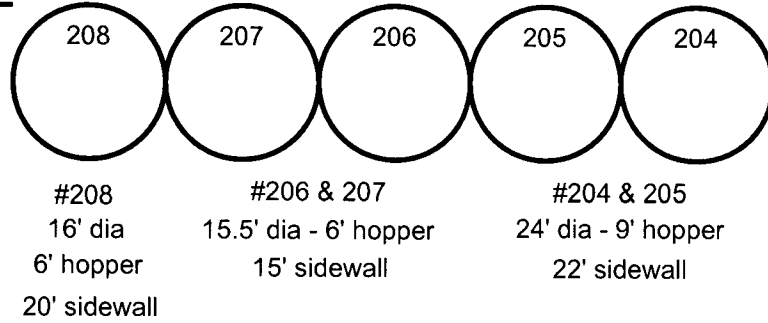


SECTION A


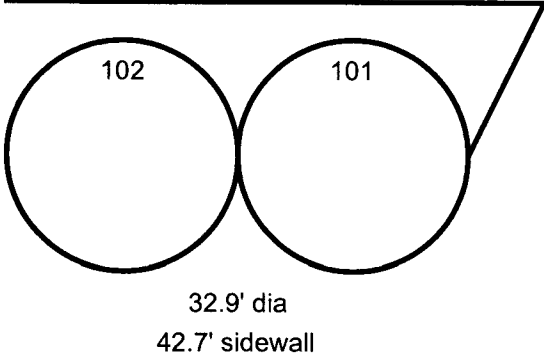
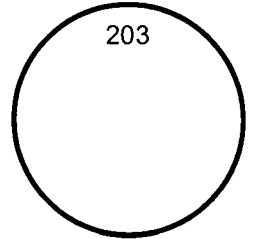



EQUITY CO-OP ELEV. CO. of SHEYENNE
 SHEYENNE N.D.
 SECTION A

RRV&W RR

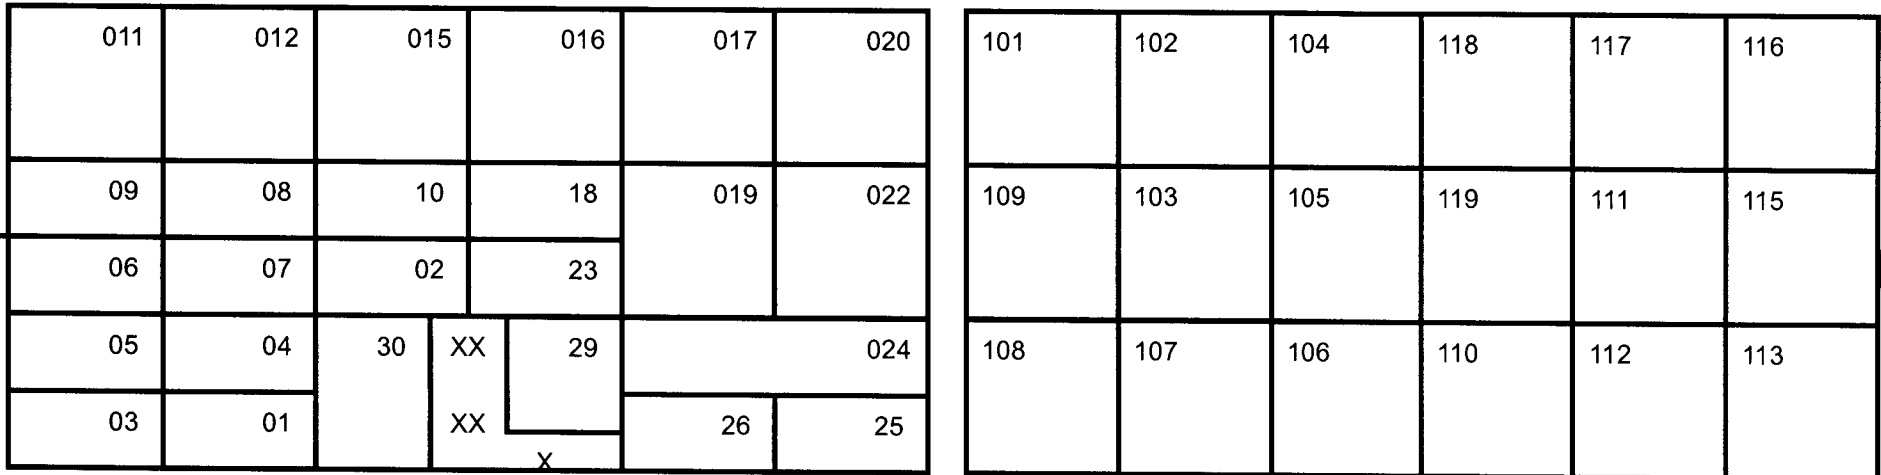

driveway

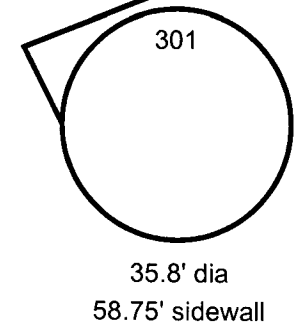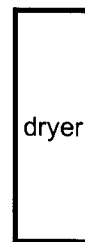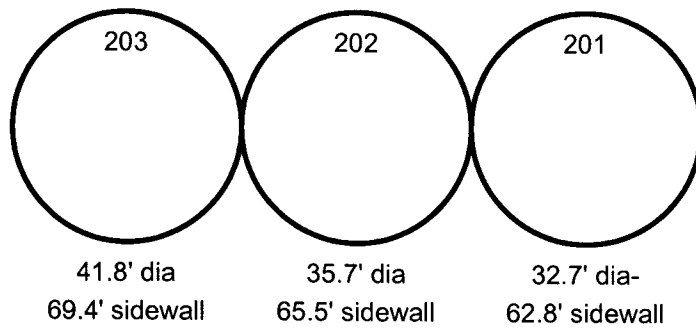

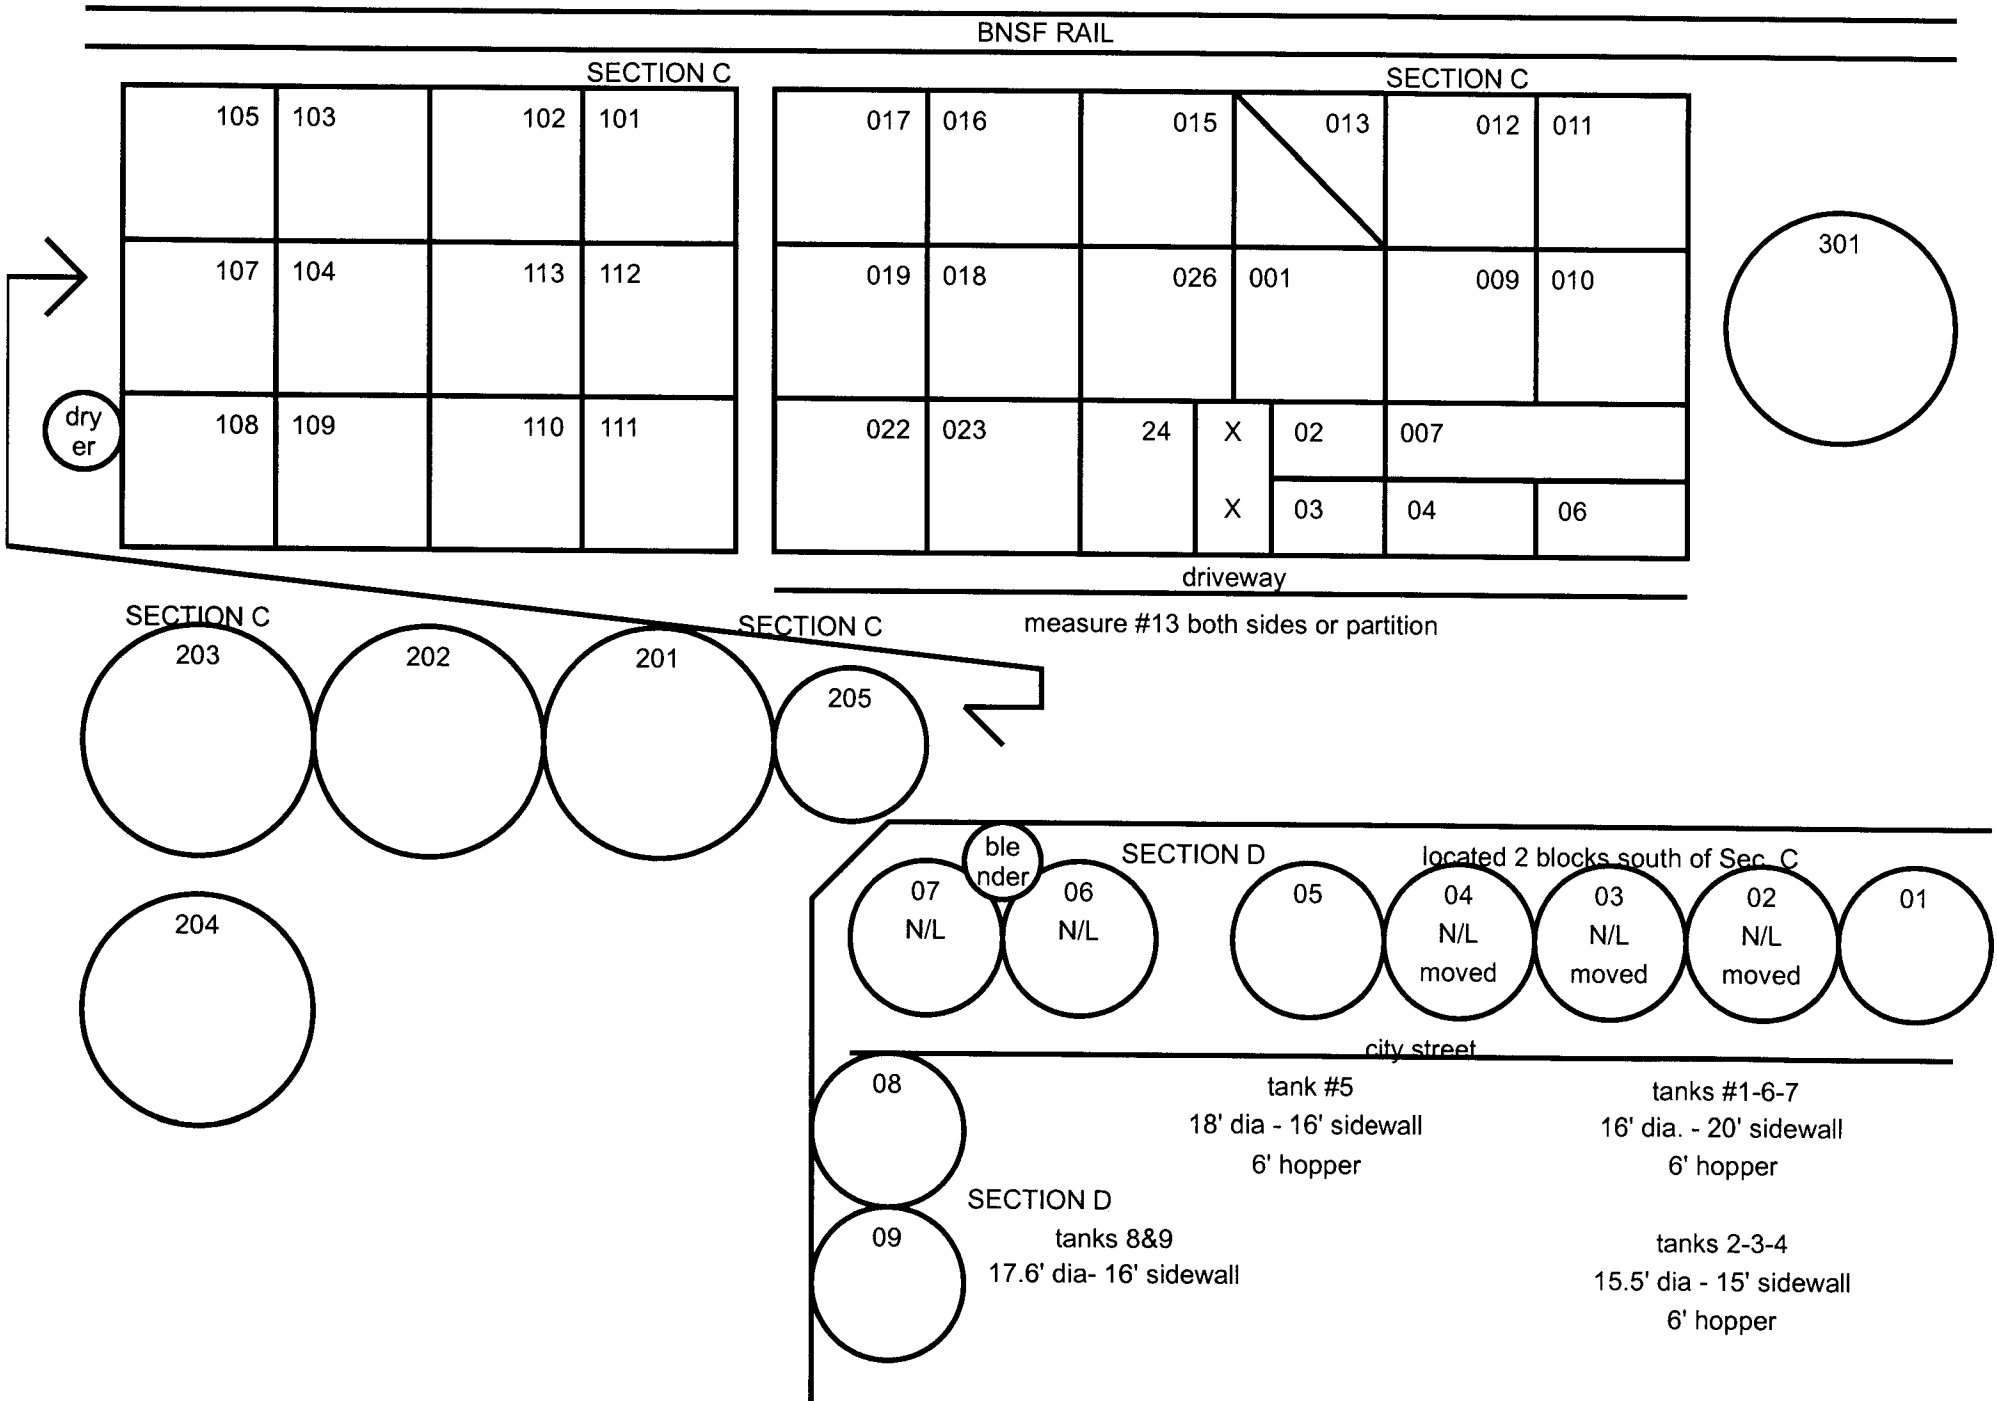

BNSF RAIL

SECTION C

SECTION C

105

103

102

101

017

016

015

013

012

011

107

104

113

112

019

018

026

001

009

010

108

109

110

111

022

023

24

X

02

007

301

dry er

driveway

measure #13 both sides or partition

SECTION C

SECTION C

203

202

201

205

204

blender

SECTION D

located 2 blocks south of Sec. C

07
N/L

06
N/L

05

04
N/L
moved

03
N/L
moved

02
N/L
moved

01

city street

08

tank #5

18' dia - 16' sidewall

6' hopper

tanks #1-6-7

16' dia. - 20' sidewall

6' hopper

SECTION D

tanks 8&9

17.6' dia- 16' sidewall

tanks 2-3-4

15.5' dia - 15' sidewall

6' hopper

09