
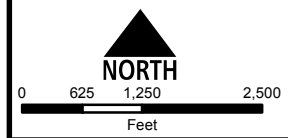


— Current BakkenLink Pipeline Route 2/7/2012
— BakkenLink Pipeline Route 10/25/2011

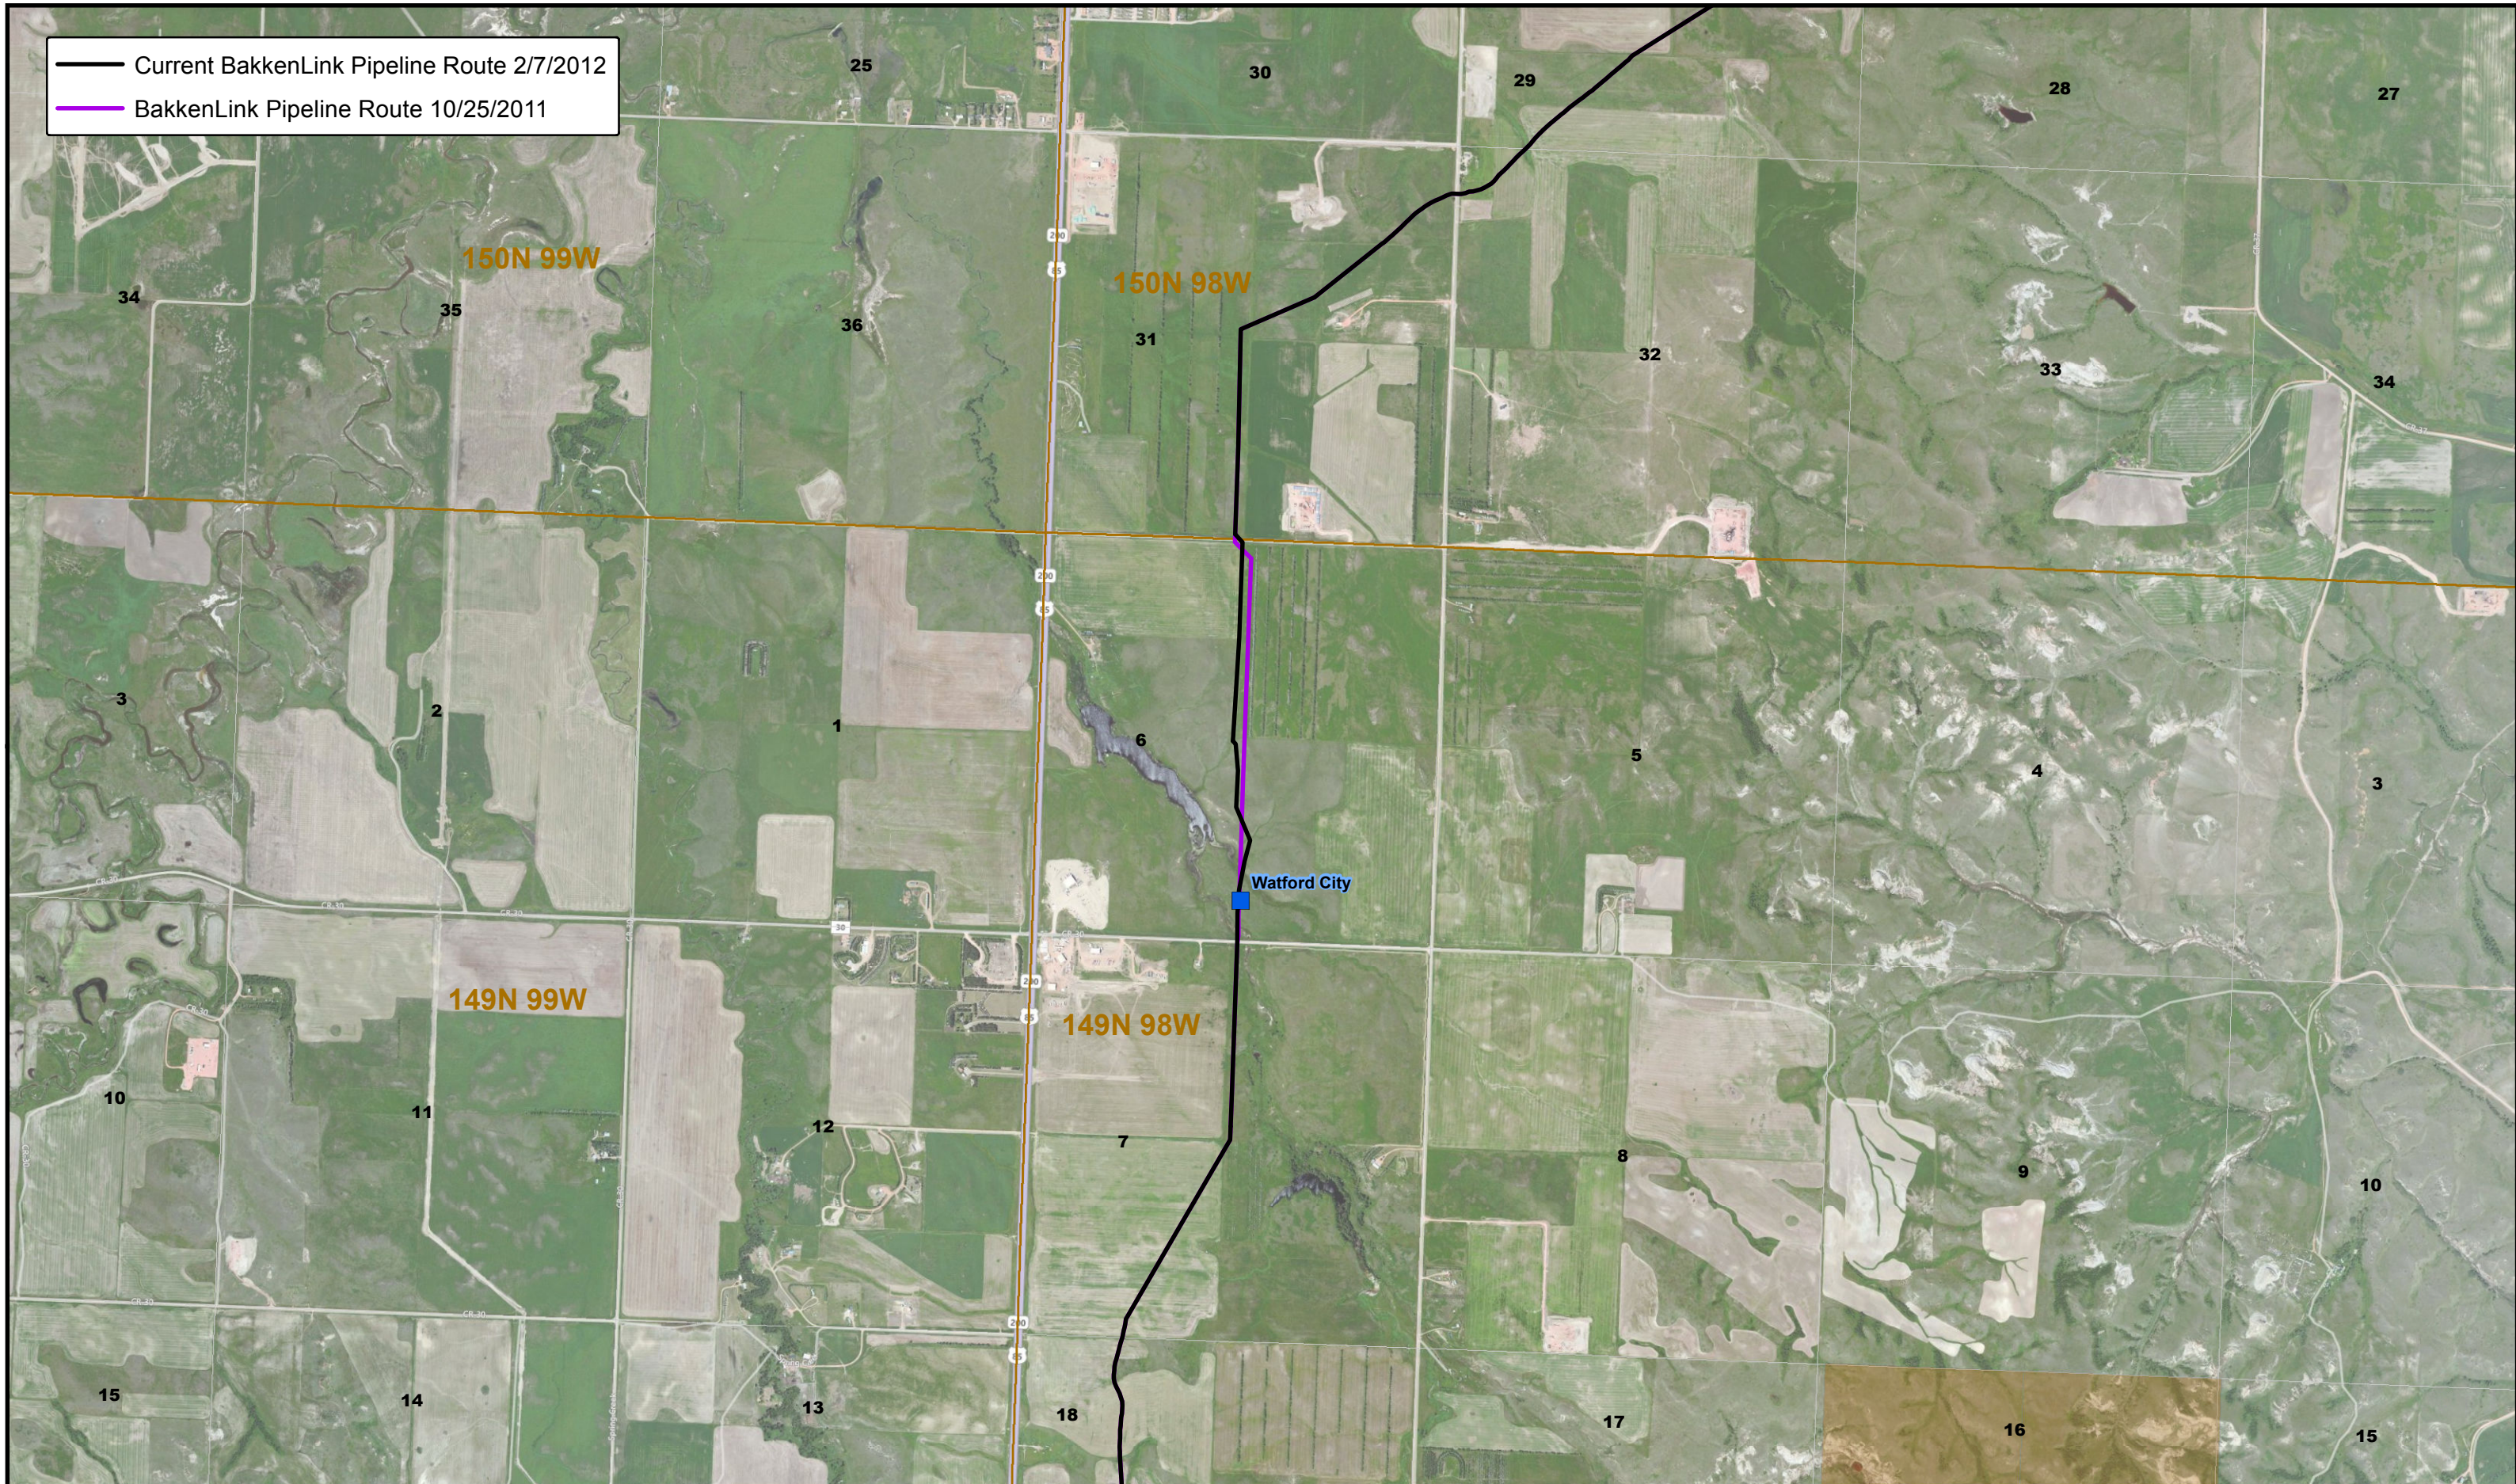

BAKKENLINK PIPELINE ROUTE
T 149N, R 98W
Preliminary route and proposed pipeline

BakkenLink
Pipeline LLC
BARTLETT & WEST