

STATE OF NORTH DAKOTA
PUBLIC SERVICE COMMISSION

BakkenLink Pipeline, LLC
Crude Oil Pipeline – Williams to Billings Counties
Siting Application

Case No. PU-10-218

AFFIDAVIT OF SERVICE BY CERTIFIED MAIL

STATE OF NORTH DAKOTA
COUNTY OF BURLEIGH

Cara DeSaye deposes and says that:

she is over the age of 18 years and not a party to this action and, on the 15th day of **February, 2013**, she deposited in the United States Mail, at Bismarck, North Dakota, **one** envelope with certified postage, return receipt requested, fully prepaid, securely sealed and containing a photocopy of:

Notice of Filings, Notice of Informal Hearing, and Notice of Opportunity for Hearing

The envelope was addressed as follows:


Mr. Lawrence Bender
Fredrikson & Byron, PA
200 N 3rd St, Suite 150
Bismarck ND 58501-3879

Cert. No. 7012 1640 0002 4652 2420

The address shown is the respective addressee's last reasonably ascertainable post office address.

Subscribed and sworn to before me
this 15th day of **February, 2013**.

SEAL

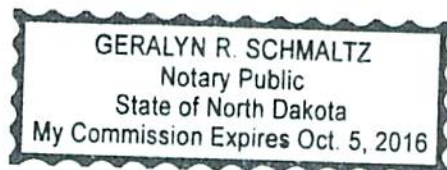

Cara DeSaye

Geraldine R. Schmaltz

Notary Public

**STATE OF NORTH DAKOTA
PUBLIC SERVICE COMMISSION**

**BakkenLink Pipeline LLC
Crude Oil Pipeline – Williams to Billings County
Siting Application**

Case No. PU-10-218

**NOTICE OF FILINGS, NOTICE OF INFORMAL HEARING,
AND NOTICE OF OPPORTUNITY FOR HEARING**

February 13, 2013

The North Dakota Public Service Commission's (Commission) February 29, 2012 Findings of Fact, Conclusions of Law and Order (Order) issued to BakkenLink Pipeline LLC (BakkenLink) a Certificate designating a corridor and a Permit designating a route for the construction of a 123.8 miles of 12-inch pipeline and three 8-inch lateral pipelines and associated facilities in Billings, Dunn, McKenzie, Stark and Williams Counties, North Dakota, for the transmission of crude oil.

The Commission's September 5, 2012 Findings of Fact, Conclusions of Law and Order granted BakkenLink's request for an amended corridor certificate and amended route permit.

On January 18, 2013, BakkenLink filed a request for modification to the approved corridor and route to allow for four reroutes of the approved route, all in McKenzie County, North Dakota. BakkenLink also filed an application for waivers of procedures and time schedules. The proposed reroutes are shown on the attached maps.

In its application for waivers of procedures and time schedules, BakkenLink requests that the Commission waive the following:

- Procedures that require separate filings of applications for a certificate of corridor compatibility and a route permit,
- Procedures that require separate notices of such applications,
- Procedures that may require a public hearing on a waiver request,
- Procedures that may require a public hearing on an application for a certificate of corridor compatibility,
- Procedures that may require a public hearing on an application for a route permit.

The issues to be considered in BakkenLink's application for waiver of procedures and time schedules are:

1. Are the proposed facilities of such length, design, location, or purpose that they will produce minimal adverse effects and that adherence to applicable procedures and time schedules may be waived?

2. Is it appropriate for the Commission to waive any procedures and time schedules as requested in the application?

The issues to be considered in BakkenLink's applications for amended certificate of corridor compatibility and amended route permit are:

1. Will the location, construction, and operation of the proposed facilities produce minimal adverse effects on the environment and upon the welfare of the citizens of North Dakota?
2. Are the proposed facilities compatible with the environmental preservation and the efficient use of resources?
3. Will the proposed facility locations minimize adverse human and environmental impact while ensuring continuing system reliability and integrity and ensuring that energy needs are met and fulfilled in an orderly and timely fashion?

At its February 1, 2013 Special Meeting, the Commission determined that it would delegate authority to staff to approve BakkenLink route deviations outside the designated corridor subject to the subsequent issuance of a Notice of Opportunity for Hearing providing opportunity for comments or requests for hearing on the four reroutes. Consequently, staff's February 8, 2013 approval of the four reroutes is conditioned on expiration of the Notice period without receipt of any comments or requests for hearing.

Those interested are invited to comment on the applications in writing. Persons desiring a hearing must file a written request identifying their interest in the proceeding and the reasons for requesting a hearing. **Comments and requests for hearing must be received by March 18, 2013.** If deemed appropriate, the Commission can determine the matter without a hearing.

An **Informal Hearing** of this matter is scheduled to begin on **March 27, 2013 at 1:30 p.m. CDT** in the Commission Hearing Room on the 12th floor of the State Capitol. At the informal hearing, the Commission will discuss this matter with the parties and interested members of the public.

For more information contact the Public Service Commission, State Capitol, Bismarck, North Dakota 58505, 701-328-2400; or Relay North Dakota, 1-800-366-6888 TTY. If you require any auxiliary aids or services, such as readers, signers, or Braille materials, please notify the Commission at least 24 hours in advance.

PUBLIC SERVICE COMMISSION




Randy Christmann
Commissioner



Brian P. Kalk
Chairman



Julie Fedorchak
Commissioner

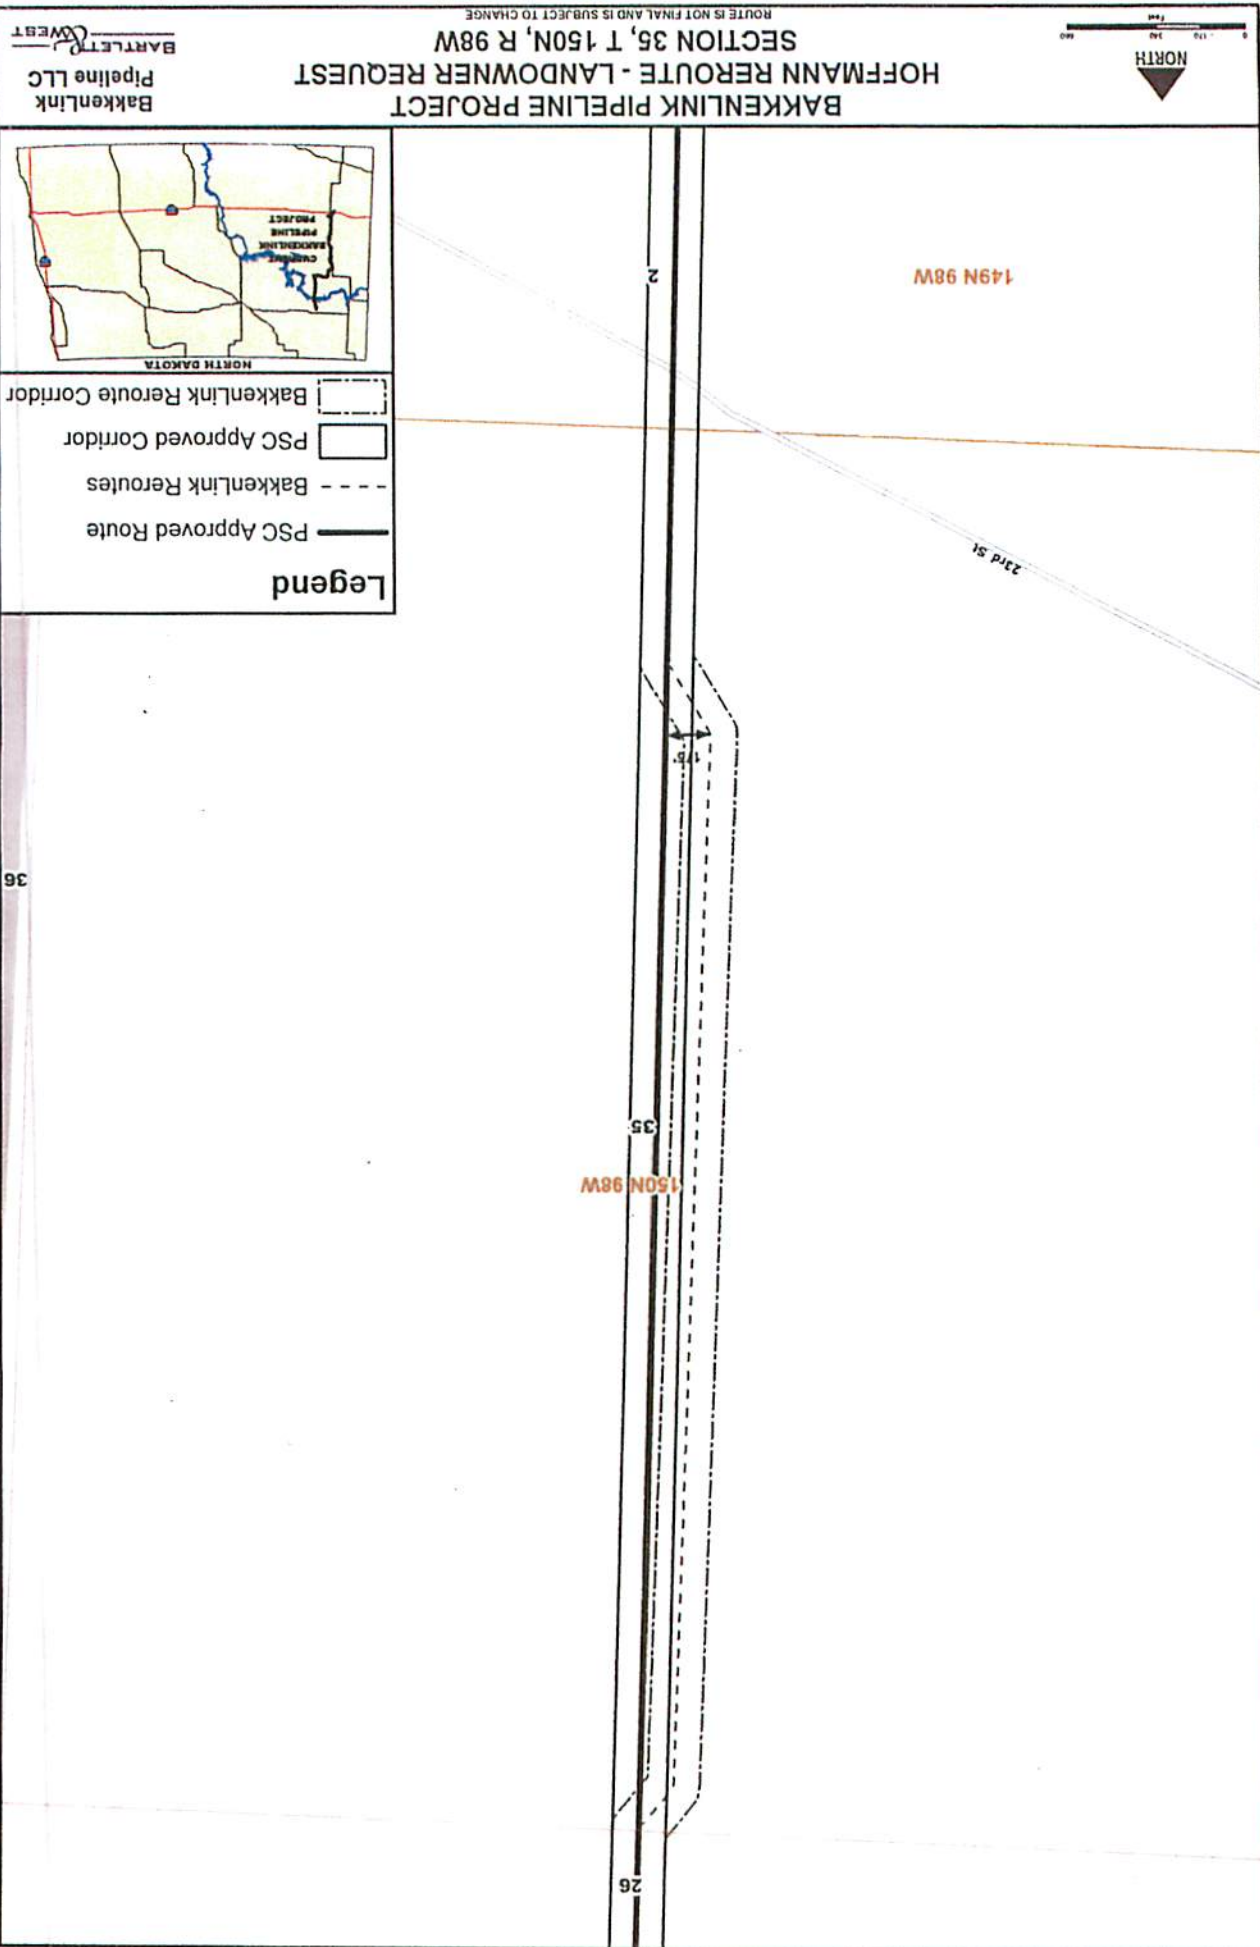

Legend

- PSC Approved Route
- BakkenLink Reroutes
- PSC Approved Corridor
- BakkenLink Reroute Corridor

36

150N 98W


149N 98W

23rd St

26

35

27

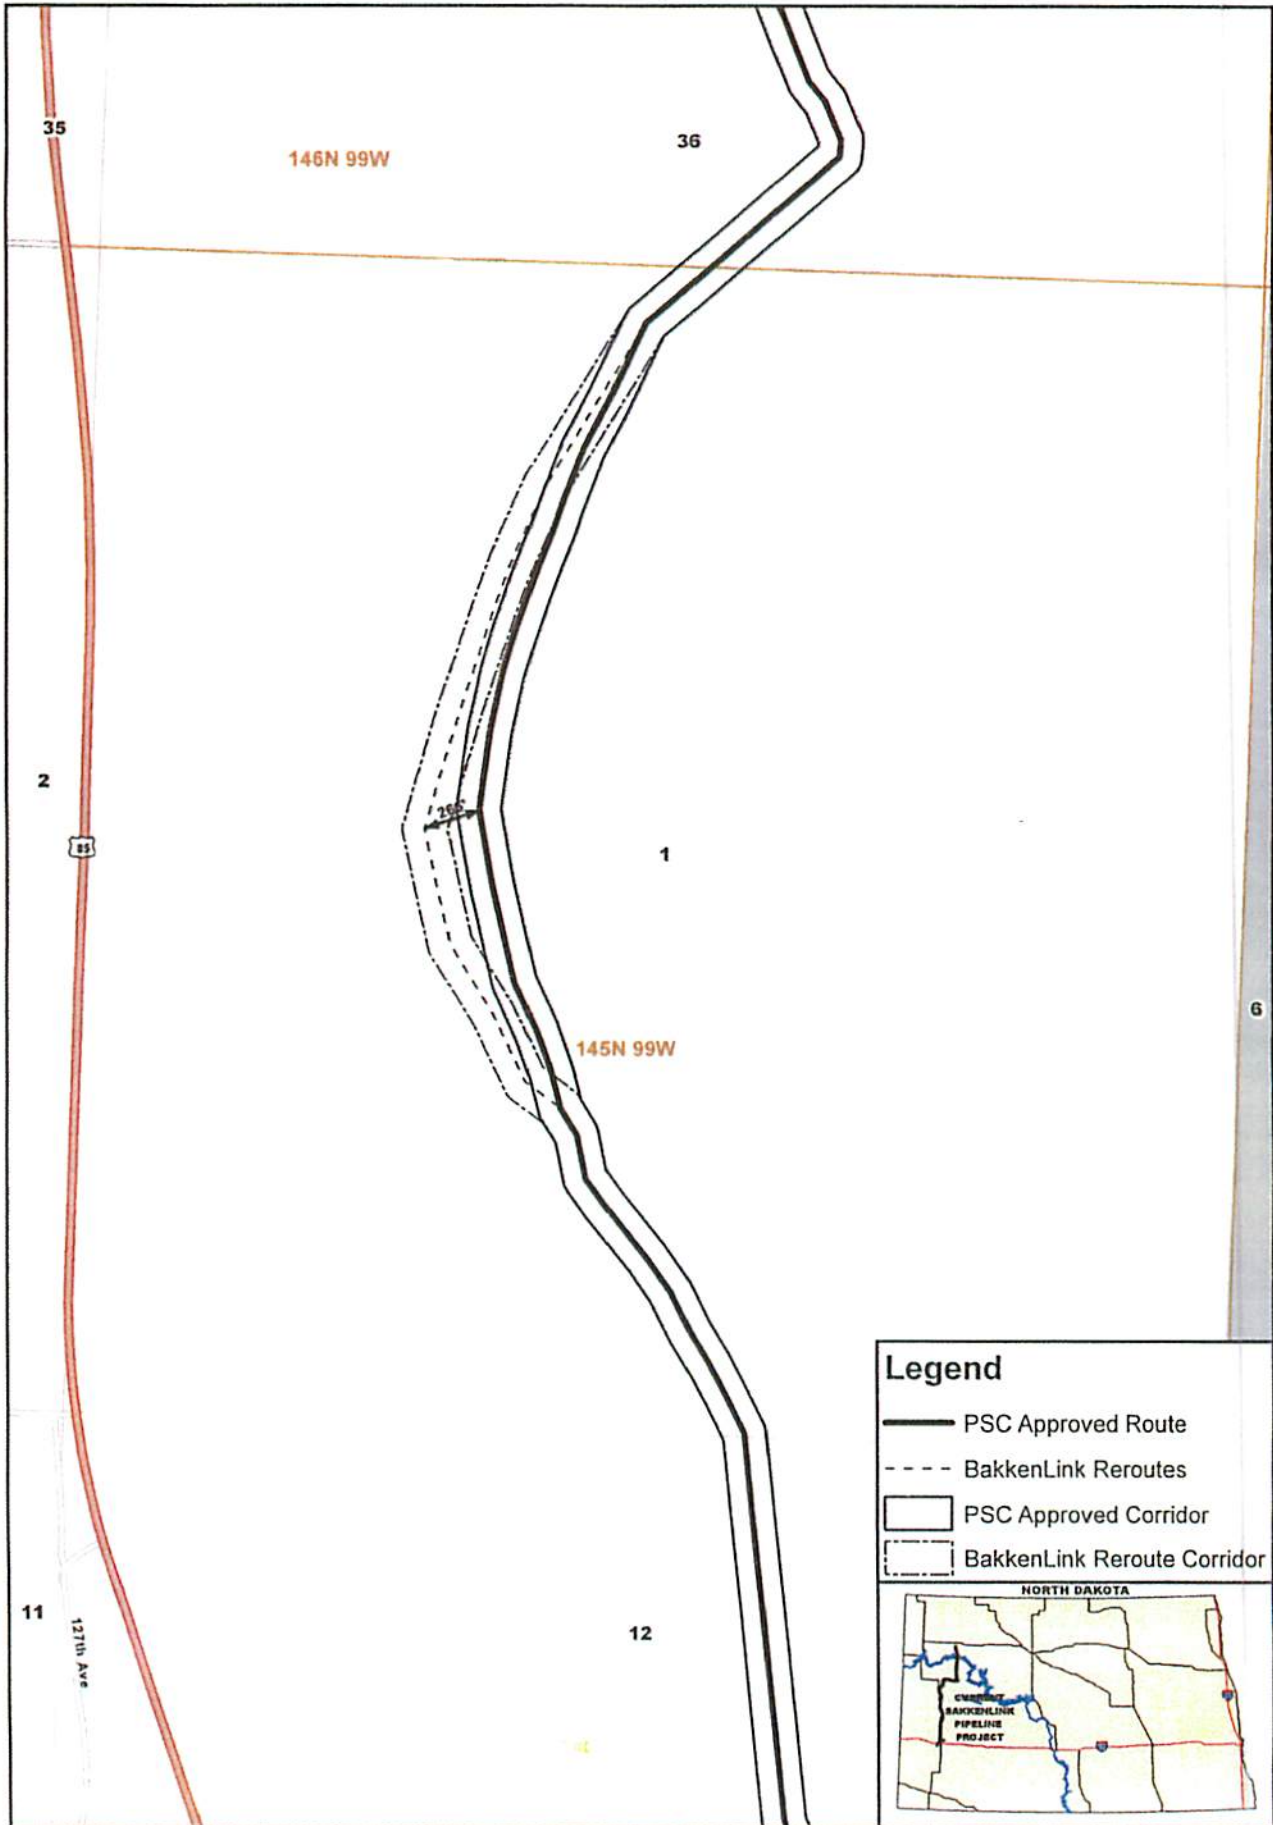

Legend

- PSC Approved Route
- - - BakkenLink Reroutes
- ▭ PSC Approved Corridor
- - - BakkenLink Reroute Corridor



BAKKENLINK PIPELINE PROJECT
KNAPP REROUTE - LANDOWNER REQUEST
SECTION 1, T 145N, R 99W
ROUTE IS NOT FINAL AND IS SUBJECT TO CHANGE

BakkenLink
 Pipeline LLC
 BARTLETT & WEST

BAKKENLINK PIPELINE PROJECT
 LEVANG REROUTE
 SECTION 18, T 150N, R 95W




ROUTE IS NOT FINAL AND IS SUBJECT TO CHANGE



Legend

- PSC Approved Route
- BakkenLink Reroutes
- PSC Approved Corridor
- BakkenLink Reroute Corridor

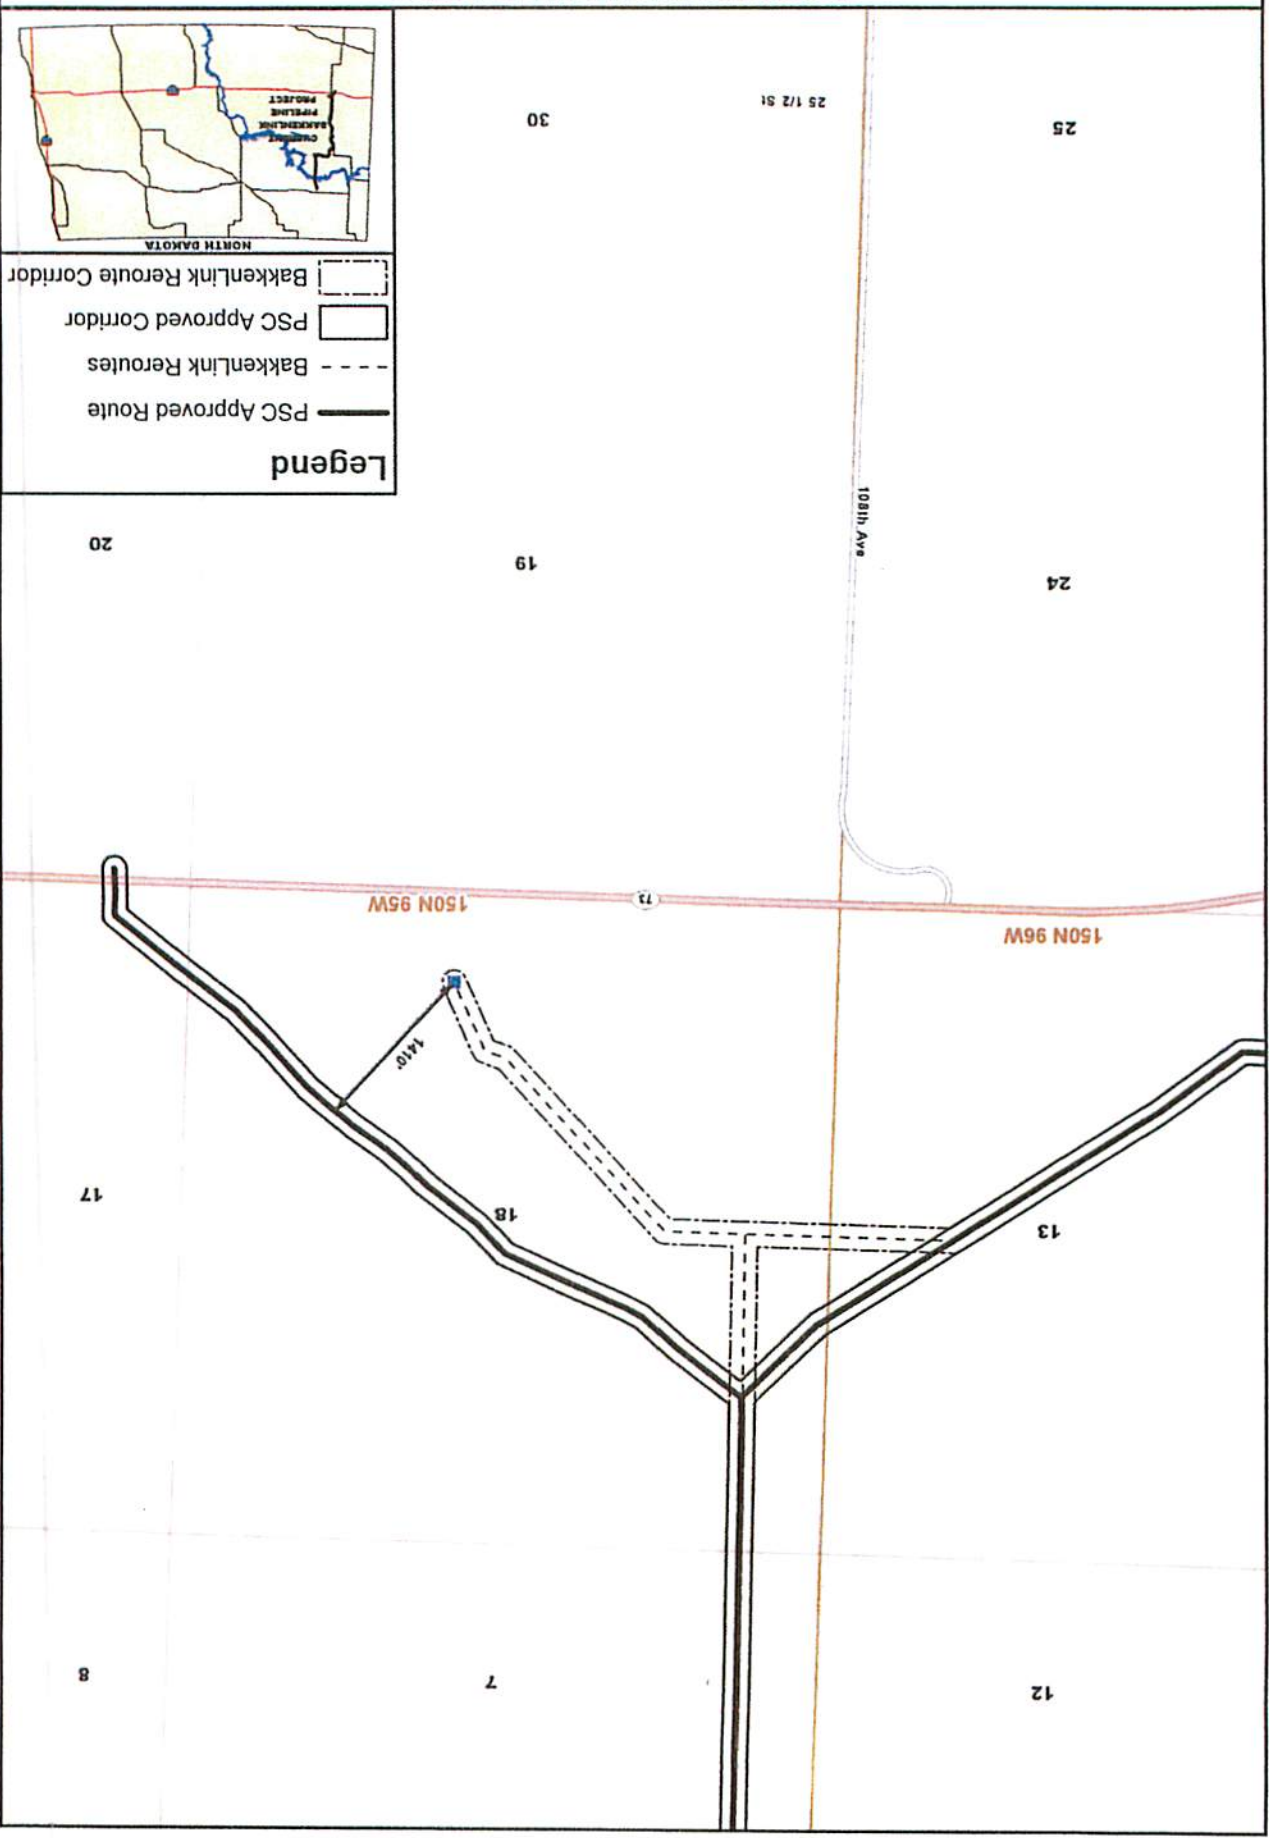

ROUTE IS NOT FINAL AND IS SUBJECT TO CHANGE

