

Exam Date:10/11/2010

Blue Flint Ethanol, LLC
 10653 S River Front Parkway Suite 300
 South Jordan , UT
 County:
 Phone: 801-984-9400
 CCC Number:

Page: 1

Examiner: 1

Location/Container Numbers/Comments	Section	Capacity
PART A - ADDITIONAL SPACE TO BE INCLUDED UNDER LICENSE		
001	B	107,423
002	B	299,012
003	B	299,012
004	B	3,983
	Total:	709,430
PART B - SPACE TO BE DELETED UNDER LICENSE		
<NO BINS DELETED>		
	Total:	0
PART C - ALL SPACE TO BE INCLUDED UNDER LICENSE		
	A	1,758,000
	B	710,000
	Total:	2,468,000
PART D - TOTAL CAPACITY BY FUNCTIONAL UNIT		
Underwood 1178	A B	2,468,000
	Total:	2,468,000

Client ID: 3405

NDPSC Bin Capacity Chart

10/11/2010 09:19:28 AM

Exam Date:10/11/2010

Blue Flint Ethanol, LLC
 10653 S River Front Parkway Suite 300
 South Jordan , UT
 County:

Page: 1

Status	Section	Bin Number	Bin Type	Base Point	Diameter or Bu/Ft (Irreg.) Length	Width	Side wall	Add for Hopper	Ded. for Obst.	Effective Depth	Add for Peak	Depth for Capac.	Bushels per Foot	Base Pack%	Bushel Capacity with Pack
--------	---------	------------	----------	------------	---	-------	--------------	----------------------	----------------------	--------------------	--------------------	------------------------	------------------------	---------------	------------------------------

Facility: Underwood**Section: A**

A	001	Round	top of slab		75.000	0.000	0.000	150.0	0.00	0.00	150.00	0.000	150.0	3551.3	10.0	585,965
A	002	Round	top of slab		75.000	0.000	0.000	150.0	0.00	0.00	150.00	0.000	150.0	3551.3	10.0	585,965
A	003	Round	top of slab		75.000	0.000	0.000	150.0	0.00	0.00	150.00	0.000	150.0	3551.3	10.0	585,965

Bin count: 3

Facility: Underwood Section: A Total: **1,757,895**To Even: **1,758,000****Section: B**

Added	B	001	Peaked	top of sidewall -15" aeration	47.800	0.000	0.000	64.80	0.00	0.00	64.800	2.900	67.7	1442.5	10.0	107,423
Added	B	002	Peaked	top of sidewall	77.600	0.000	0.000	66.10	0.00	0.00	66.100	5.400	71.5	3801.8	10.0	299,012
Added	B	003	Peaked	top of sidewall	77.600	0.000	0.000	66.10	0.00	0.00	66.100	5.400	71.5	3801.8	10.0	299,012
Added	B	004	Peaked	top of sidewall	16.000	0.000	0.000	20.00	2.30	0.00	22.300	1.000	23.3	161.6	5.80	3,983

Bin count: 4


Facility: Underwood Section: B Total: **709,430**To Even: **710,000****Overall Licensed Bin Capacity for:**

Blue Flint Ethanol, LLC

Bin count: 7


Licensed Capacity:
(includes pack)**2,467,325 Bu.**Licensed Capacity (to even):
(includes pack and section totals are
rounded up to next highest 1000)**2,468,000 Bu.**

BLUE FLINT ETHANOL, LLC
UNDERWOOD ND

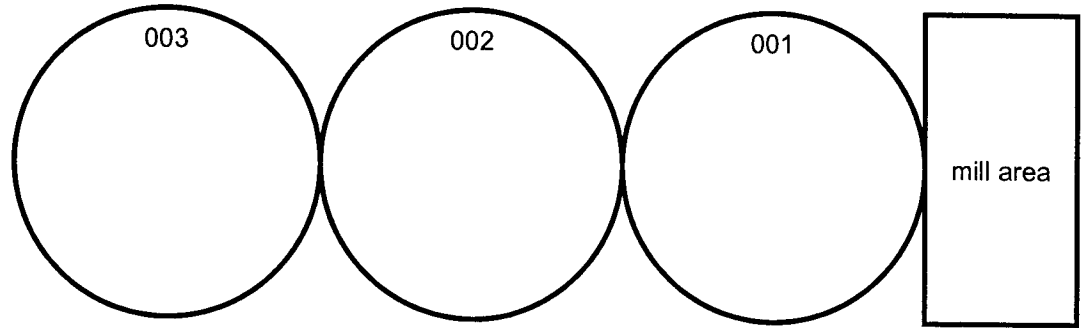

SECTION A
3 concrete silos 75' diameter x 150' depth

SECTION B
wet corn receiving & storage

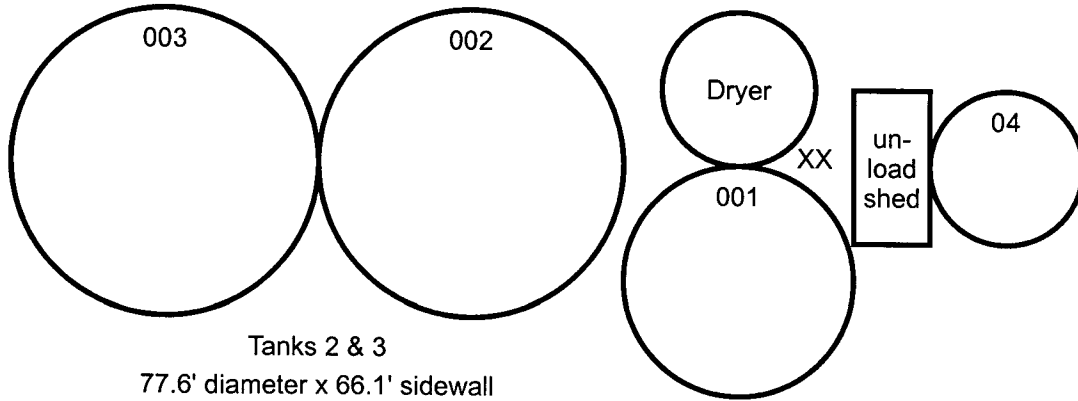



Tanks 2 & 3
77.6' diameter x 66.1' sidewall

tank 1
47.8' diameter x 64.8' sidewall
full aeration floor deduct 1.25'


1' block N



1/2 block NW

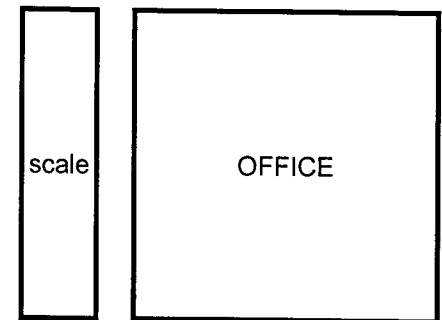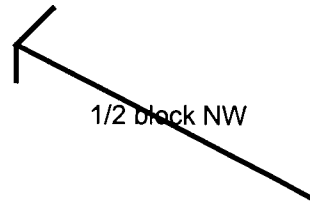


BLUE FLINT ETHANOL, LLC
UNDERWOOD ND

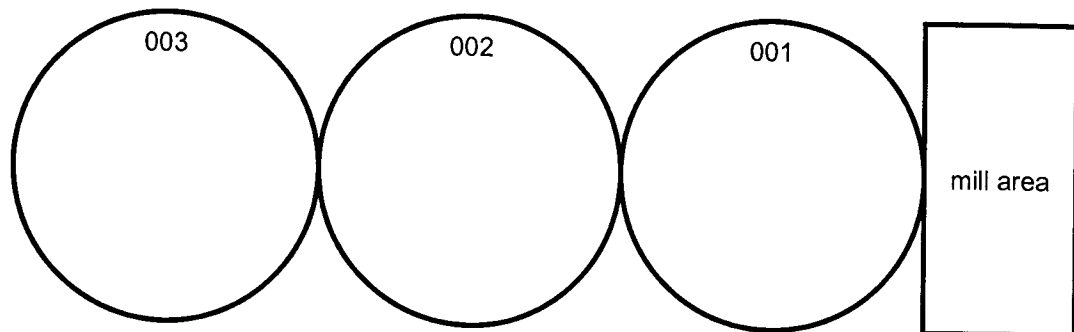

SECTION A
3 concrete silos 75' diameter x 150' depth

SECTION B
wet corn receiving & storage

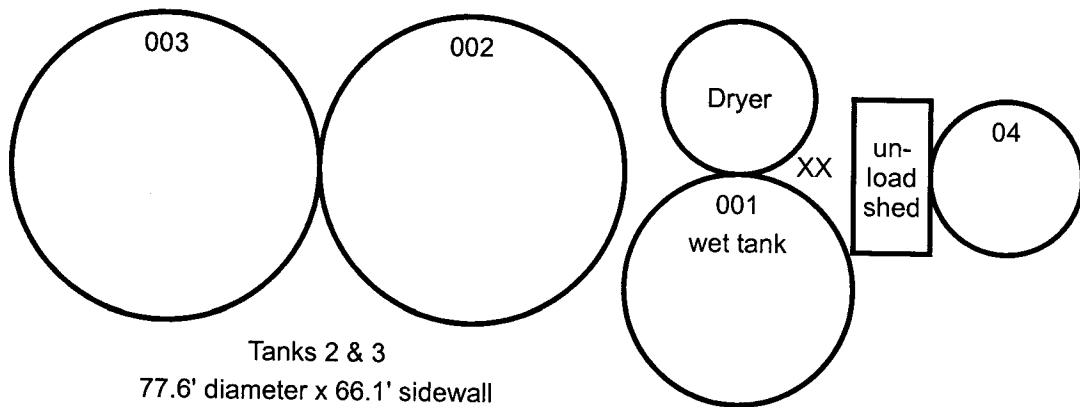

Tanks 2 & 3
77.6' diameter x 66.1' sidewall

tank 1
47.8' diameter x 64.8' sidewall
full aeration floor deduct 1.25'

1' block N



1/2 block NW

